




382+50

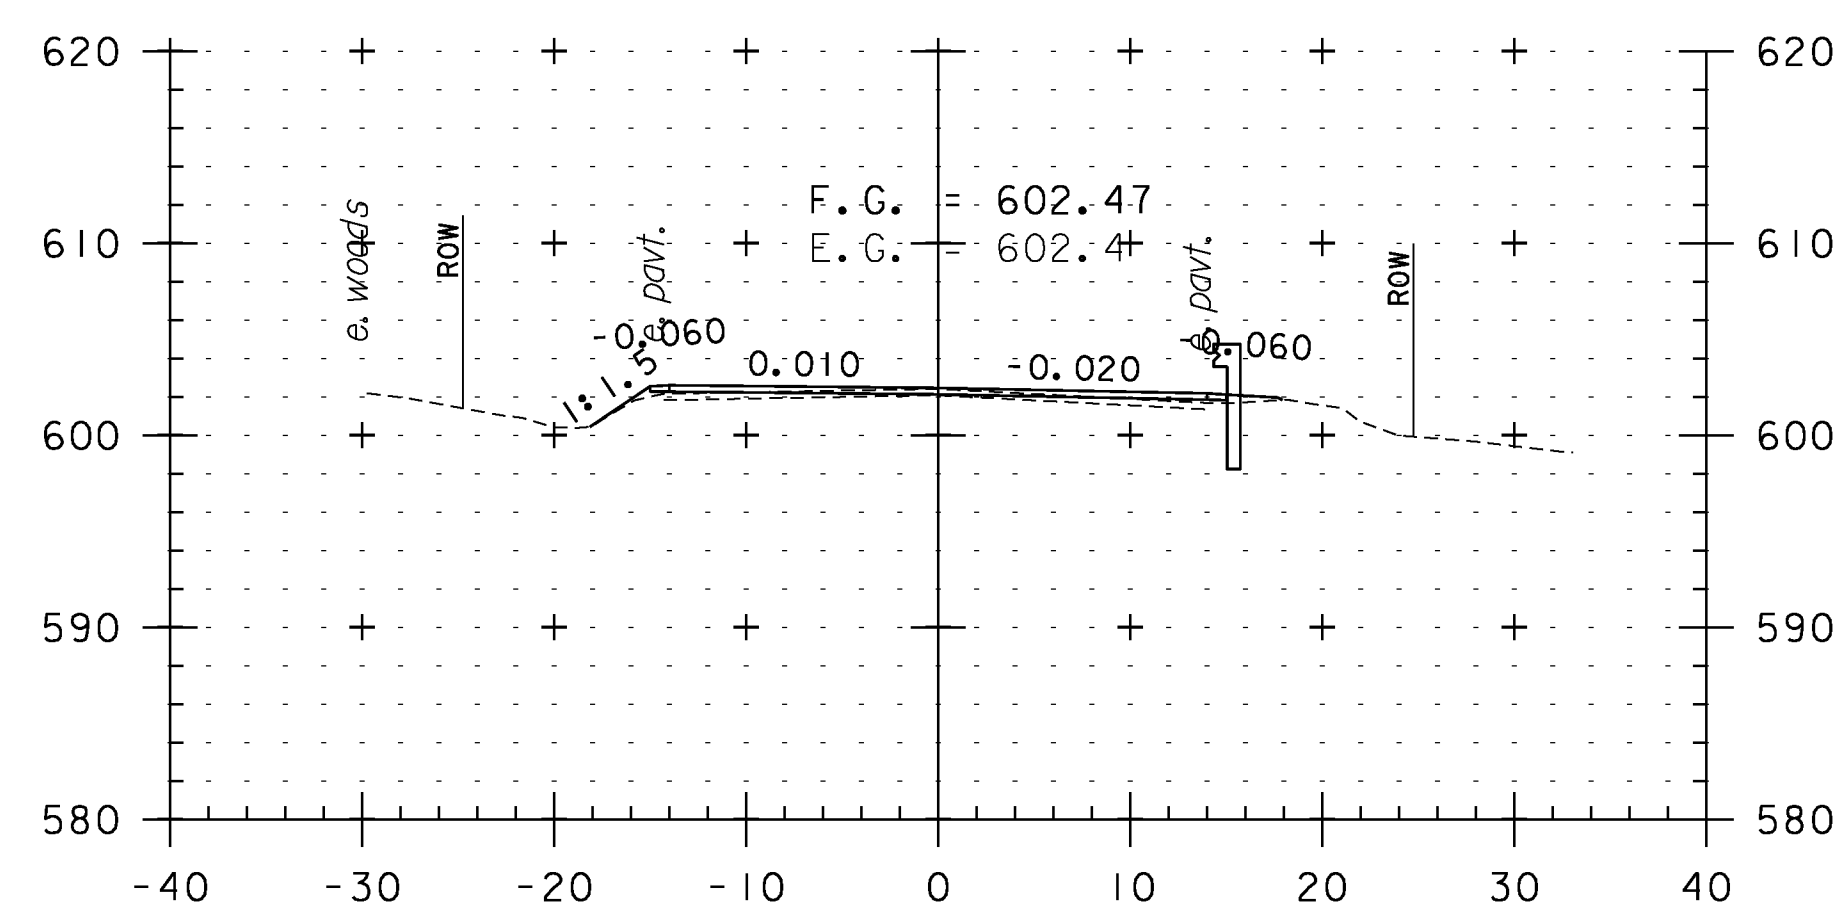


382+00

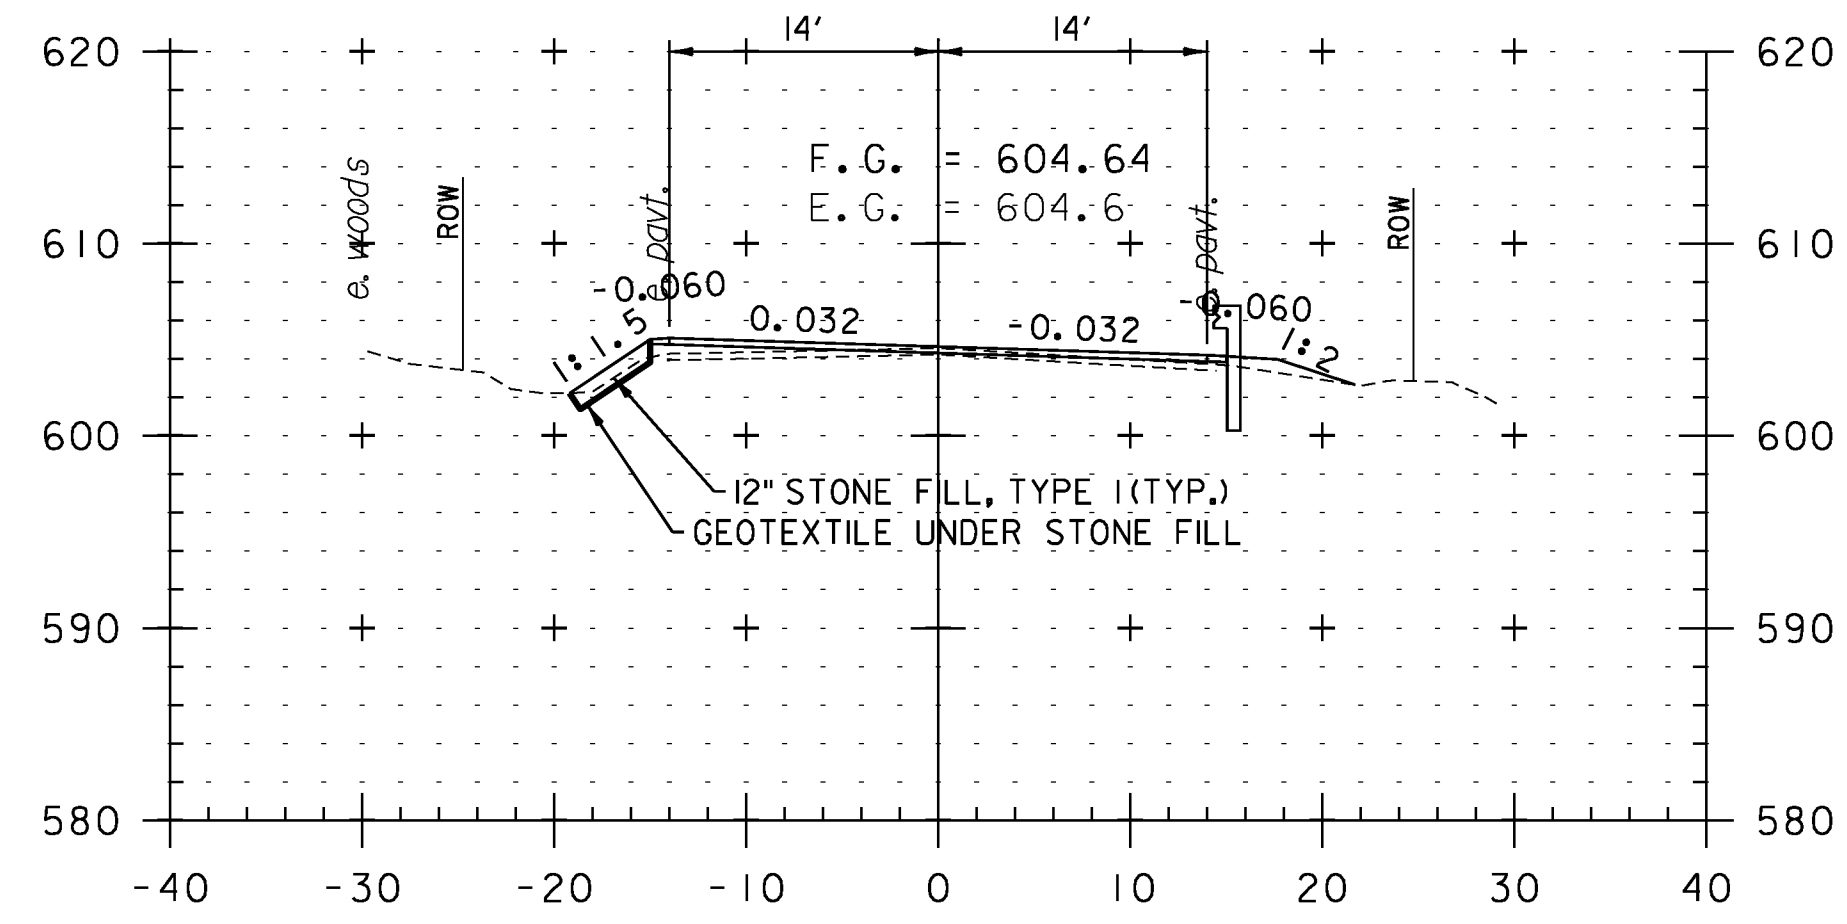


381+50

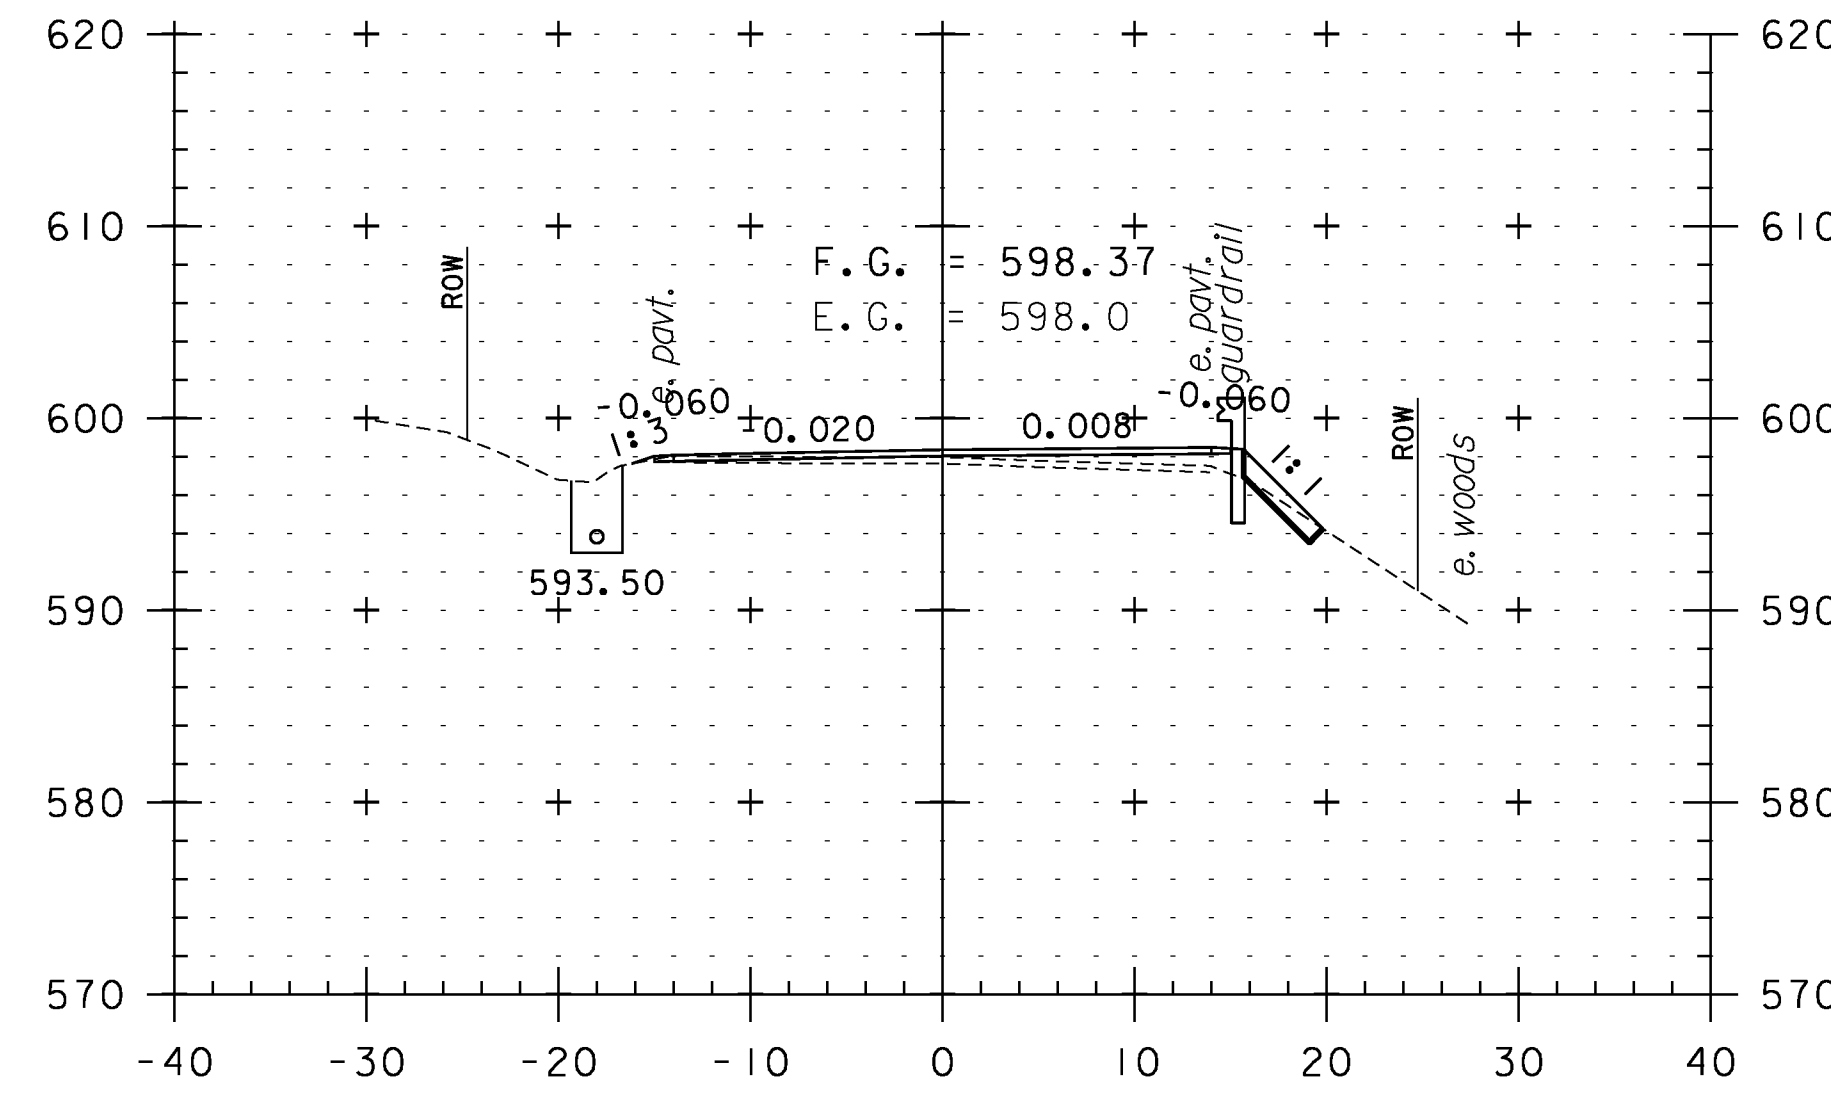


383+50

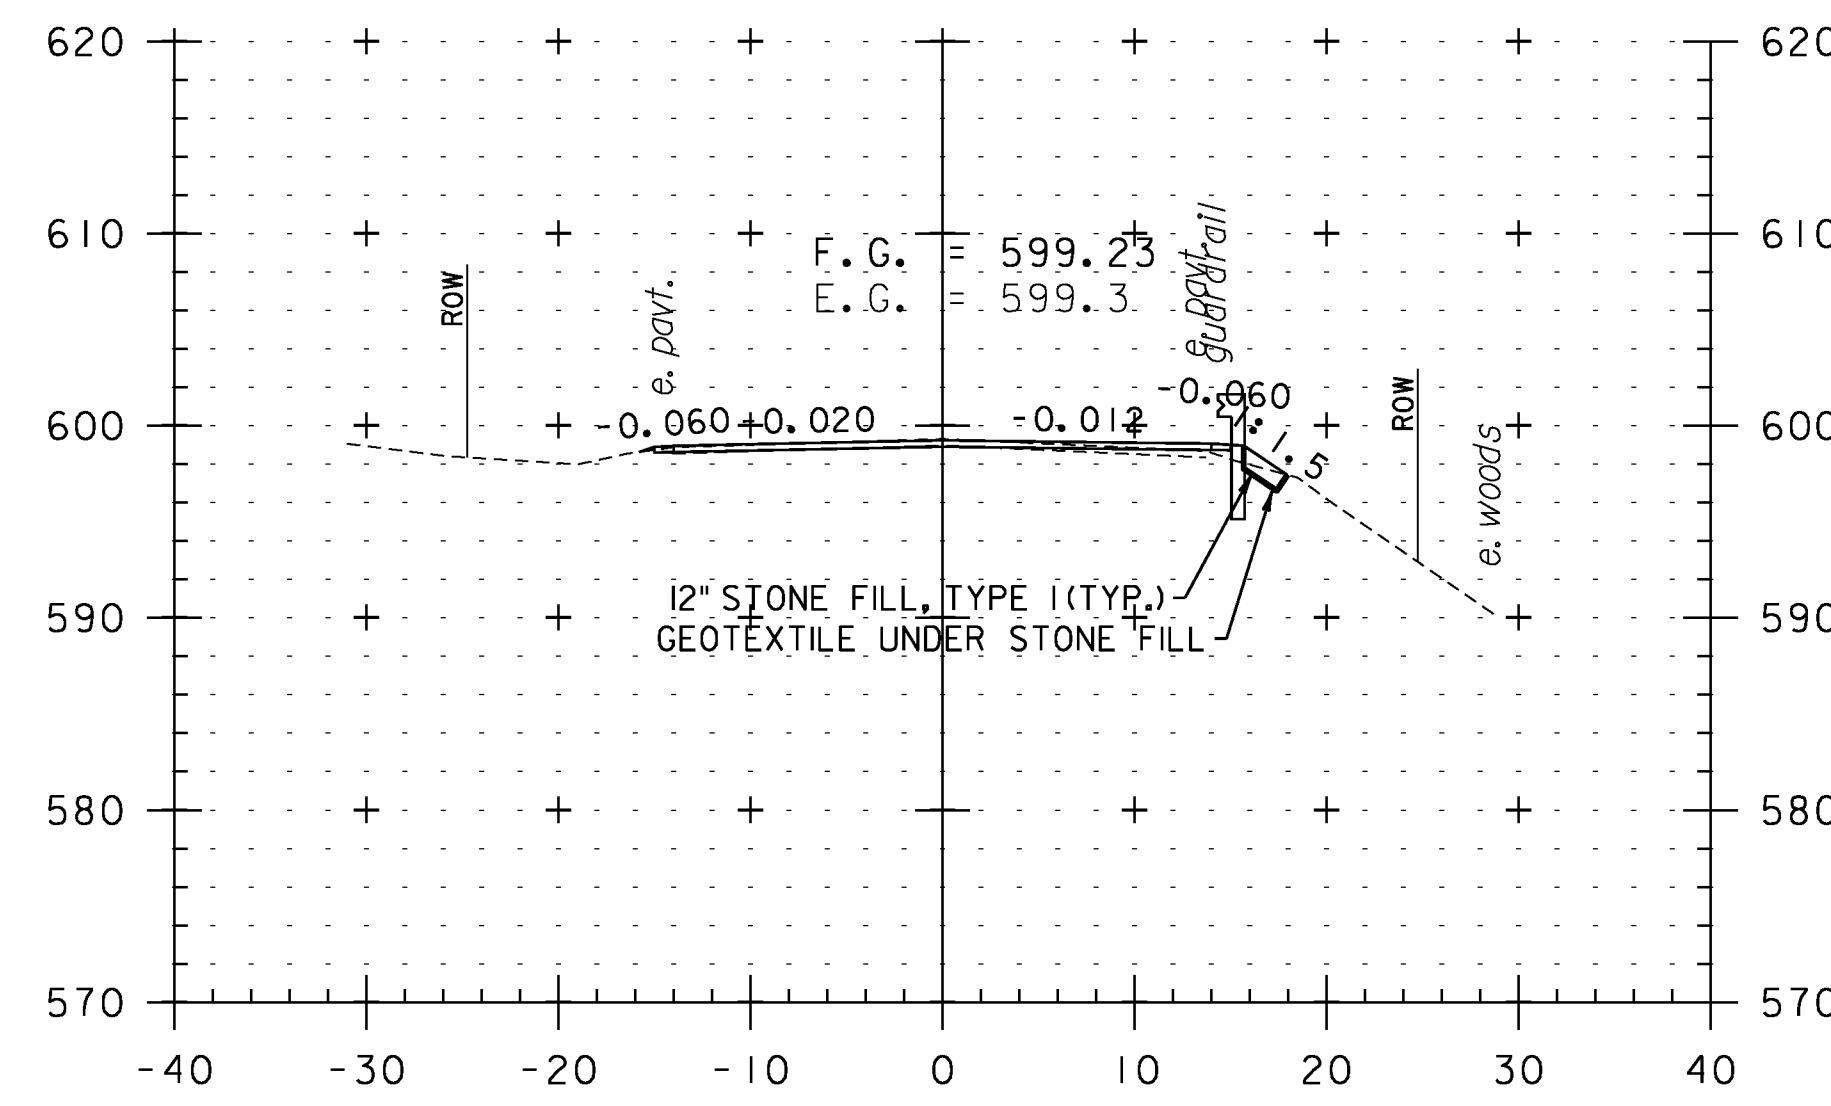

383+00

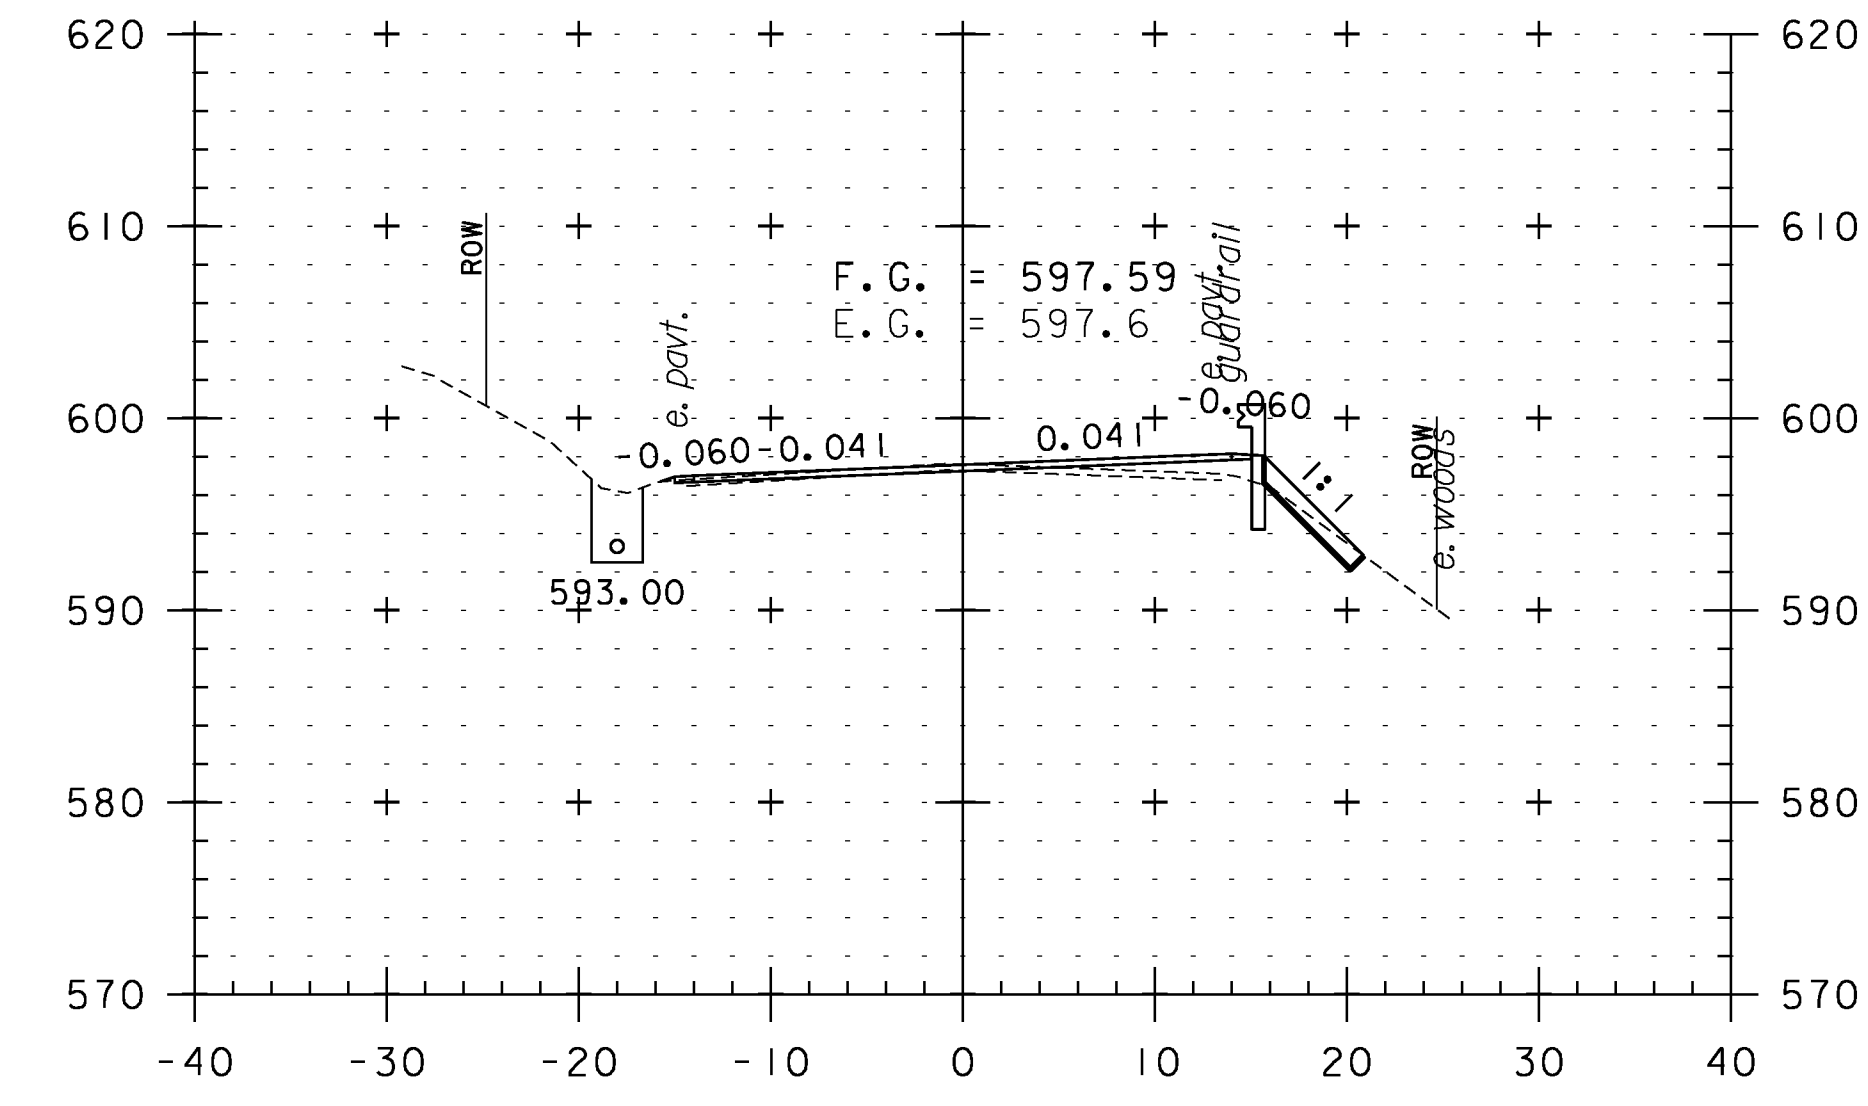


384+50

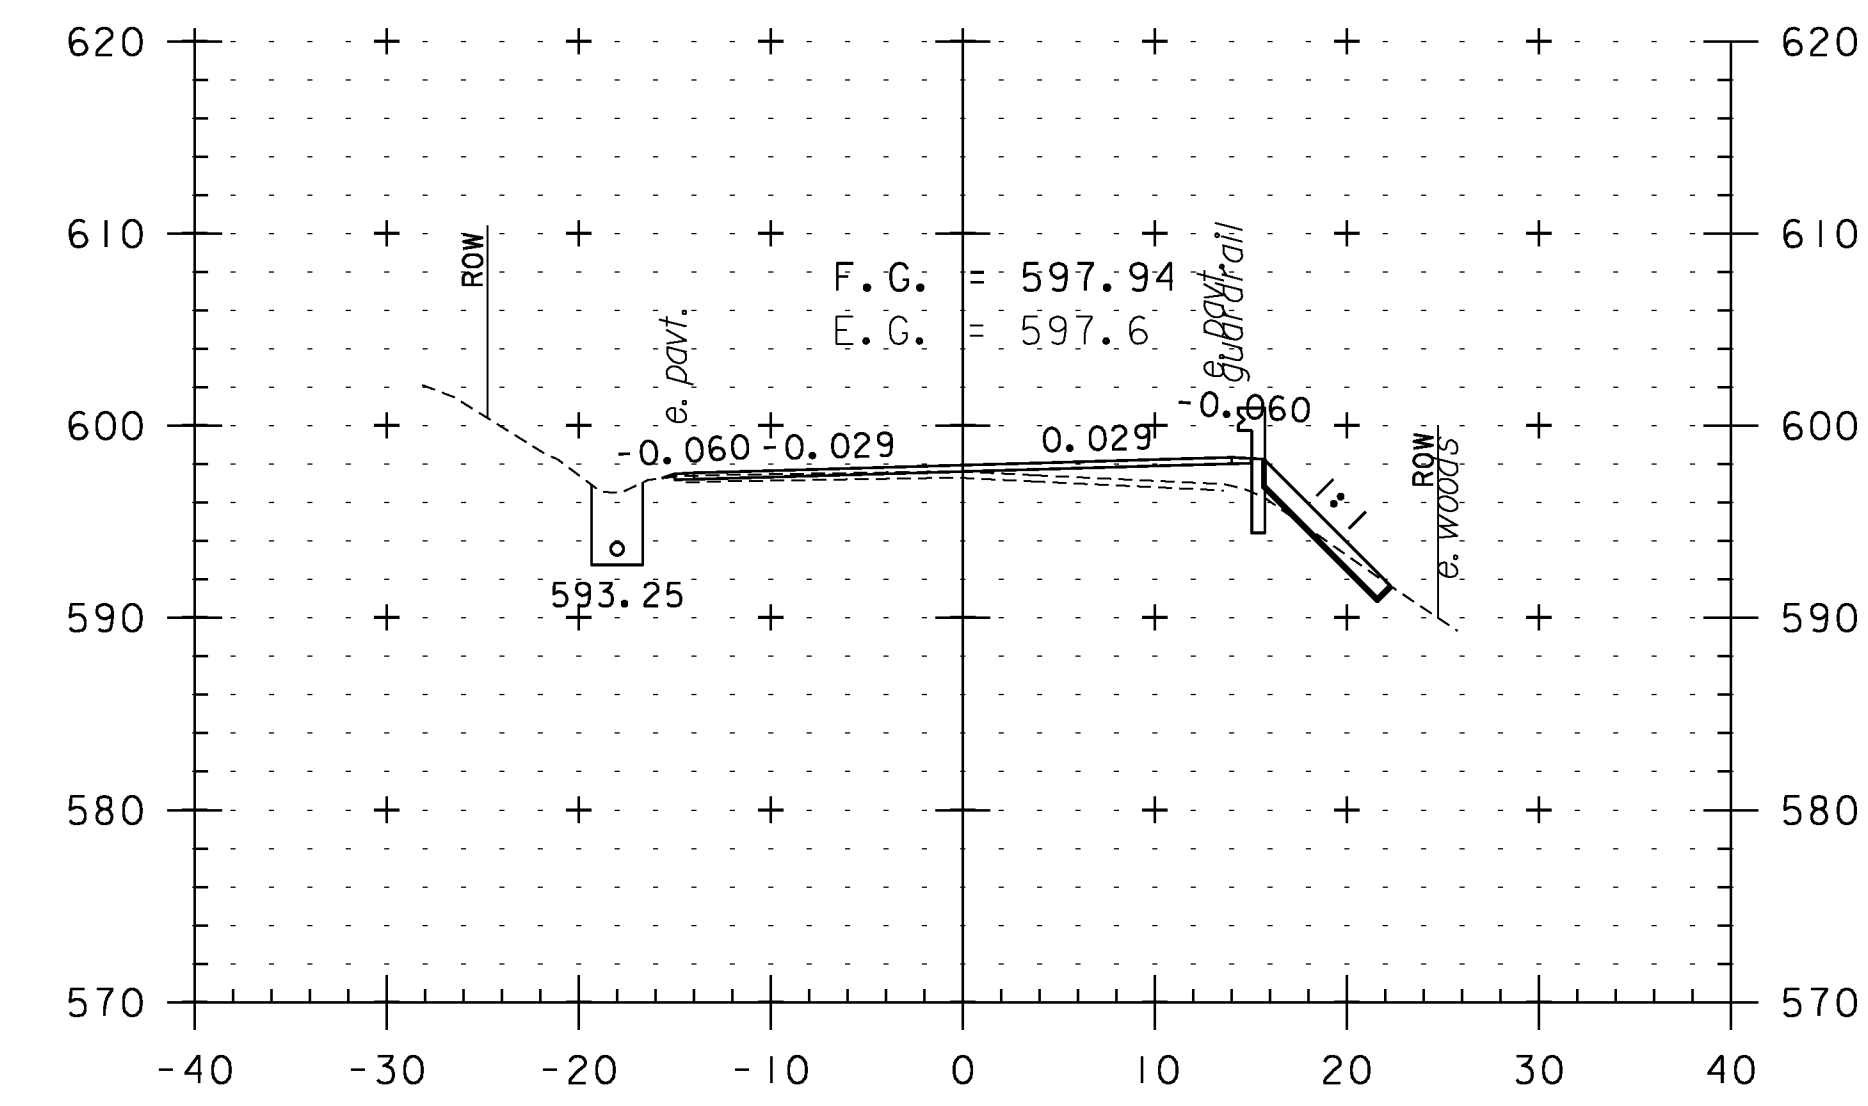

384+00

CROSS SECTION SHEET 75

PROJECT NAME: WEATHERSFIELD	
PROJECT NUMBER: STP 2913(I)	
FILE NAME: I0c228	PLOT DATE: 2/7/2013
PROJECT LEADER: PTS	DRAWN BY: WWG
DESIGNED BY: NLL	CHECKED BY: PTS
IPARM FILE NAME: pI0c228.l65	SHEET 165 OF 234

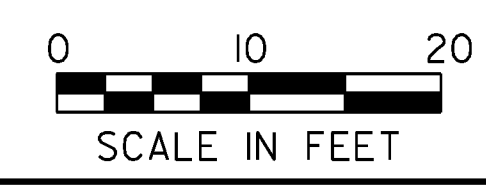

STA. 381+50 TO STA. 384+50