




390+00

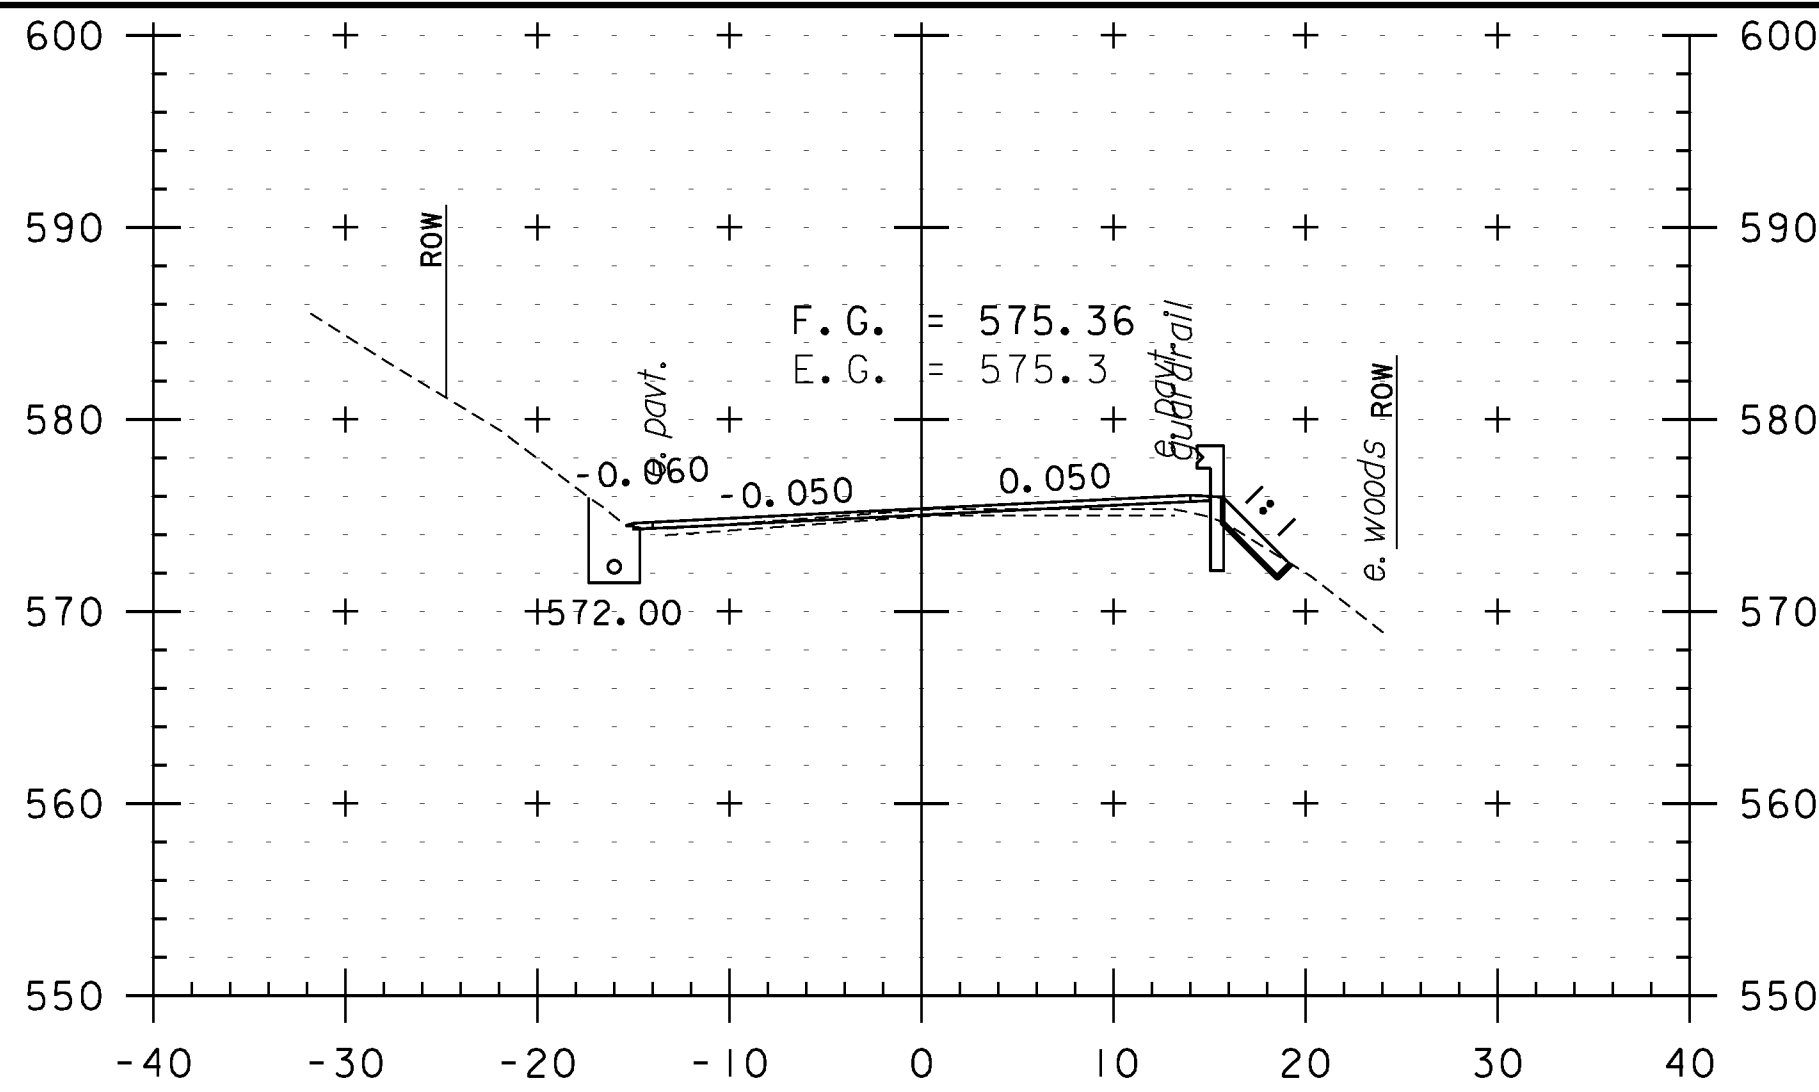


391+50

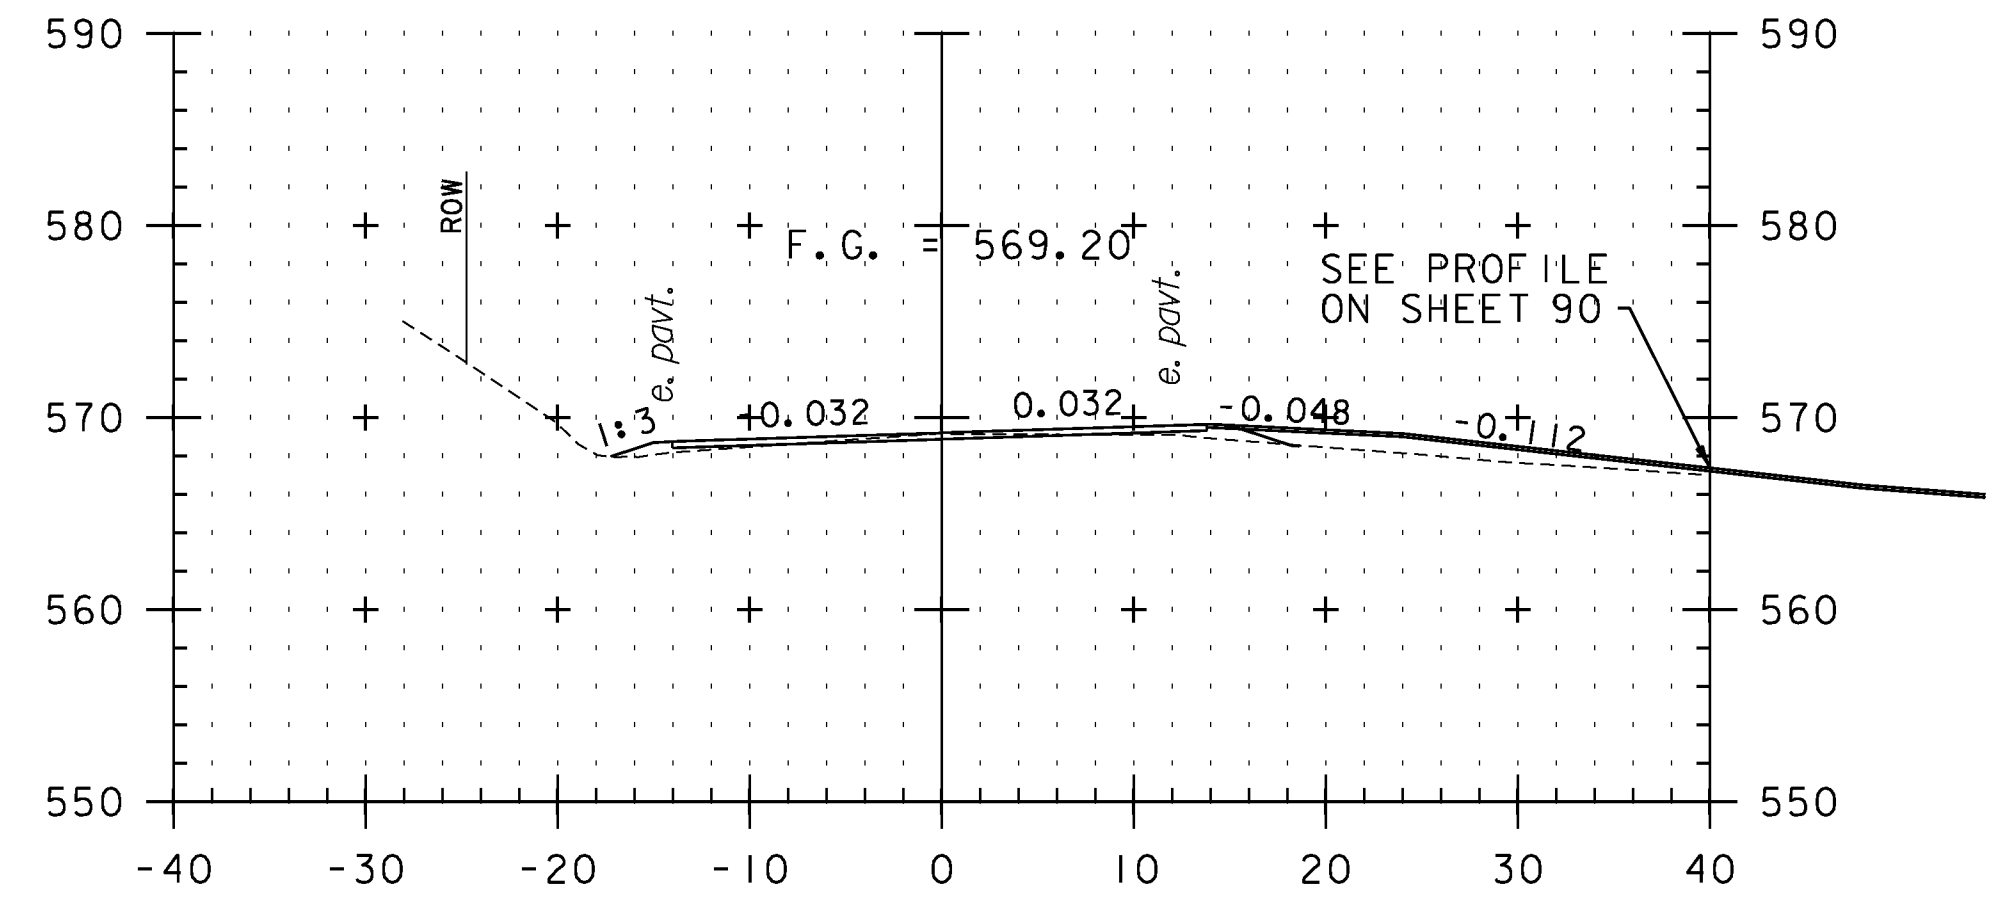


392+53
TH 102

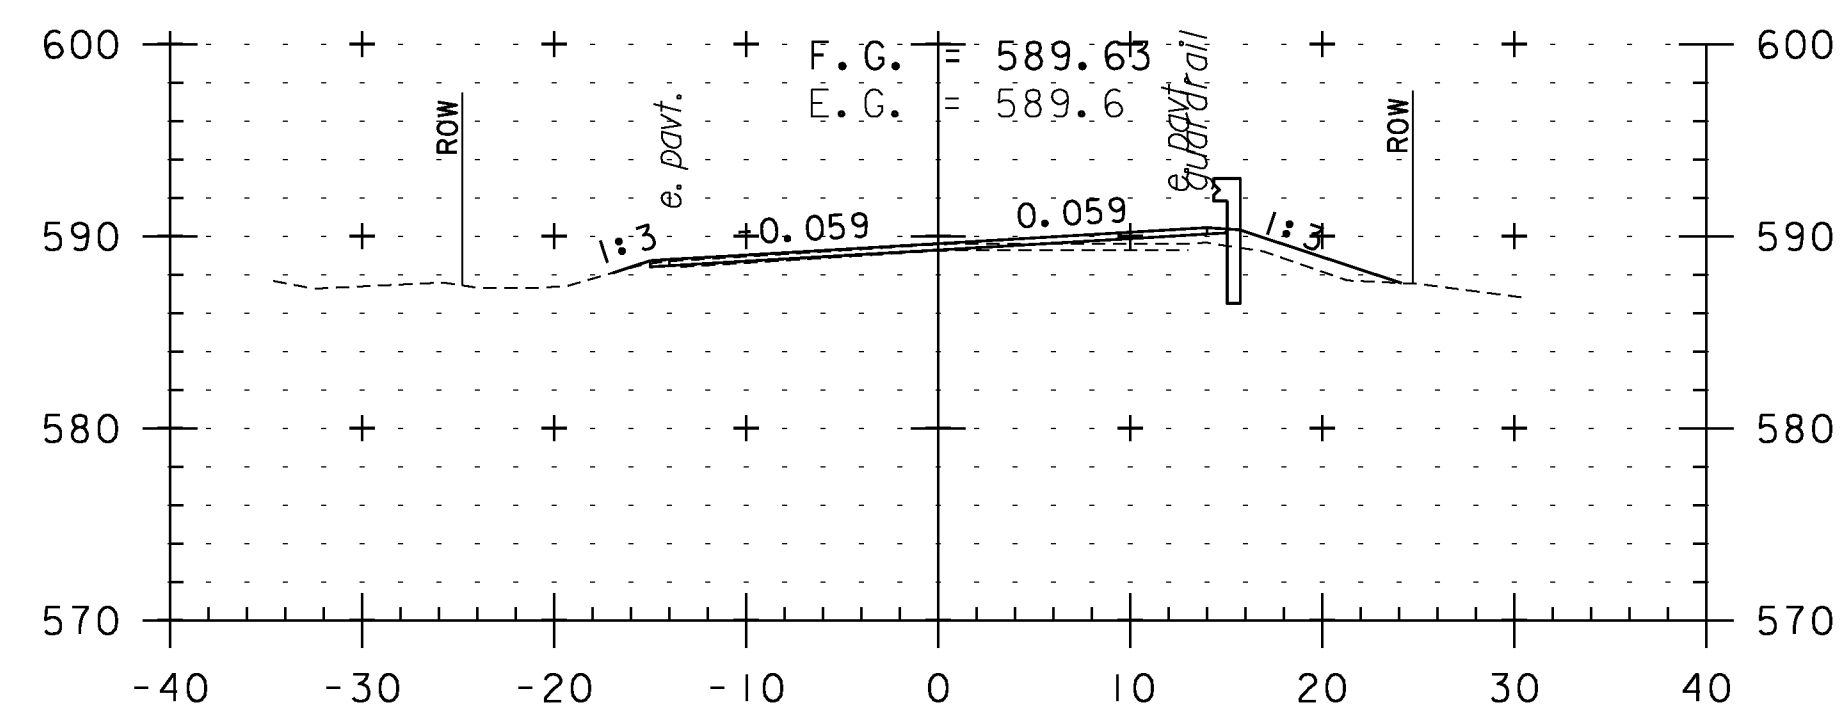


389+50

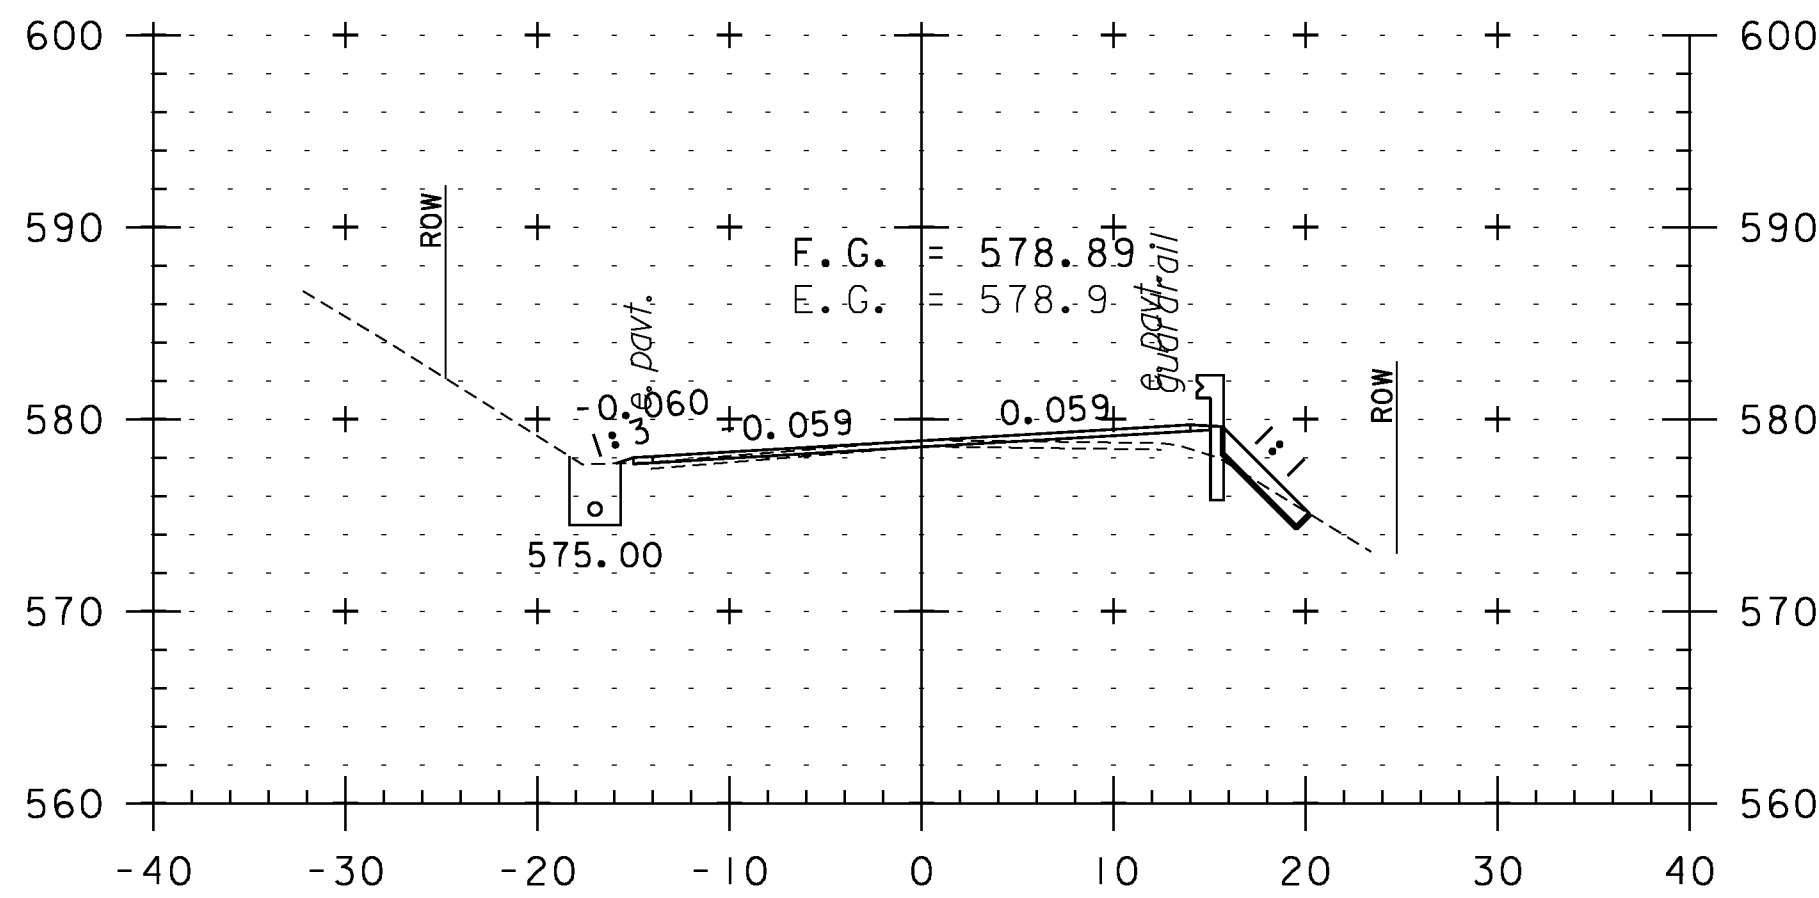


391+00

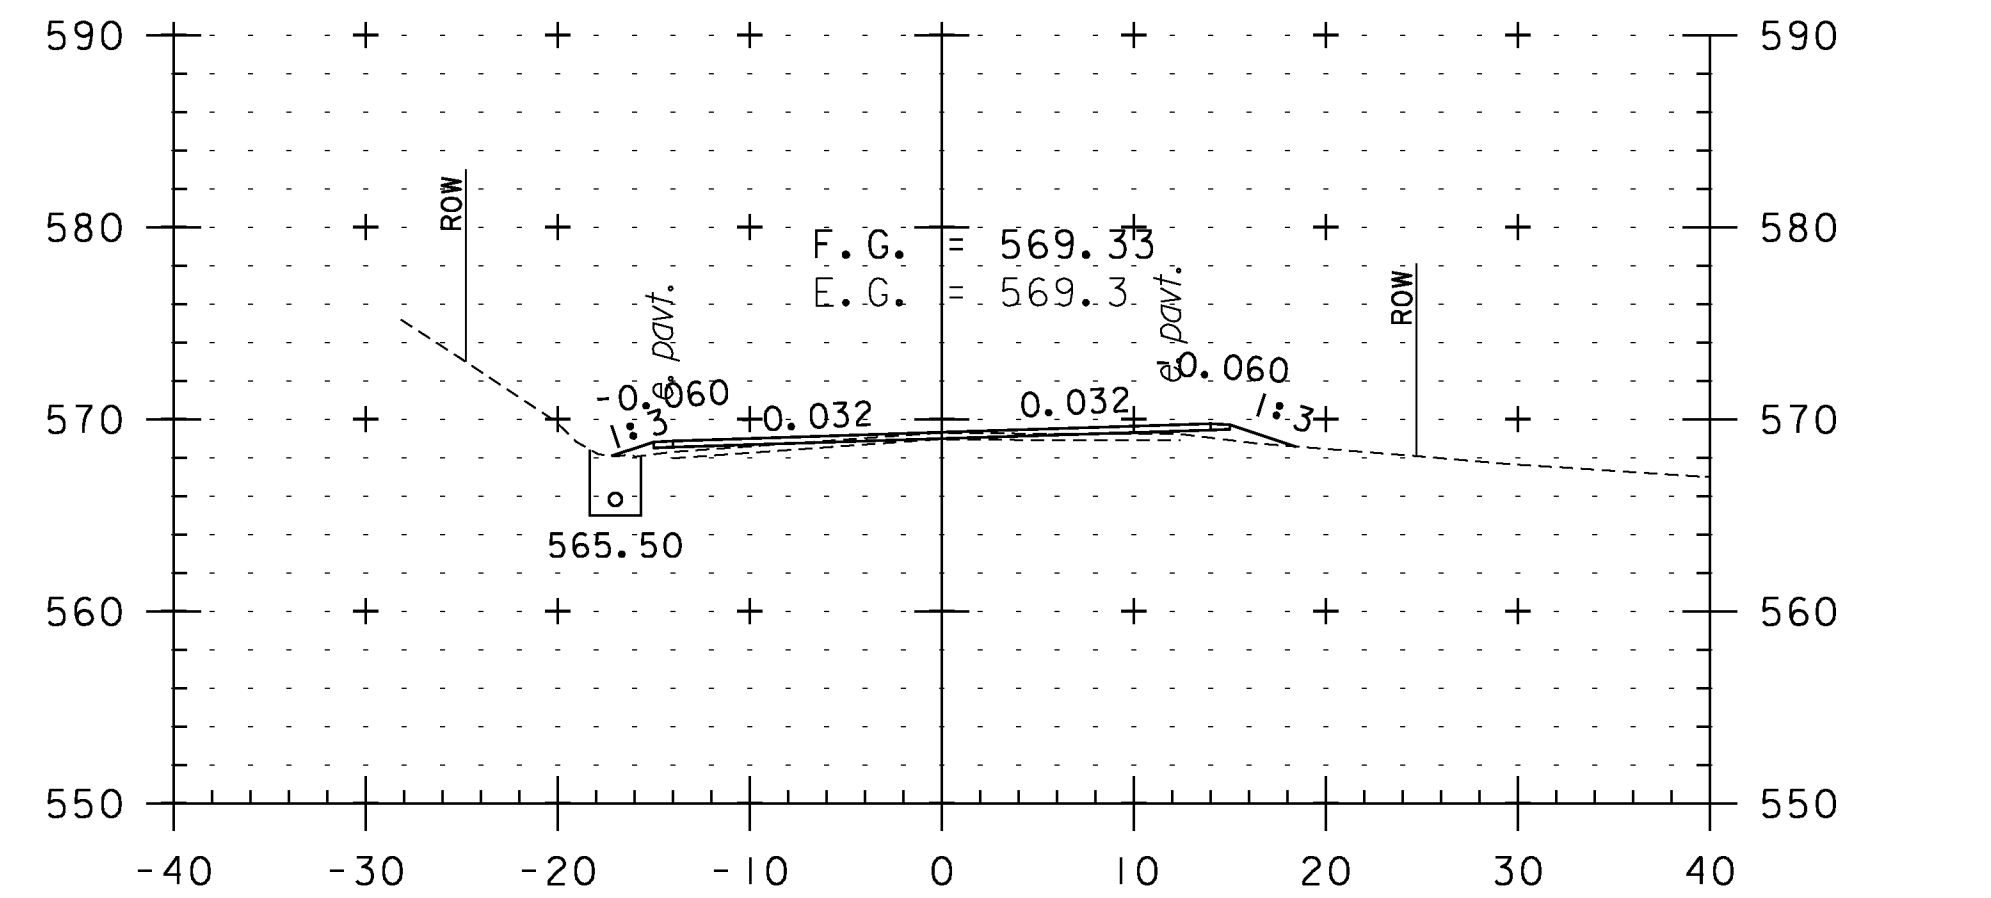


392+50

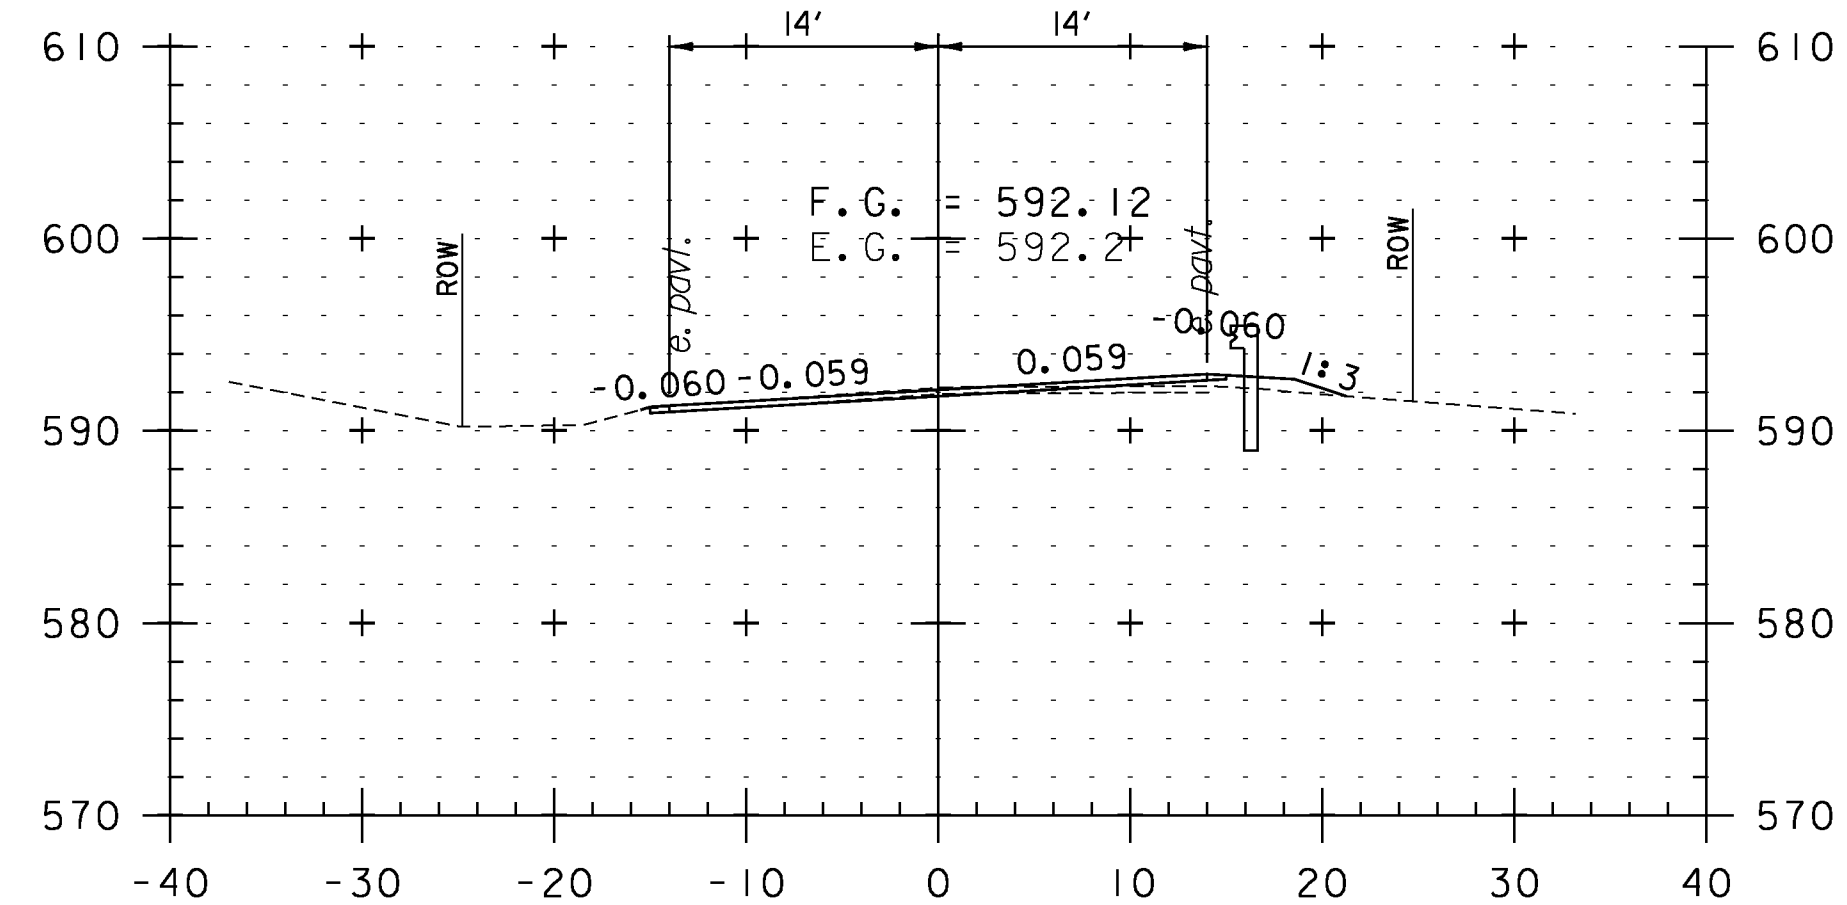

389+00

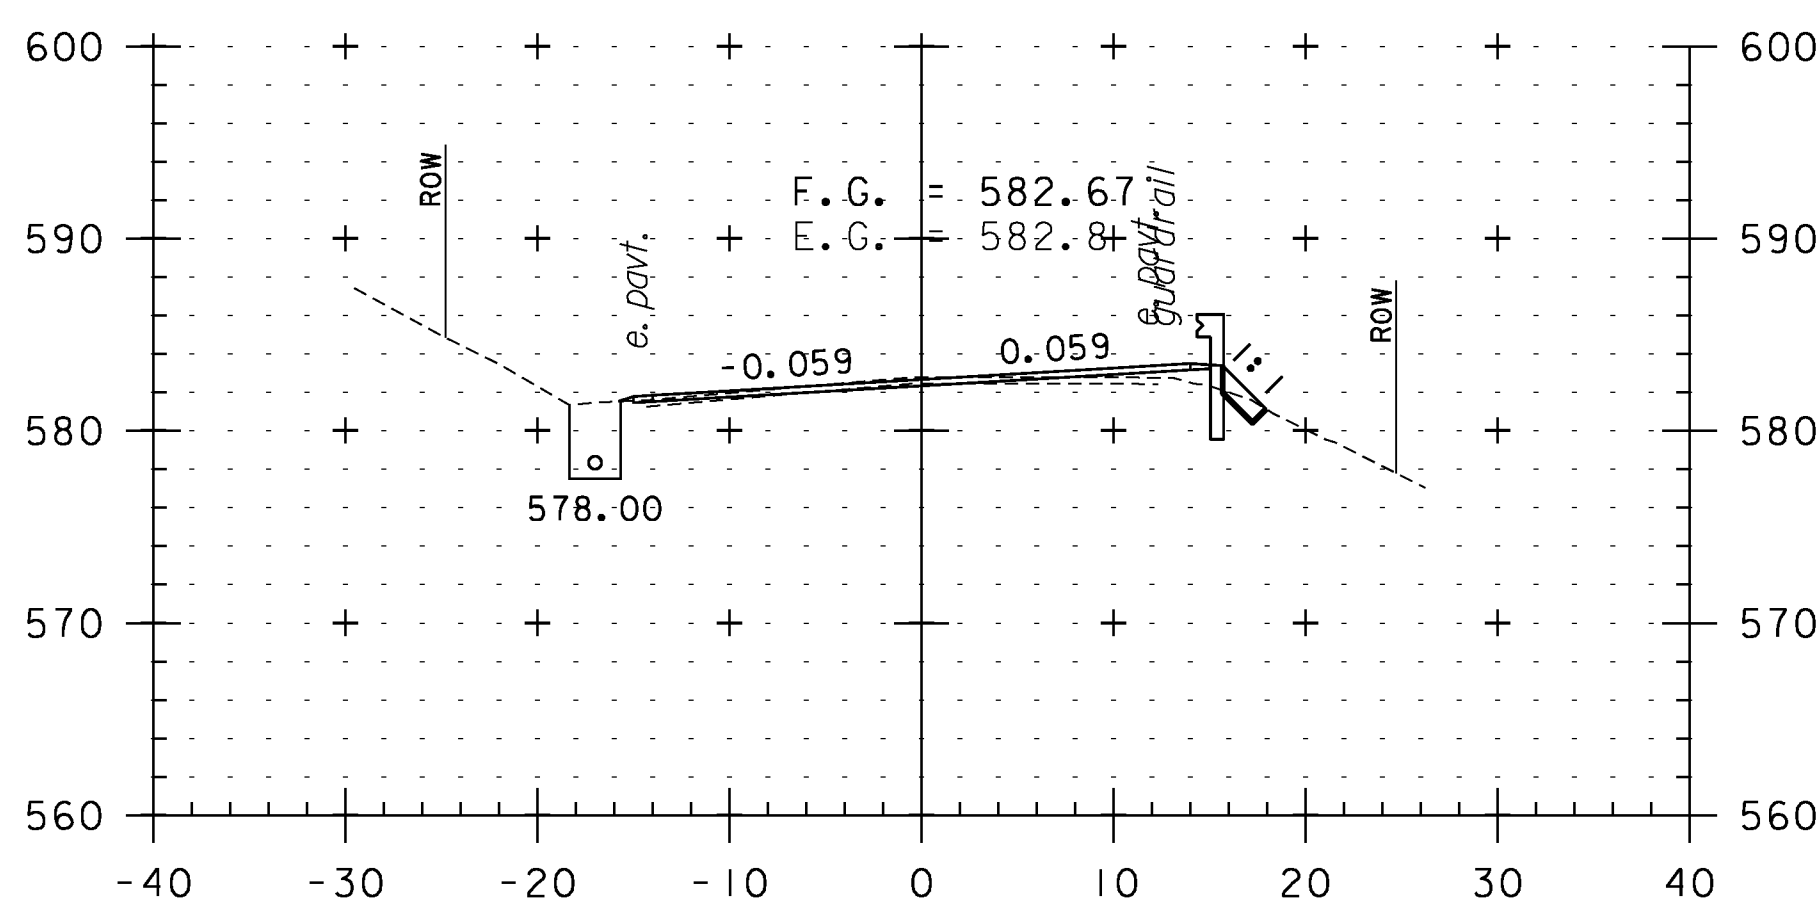

390+50

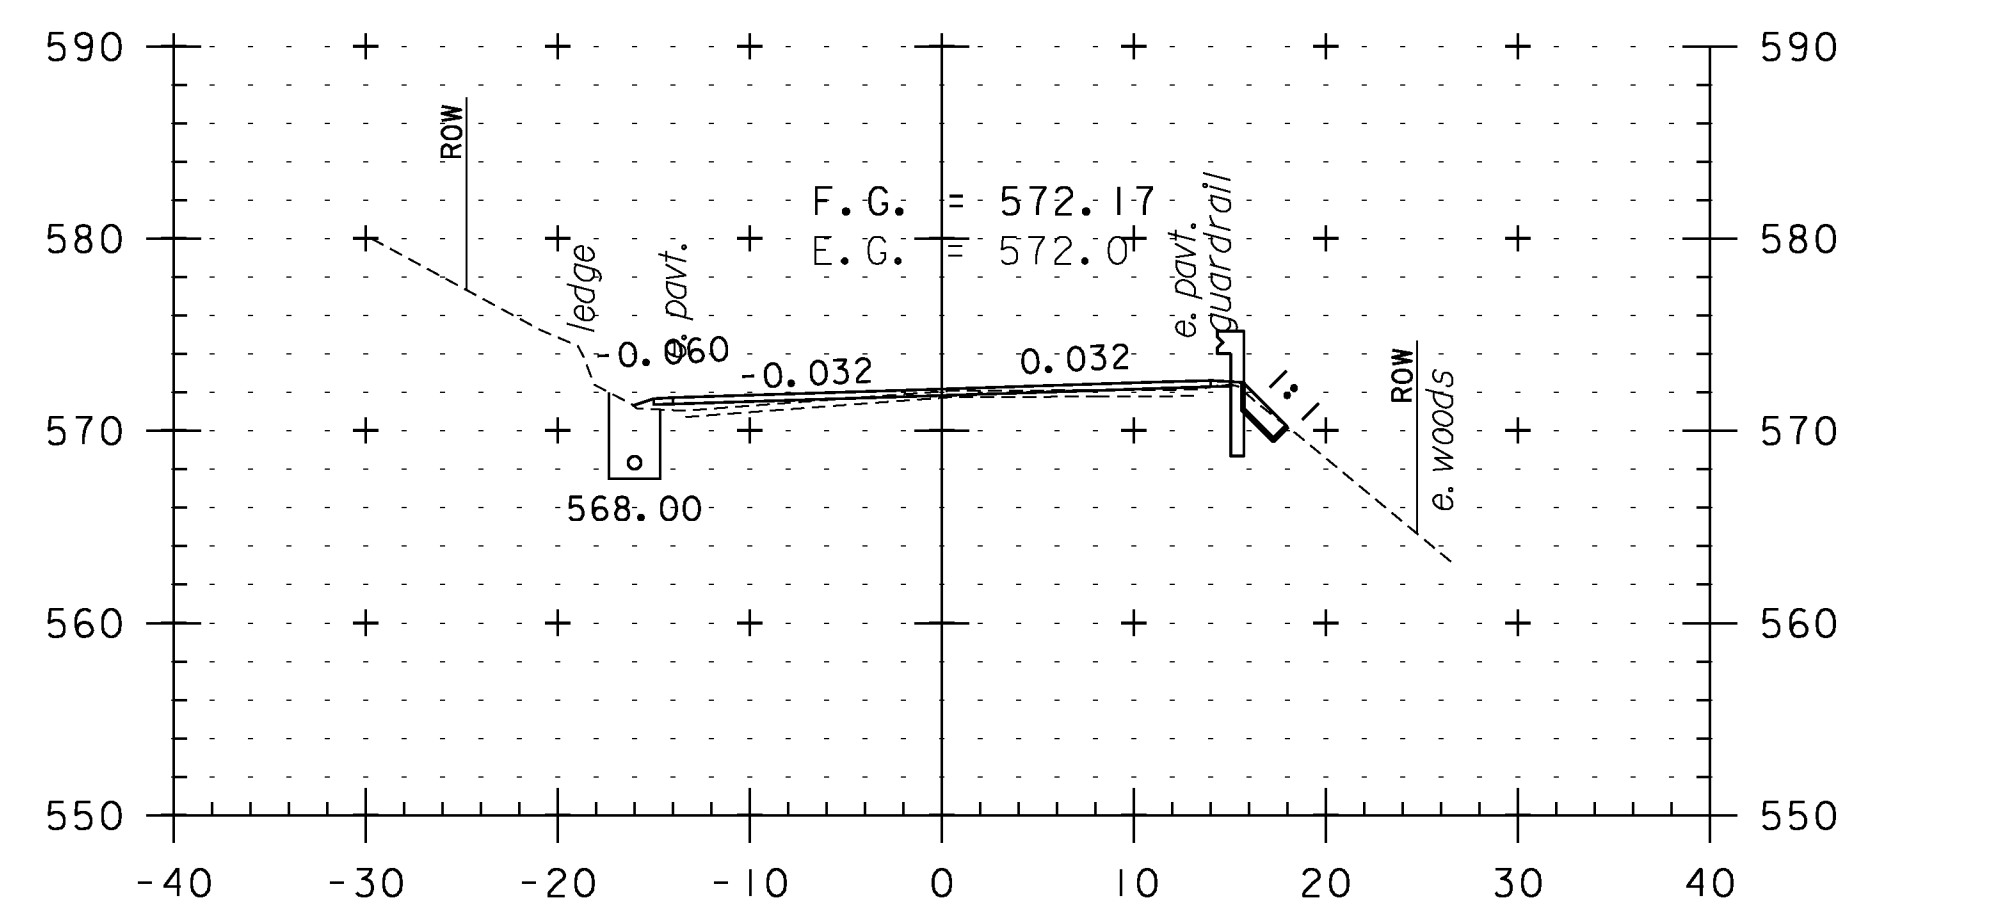

392+00

CROSS SECTION SHEET 77

PROJECT NAME: WEATHERSFIELD

PROJECT NUMBER: STP 2913(I)

FILE NAME: I0c228

PROJECT LEADER: PTS

DESIGNED BY: NLL

IPARM FILE NAME: pI0c228_167

PLOT DATE: 2/7/2013

DRAWN BY: WWG

CHECKED BY: PTS

SHEET 167 OF 234



STA. 389+00 TO STA. 392+53