




394+00

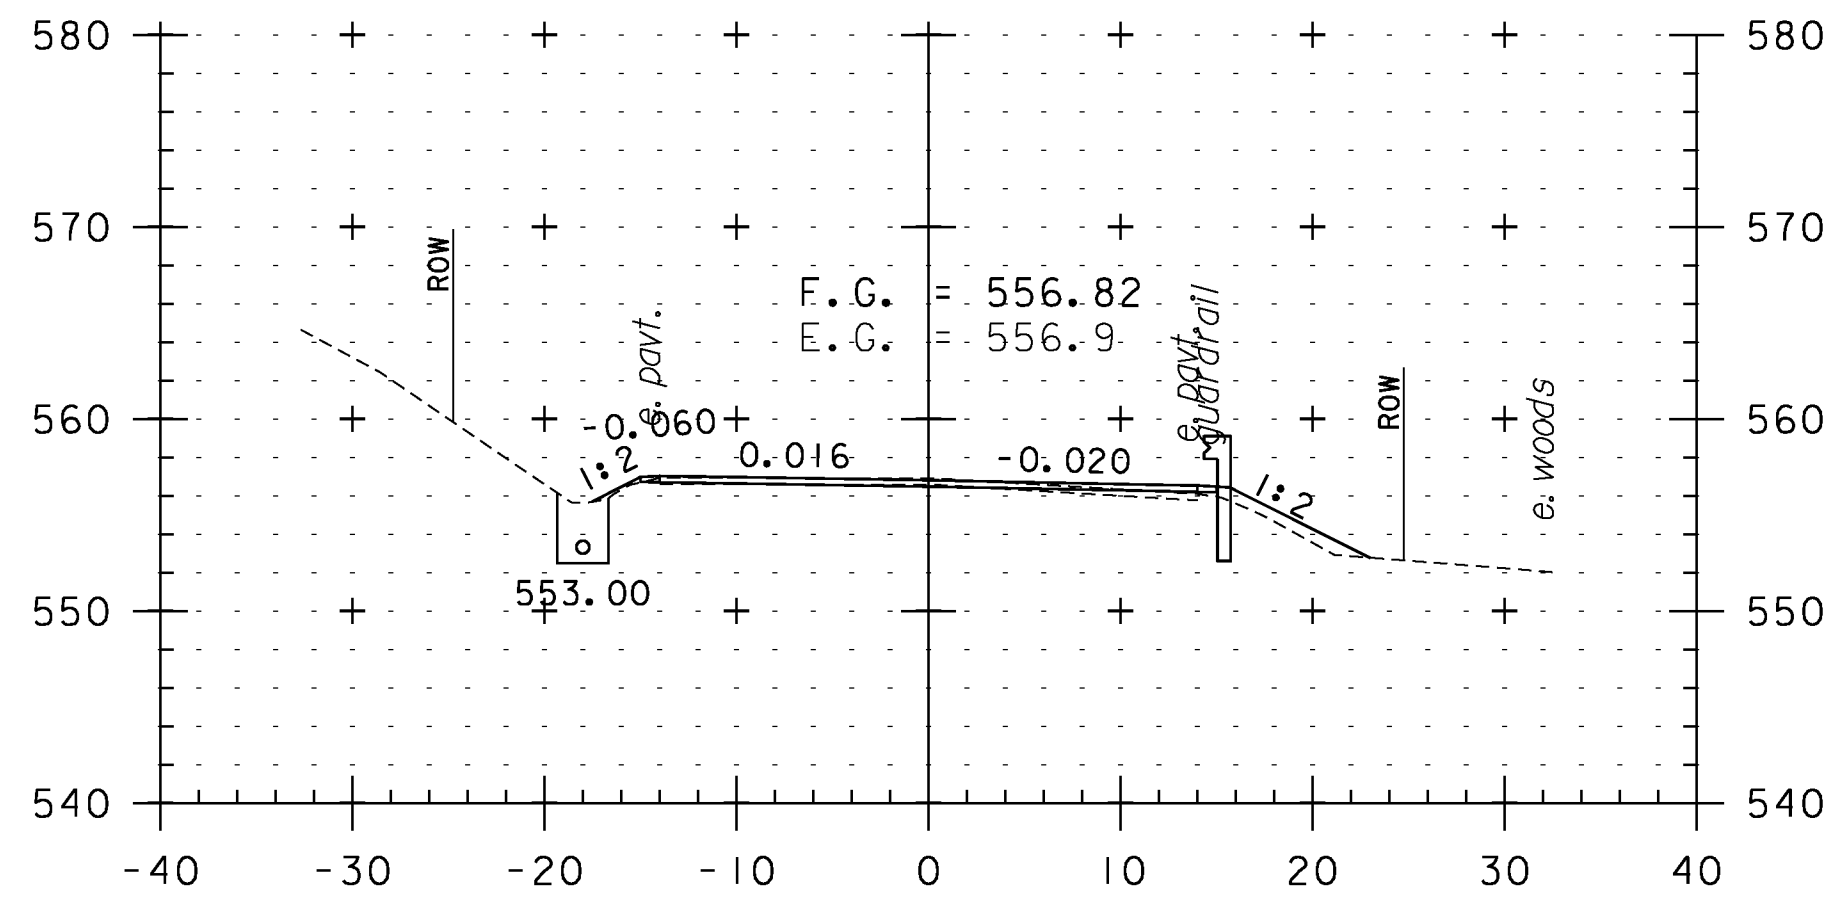


395+50

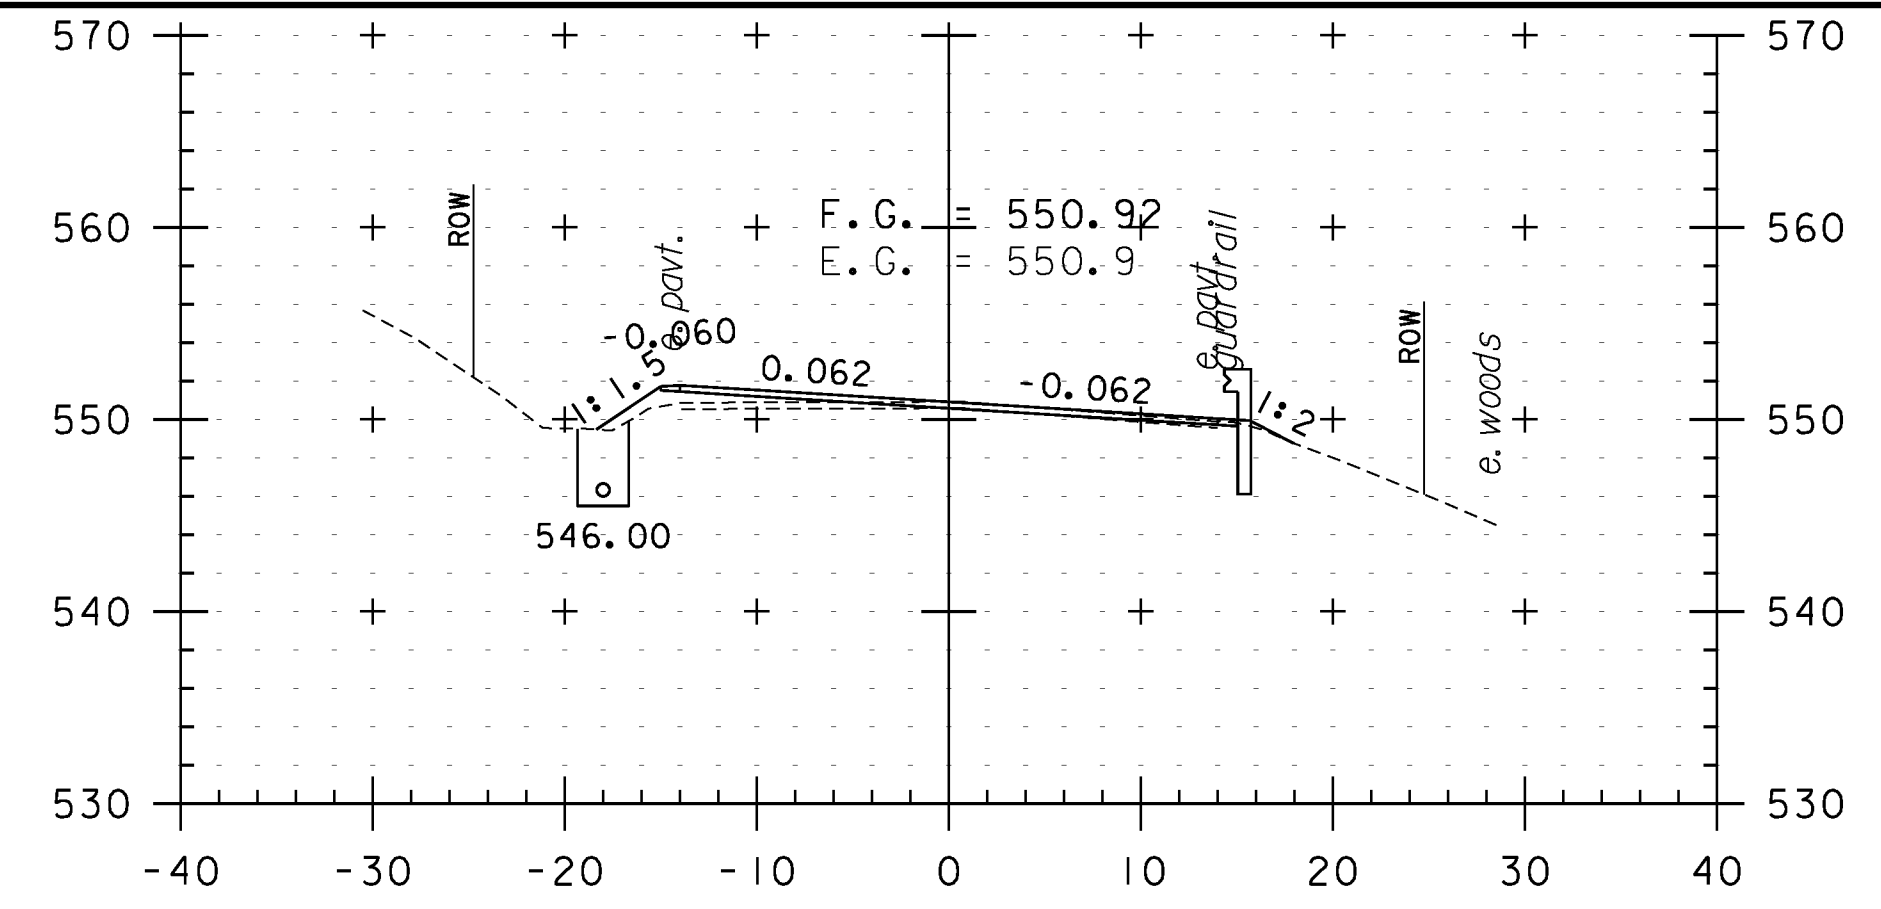


397+00

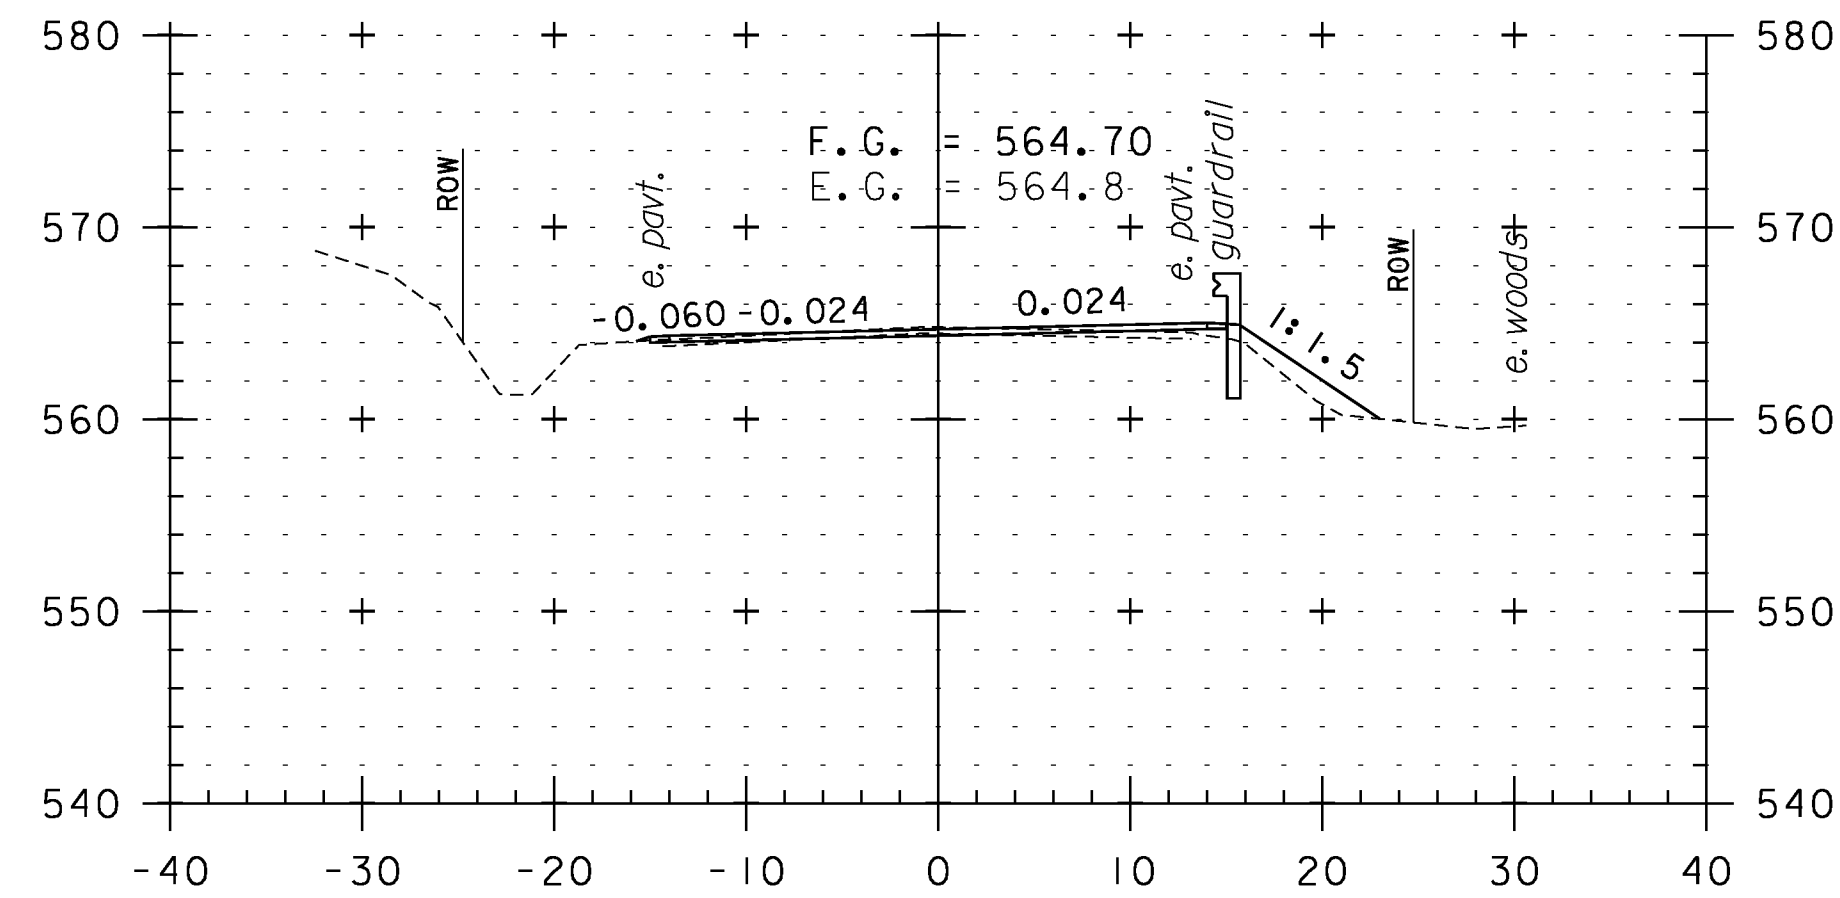


393+50

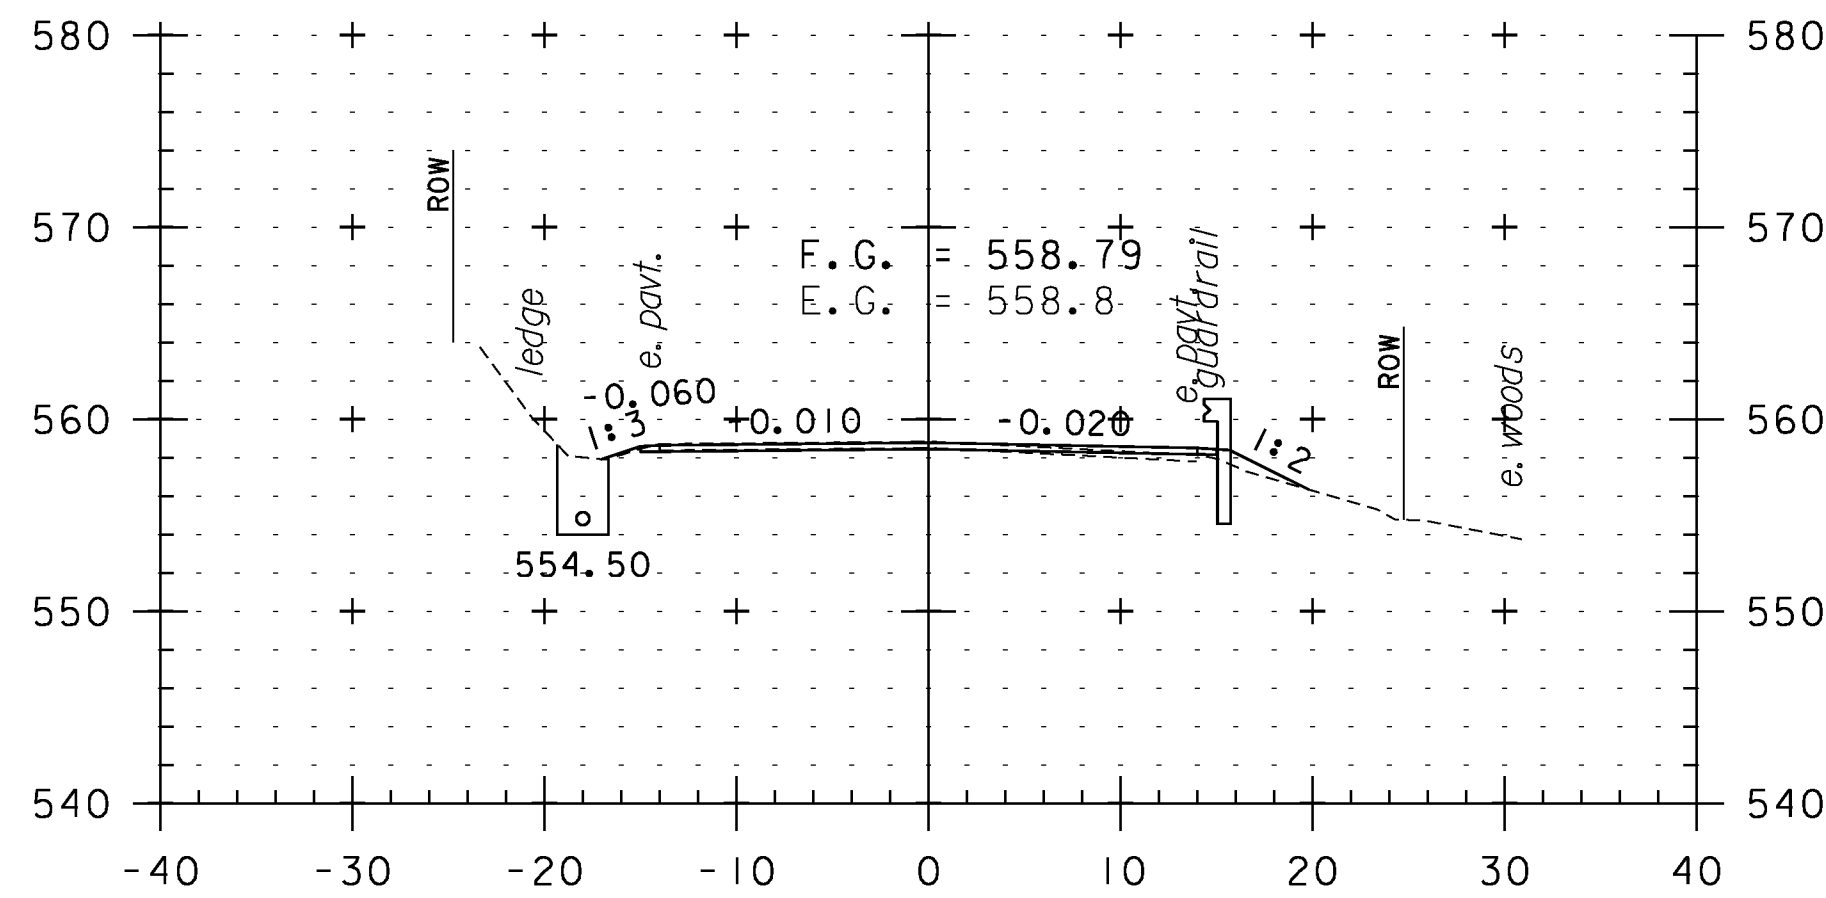


395+00

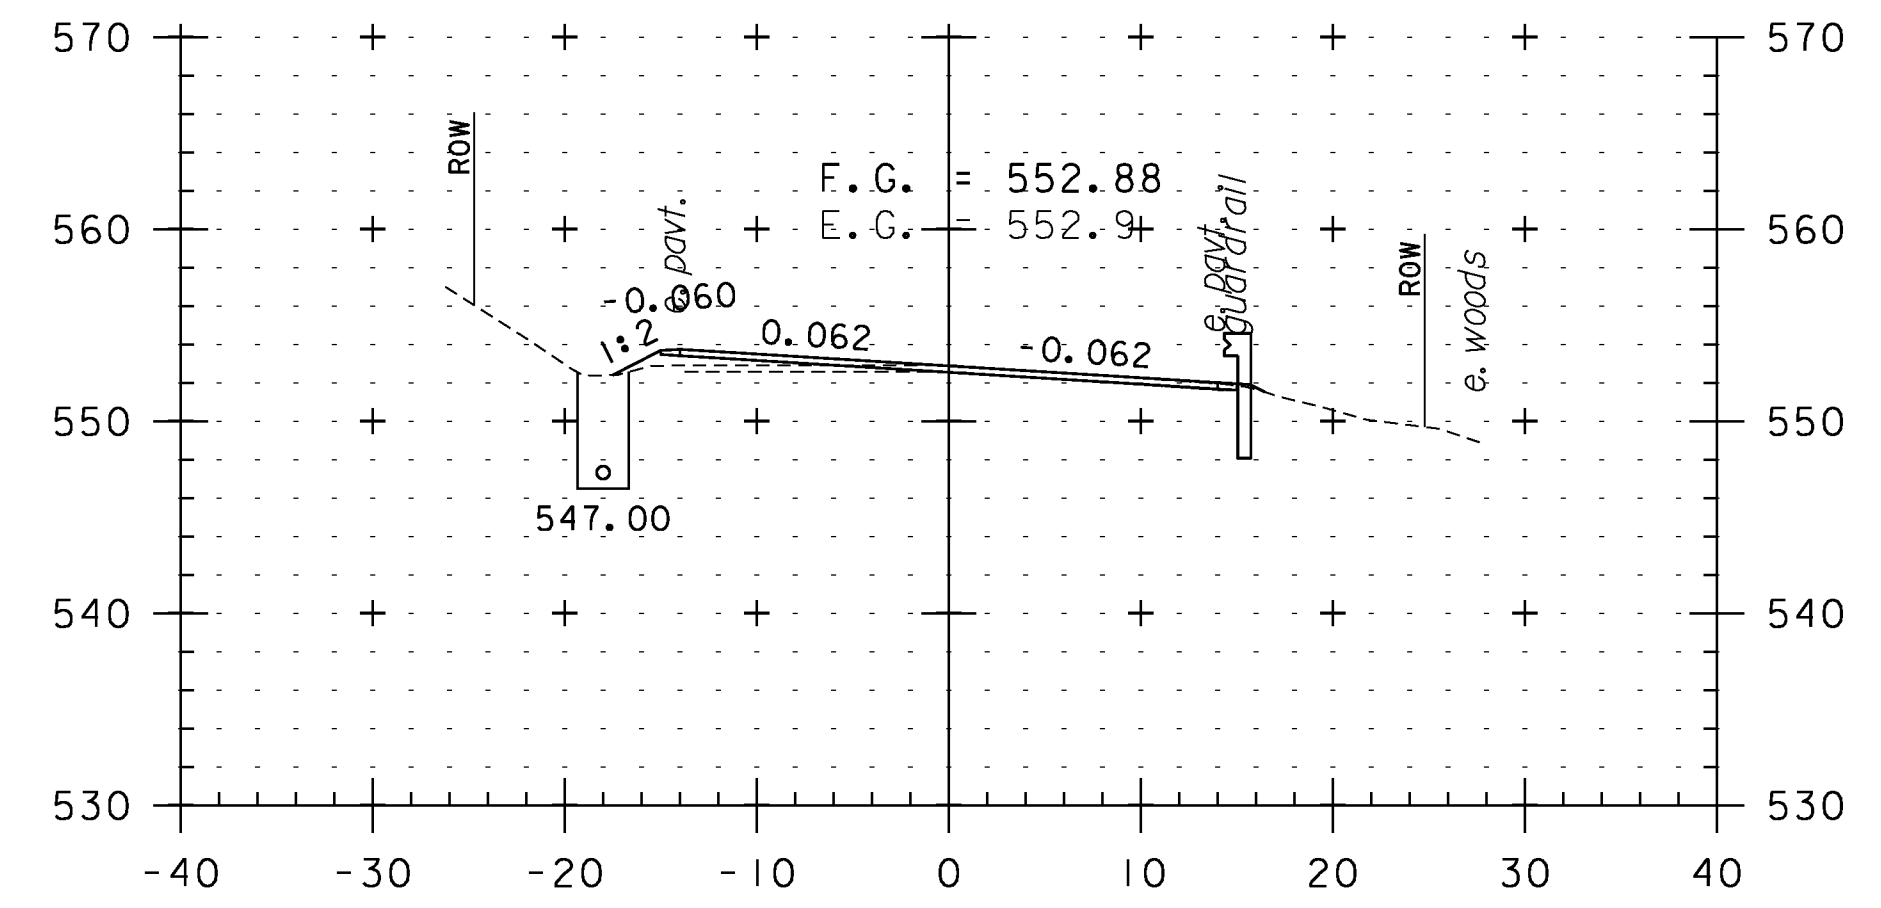


396+50

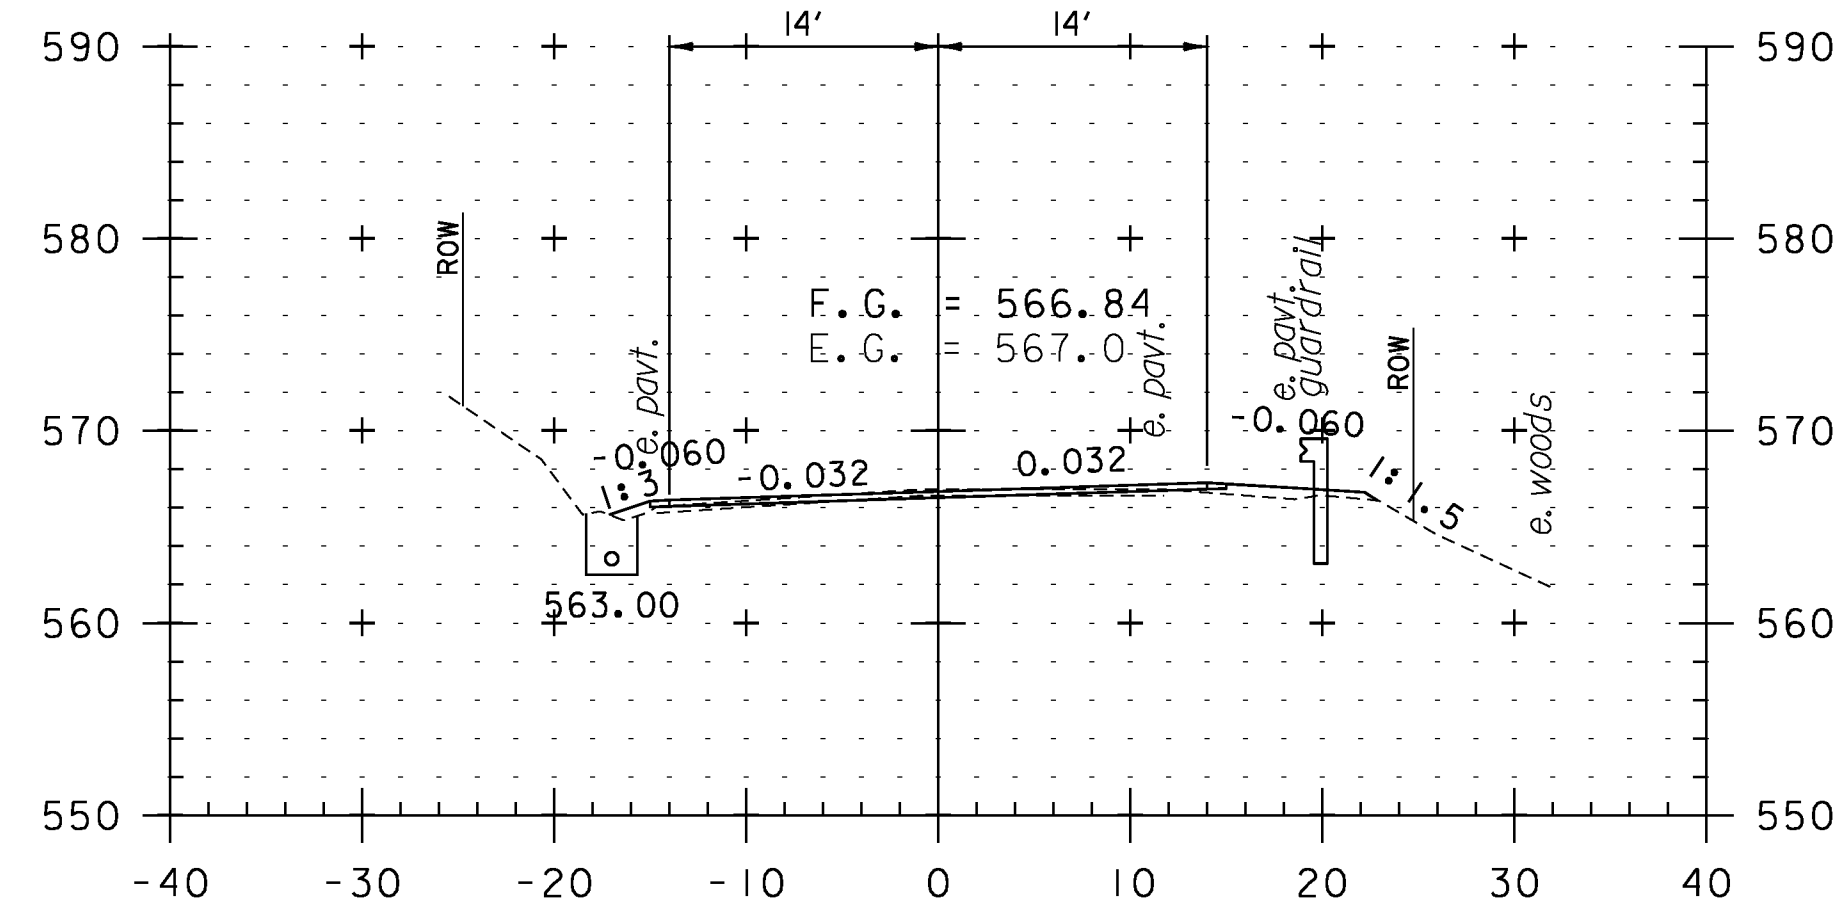

393+00

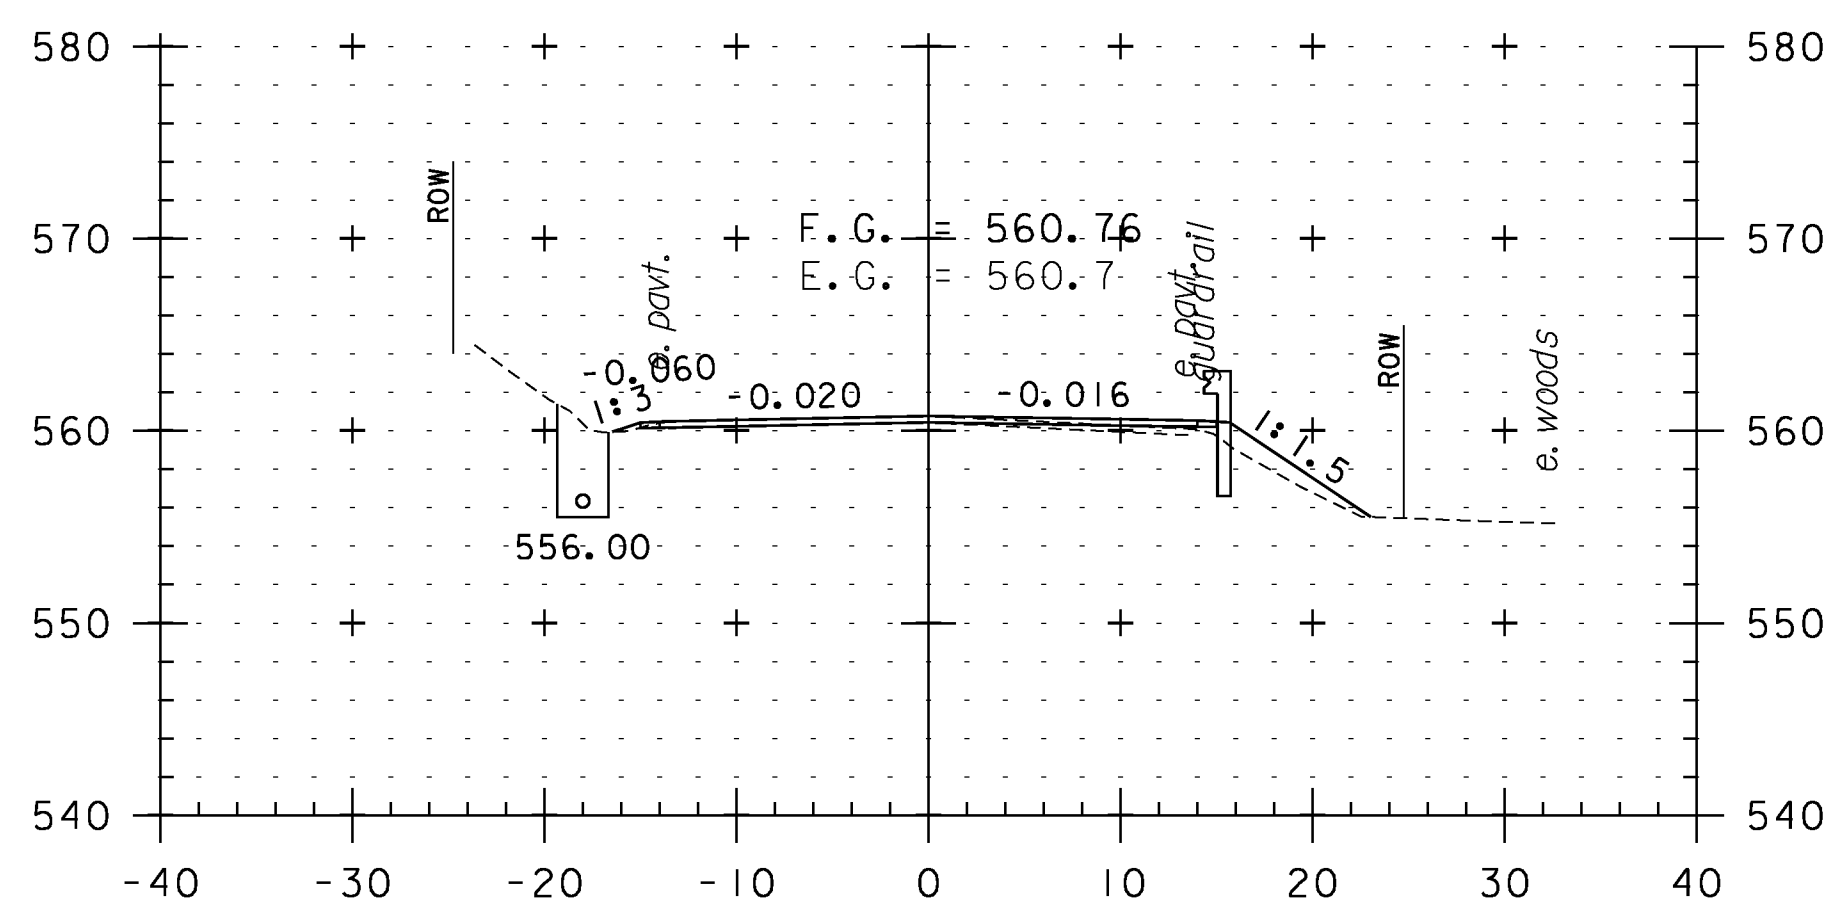

394+50

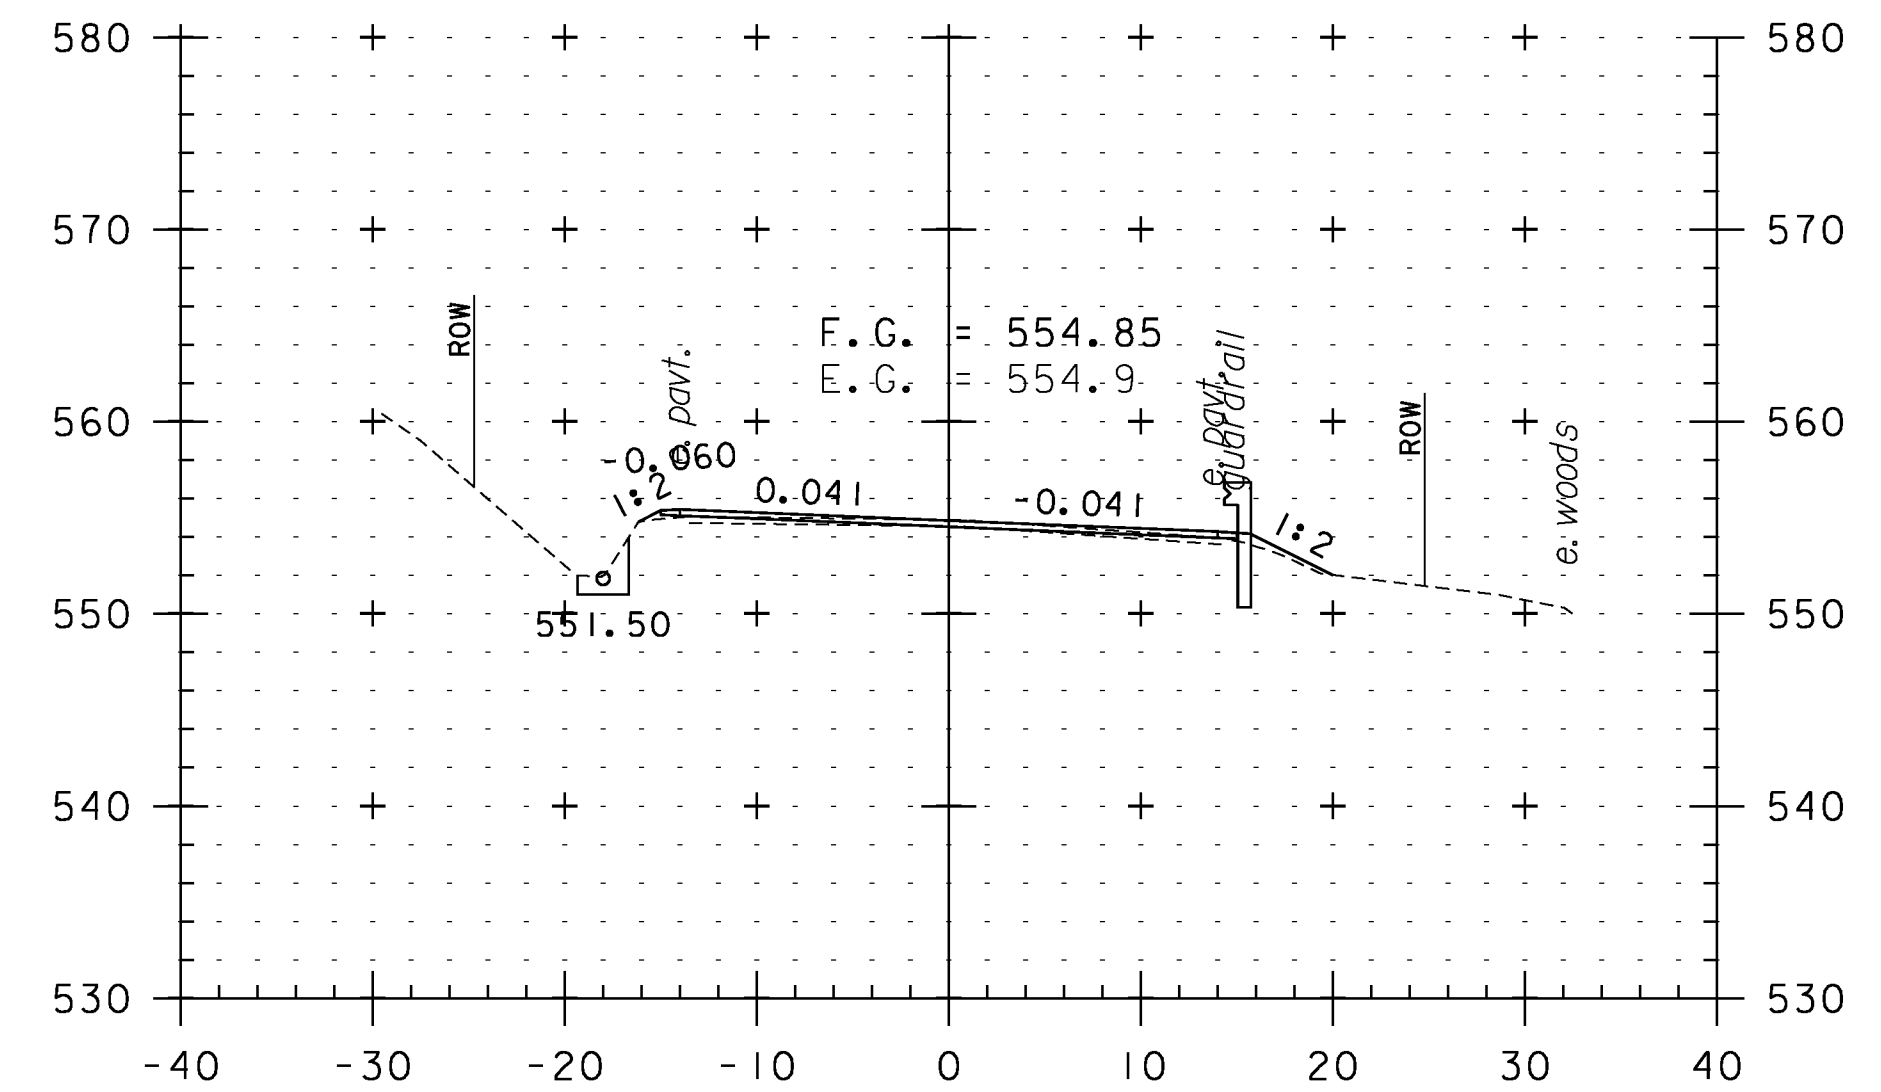

396+00

**CROSS SECTION SHEET 78**

PROJECT NAME: WEATHERSFIELD

PROJECT NUMBER: STP 2913(I)

FILE NAME: I0c228

PROJECT LEADER: PTS

DESIGNED BY: NLL


IPARM FILE NAME: pI0c228.l68

PLOT DATE: 2/7/2013

DRAWN BY: WWG

CHECKED BY: PTS

SHEET 168 OF 234

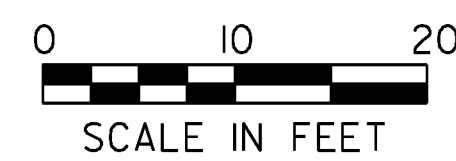

STA. 393+00 TO STA. 397+00