




398+50

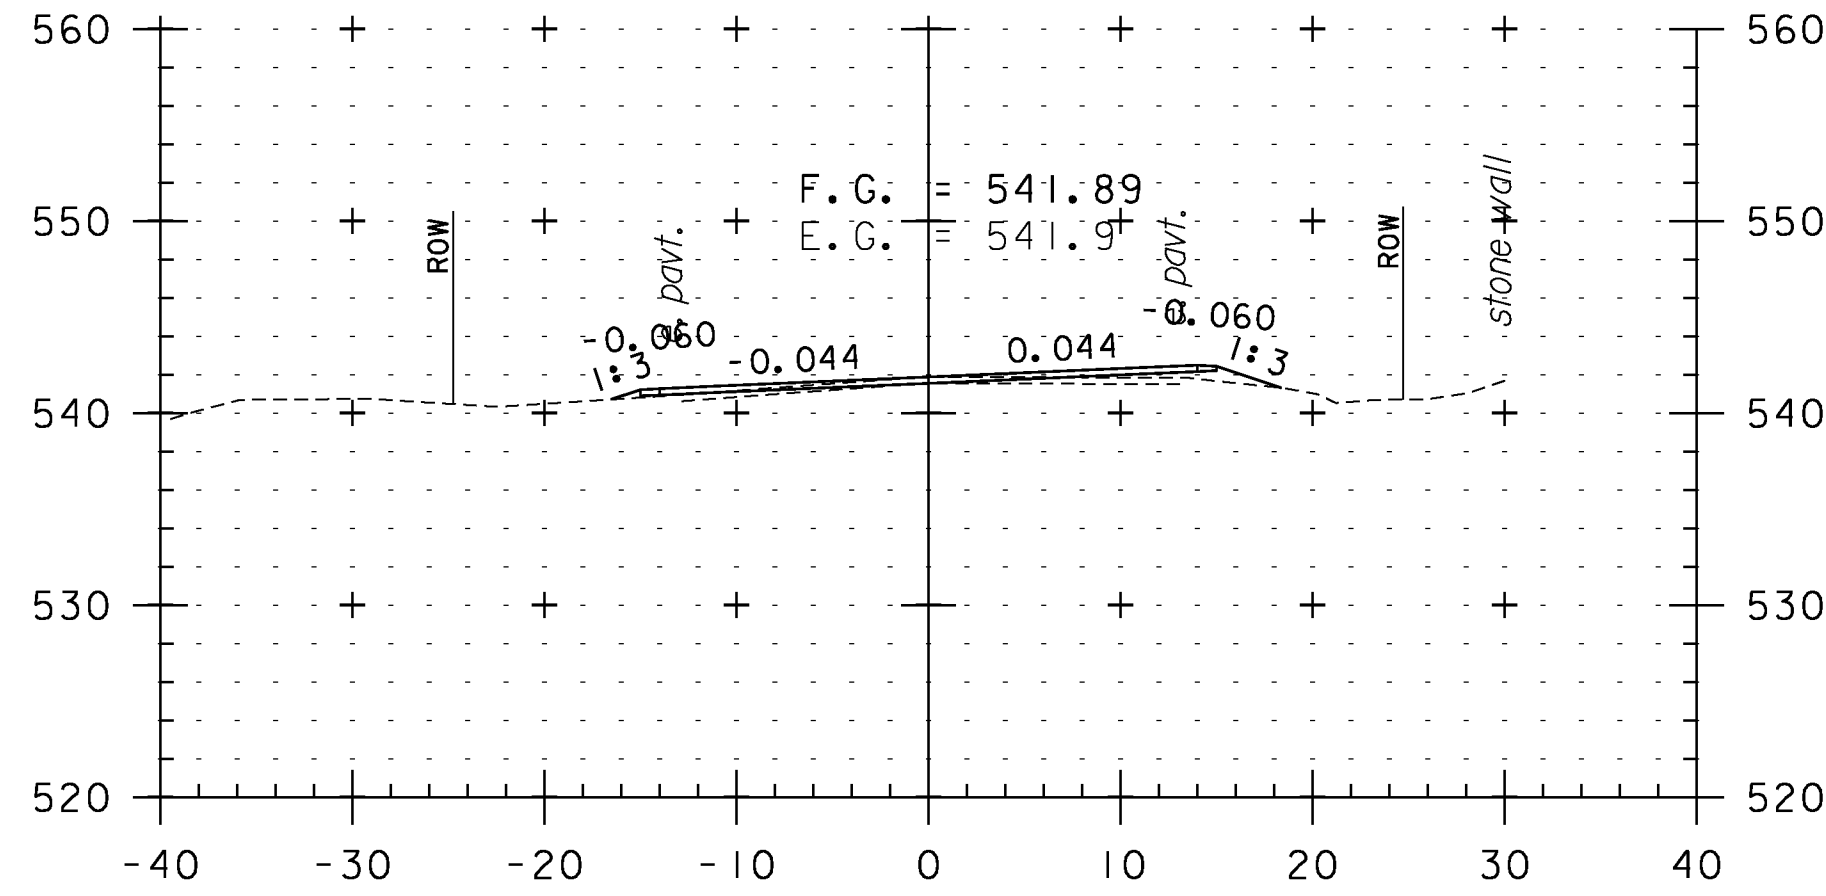


400+00

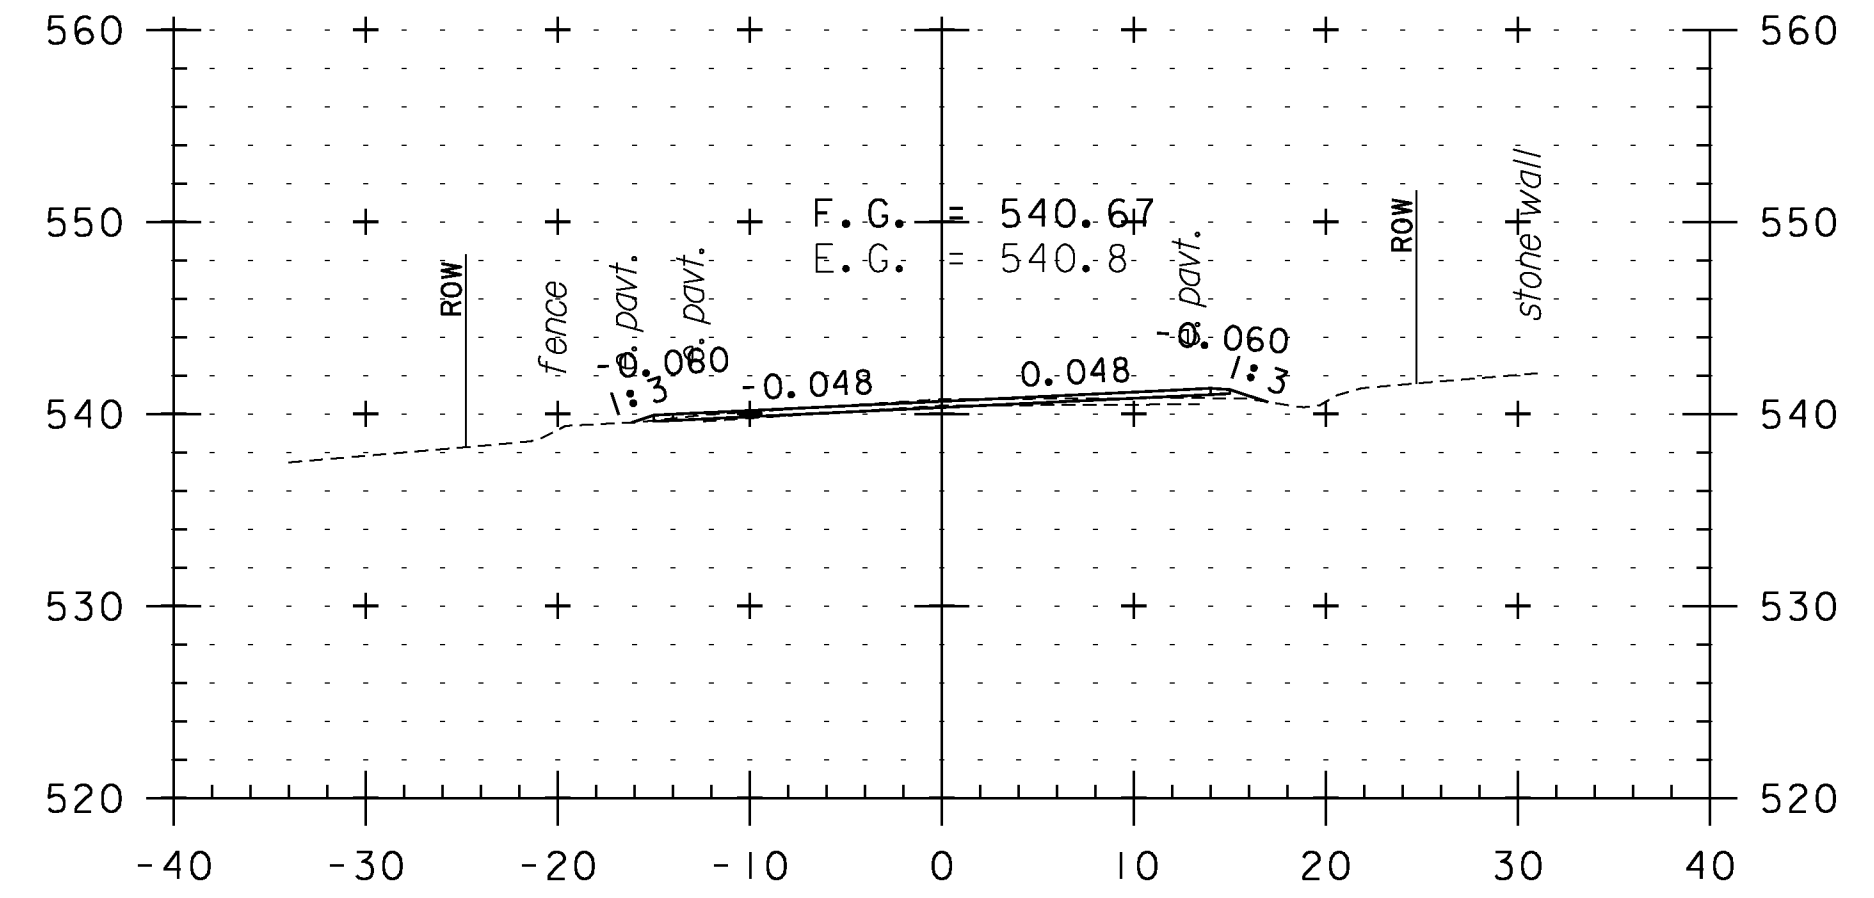


401+00

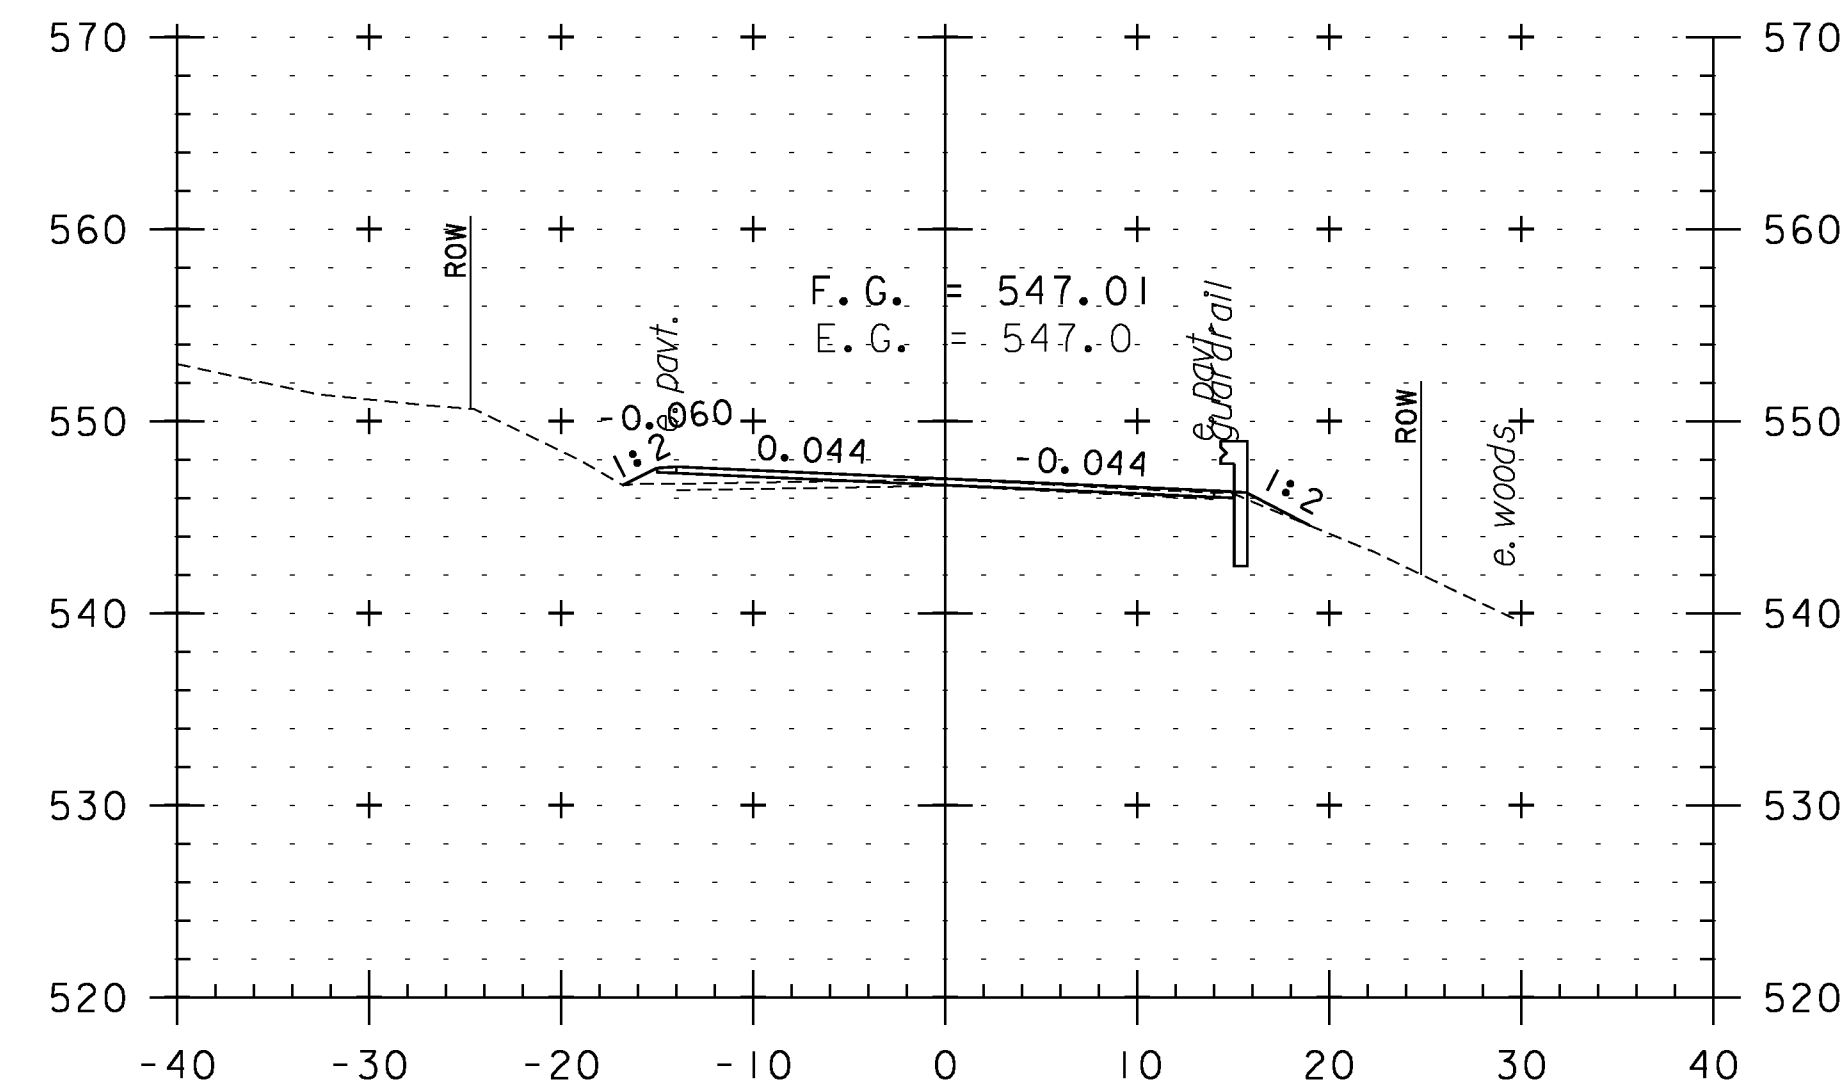


398+00

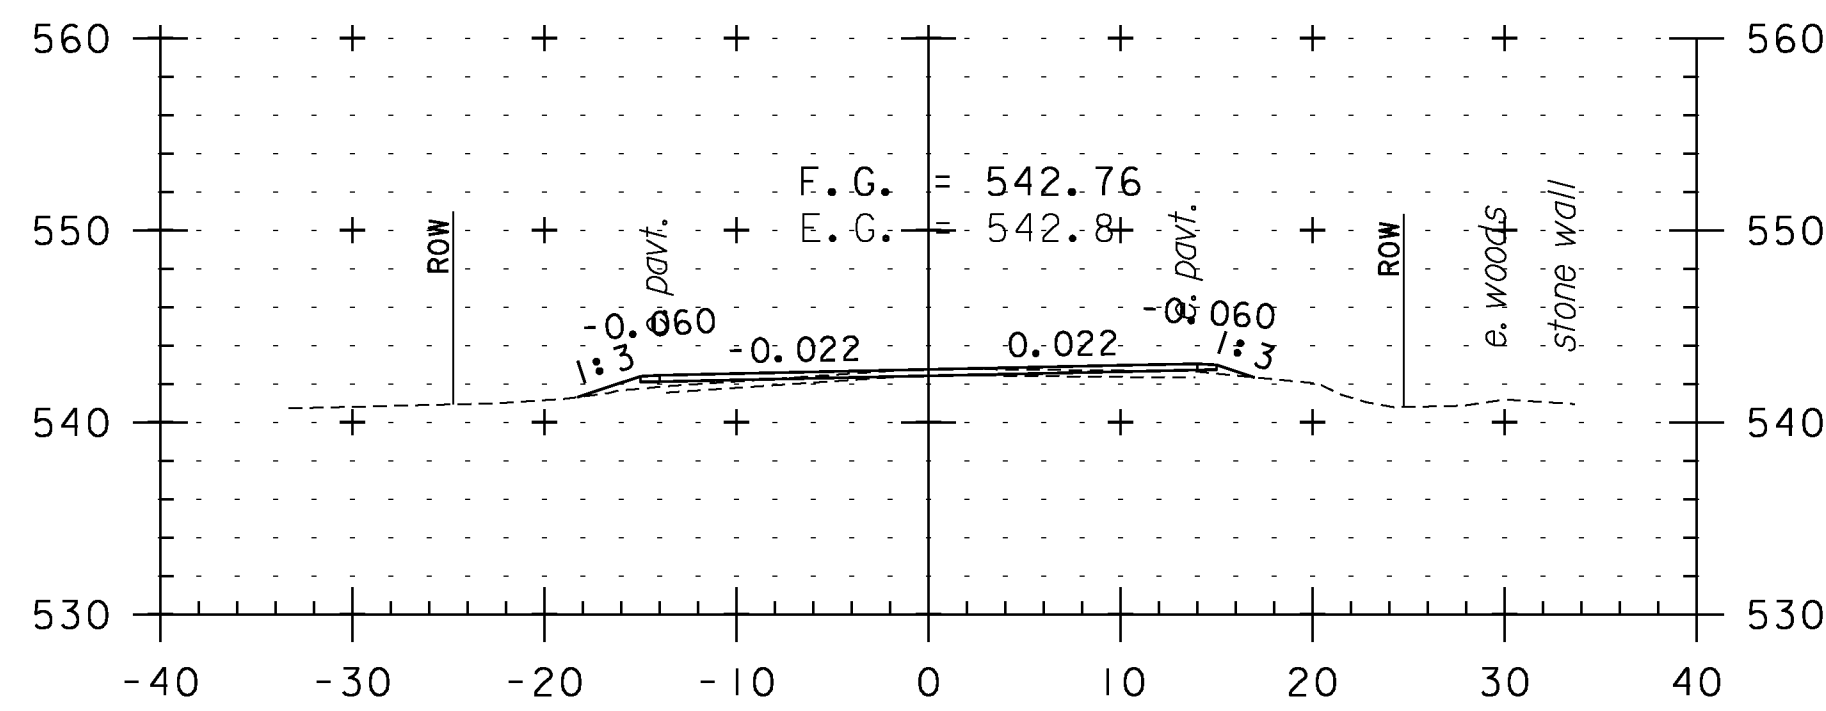


399+50

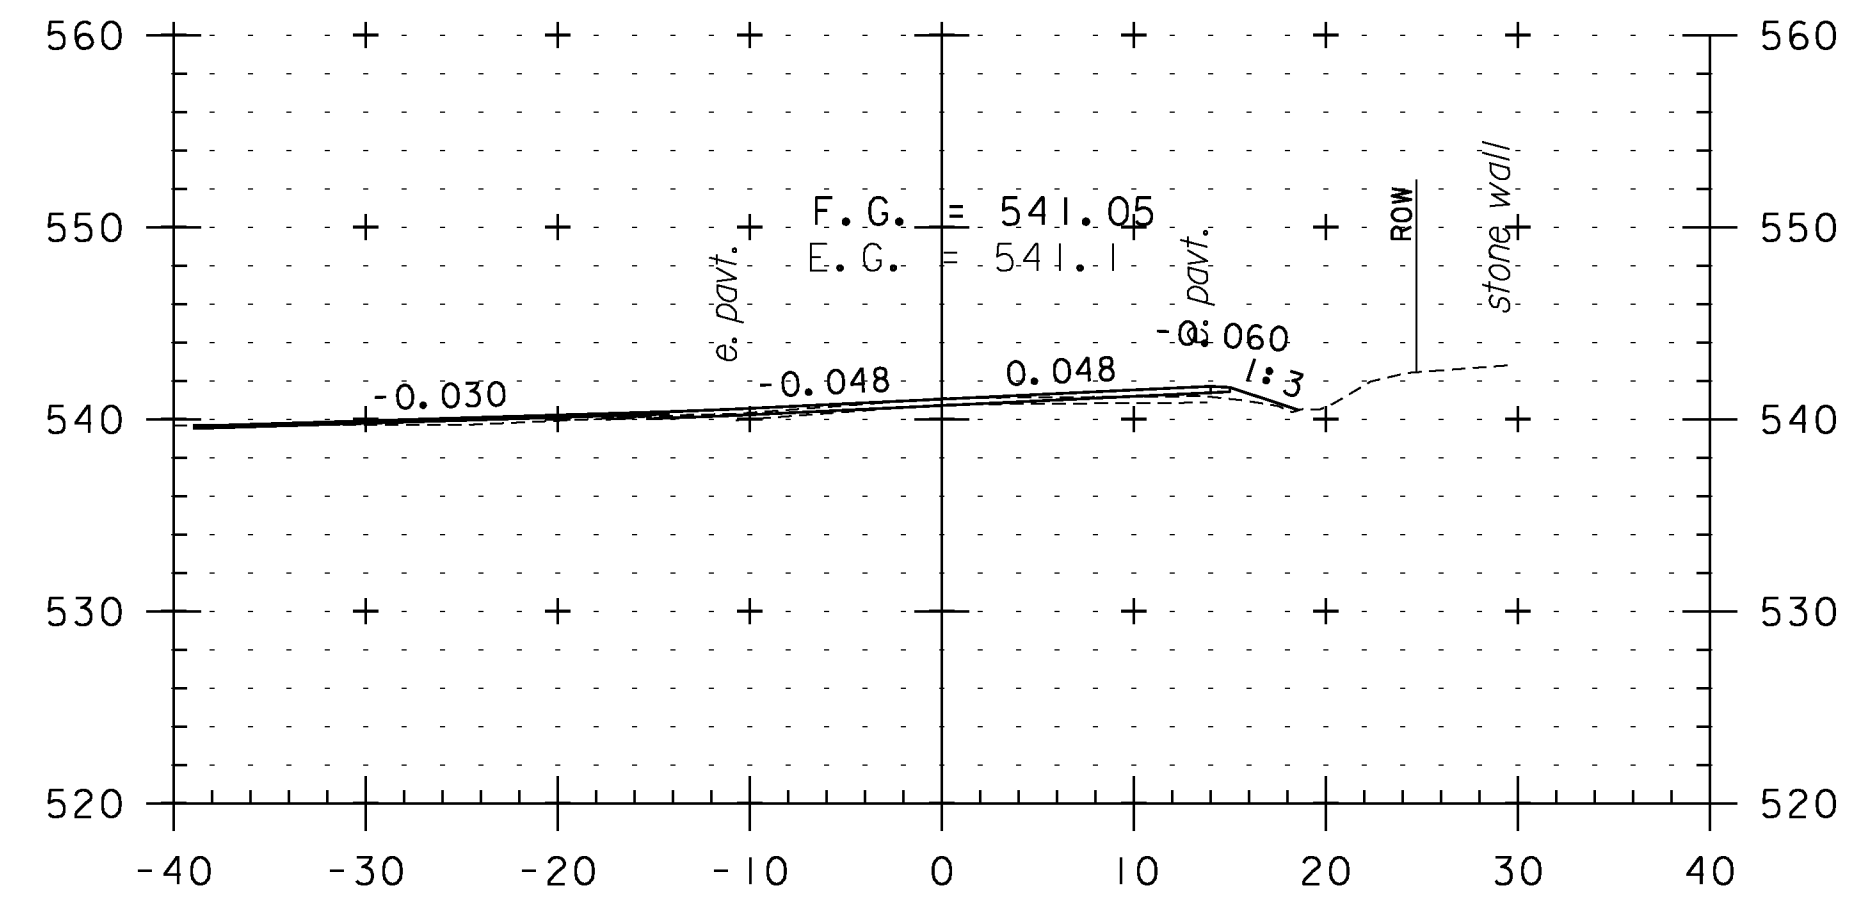


400+65
TH 88

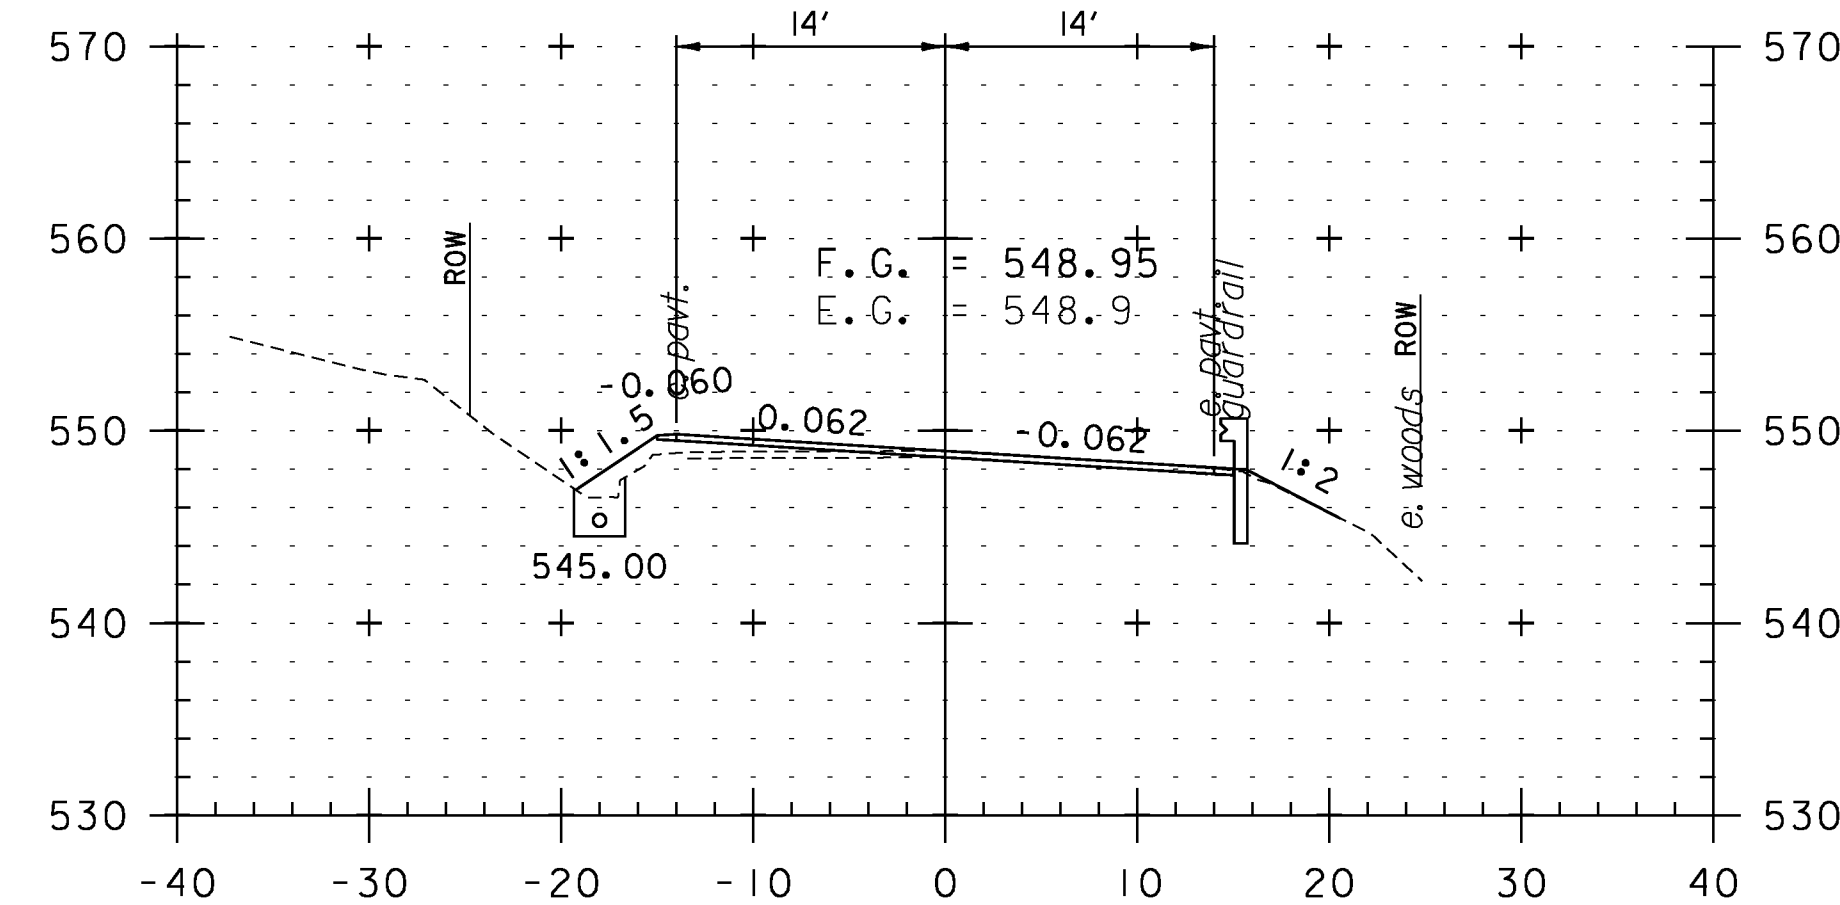

397+50

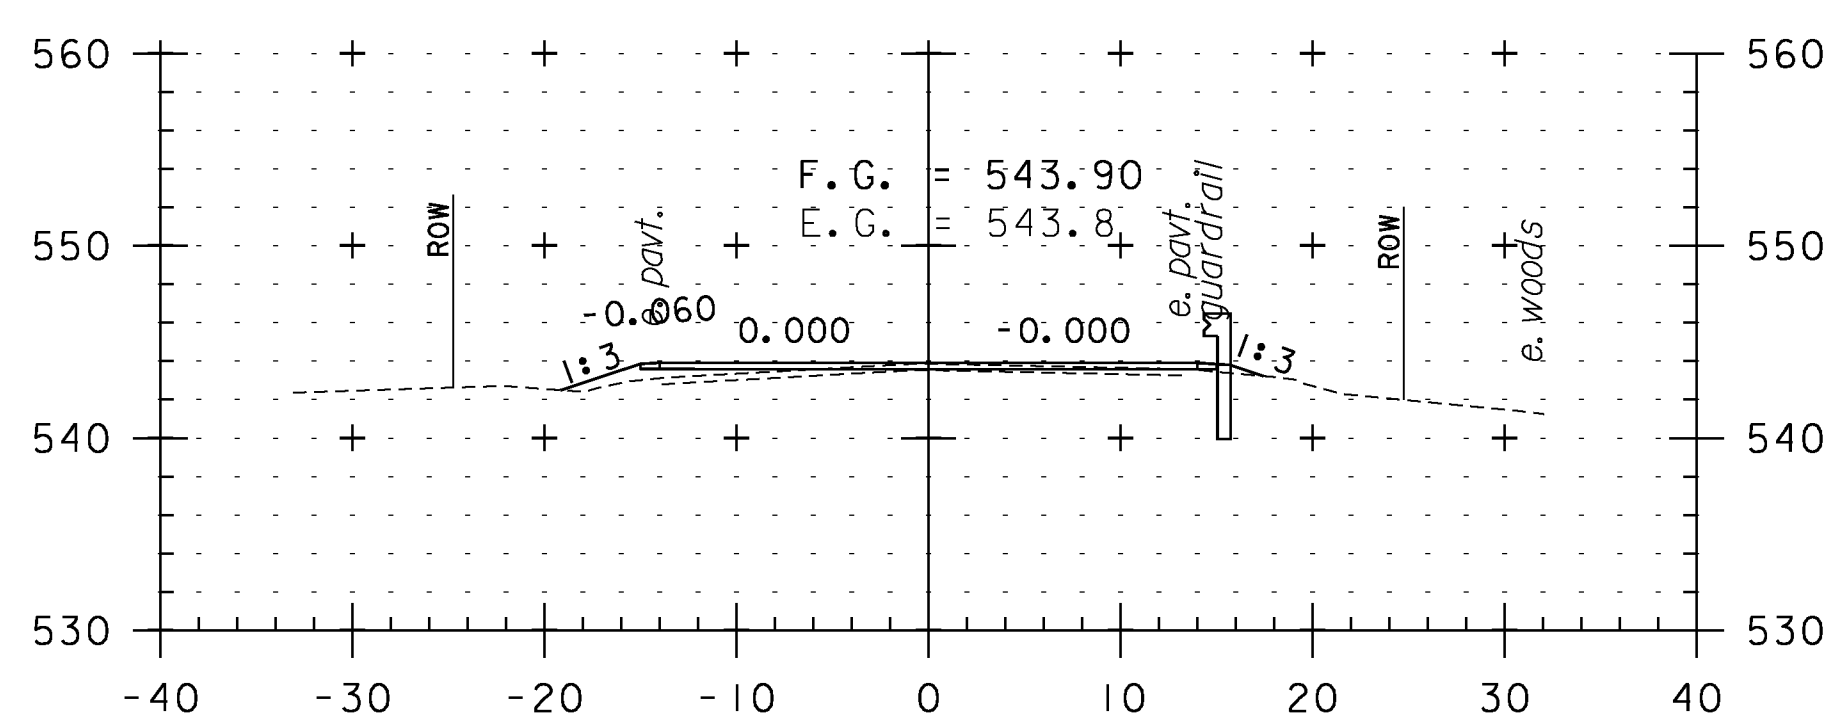

399+00

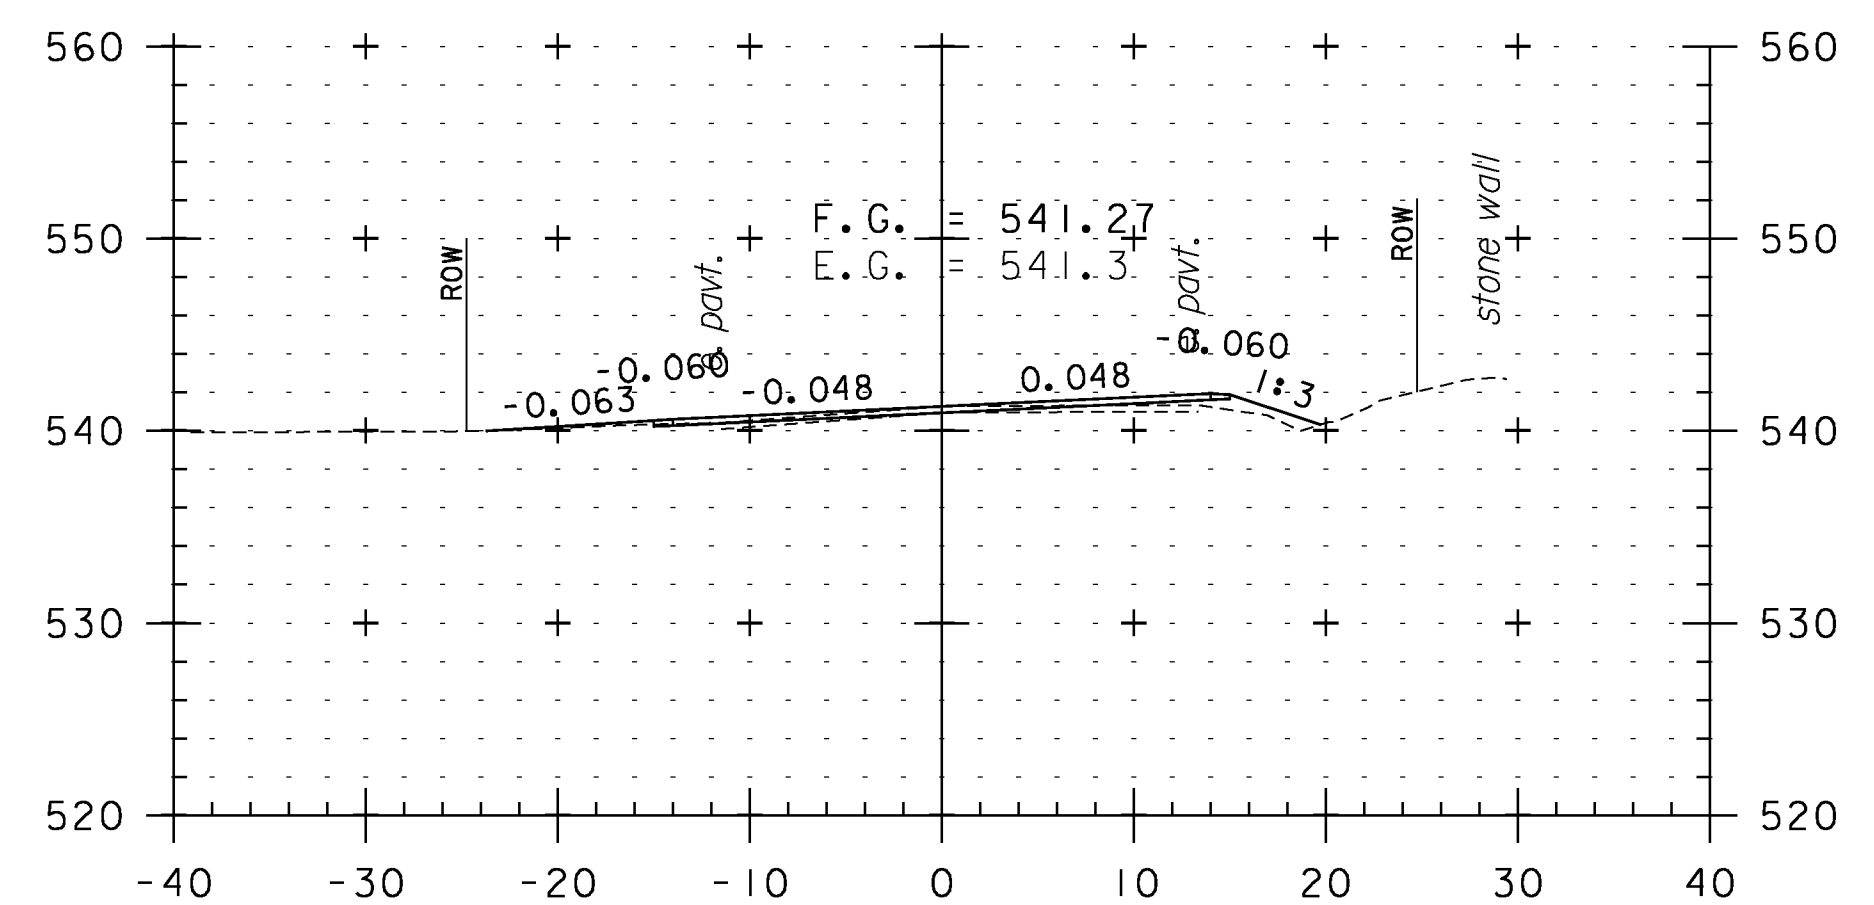

400+50

CROSS SECTION SHEET 79

PROJECT NAME: WEATHERSFIELD

PROJECT NUMBER: STP 2913(I)

FILE NAME: I0c228

PROJECT LEADER: PTS

DESIGNED BY: NLL


IPARM FILE NAME: pI0c228.l69

PLOT DATE: 2/7/2013

DRAWN BY: WWG

CHECKED BY: PTS

SHEET 169 OF 234

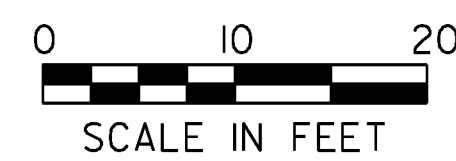

STA. 397+50 TO STA. 401+00