




415+50

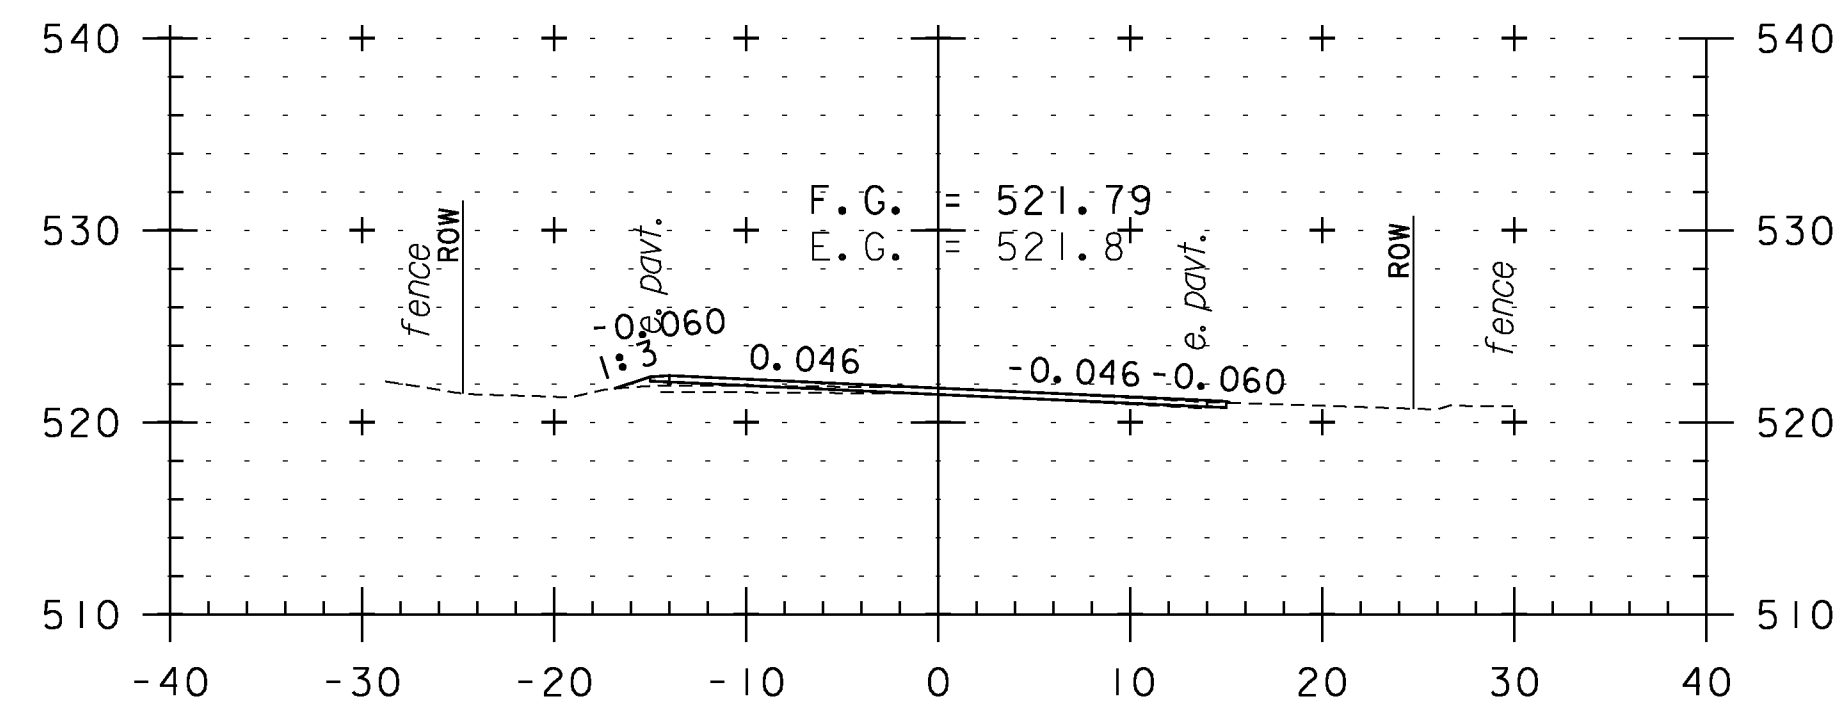


415+00

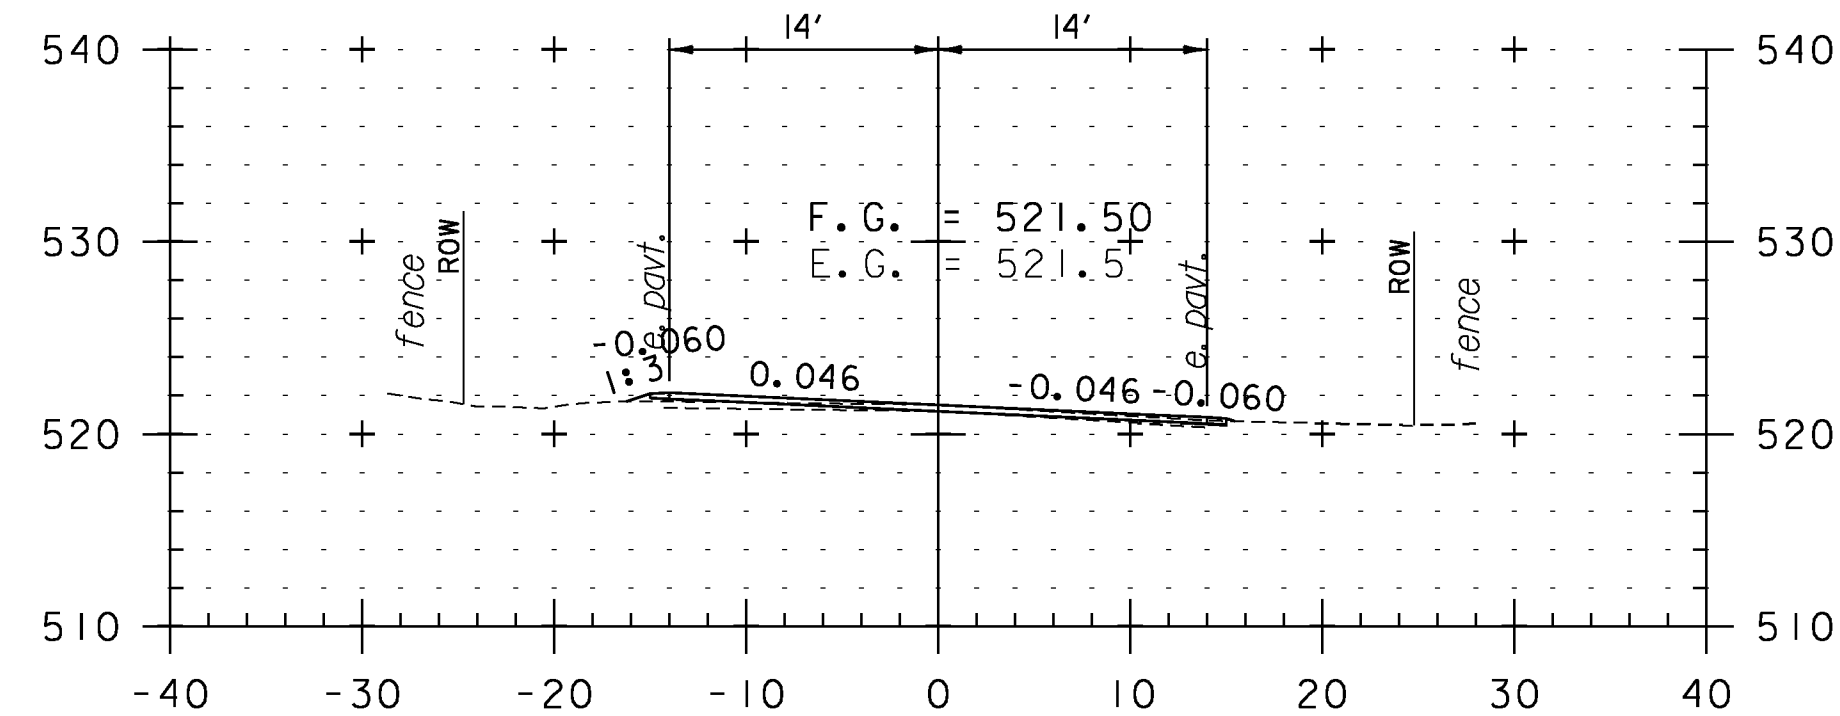


414+50

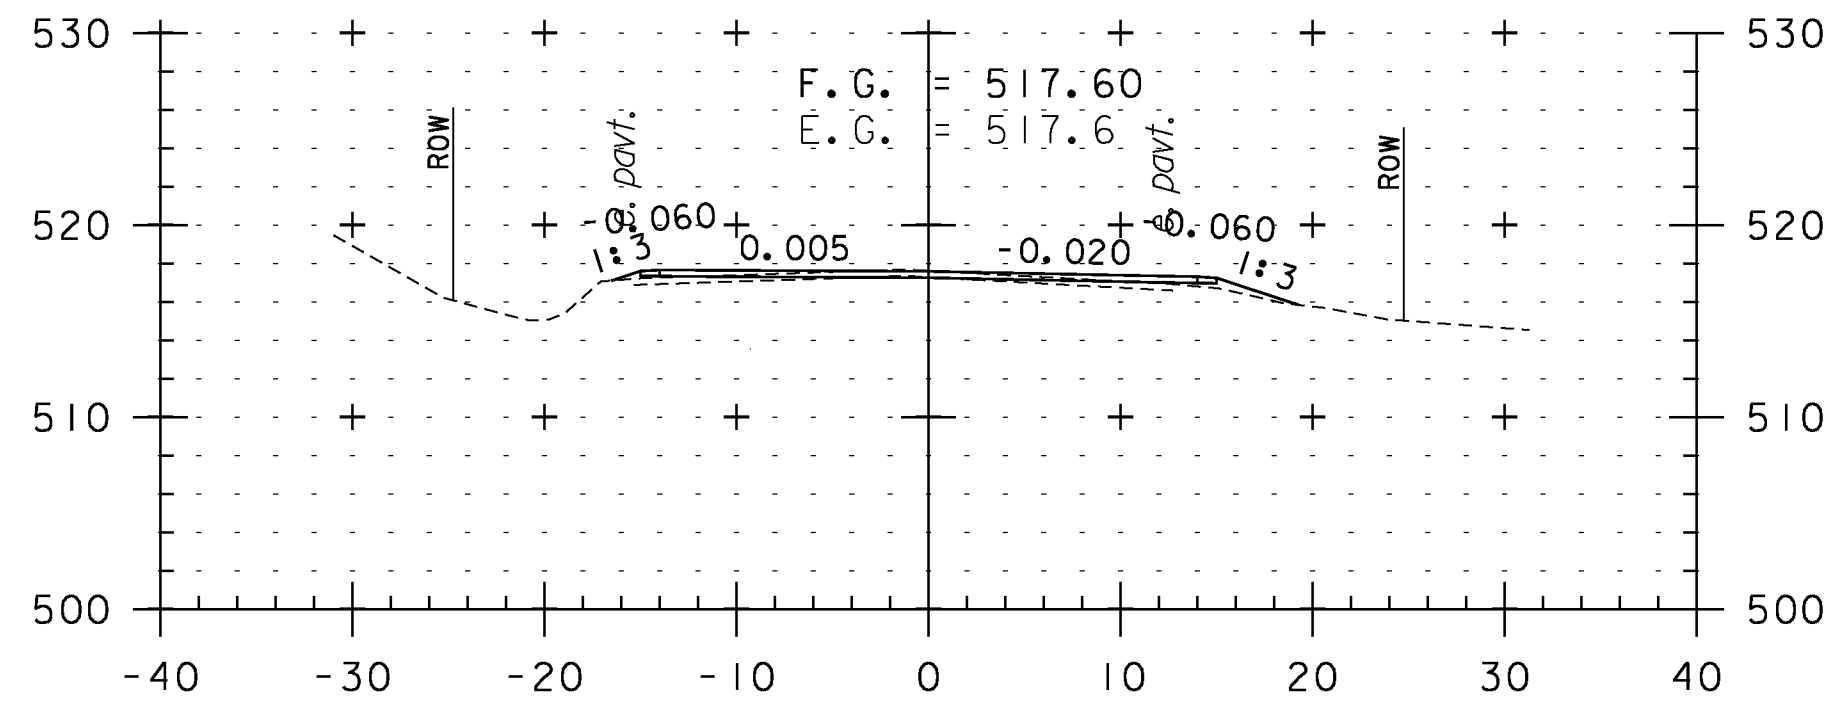


417+00

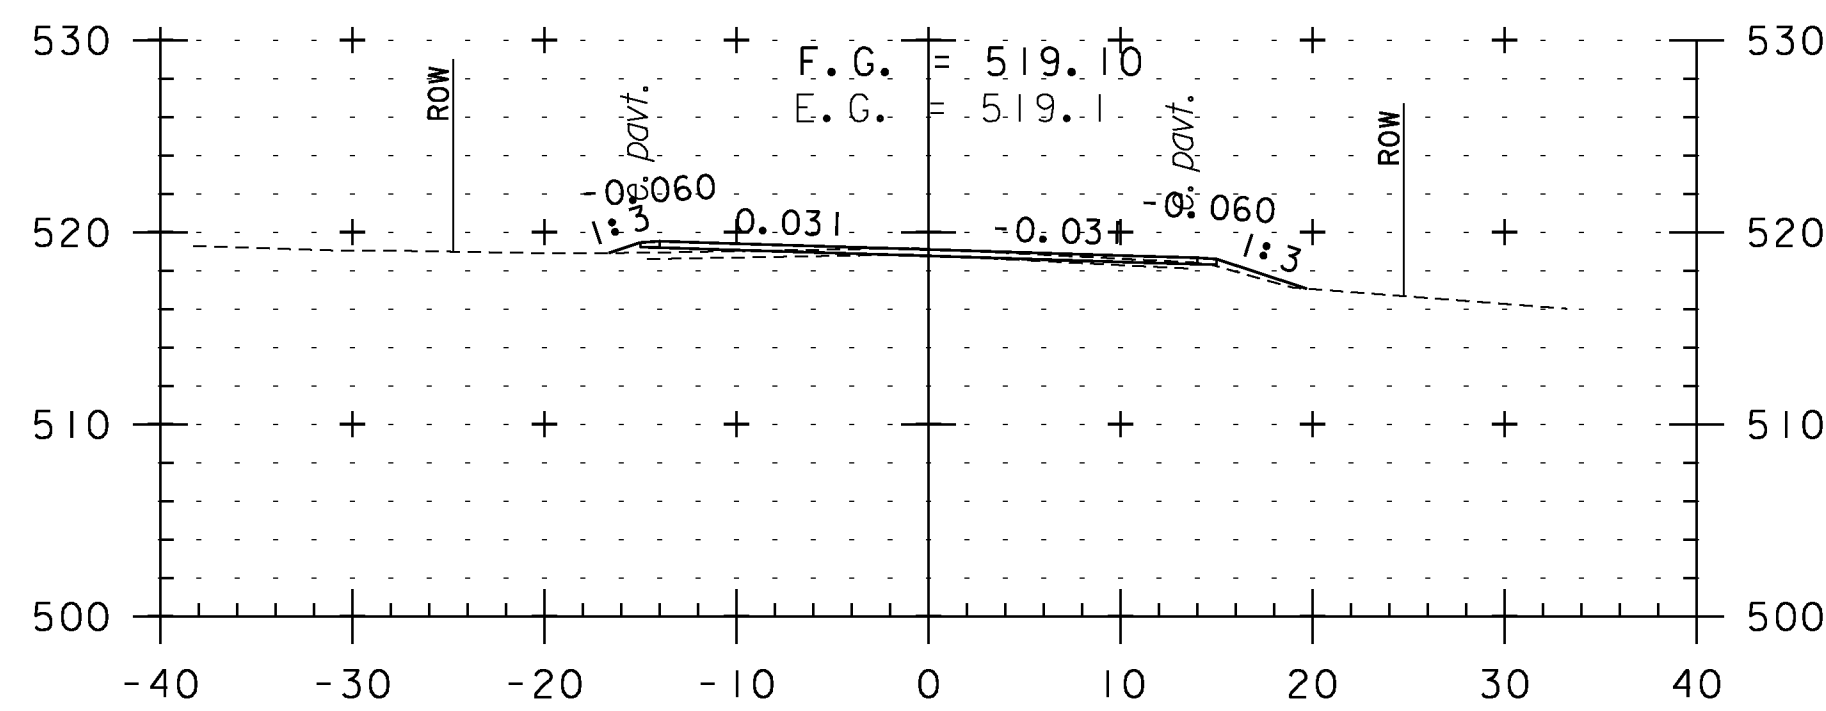


416+50

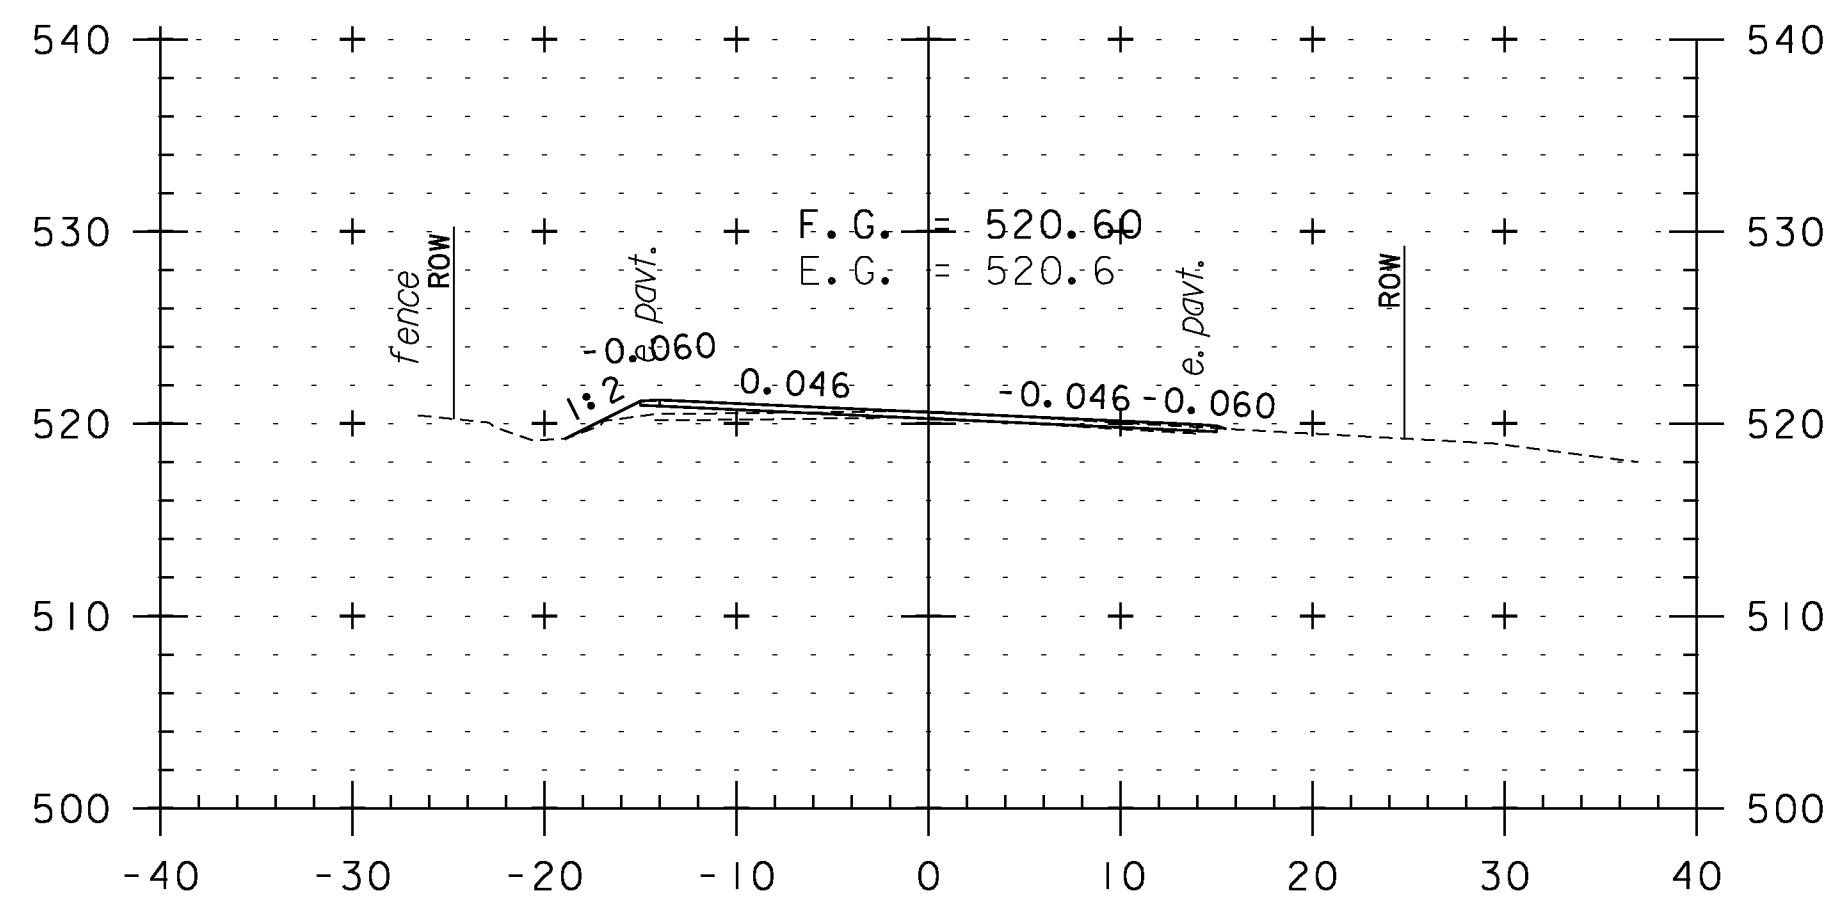


416+00

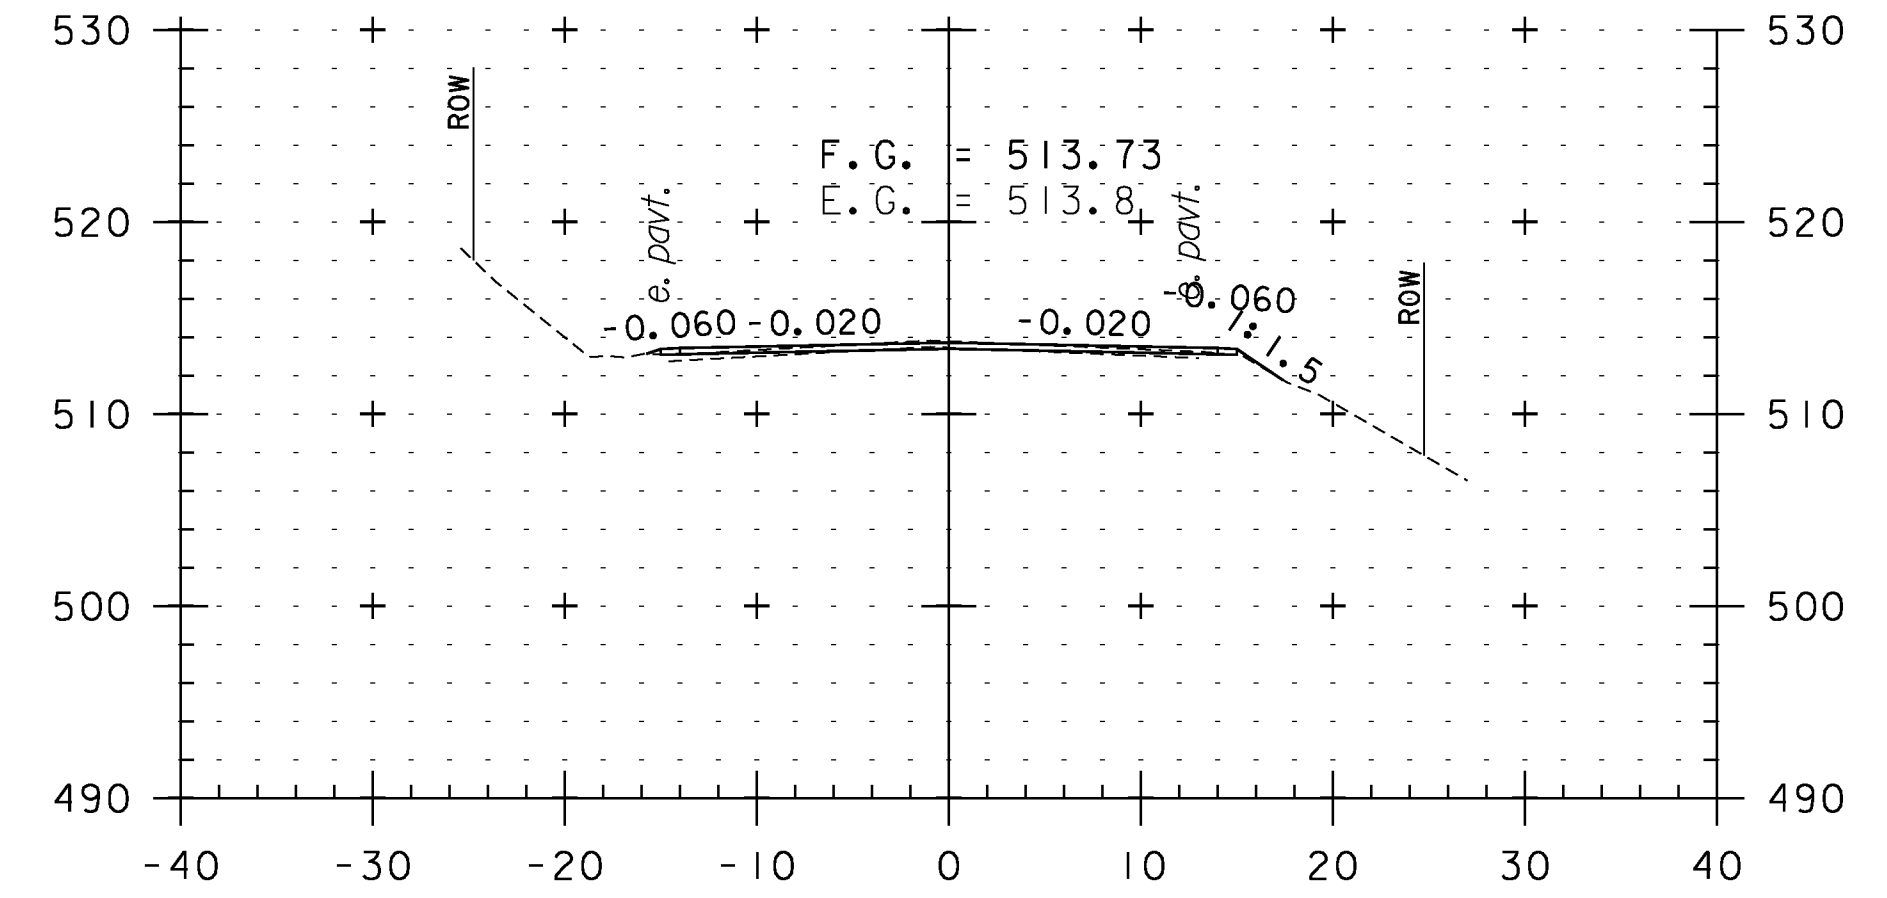

418+50

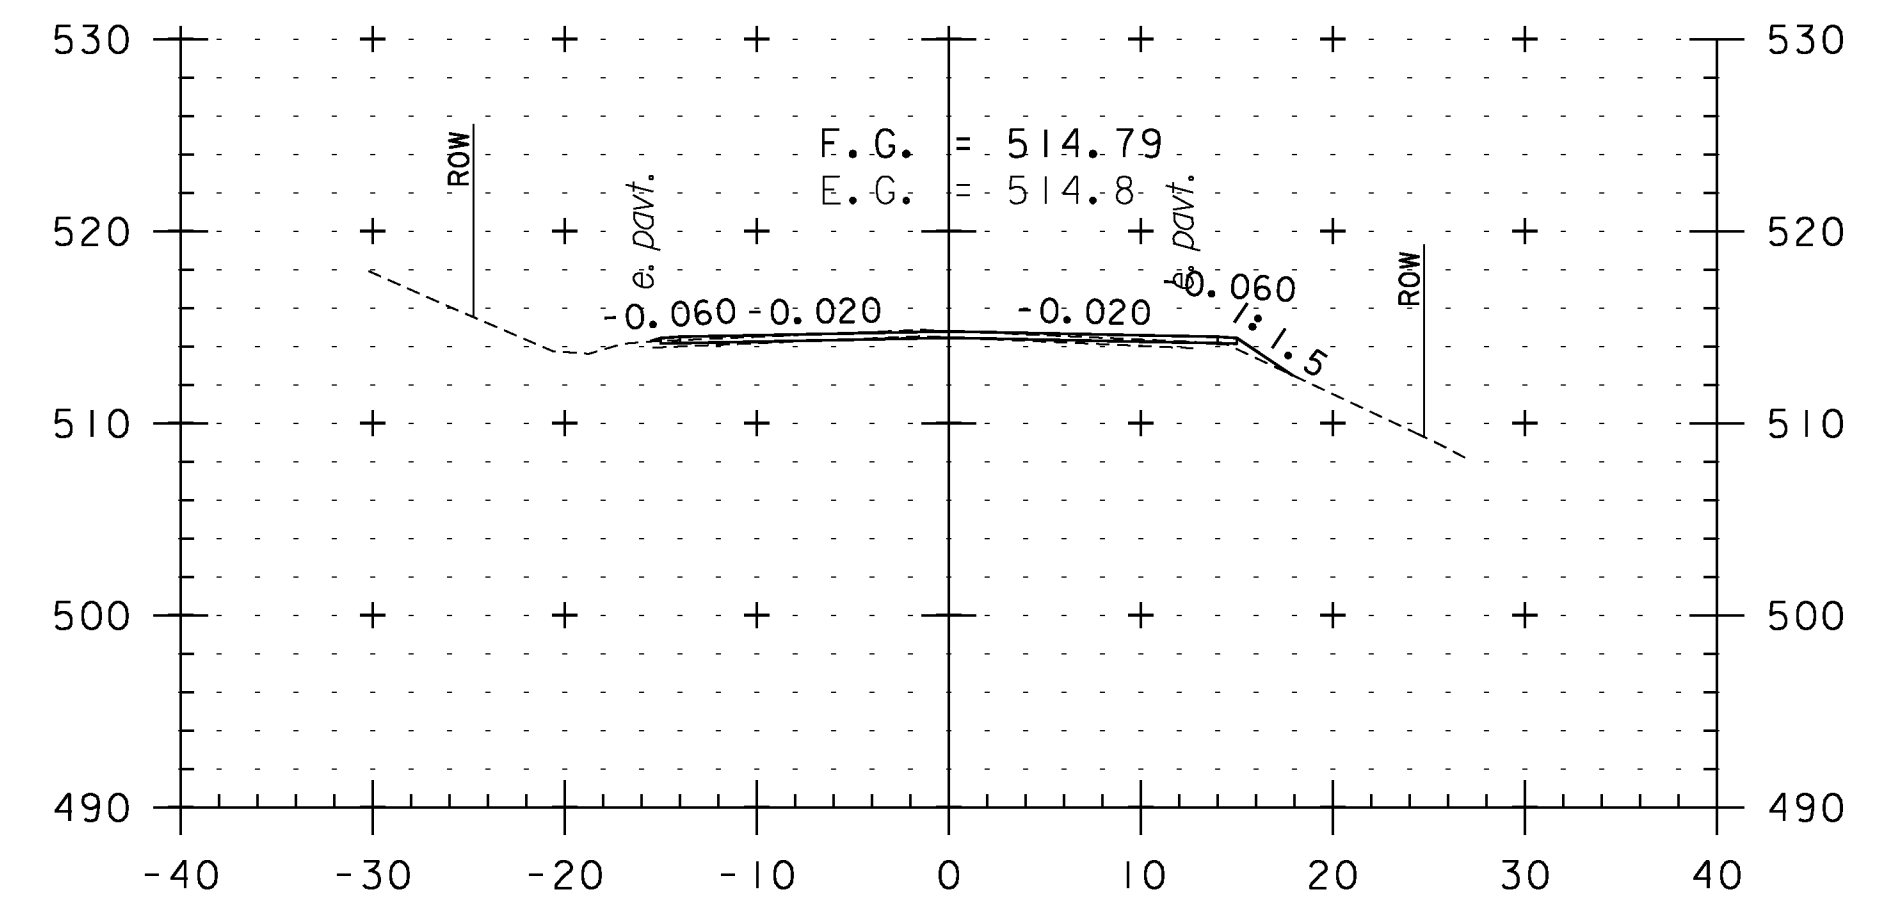

418+00

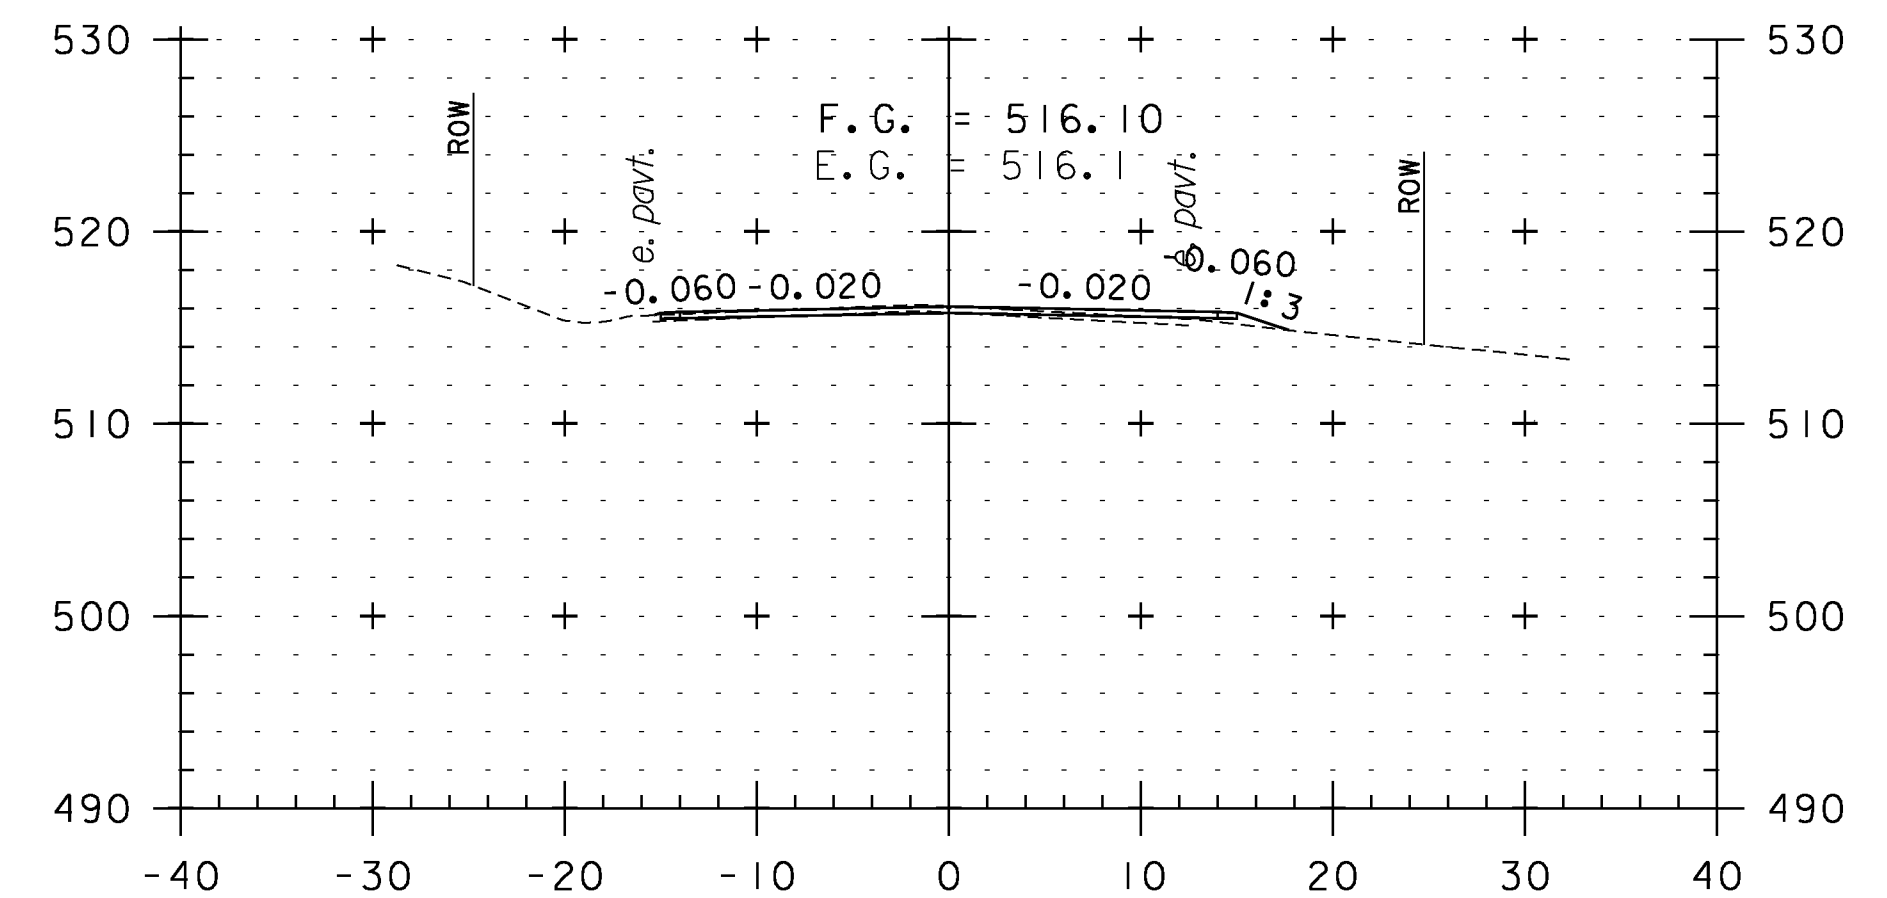

417+50

CROSS SECTION SHEET 83

PROJECT NAME: WEATHERSFIELD

PROJECT NUMBER: STP 2913(I)

FILE NAME: I0c228

PROJECT LEADER: PTS

DESIGNED BY: NLL


IPARM FILE NAME: pI0c228.I73

PLOT DATE: 2/7/2013

DRAWN BY: WWG

CHECKED BY: PTS

SHEET 173 OF 234

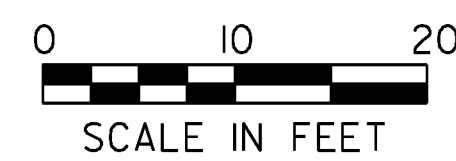

STA. 414+50 TO STA. 418+50