




420+00

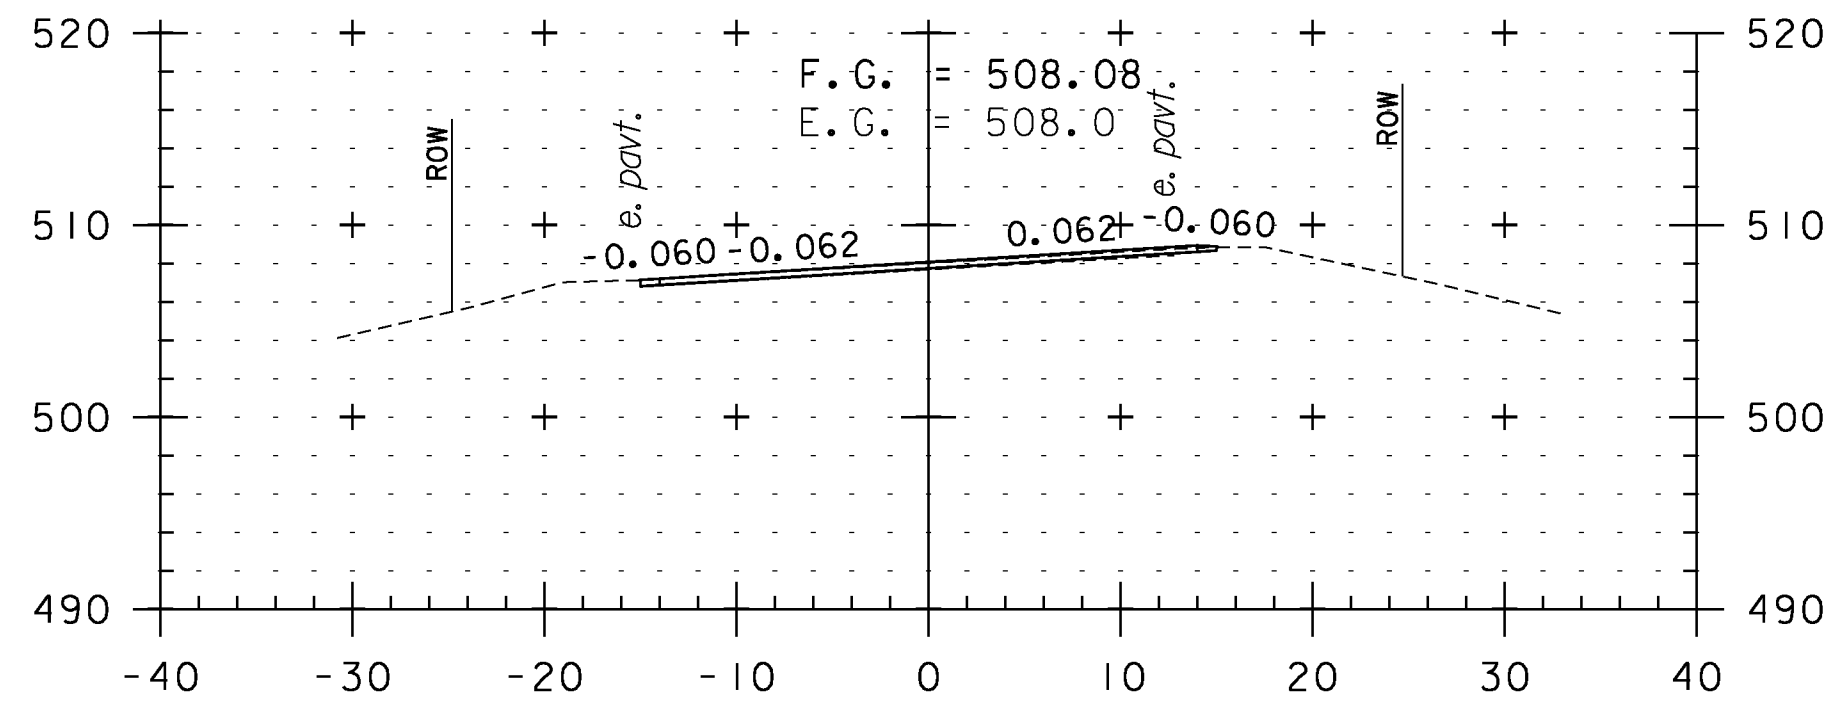


421+50

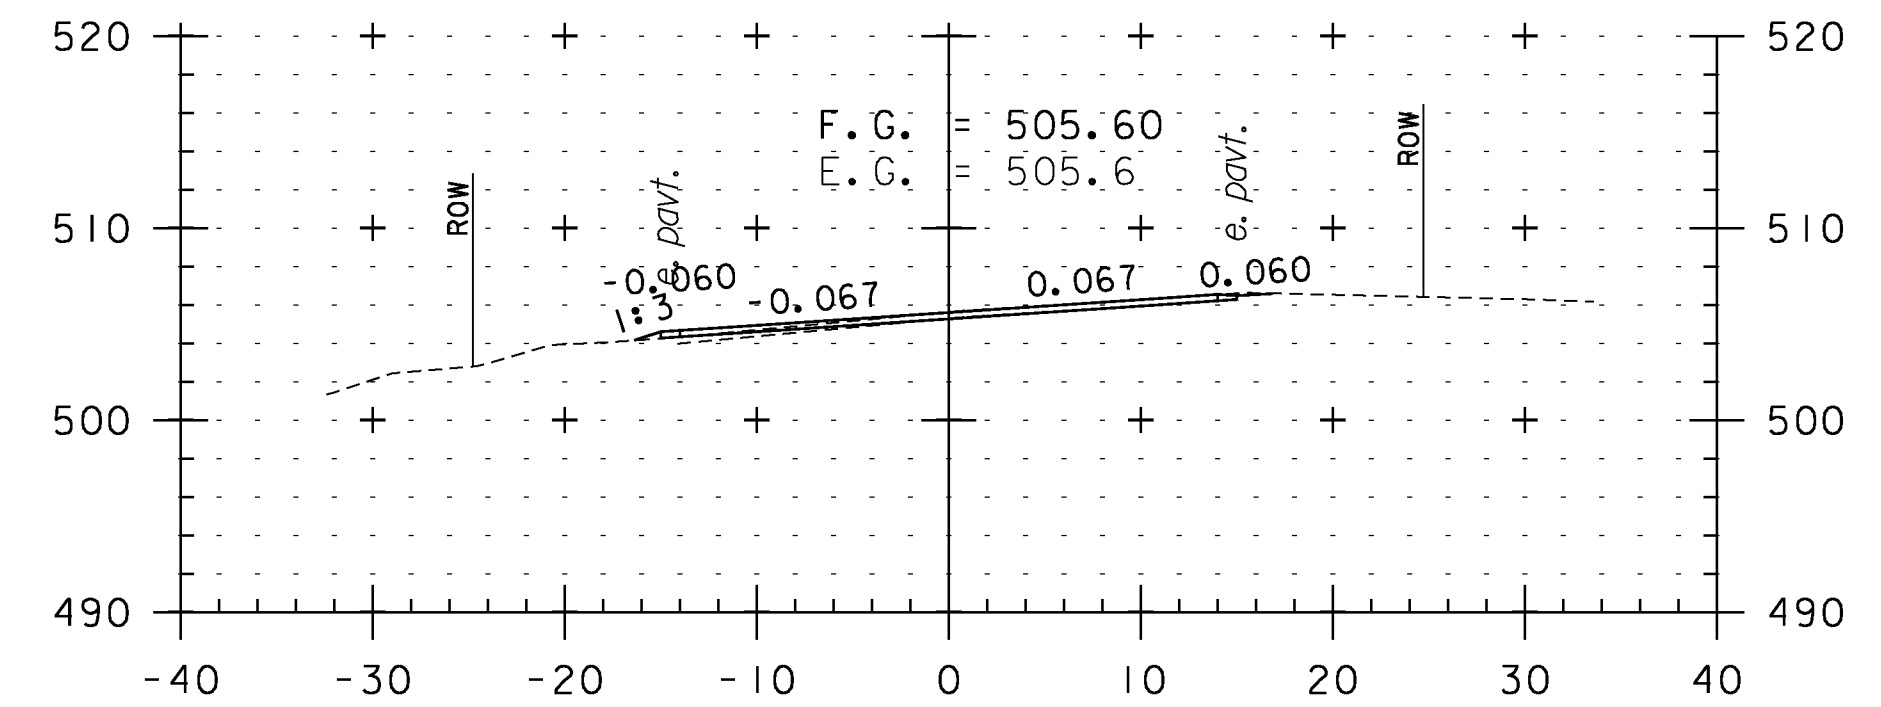


423+00

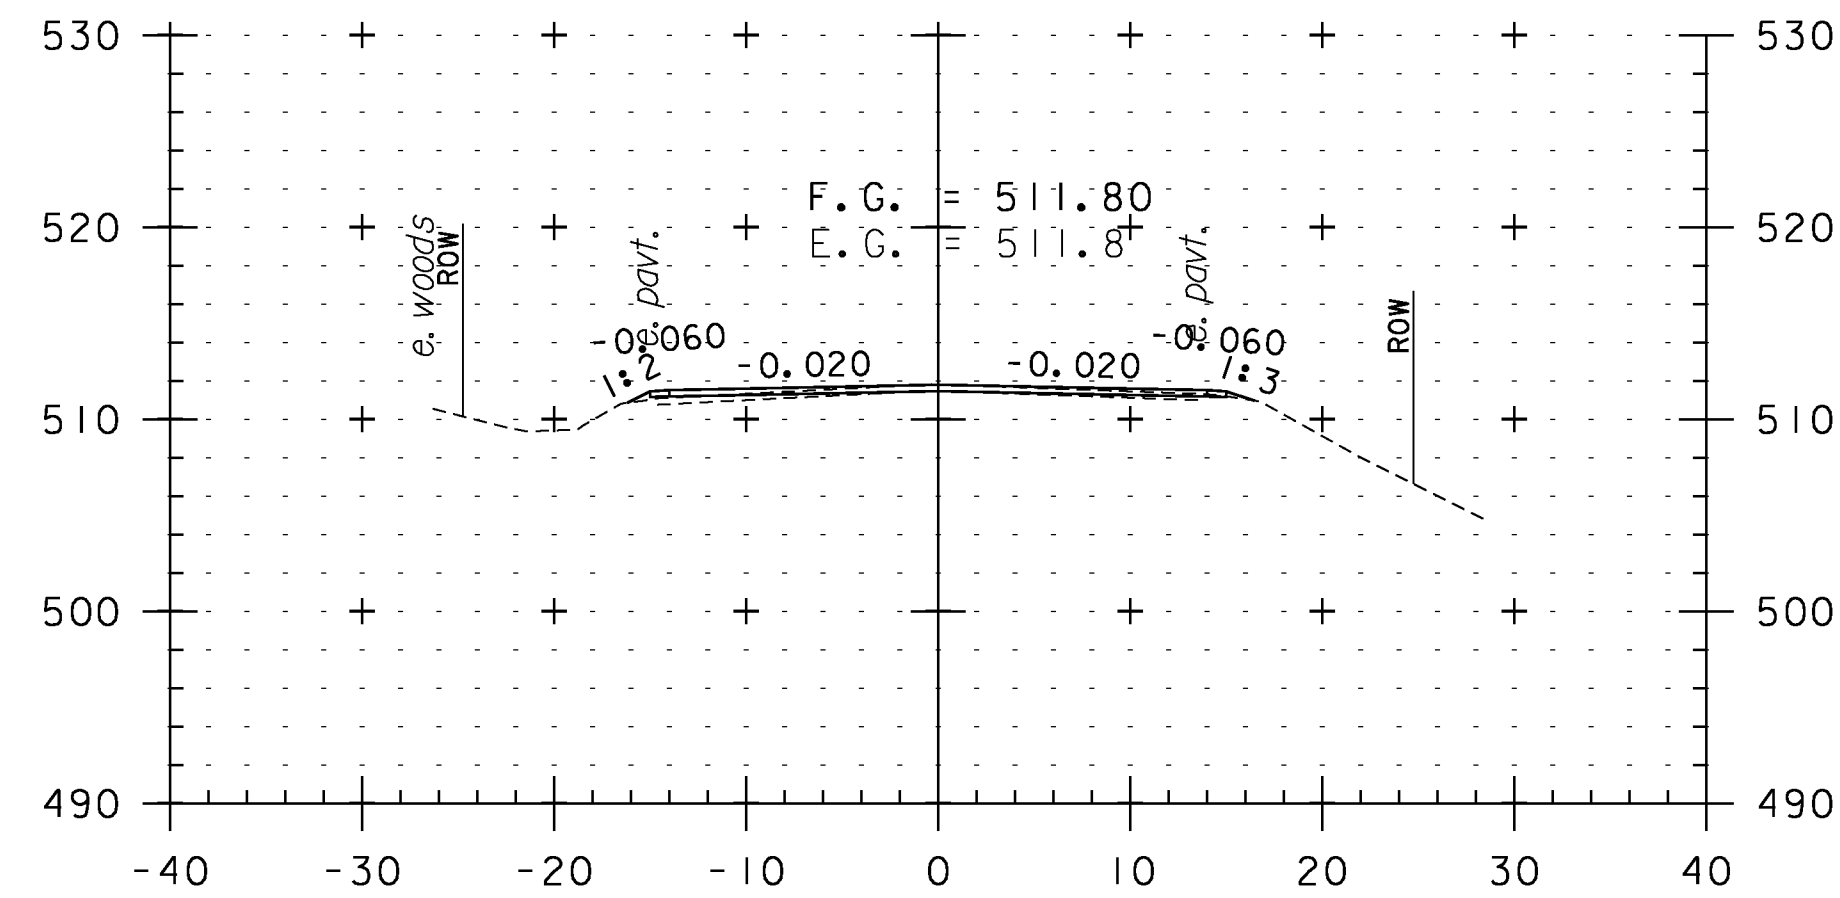


419+50

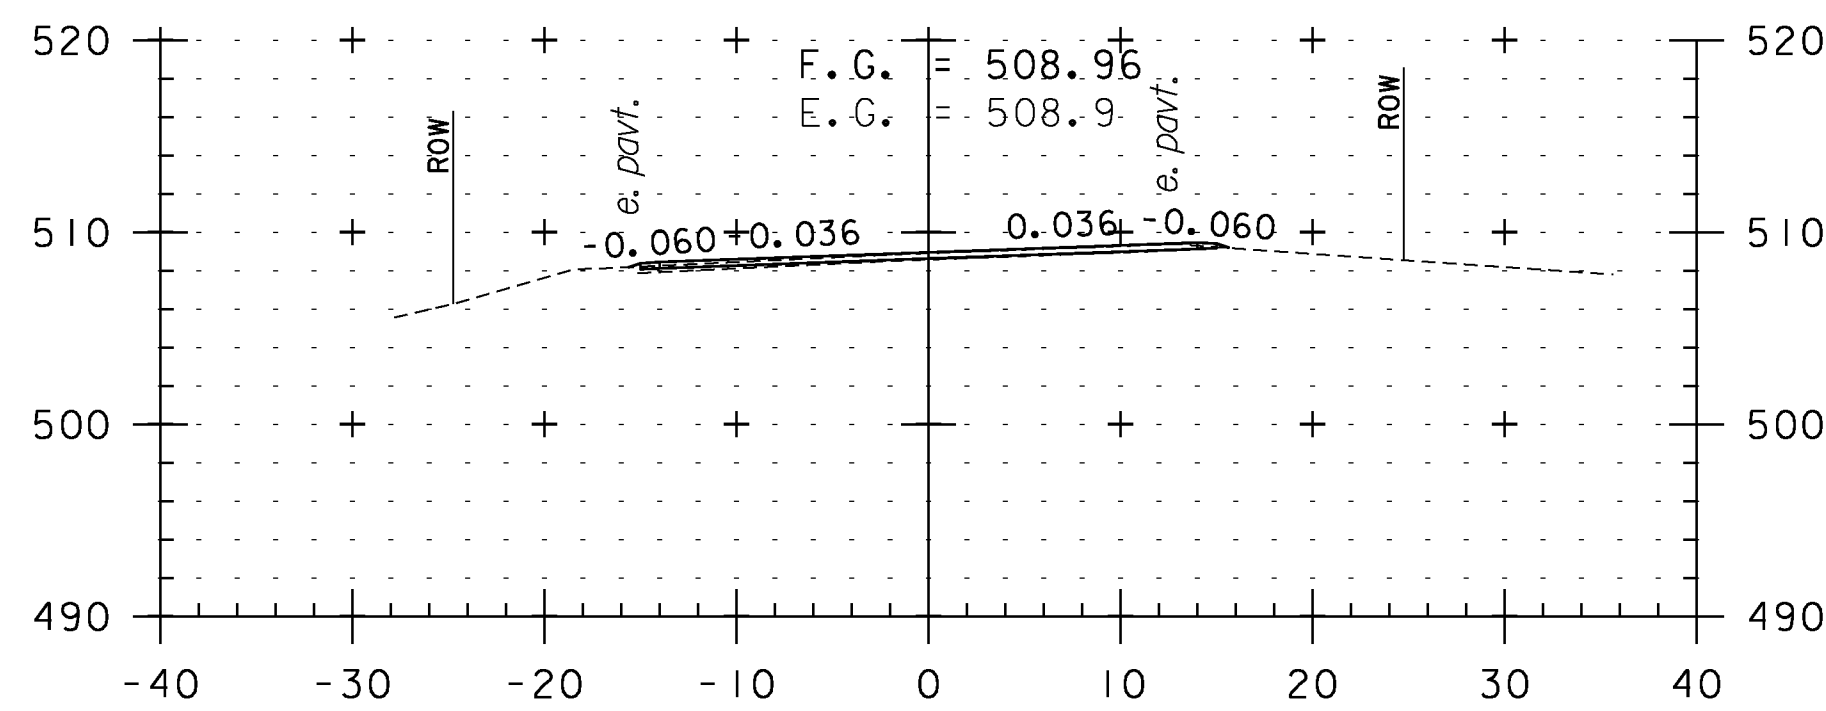


421+00

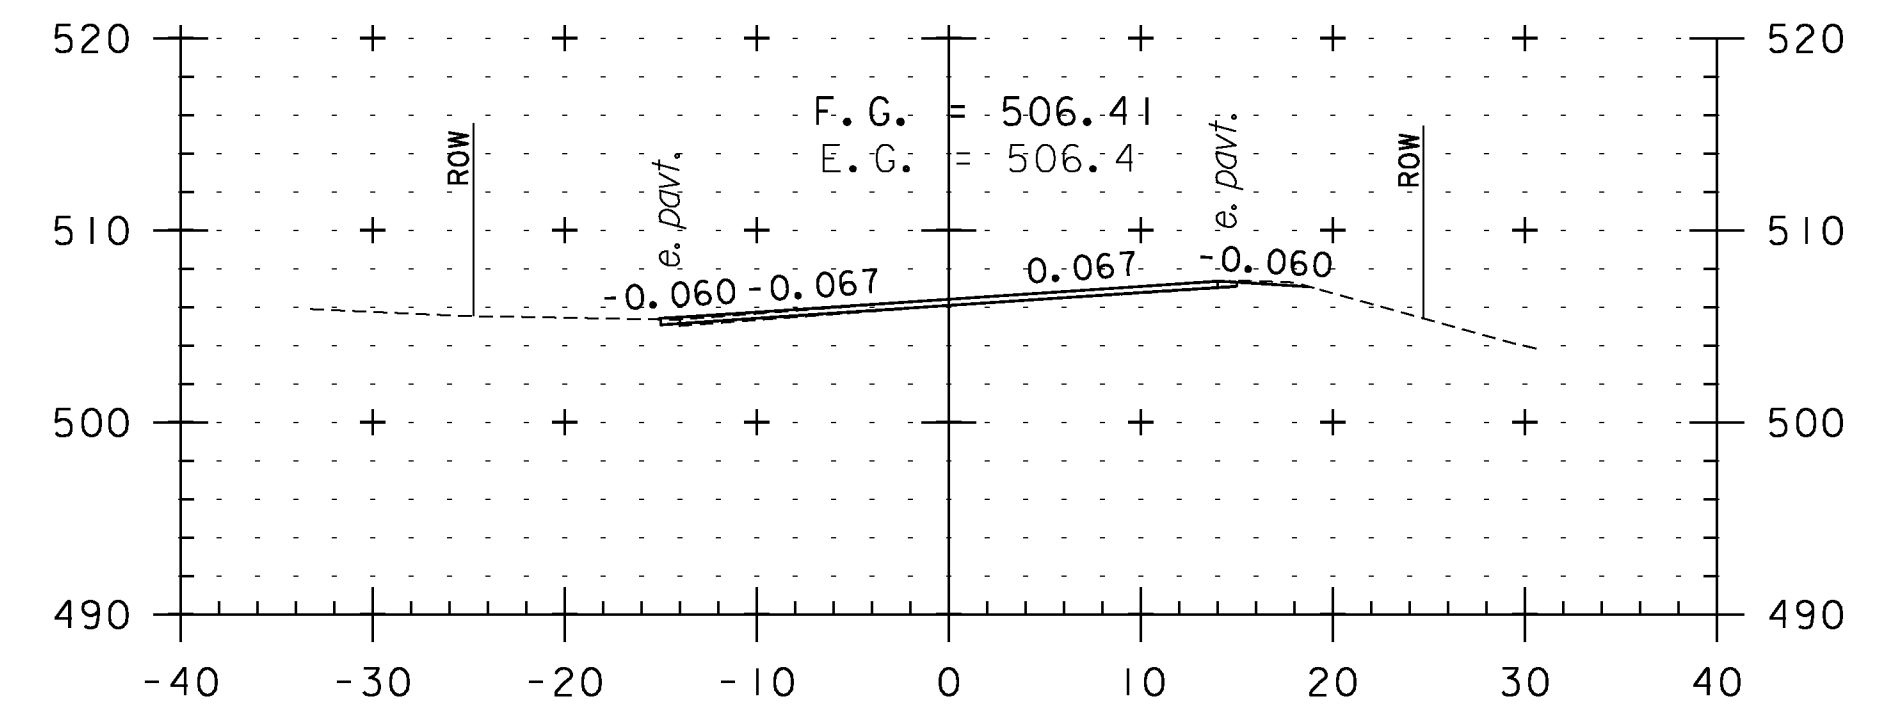


422+50

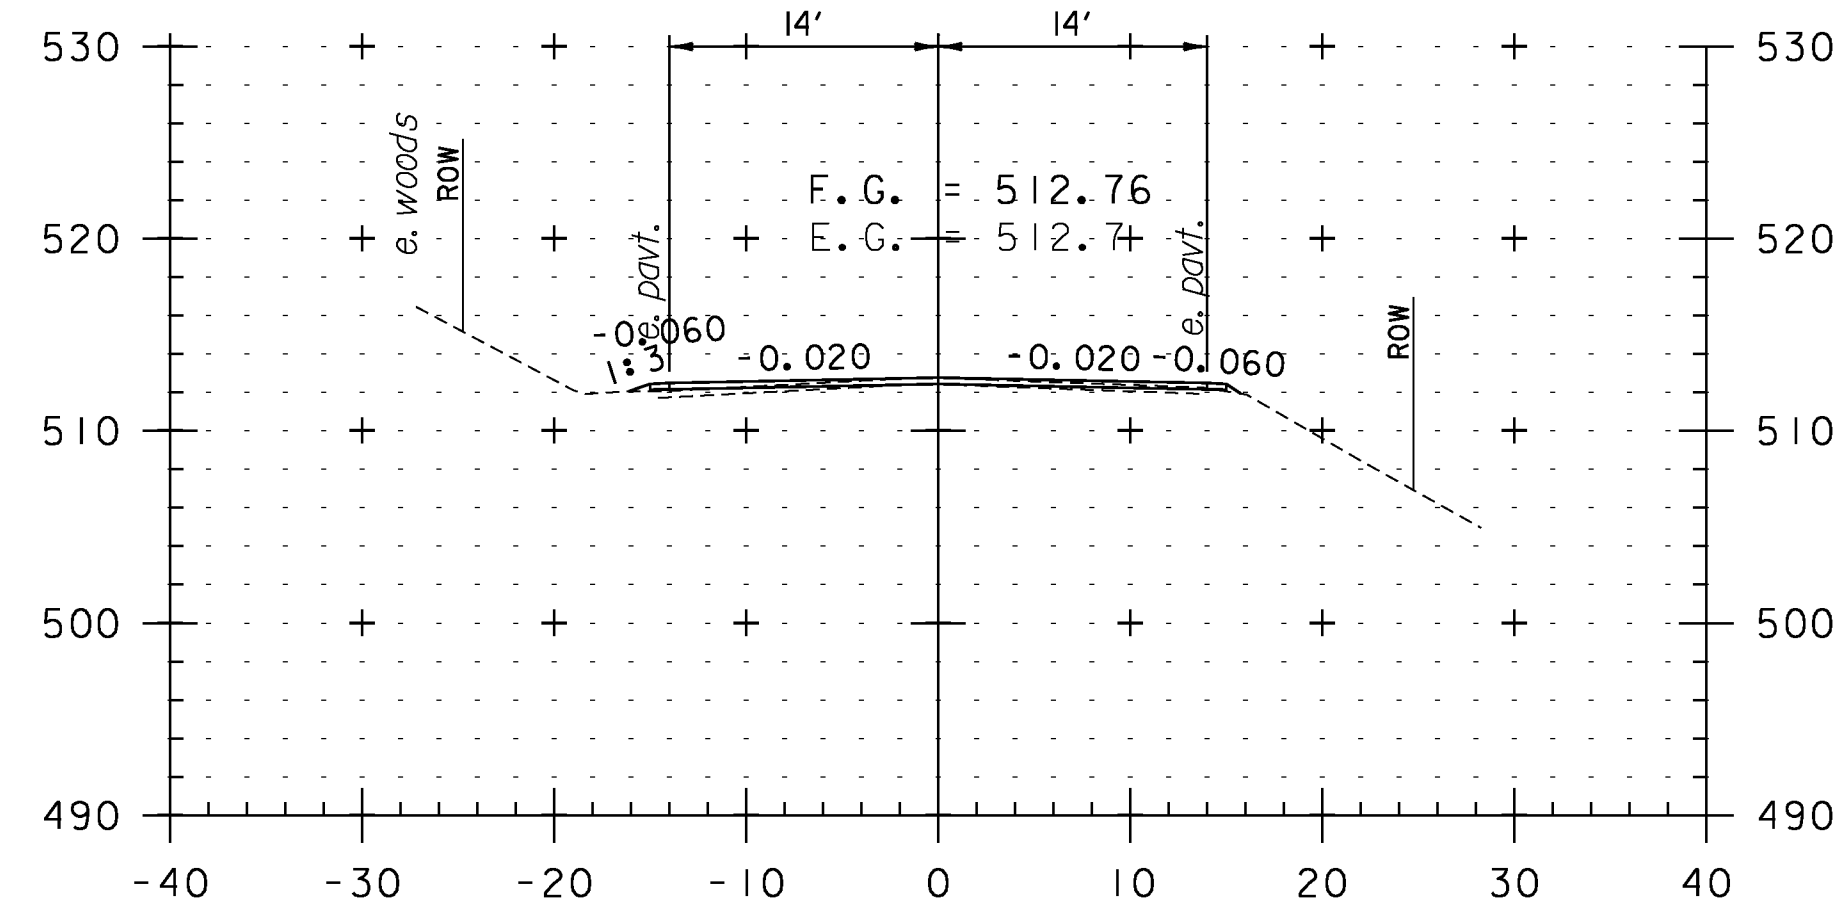

419+00

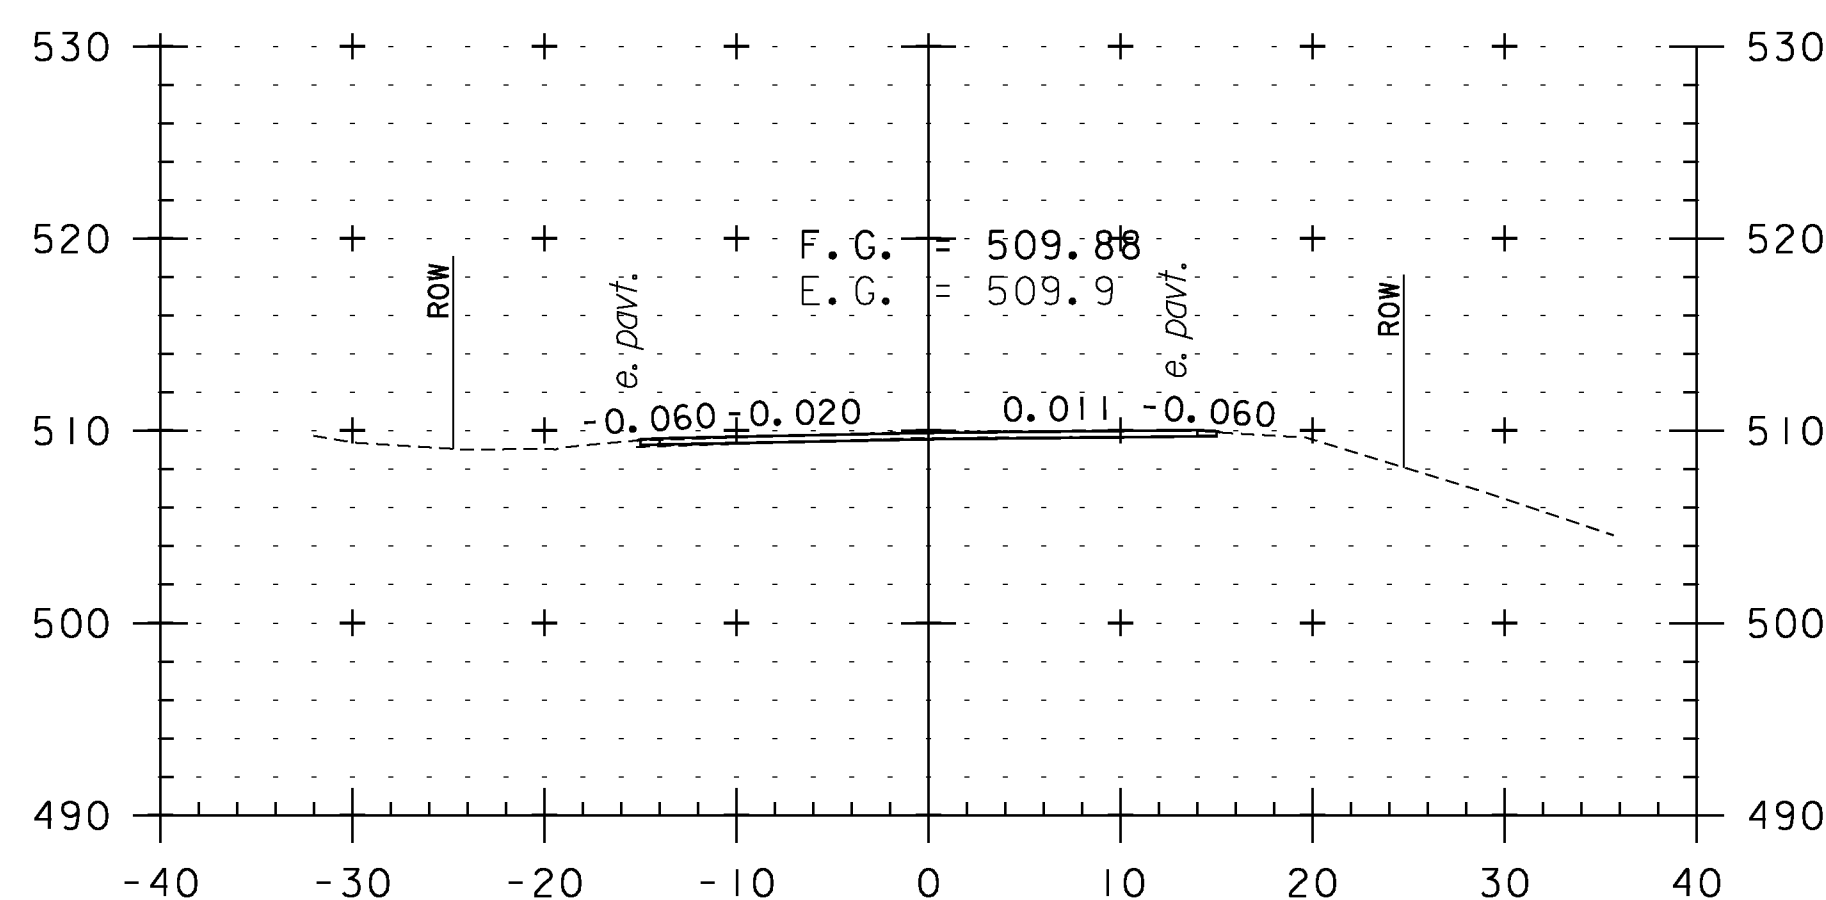

420+50

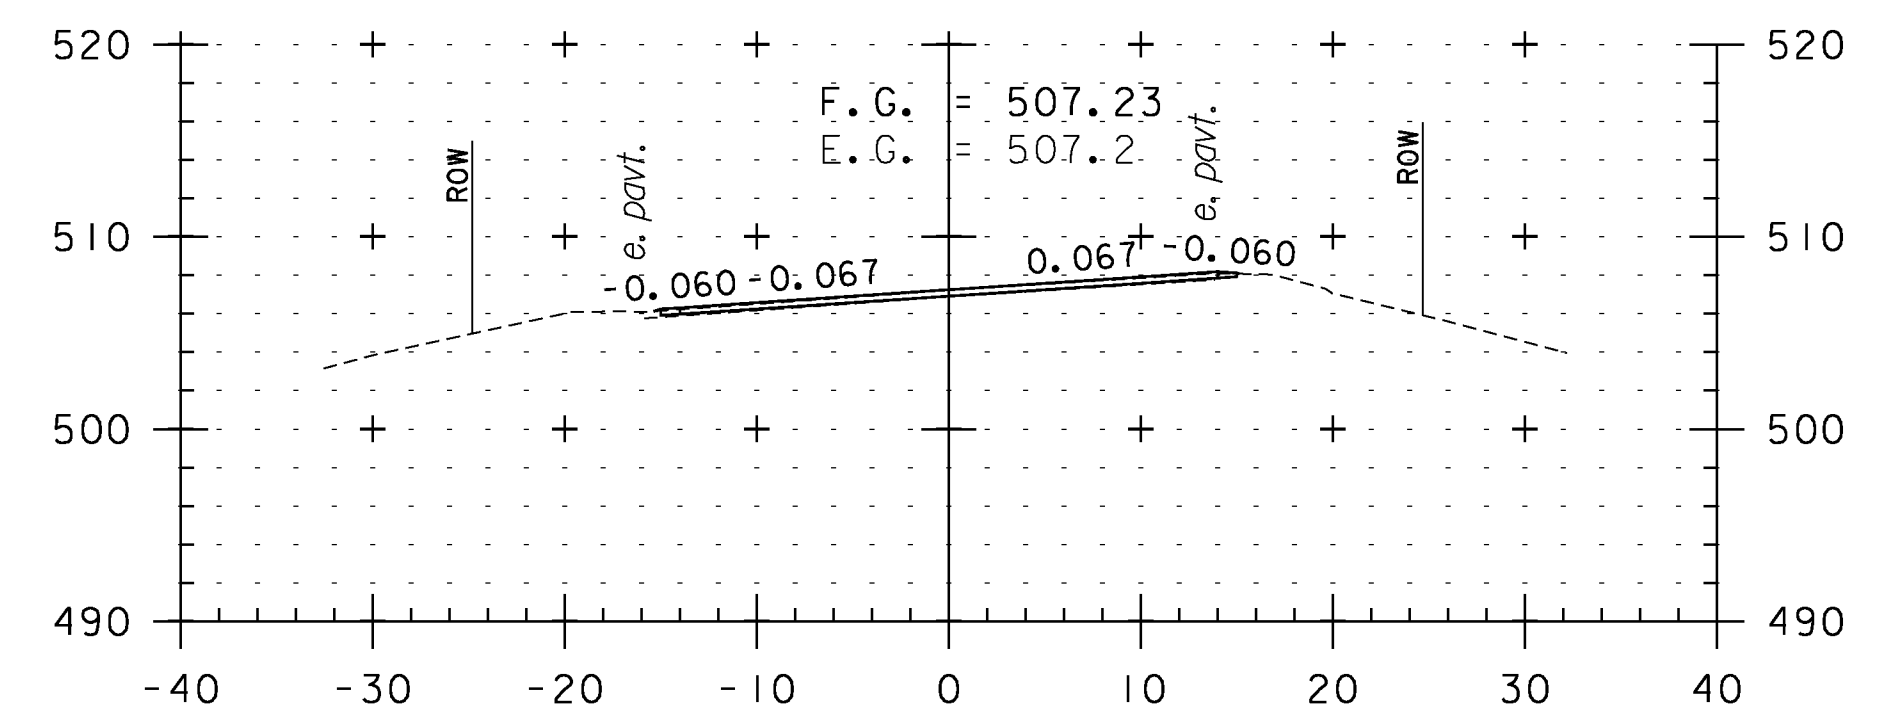

422+00

CROSS SECTION SHEET 84

PROJECT NAME: WEATHERSFIELD	
PROJECT NUMBER: STP 2913(I)	
FILE NAME: I0c228	PLOT DATE: 2/7/2013
PROJECT LEADER: PTS	DRAWN BY: WWG
DESIGNED BY: NLL	CHECKED BY: PTS
IPARM FILE NAME: pI0c228.I74	SHEET 174 OF 234



STA. 419+00 TO STA. 423+00