




424+50

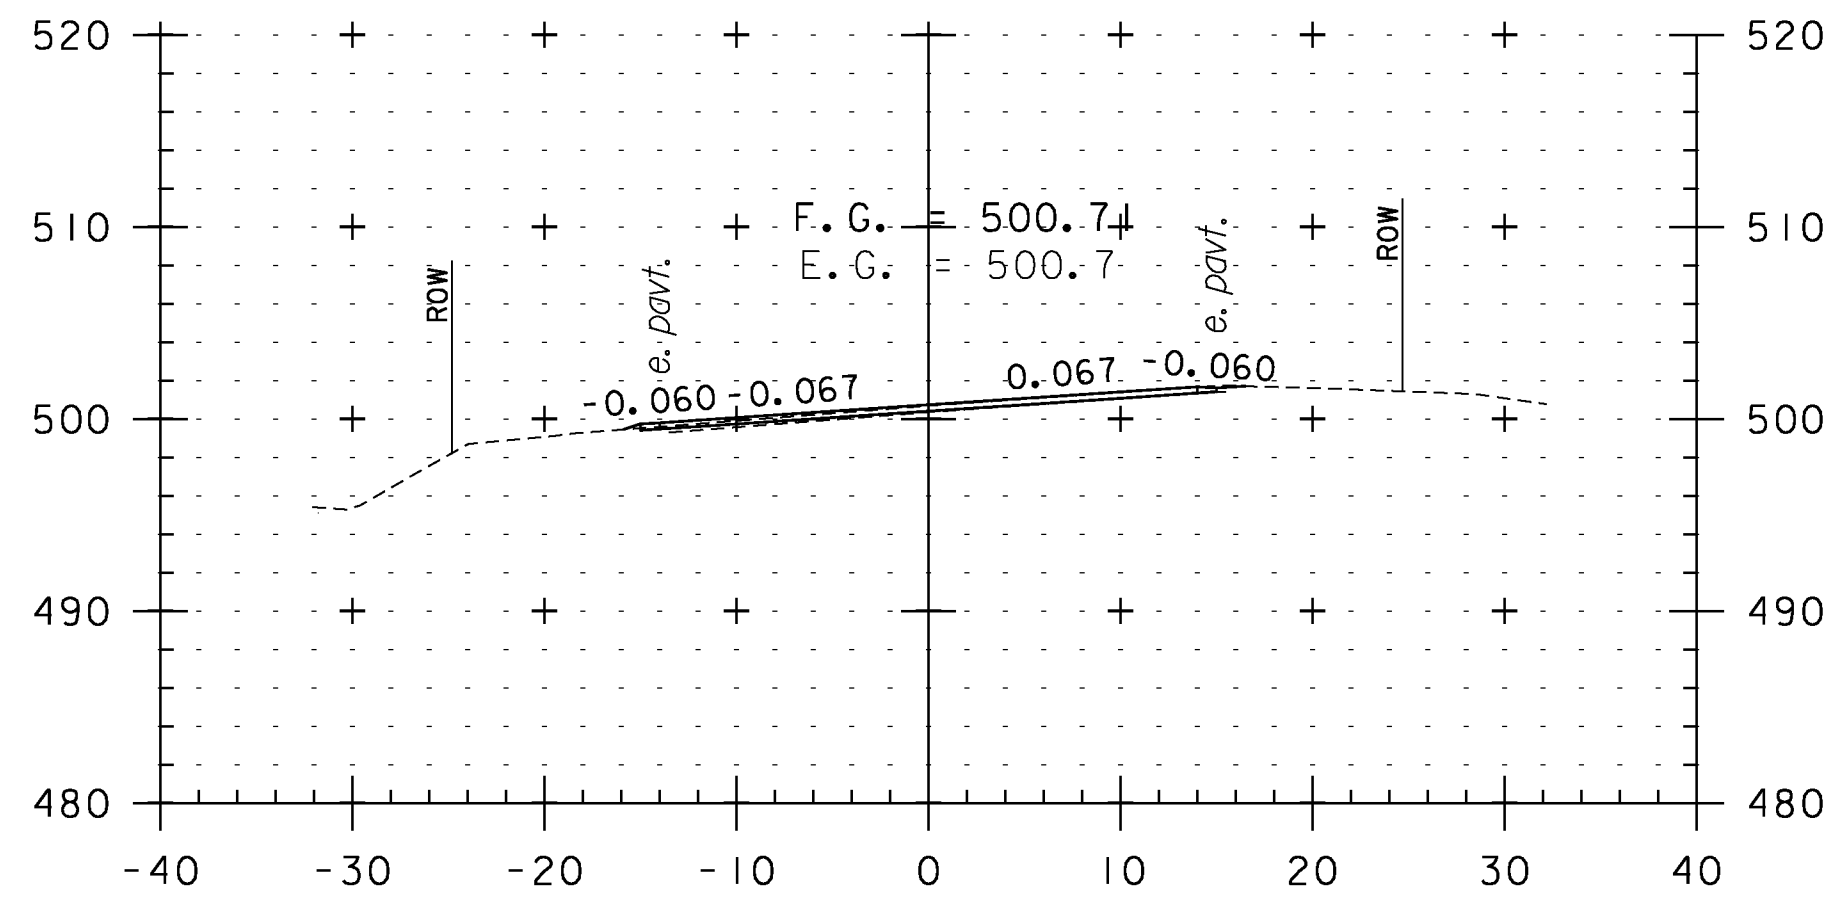


426+00

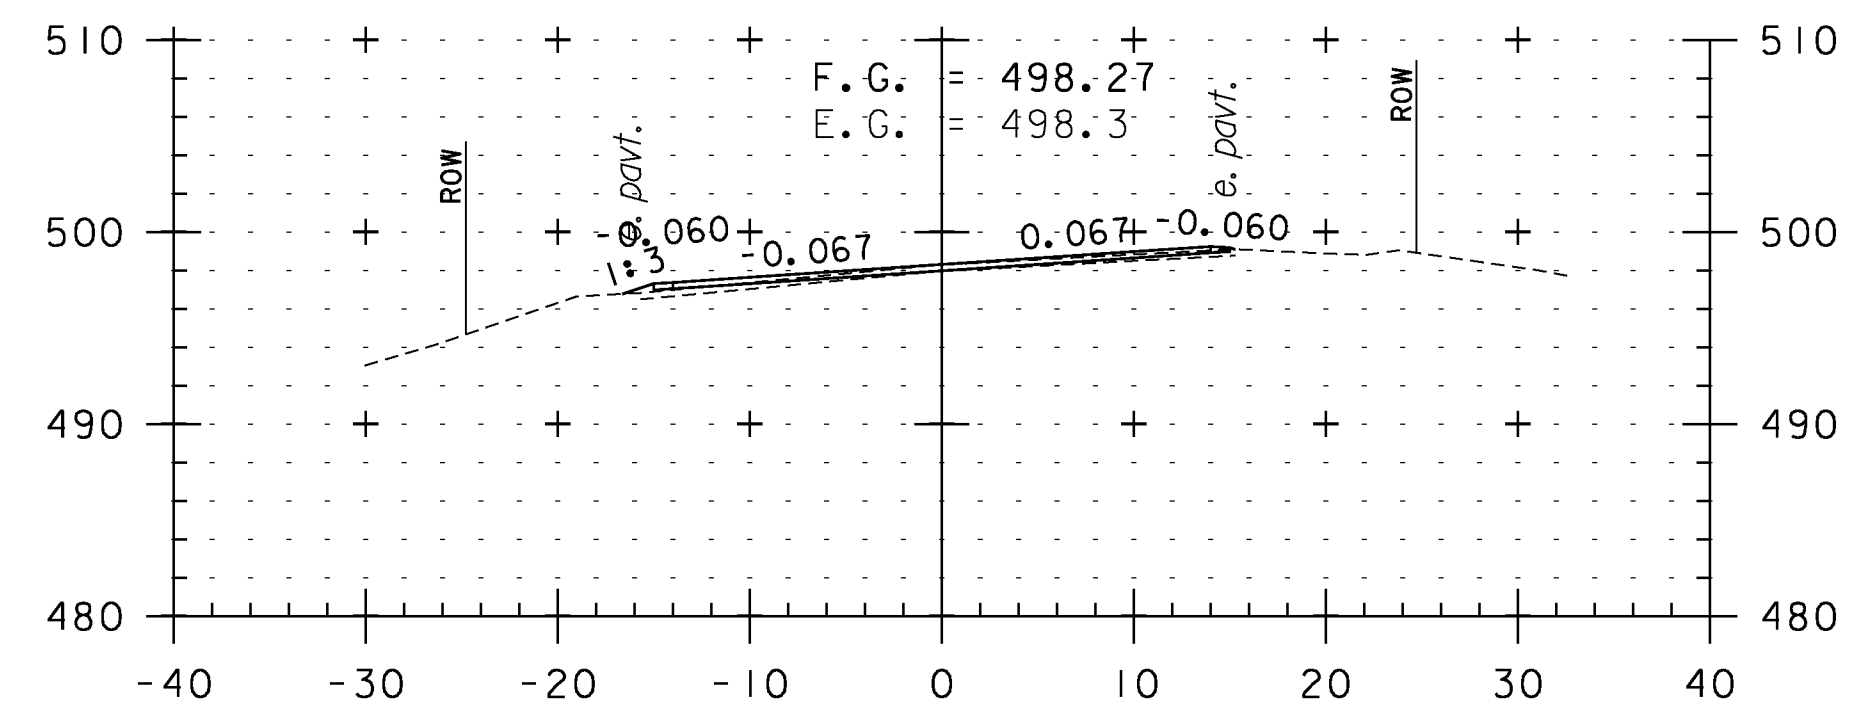


427+50

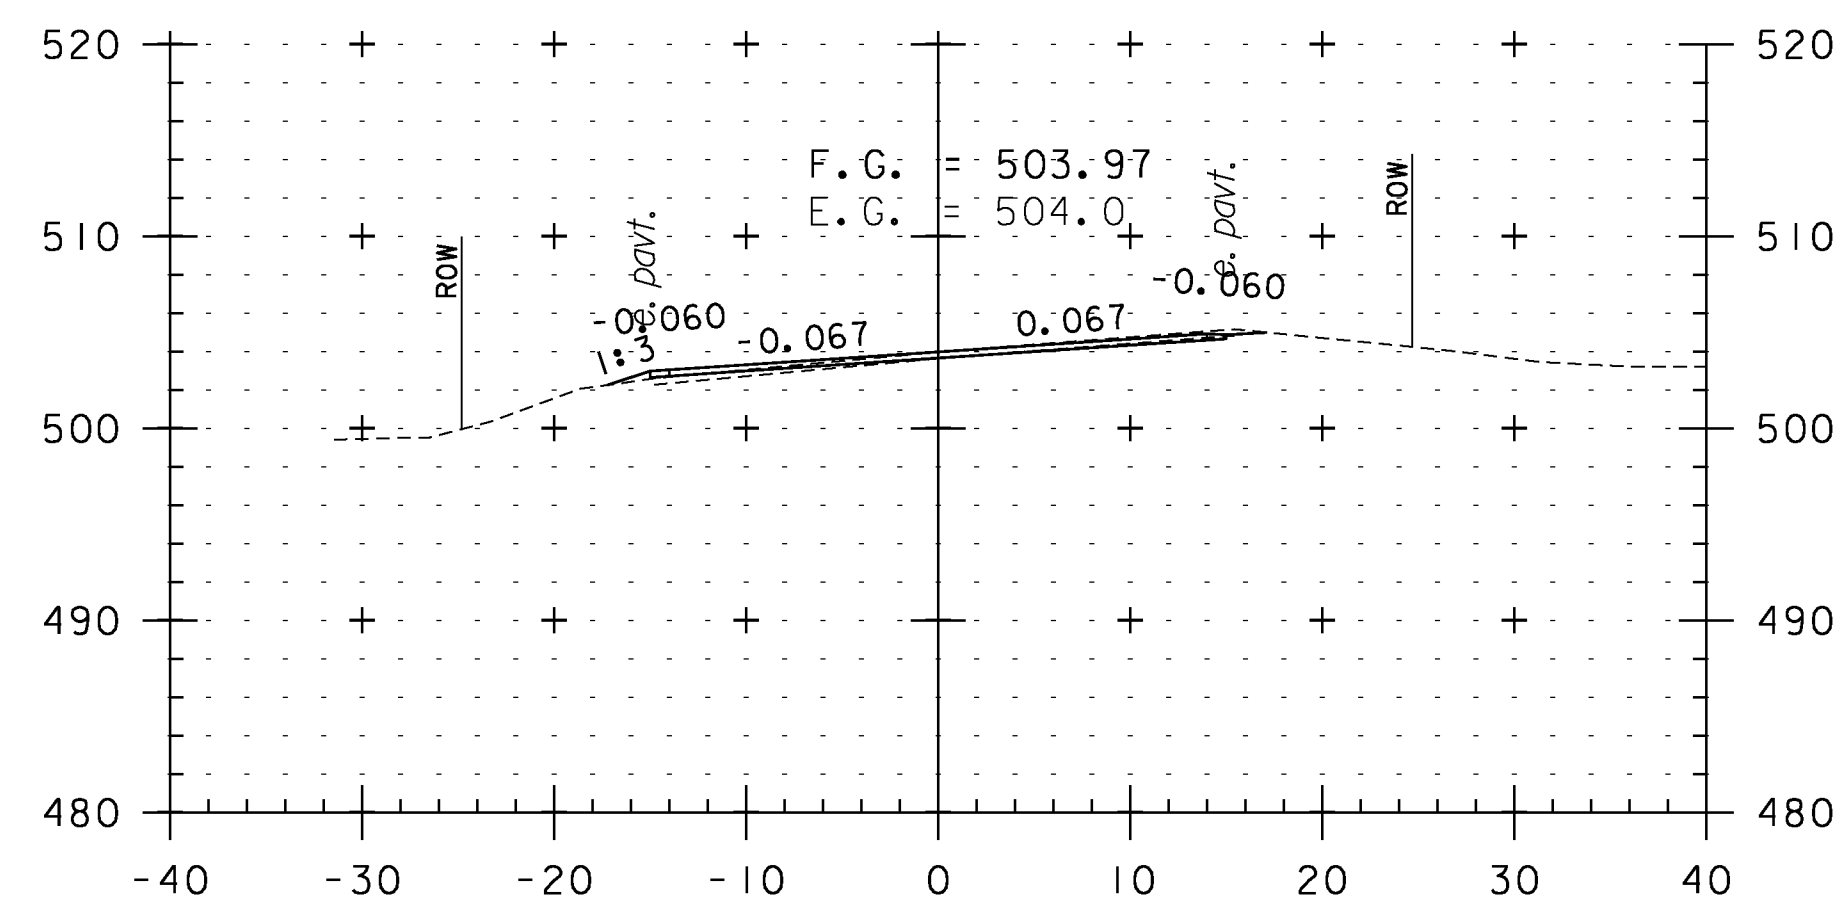


424+00

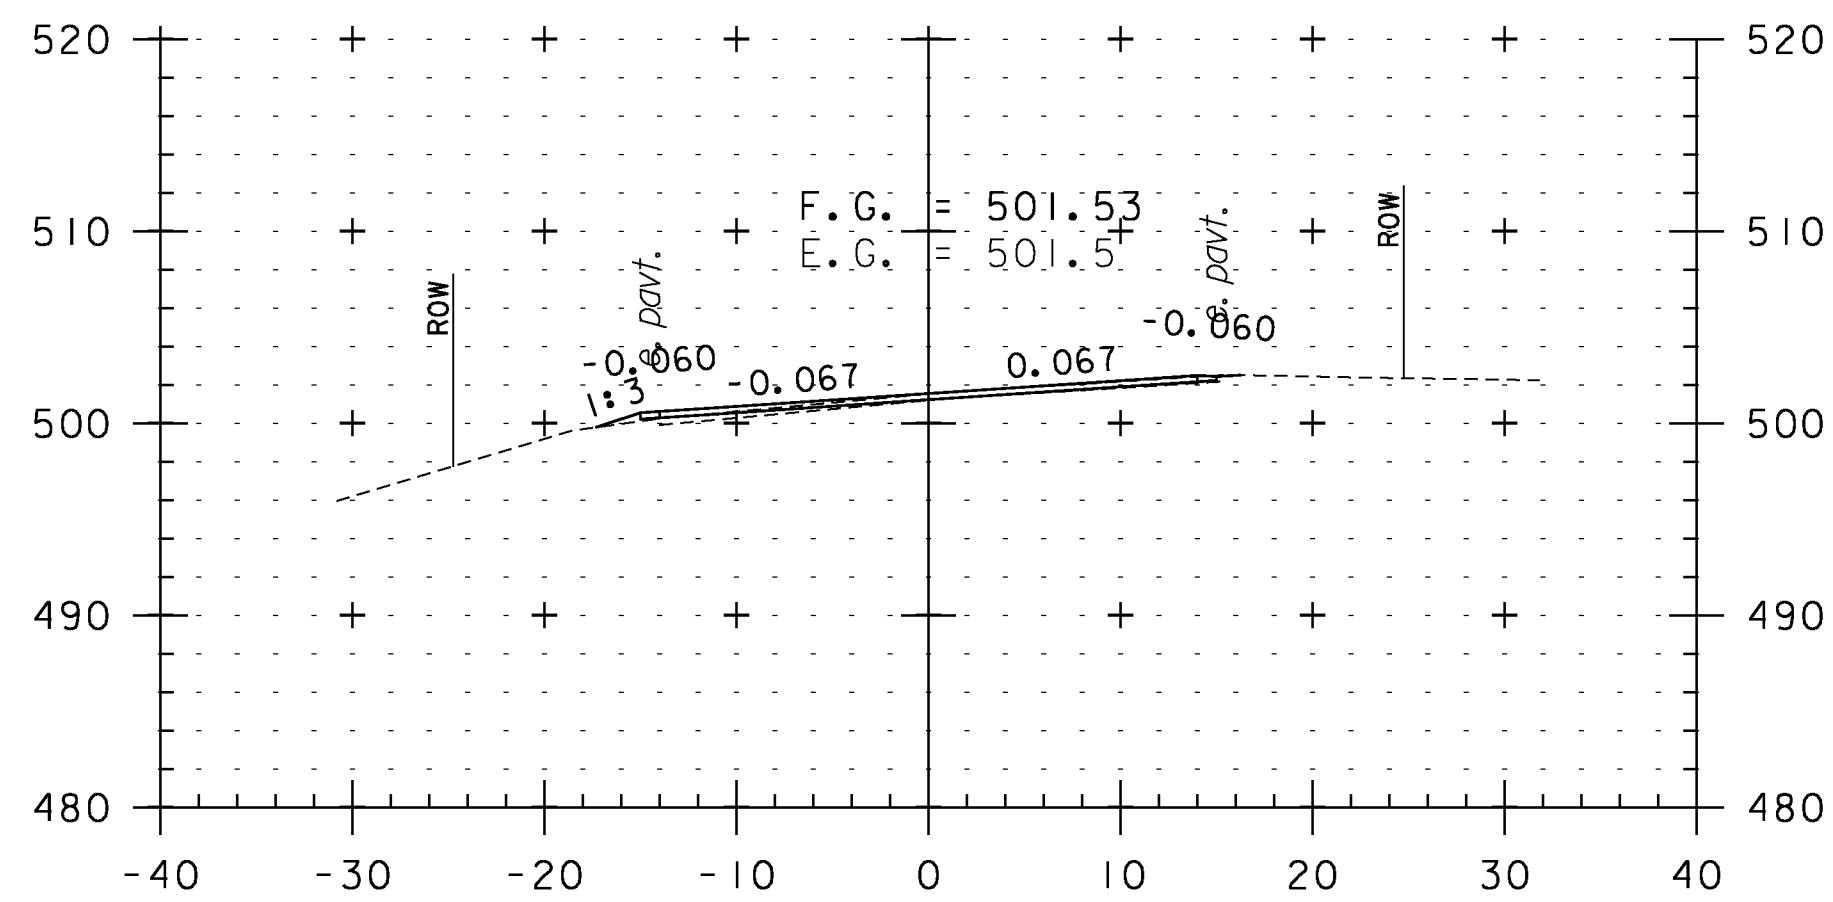


425+50

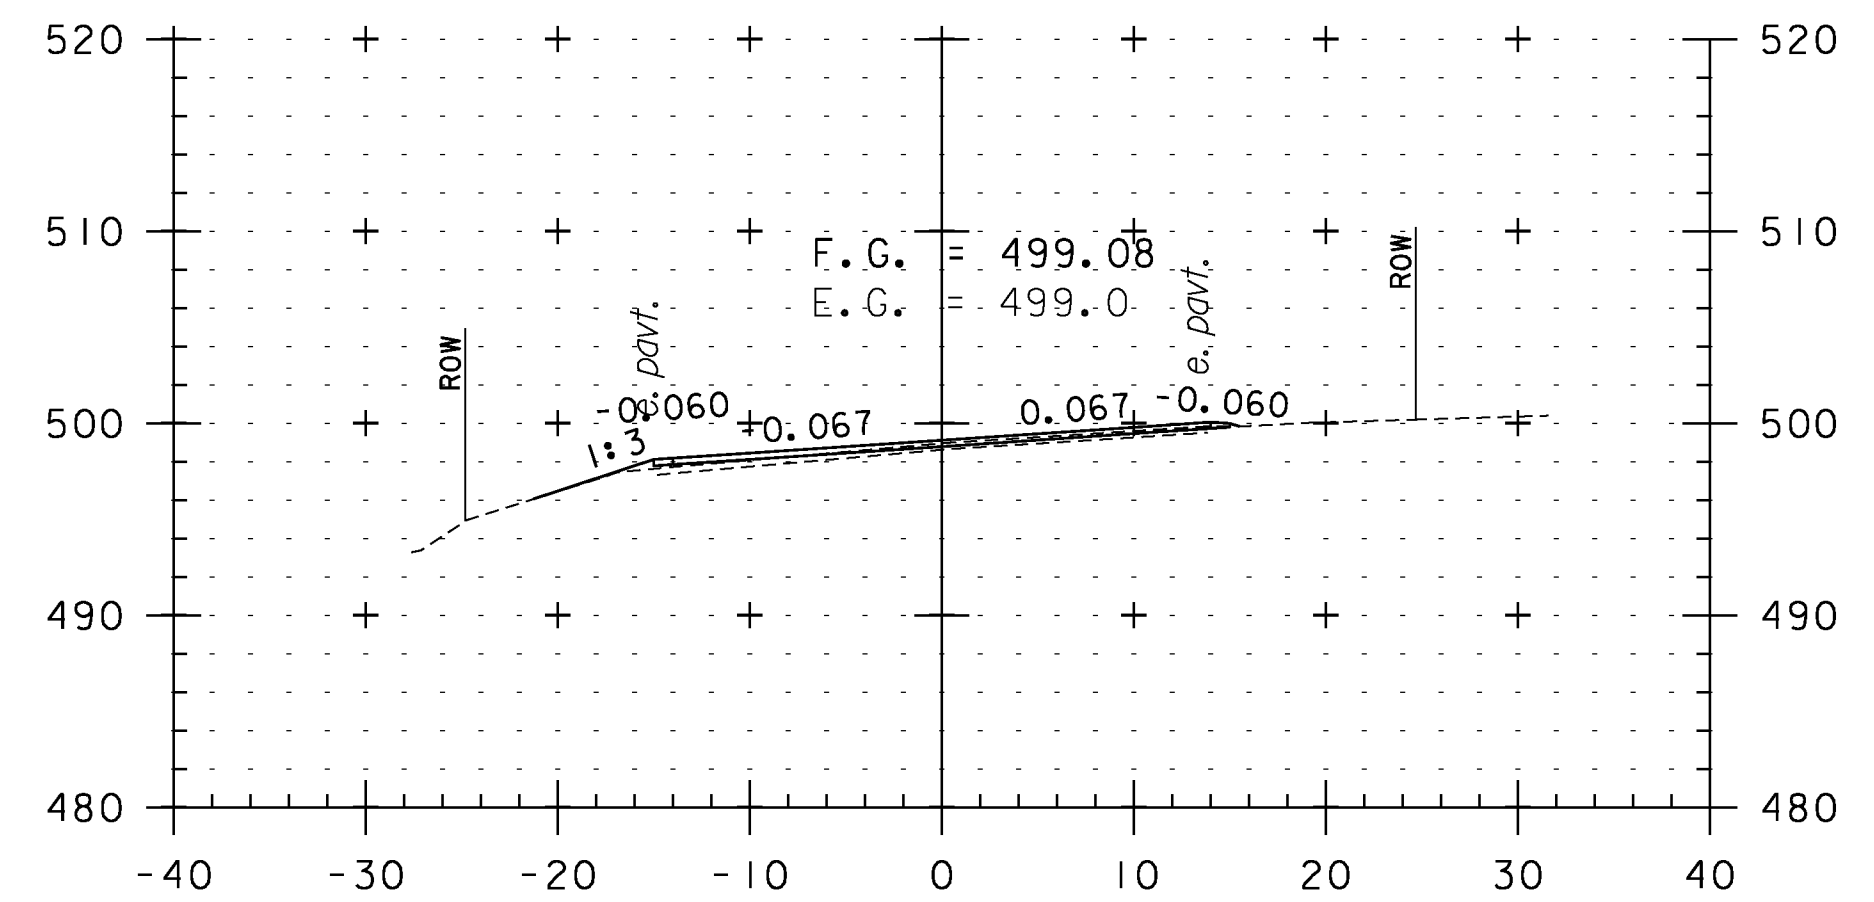


427+00

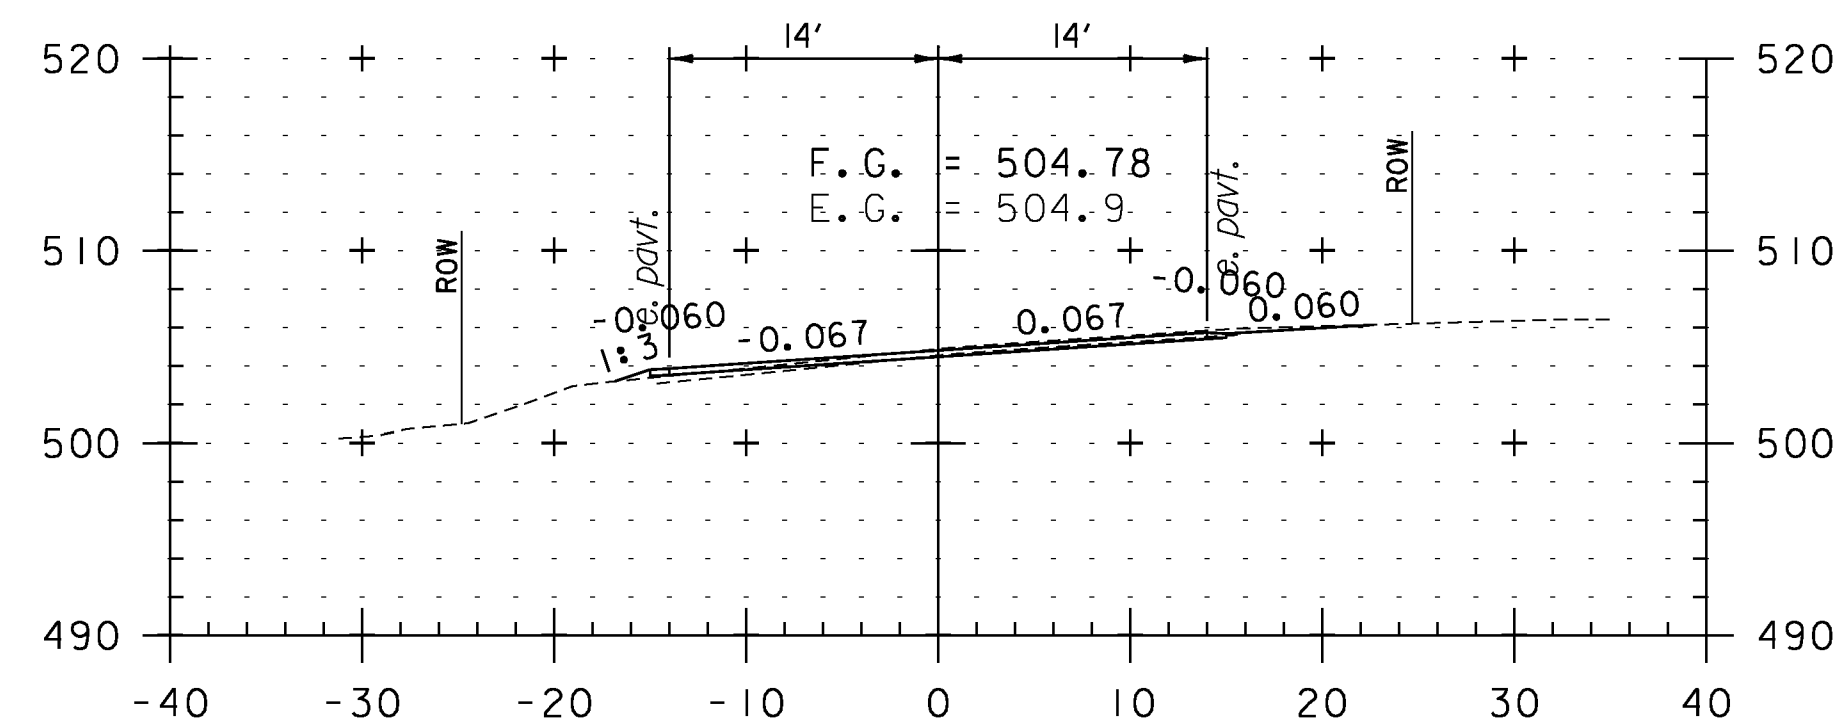

423+50

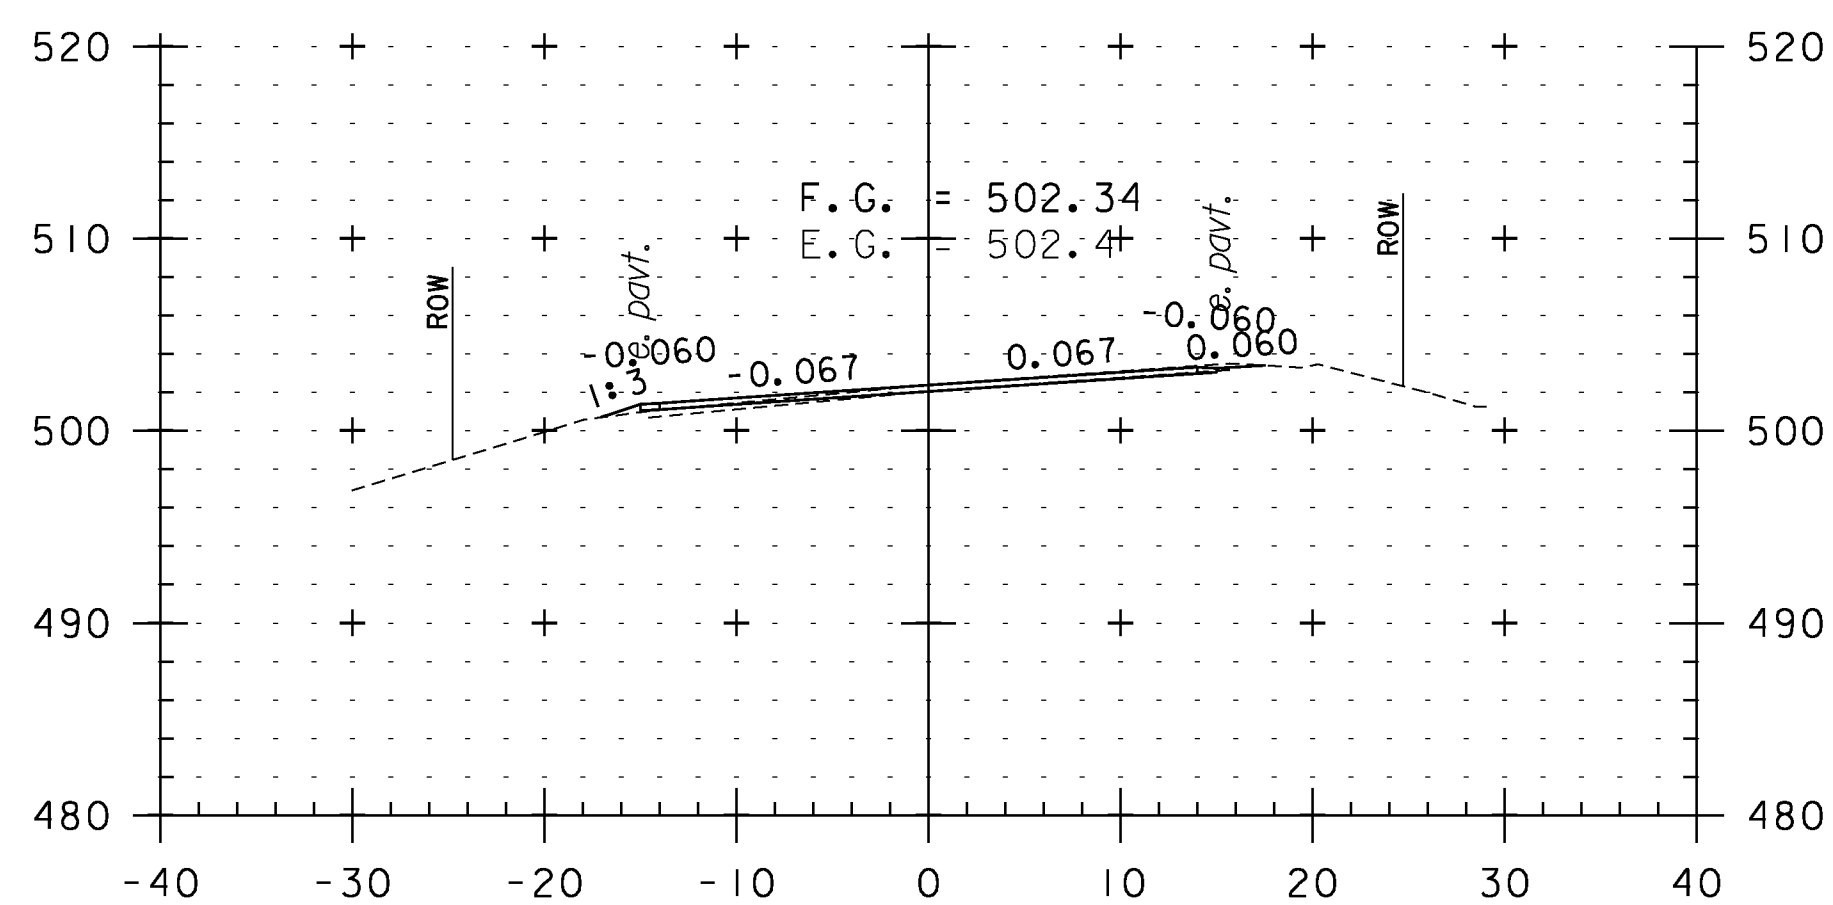

425+00

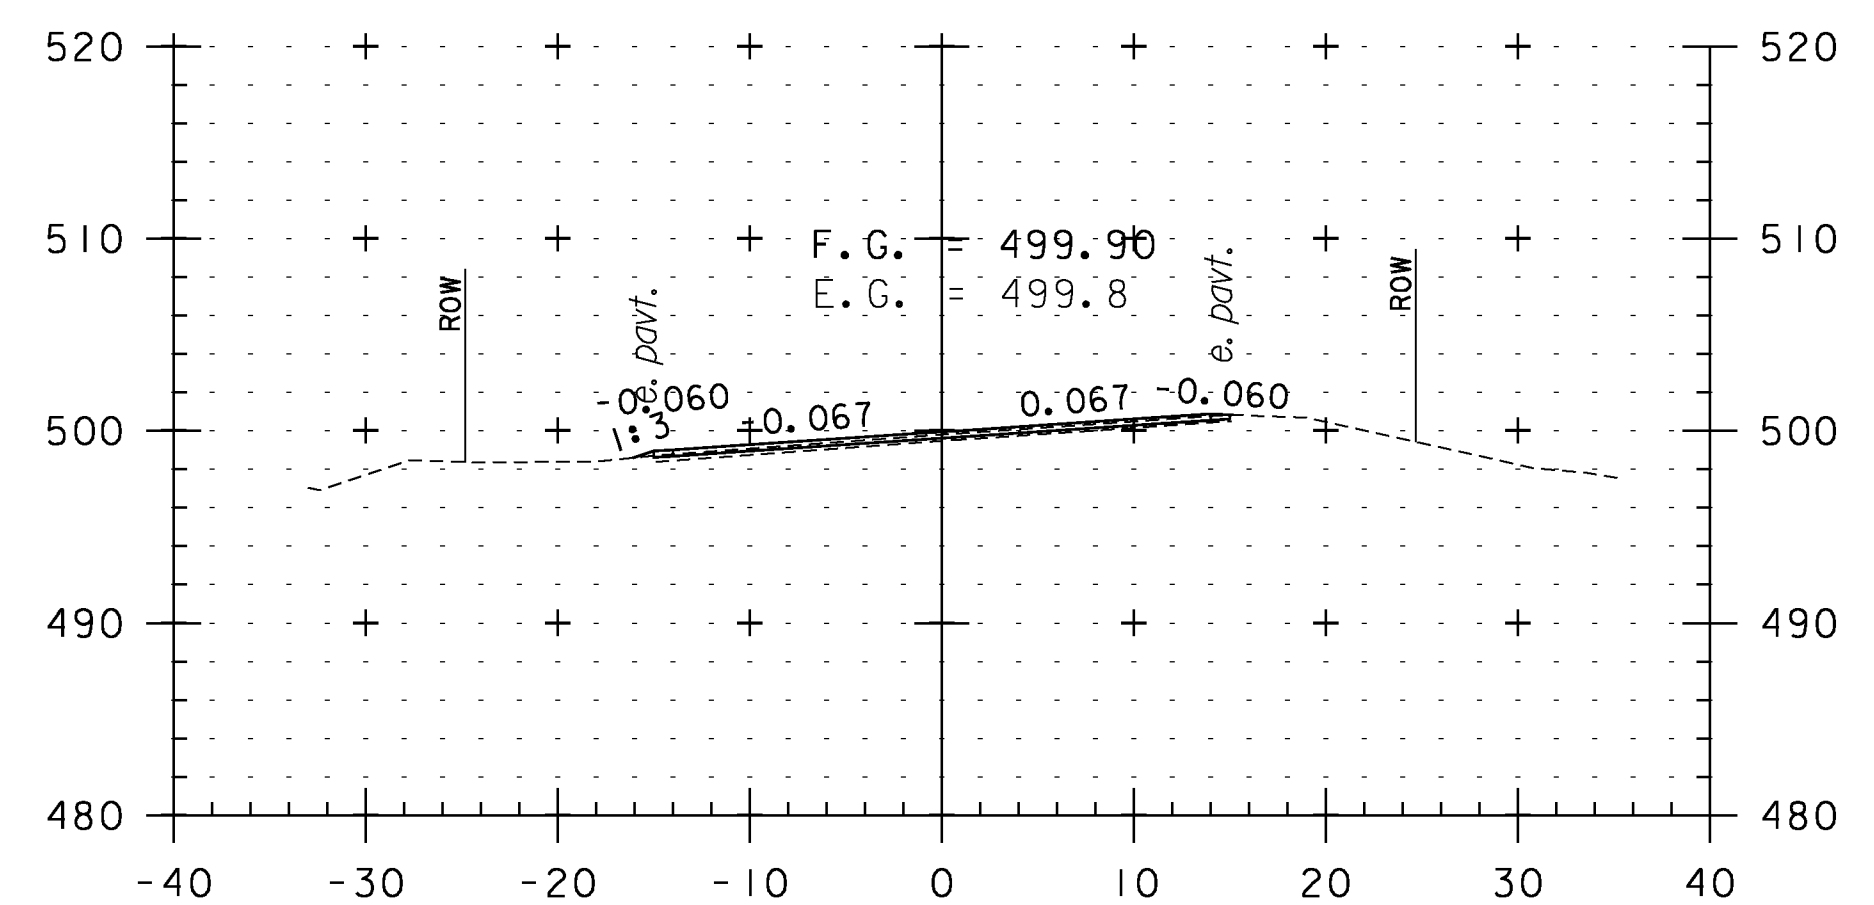

426+50

CROSS SECTION SHEET 85

| | |
|------------------------------|---------------------|
| PROJECT NAME: WEATHERSFIELD | PLOT DATE: 2/7/2013 |
| PROJECT NUMBER: STP 2913(I) | DRAWN BY: WWG |
| FILE NAME: I0c228 | CHECKED BY: PTS |
| PROJECT LEADER: PTS | SHEET 175 OF 234 |
| DESIGNED BY: NLL | |
| IPARM FILE NAME: pI0c228_175 | |



STA. 423+50 TO STA. 427+50