



60+25

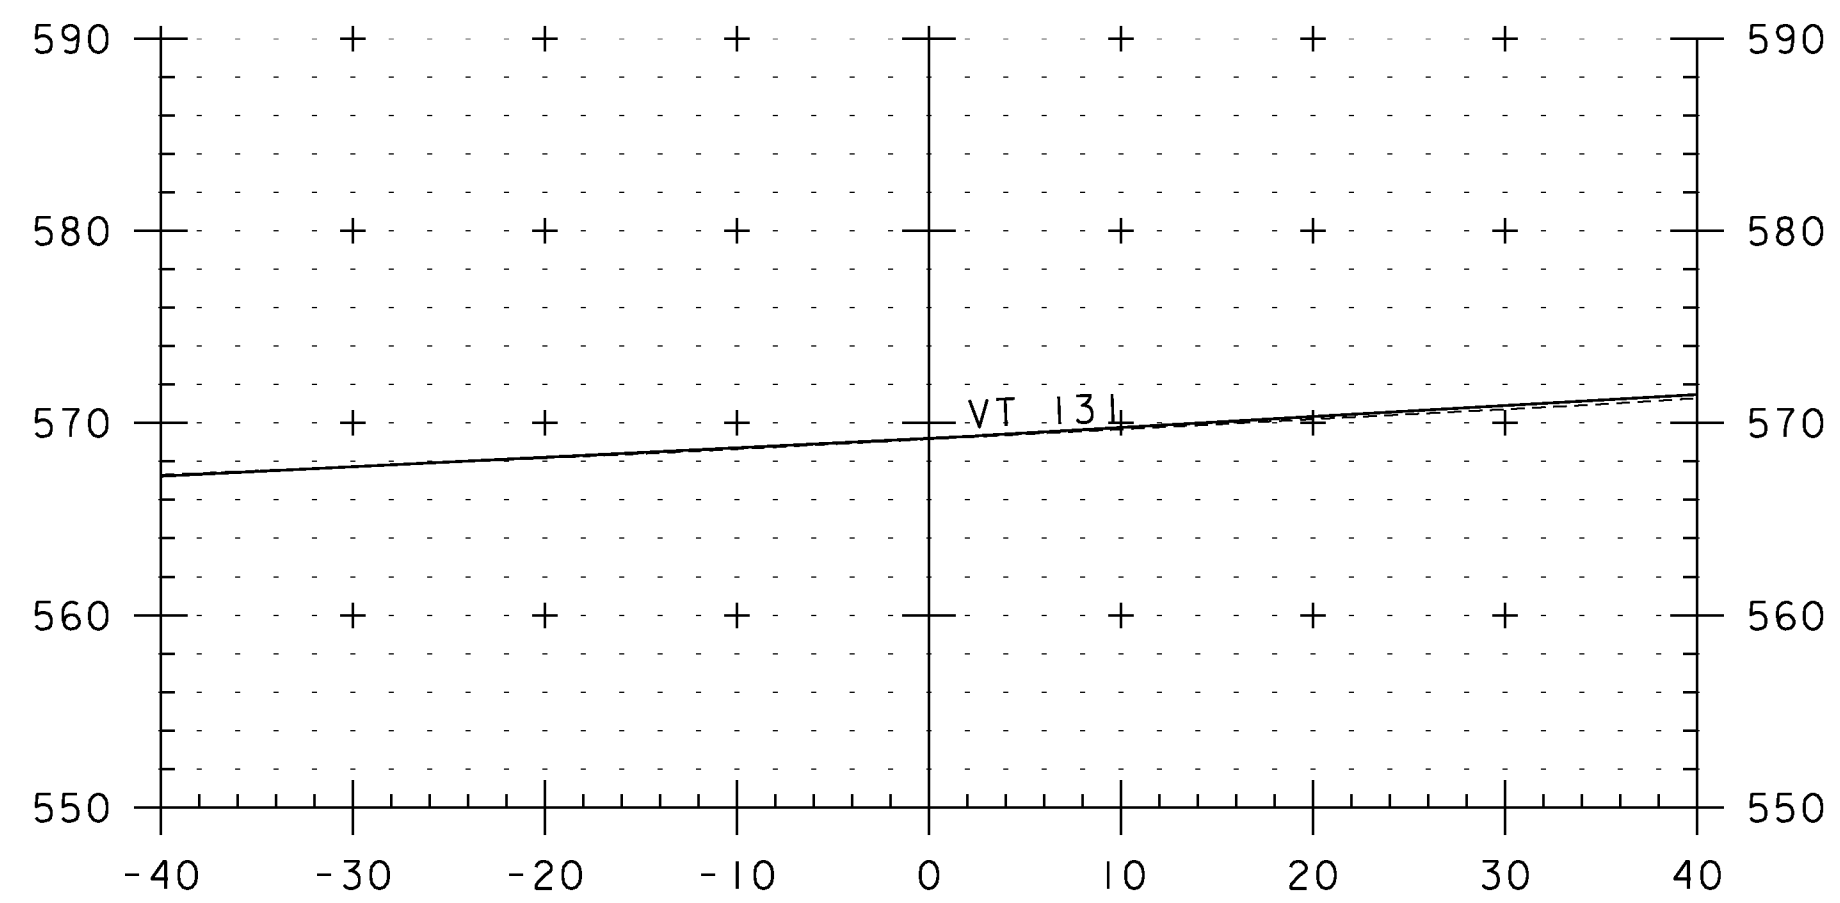

60+00

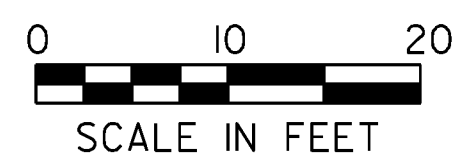

STA. 60+00 TO STA. 60+25

CROSS SECTION TH 102

PROJECT NAME: WEATHERSFIELD	PLOT DATE: 2/7/2013
PROJECT NUMBER: STP 2913(I)	DRAWN BY: JLS
FILE NAME: I0c228	CHECKED BY: PTS
PROJECT LEADER: PTS	SHEET 182 OF 234
DESIGNED BY: JLS	
IPARM FILE NAME: pI0C228.l82	