




85+27

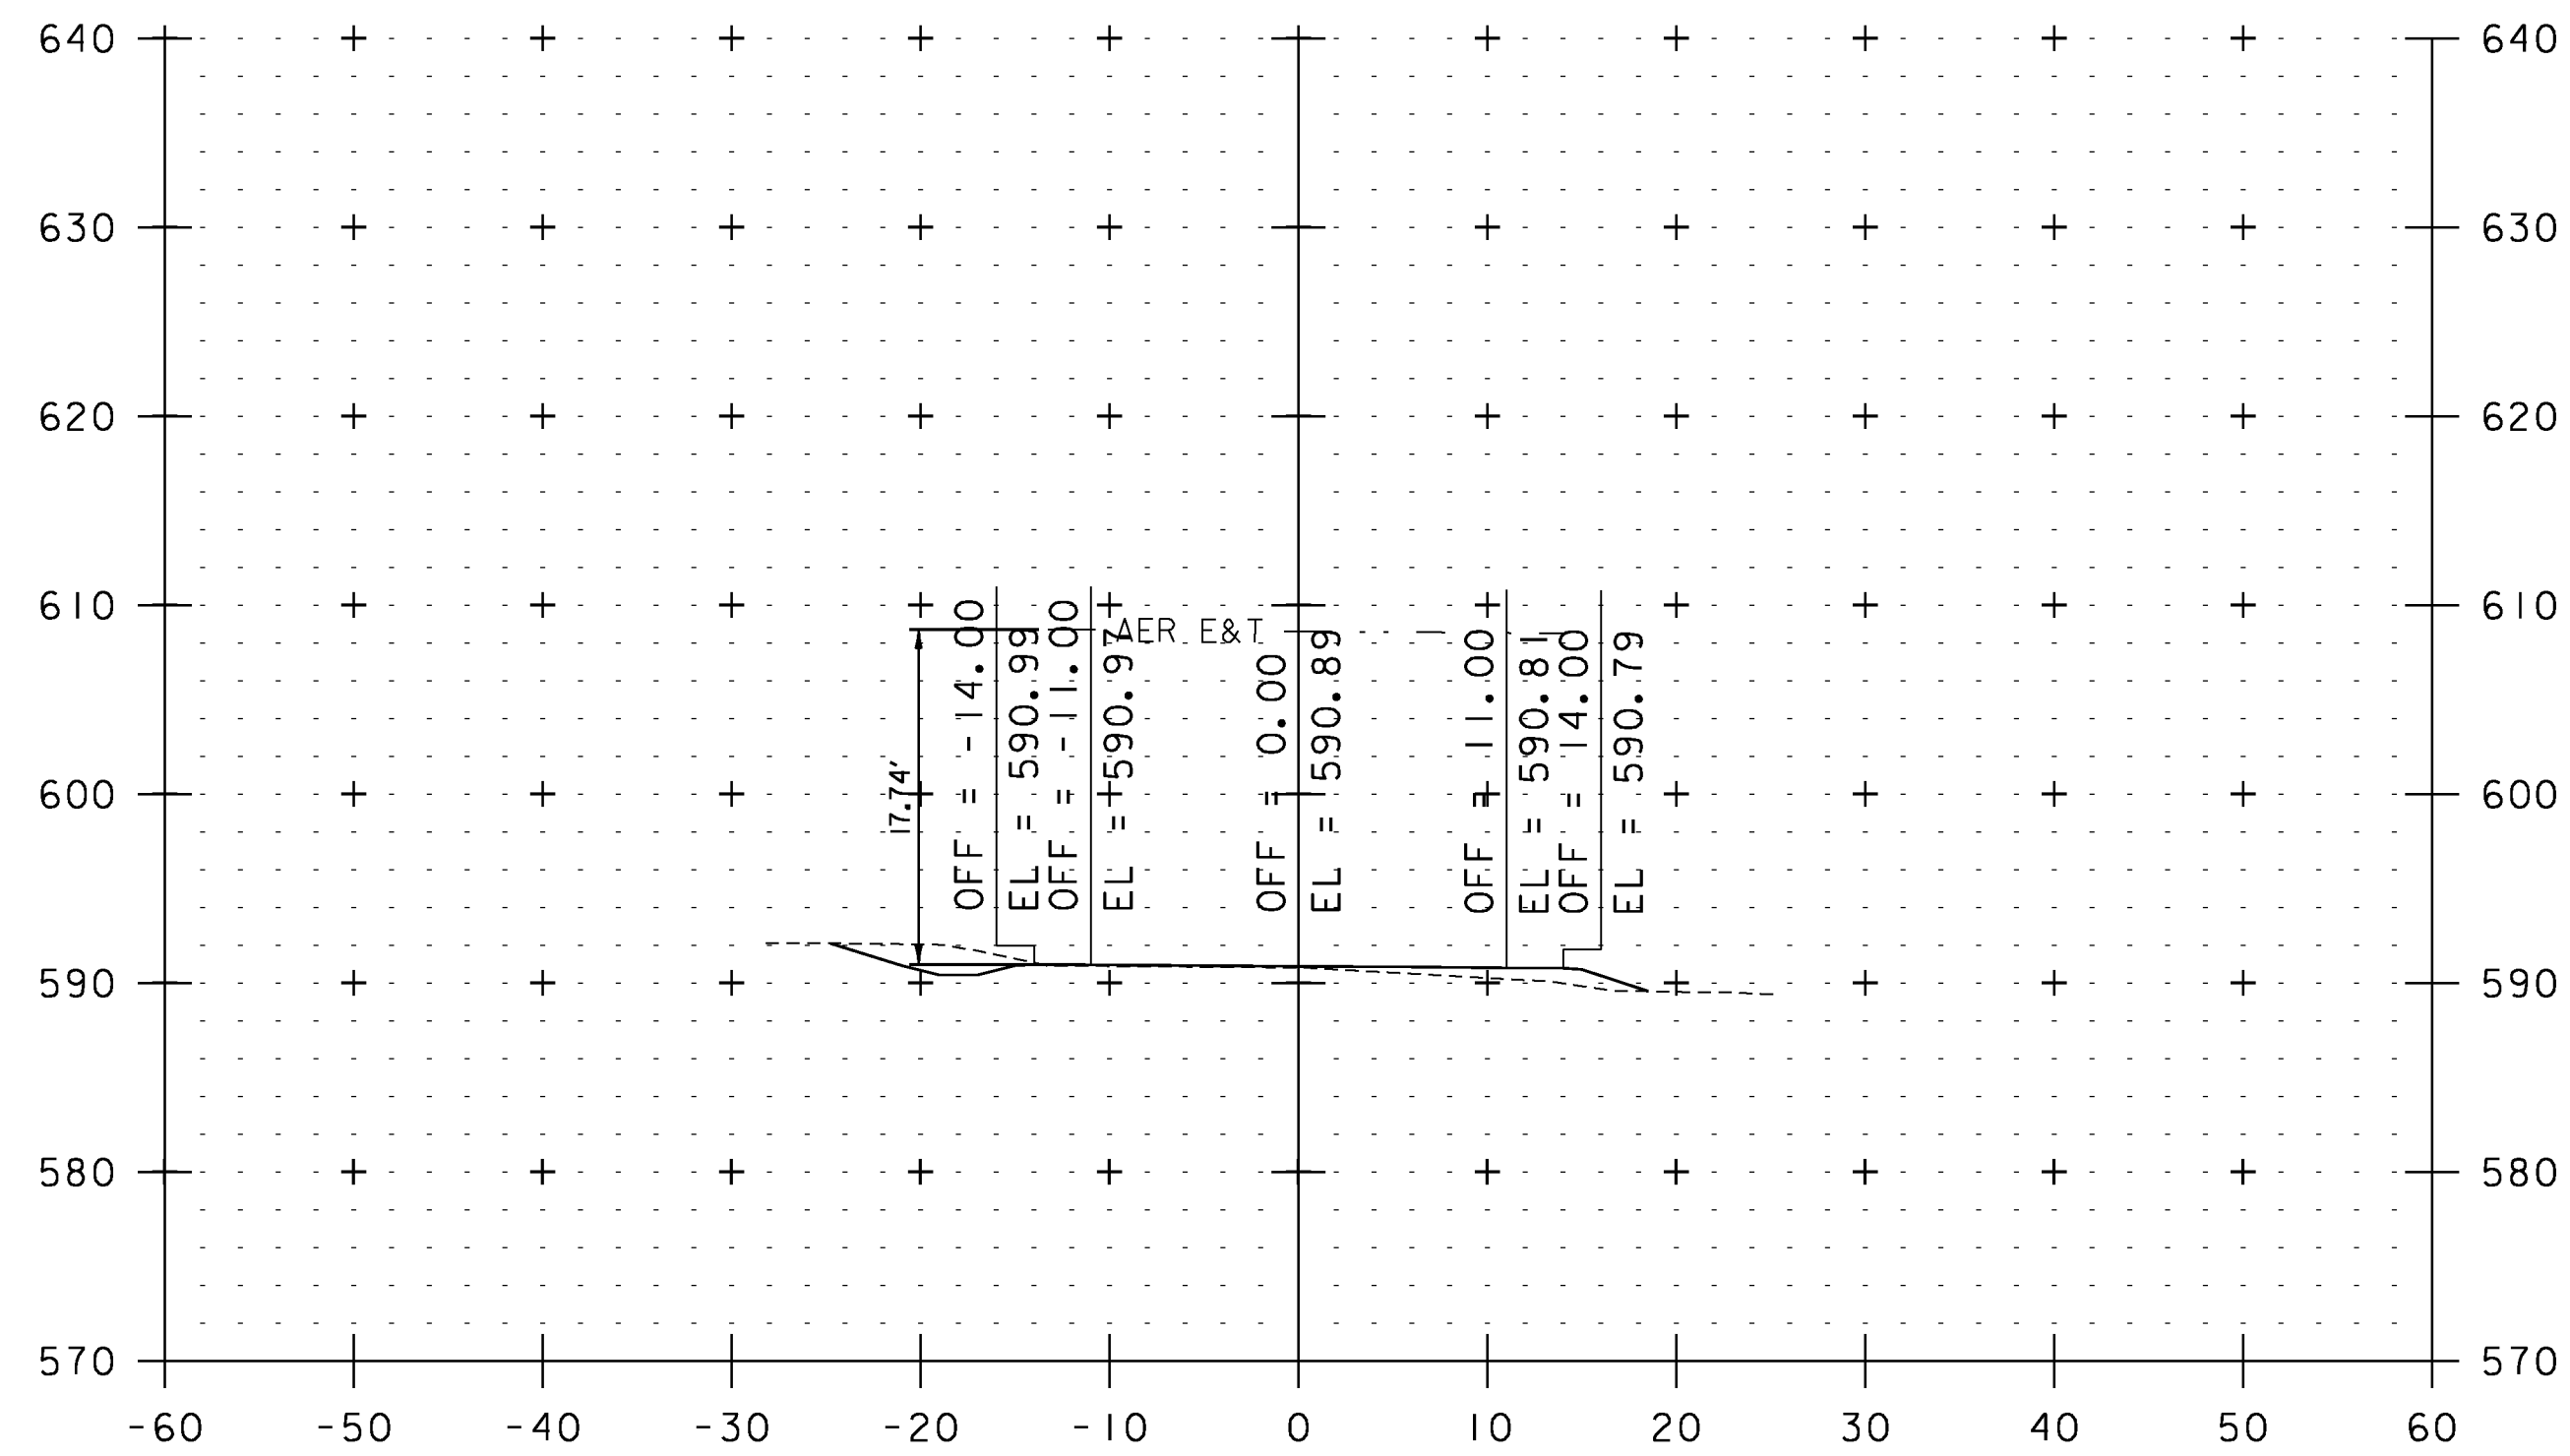


96+37

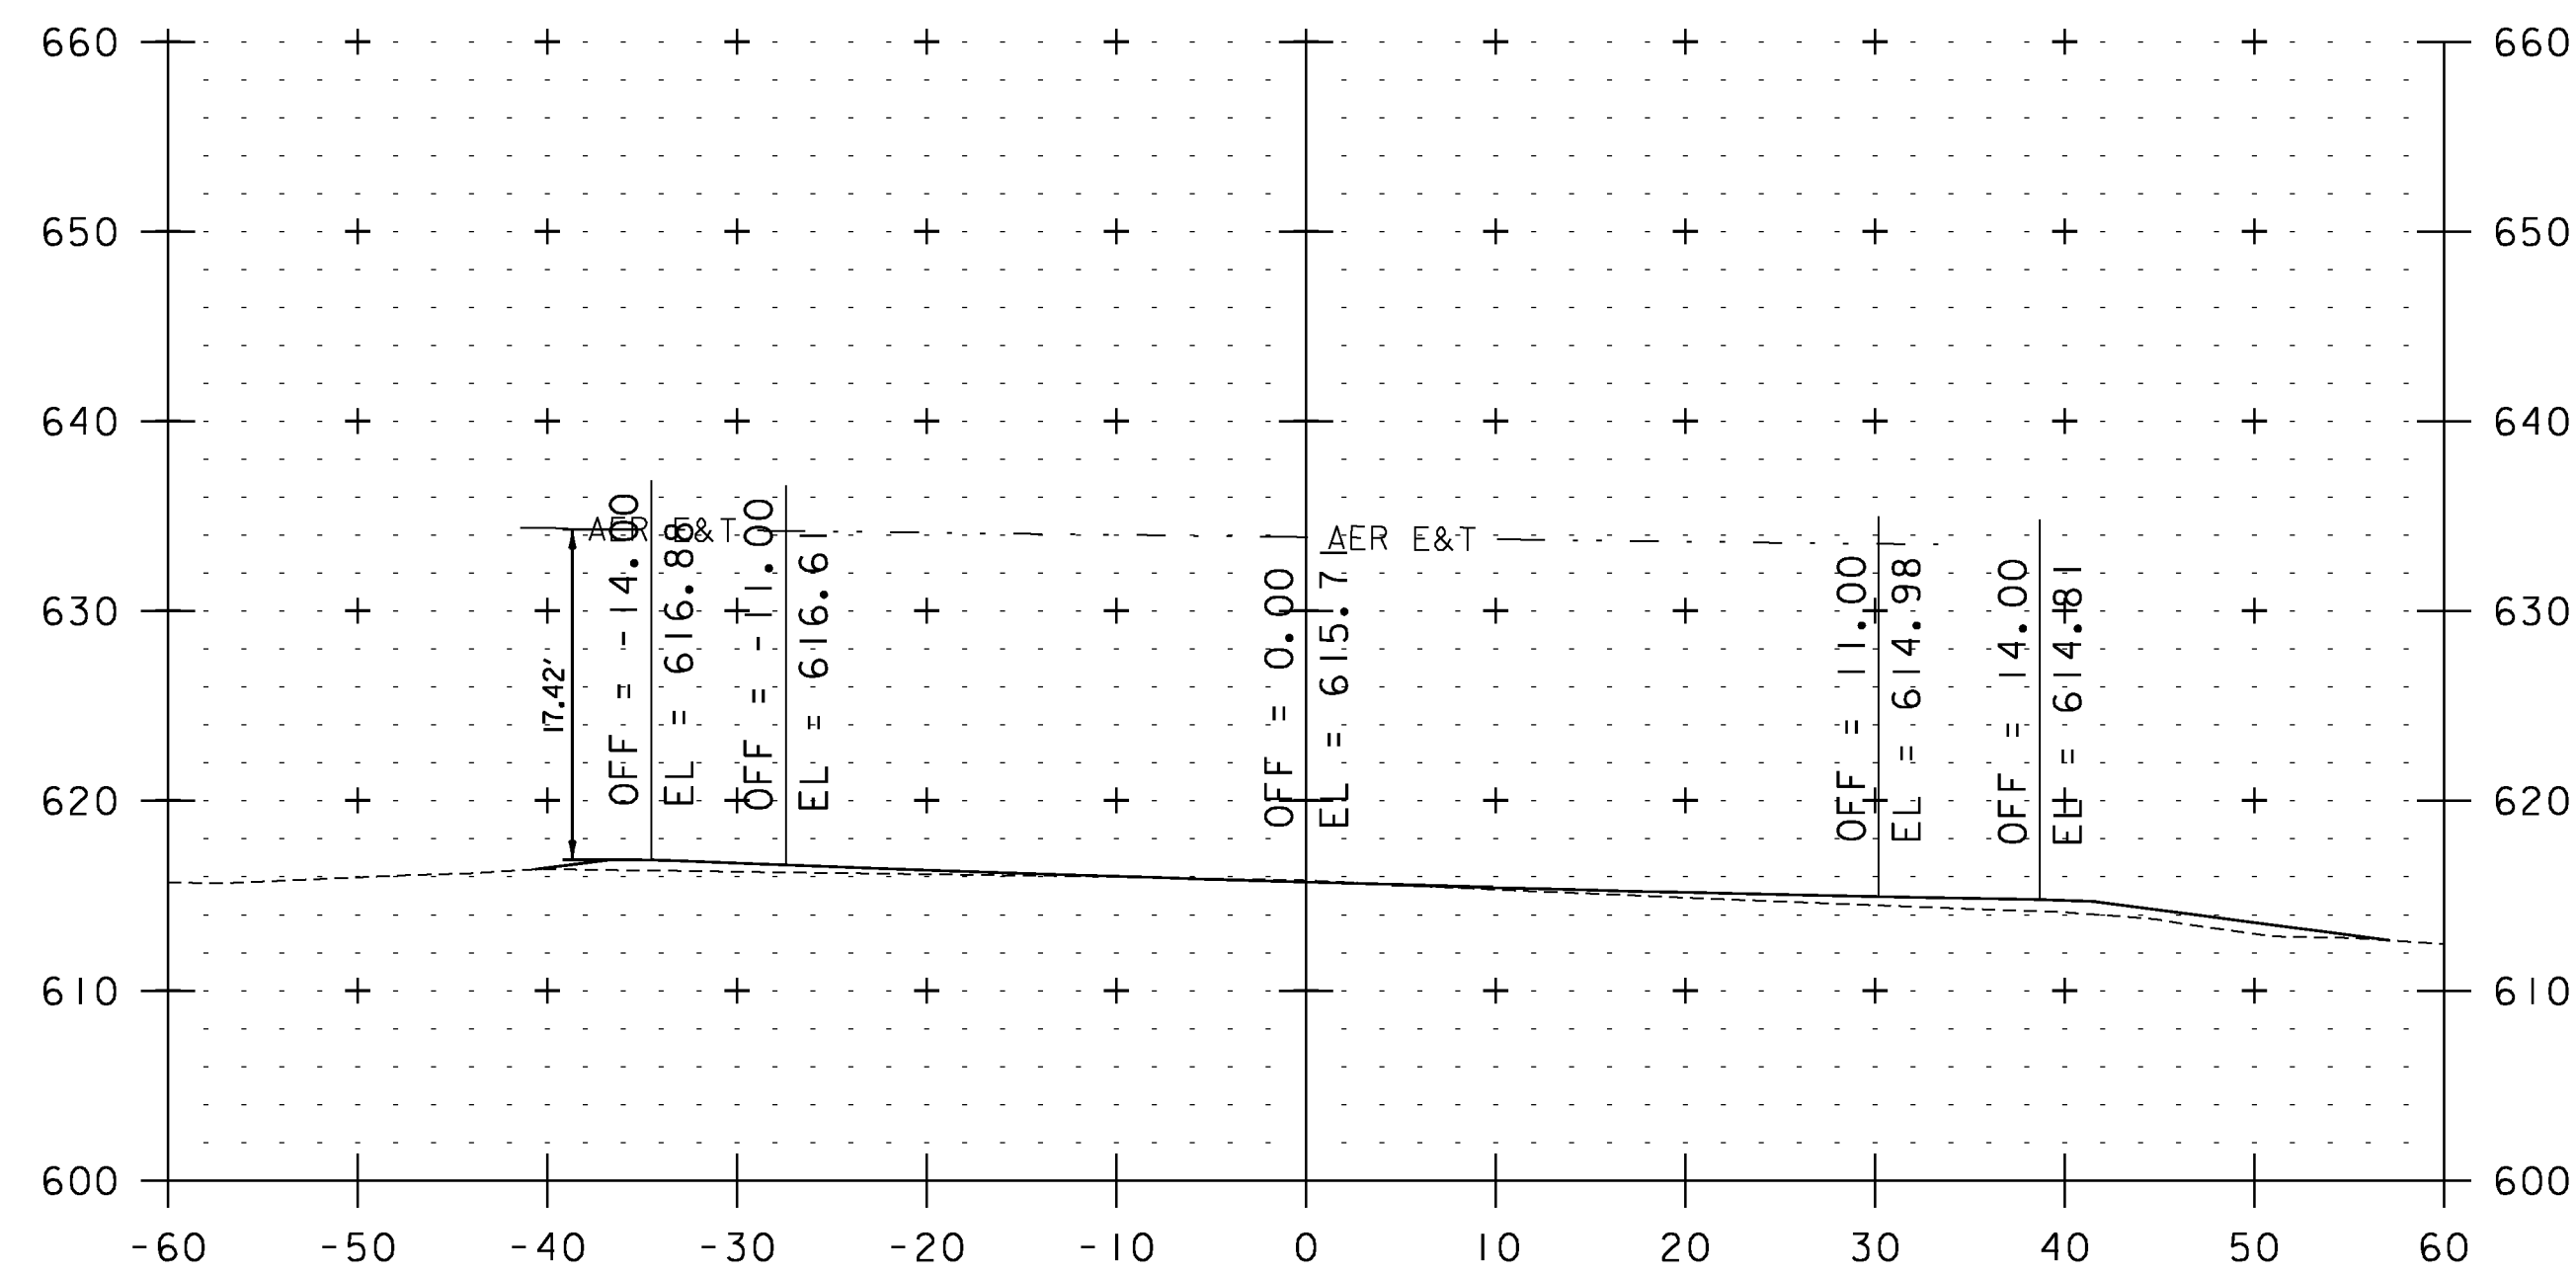

80+71

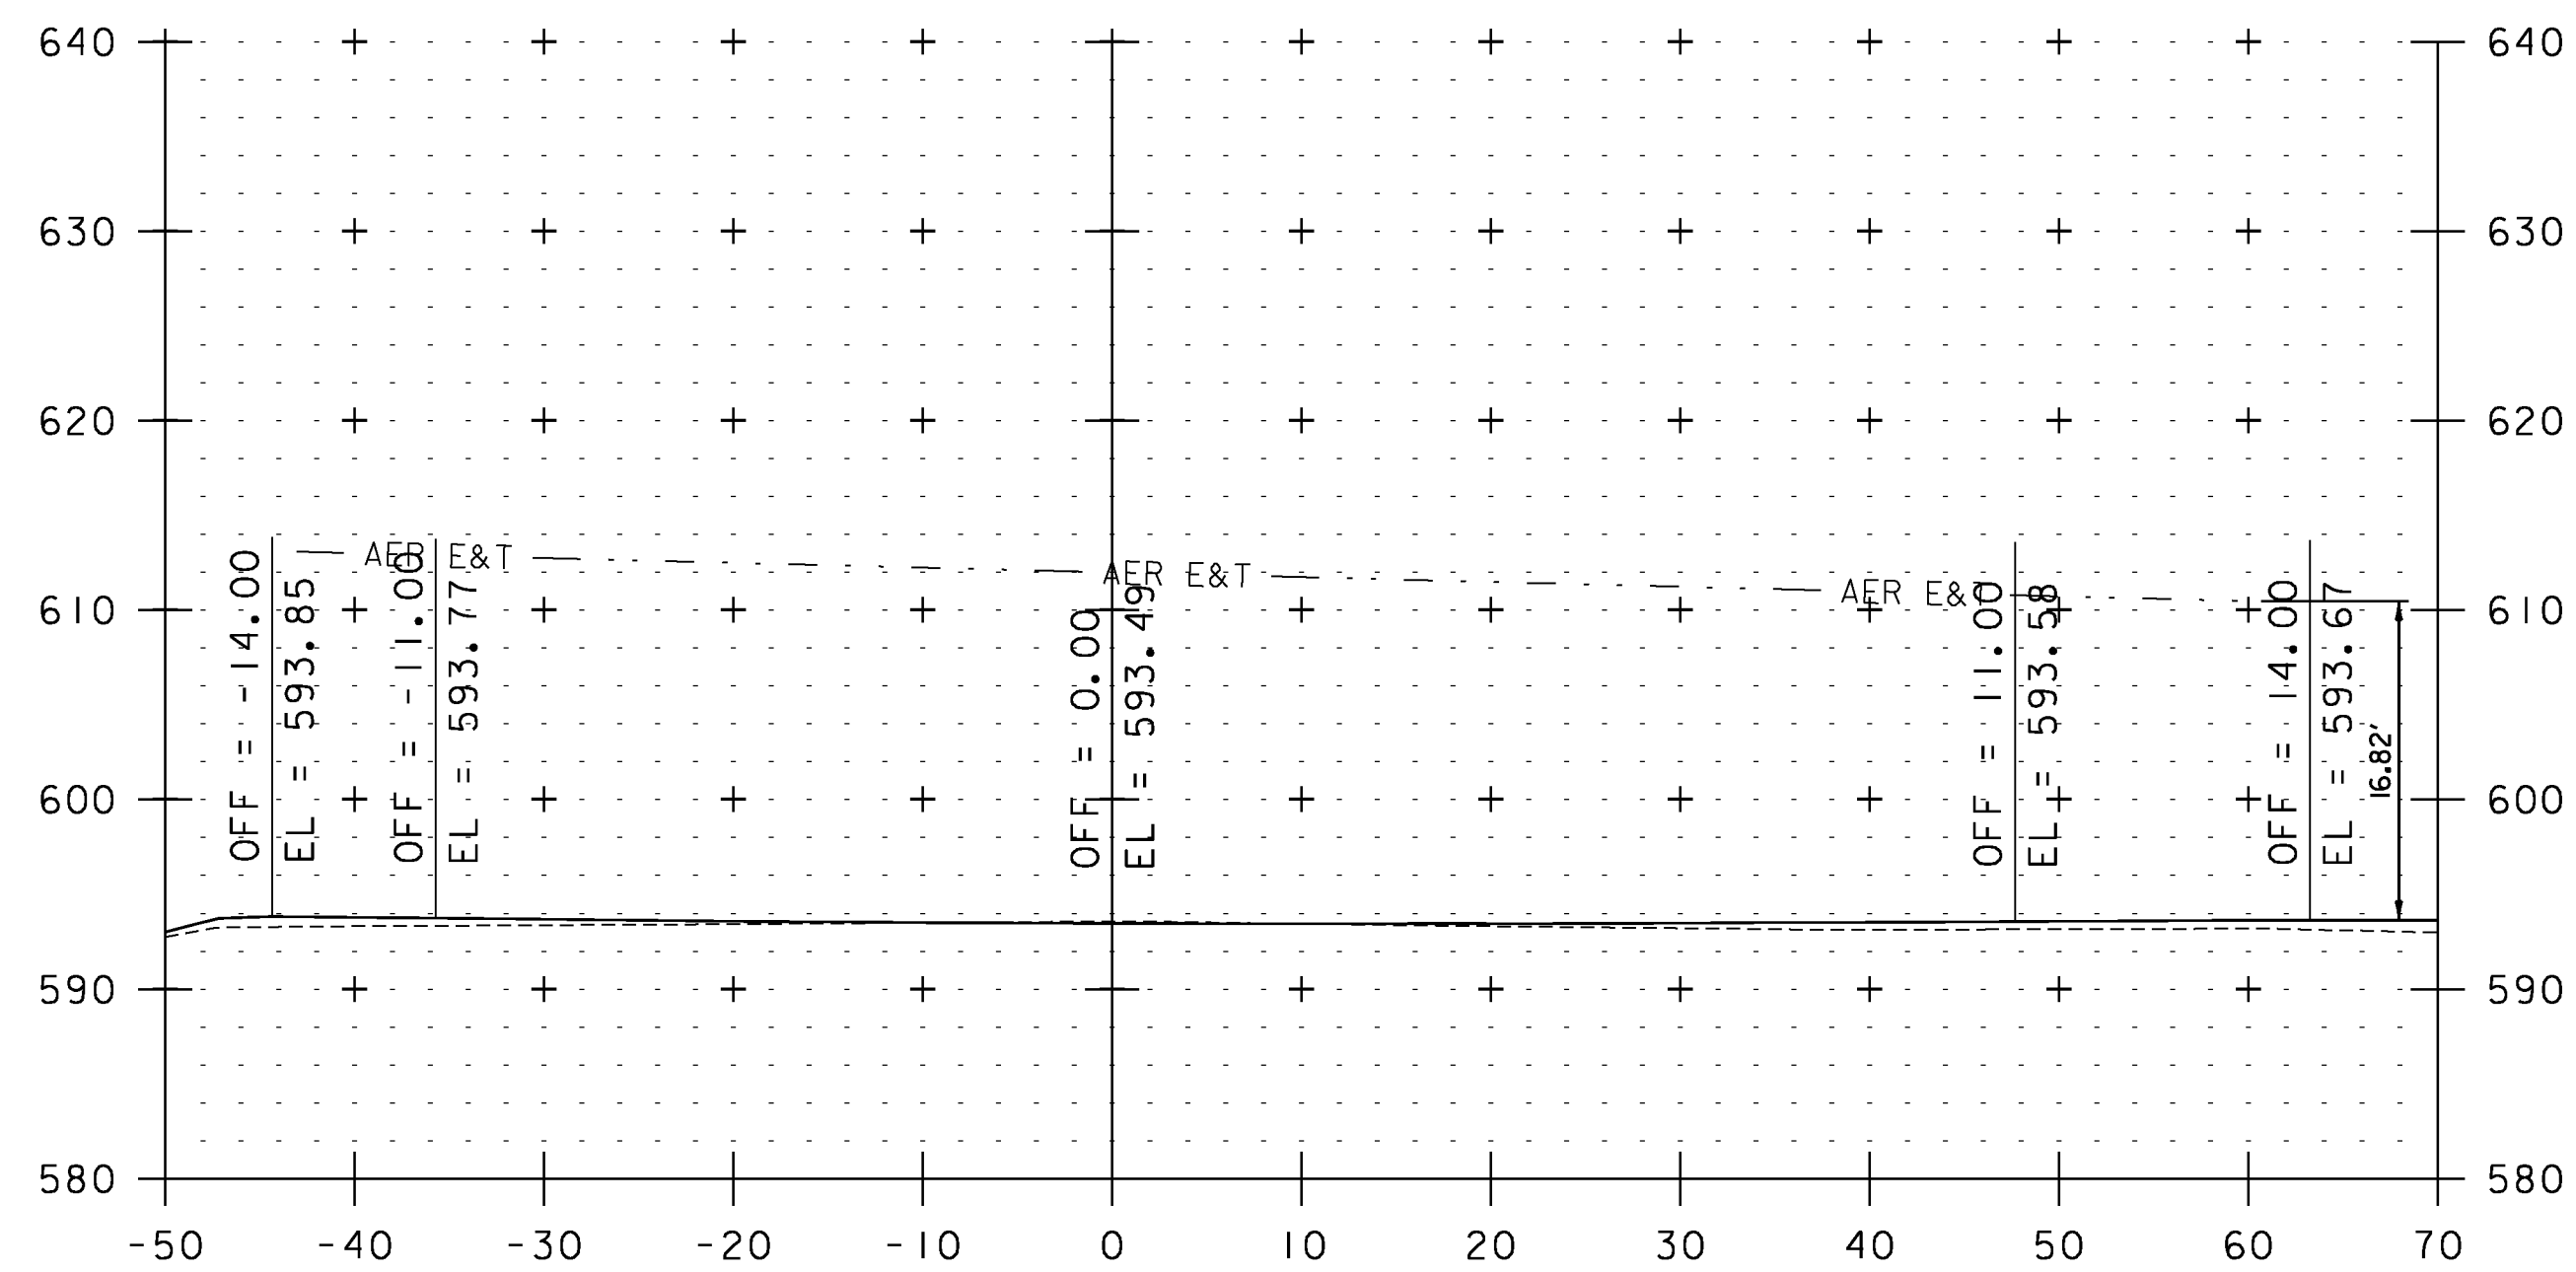

89+70

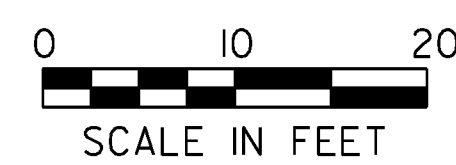

STA. 80+71 TO STA. 96+37

UTILITY CROSS SECTION SHEET 2

| | |
|------------------------------|---------------------|
| PROJECT NAME: WEATHERSFIELD | PLOT DATE: 2/7/2013 |
| PROJECT NUMBER: STP 2913(I) | DRAWN BY: JLS |
| FILE NAME: I0c228 | CHECKED BY: PTS |
| PROJECT LEADER: PTS | SHEET 184 OF 234 |
| DESIGNED BY: NLL | |
| IPARM FILE NAME: pI0c228_184 | |