




123+43

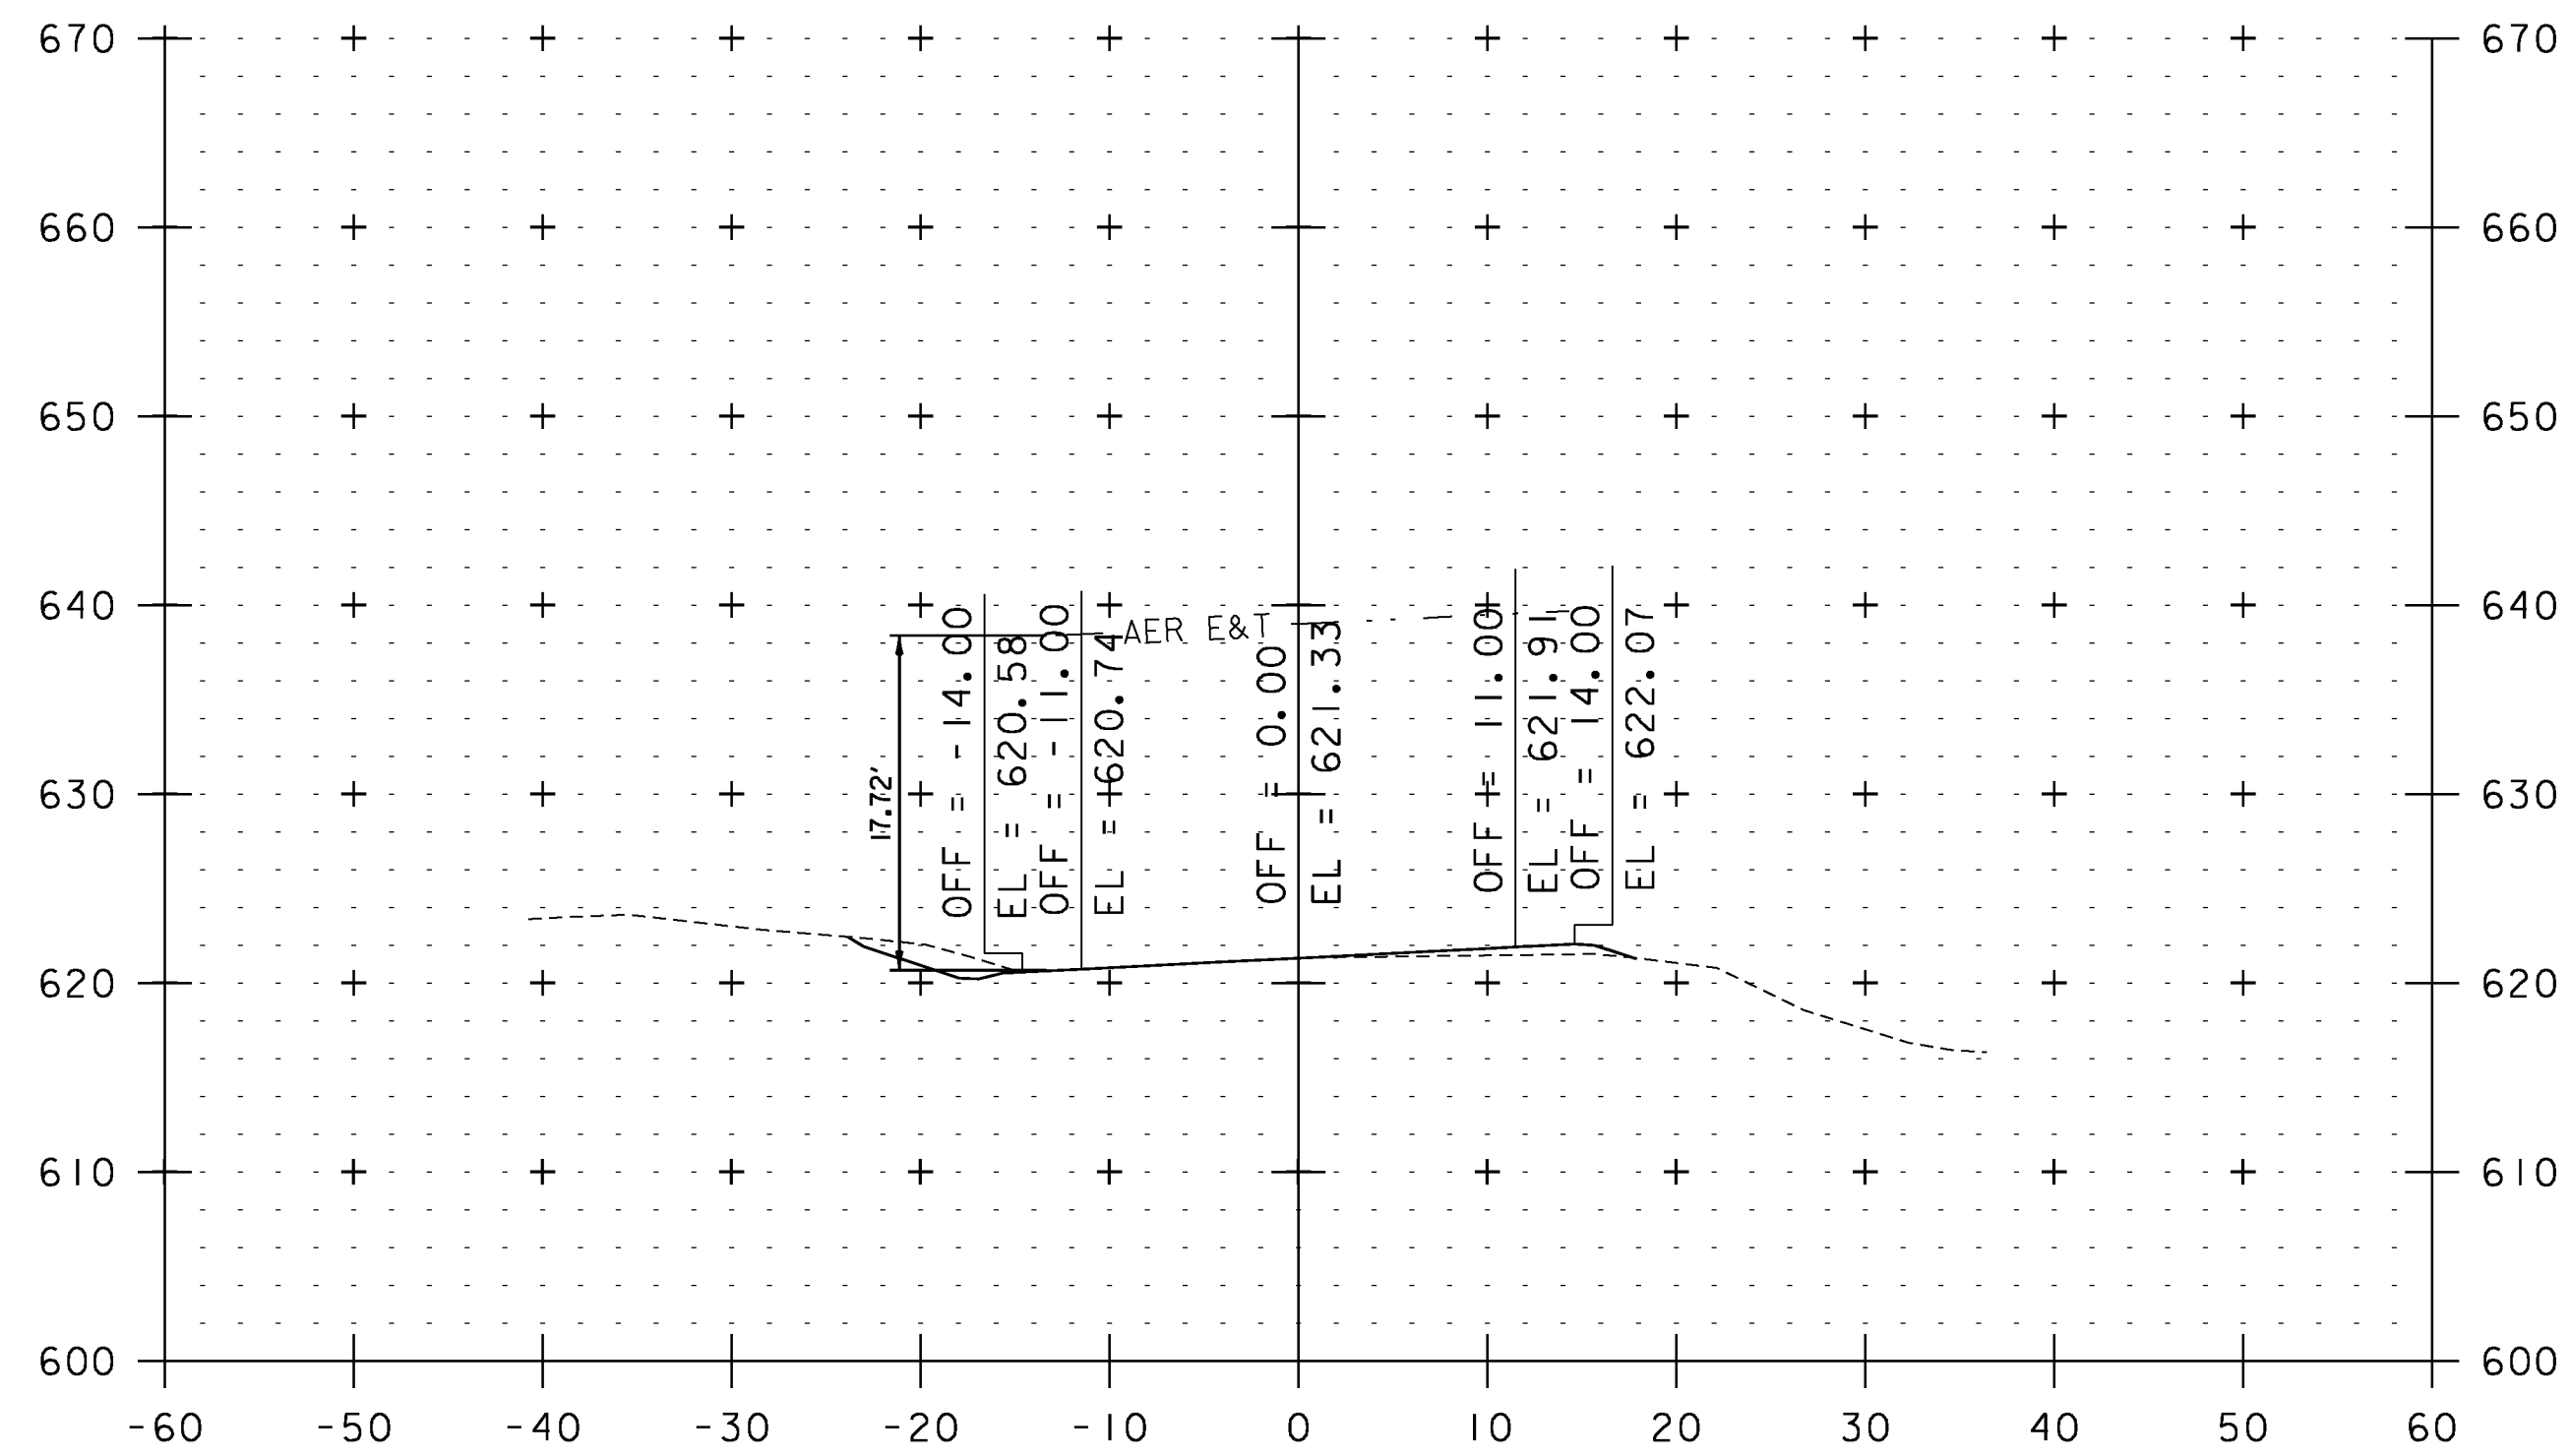

128+92

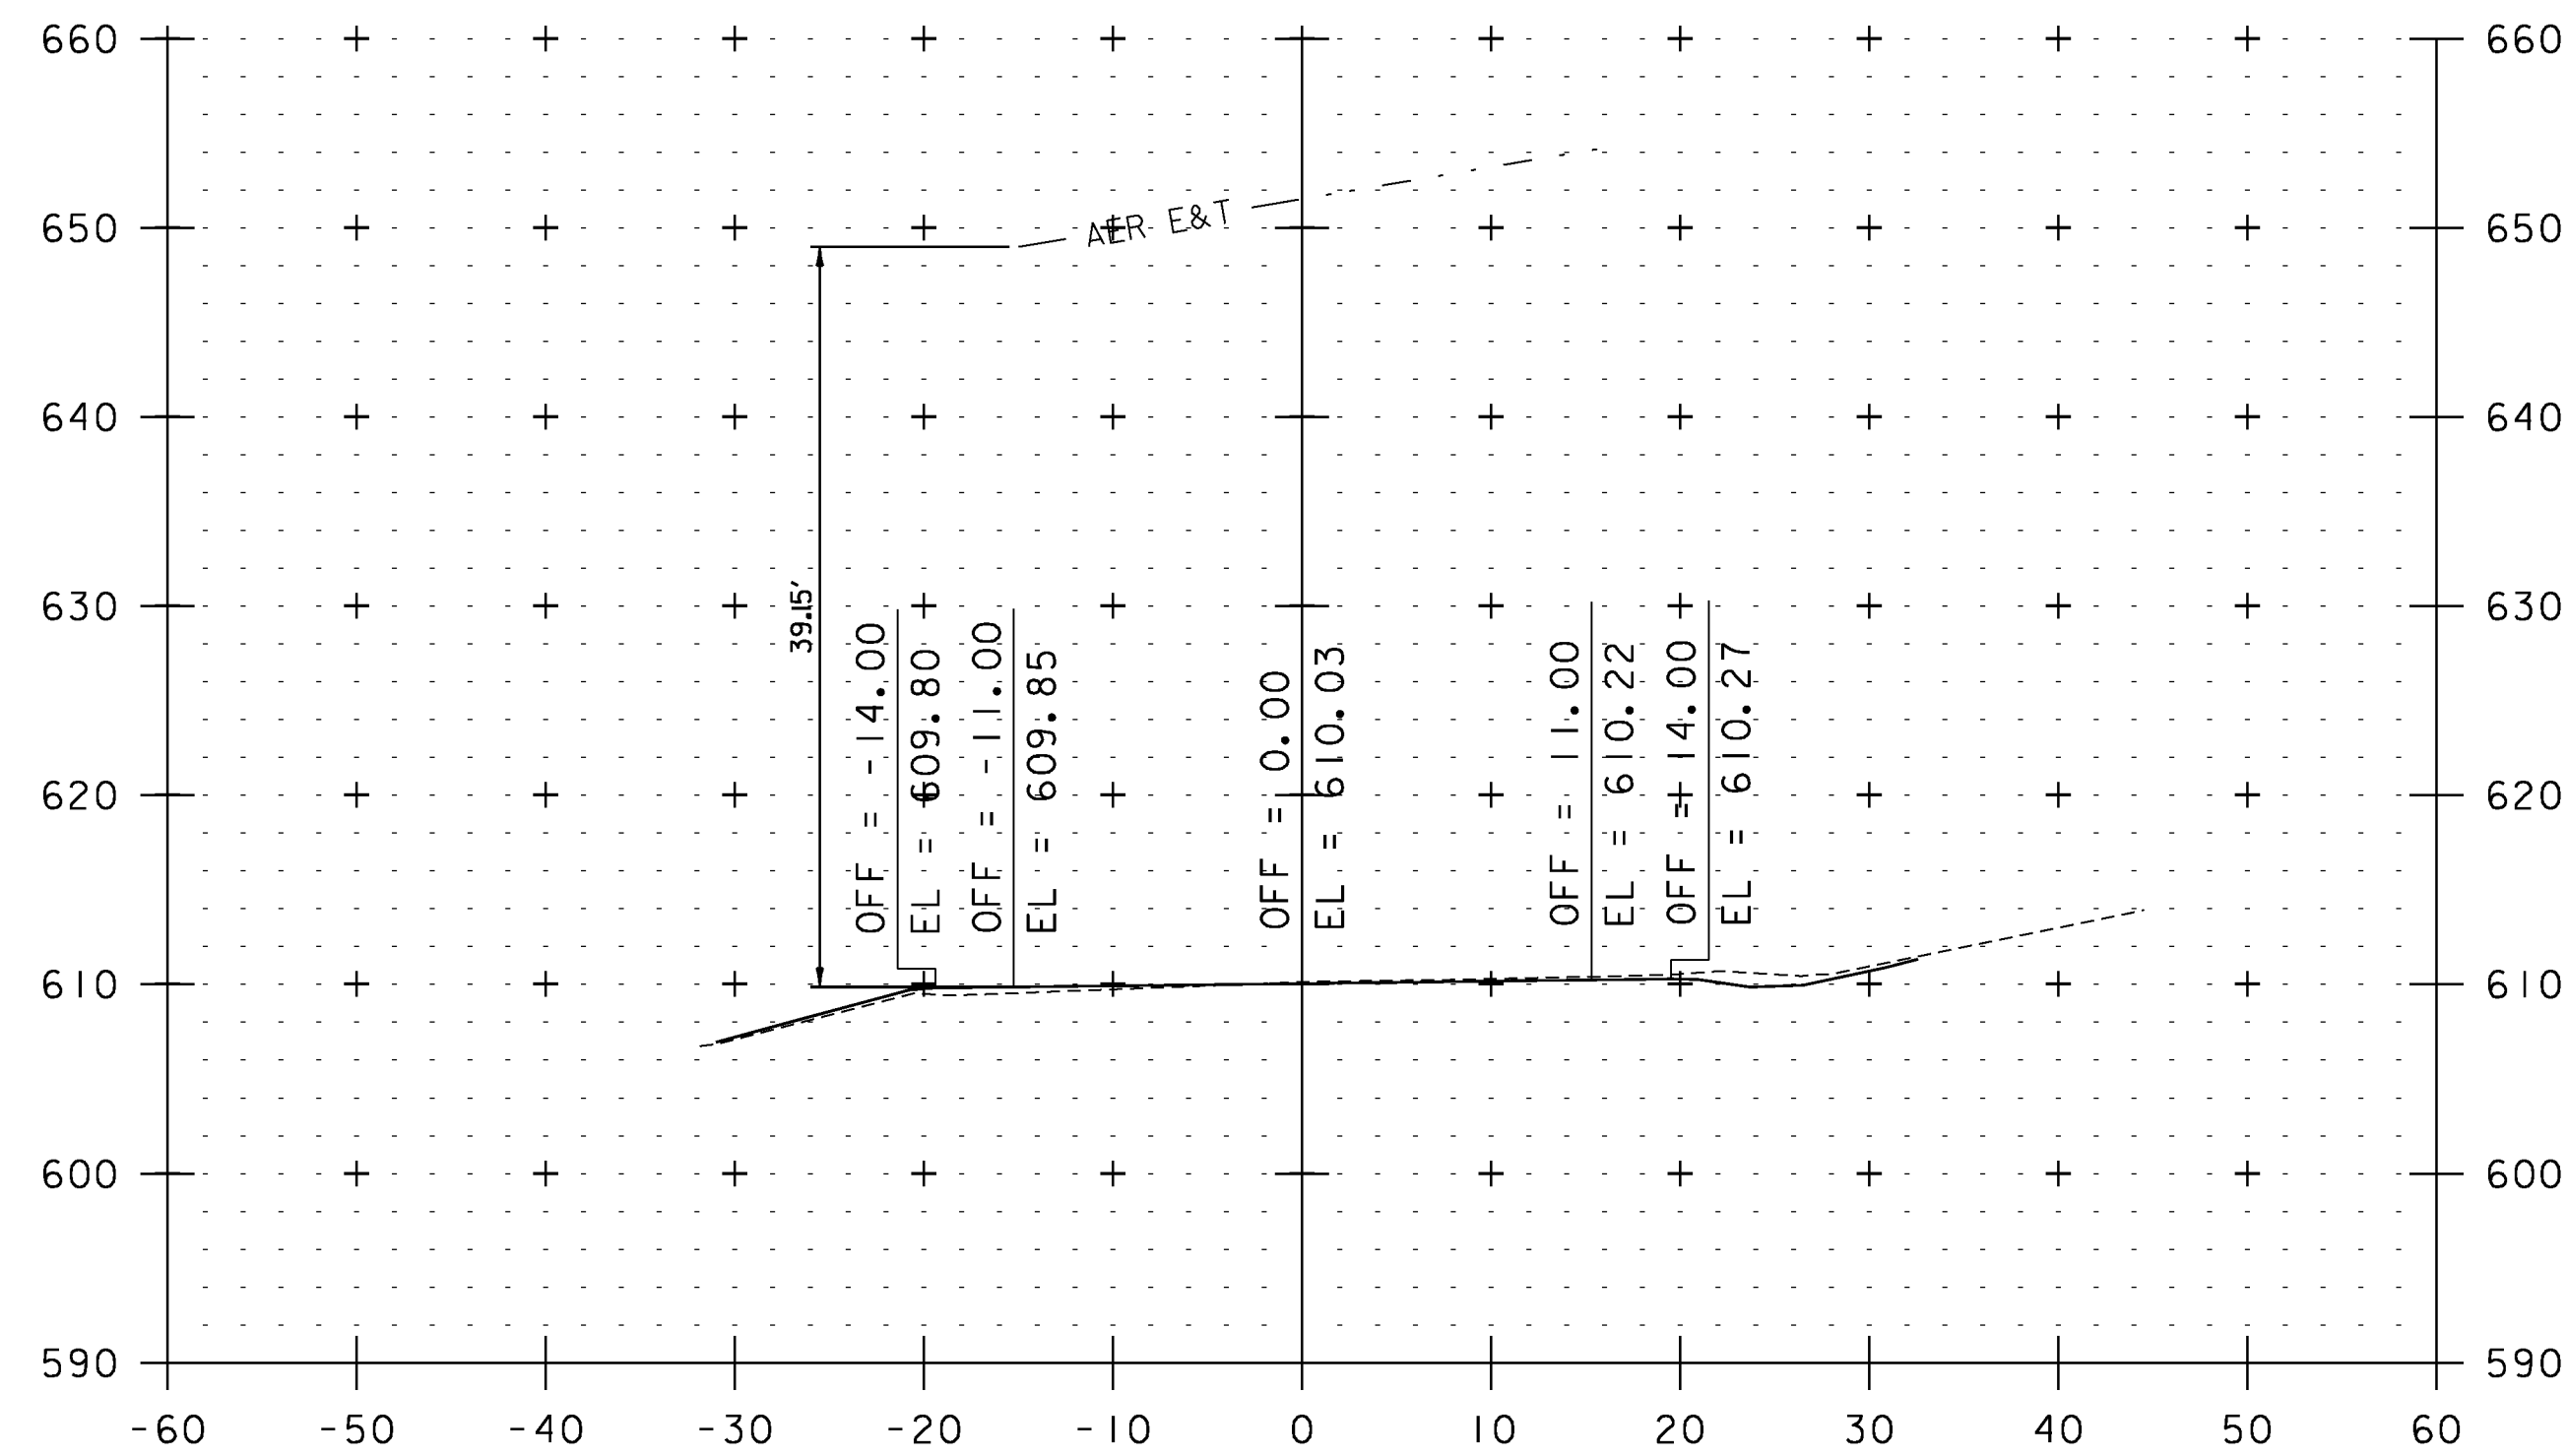

121+23

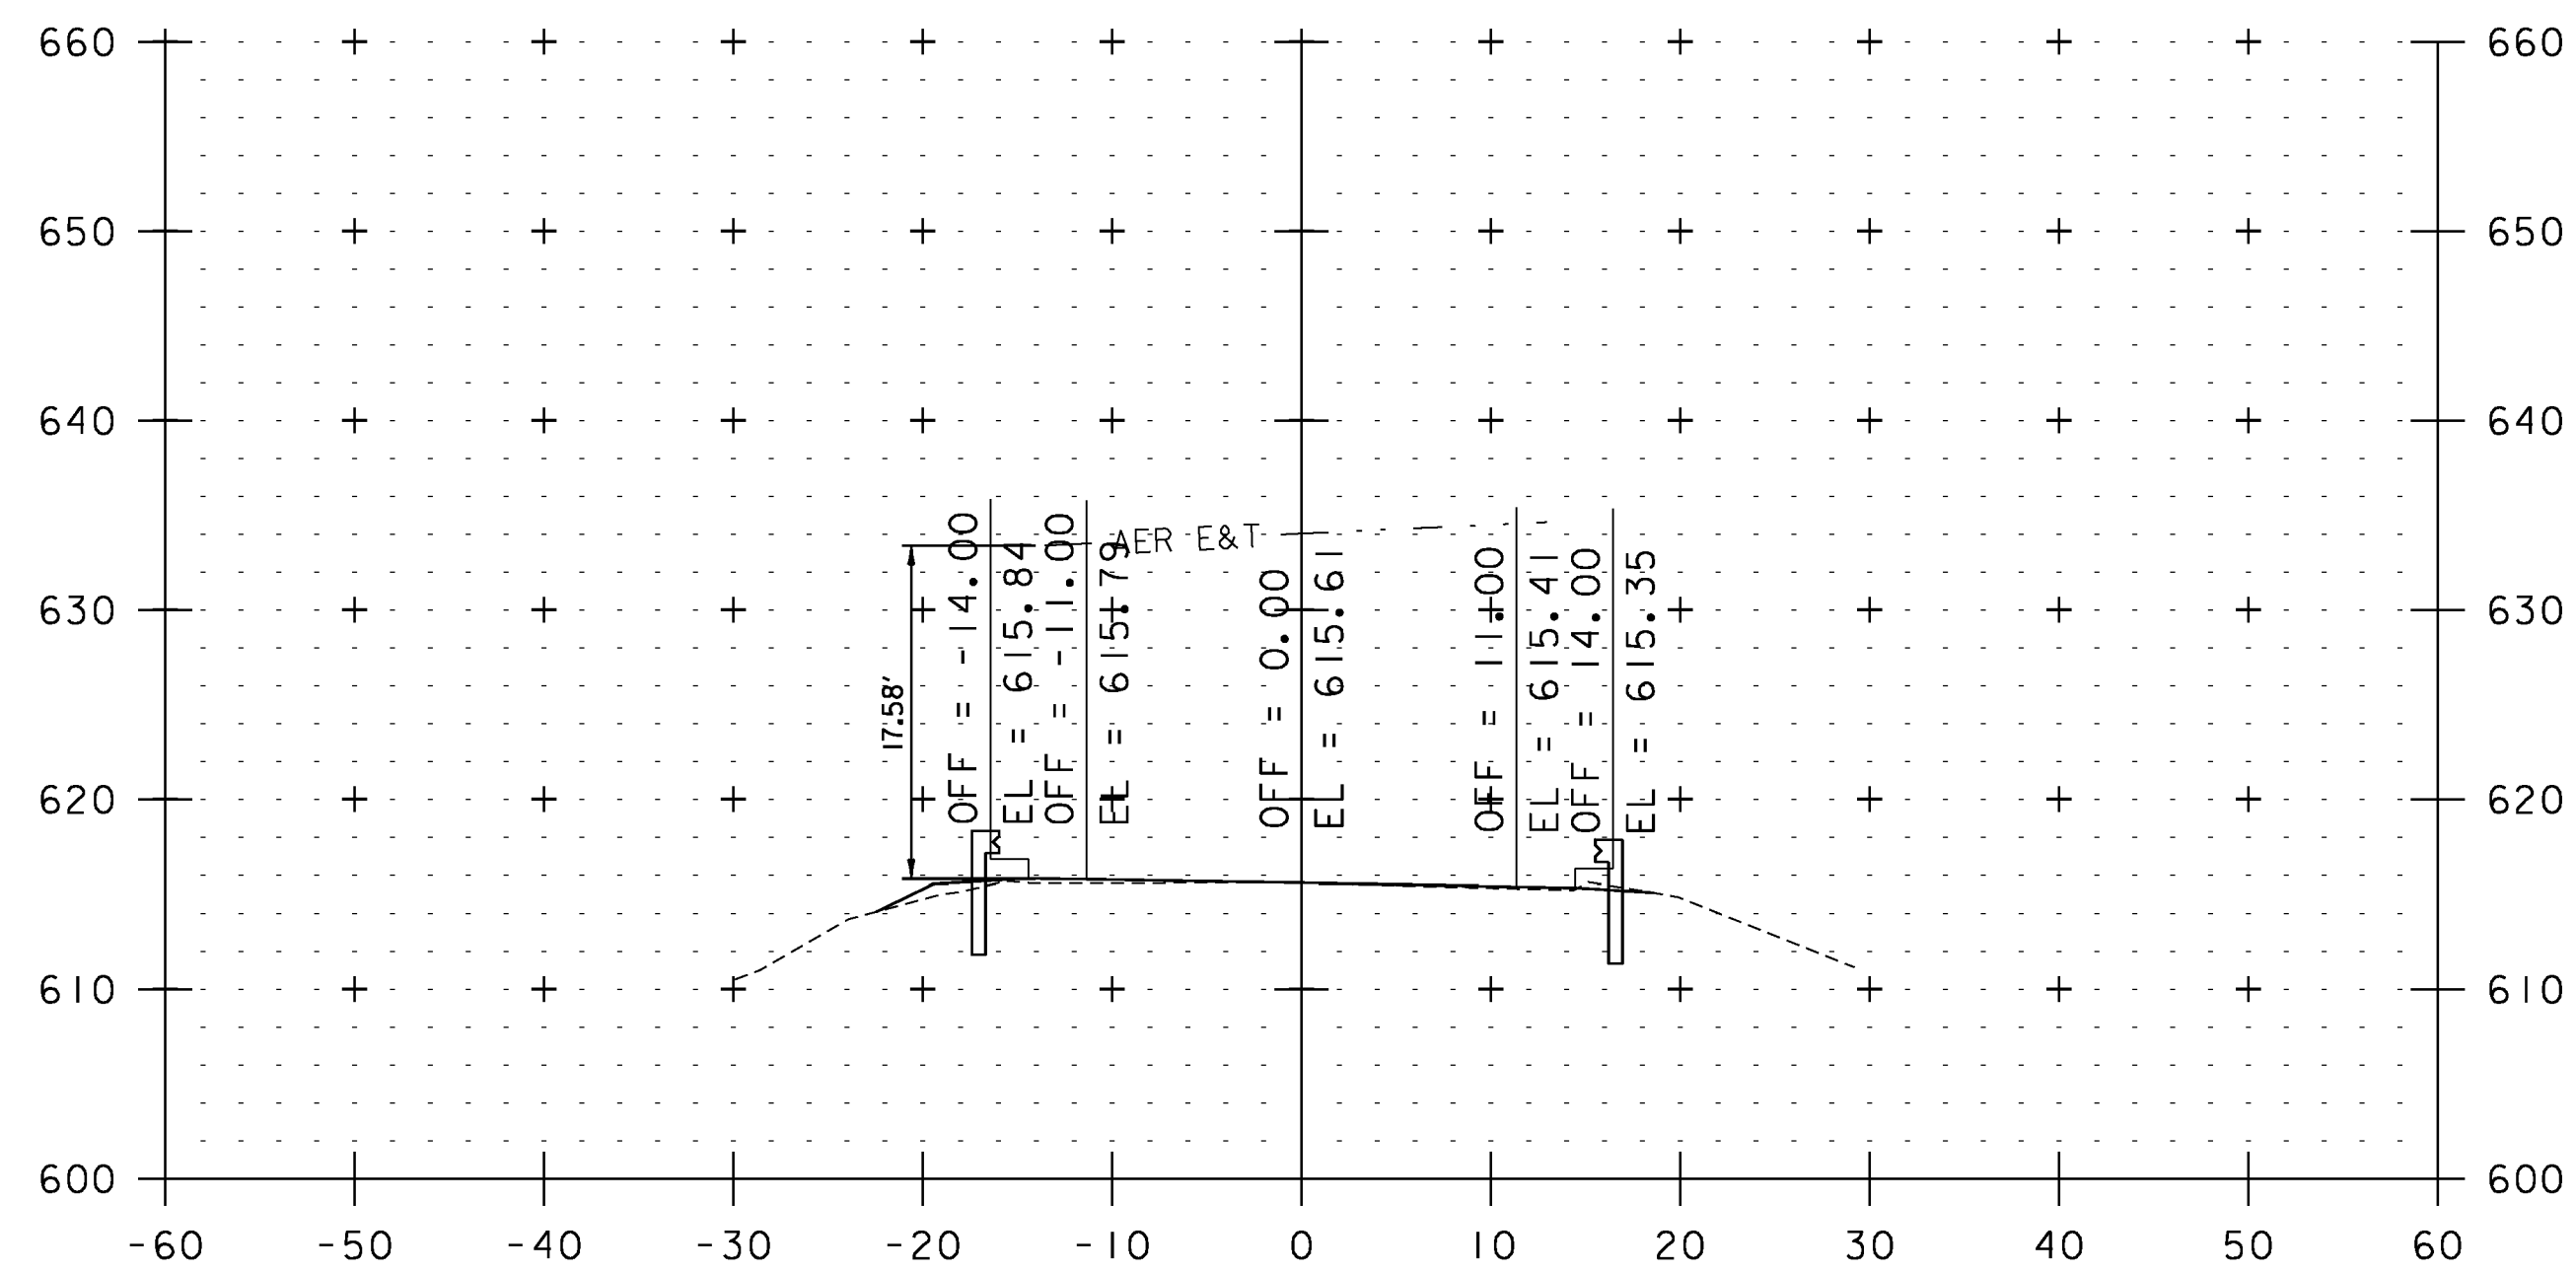

125+87



STA. 121+23 TO STA. 128+92

UTILITY CROSS SECTION SHEET 5

PROJECT NAME: WEATHERSFIELD	PLOT DATE: 2/7/2013
PROJECT NUMBER: STP 2913(I)	DRAWN BY: JLS
FILE NAME: I0c228	CHECKED BY: PTS
PROJECT LEADER: PTS	SHEET 187 OF 234
DESIGNED BY: NLL	
IPARM FILE NAME: pI0c228.l87	