




166+01

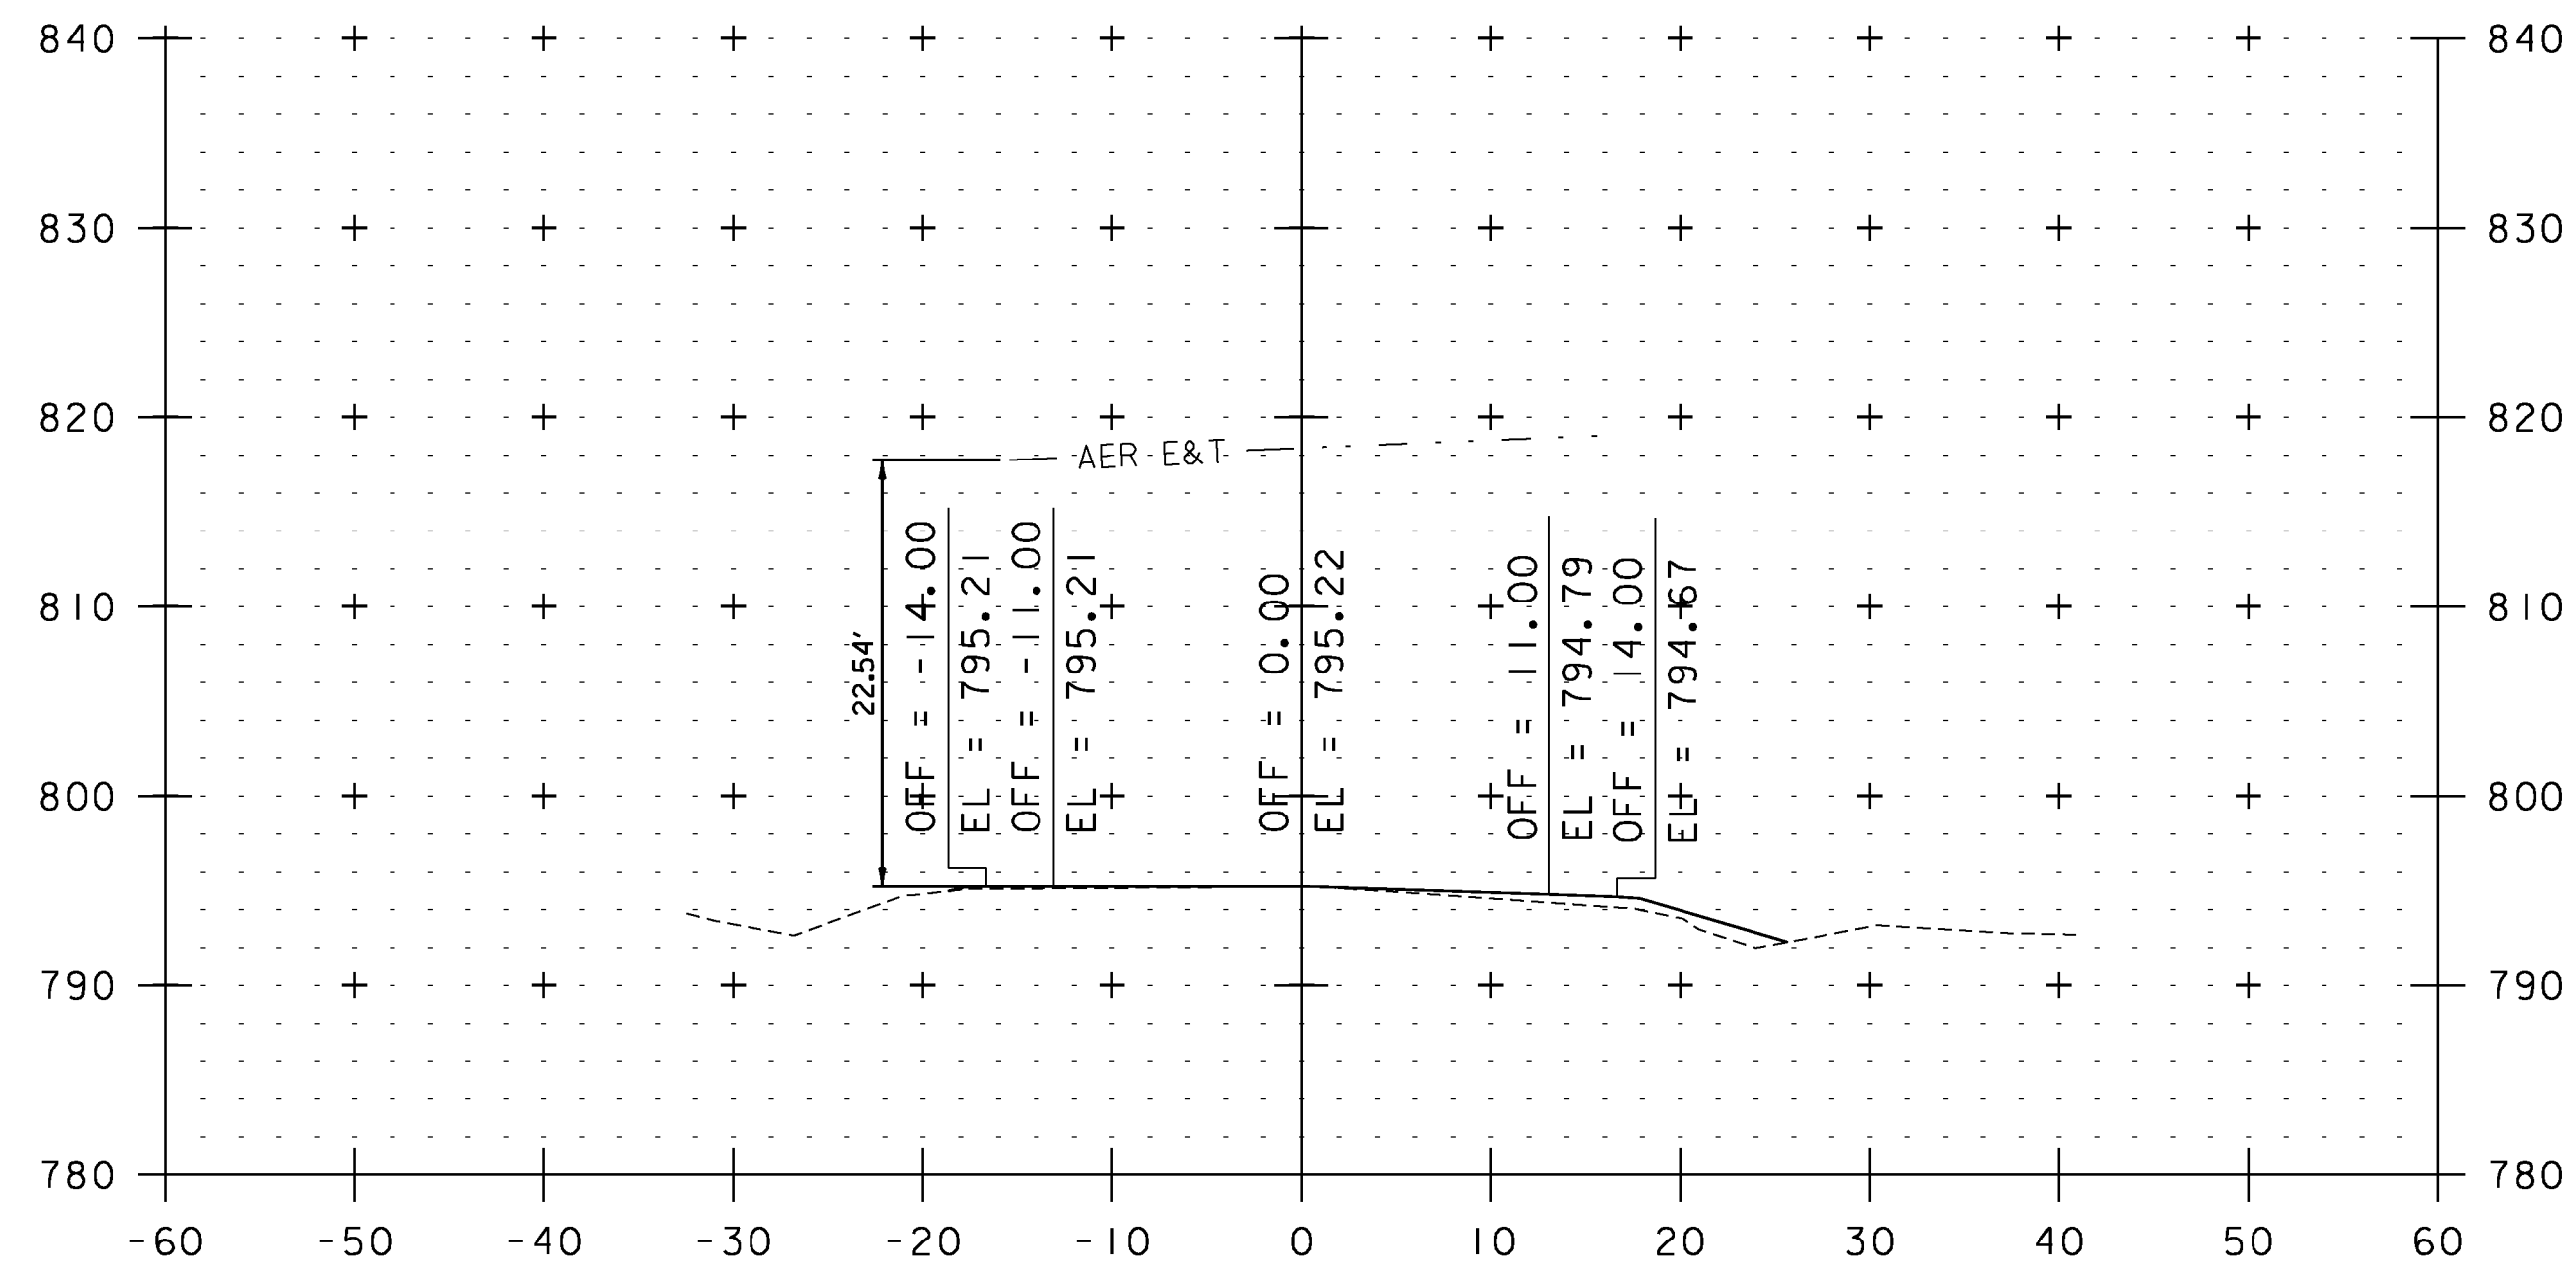

170+33

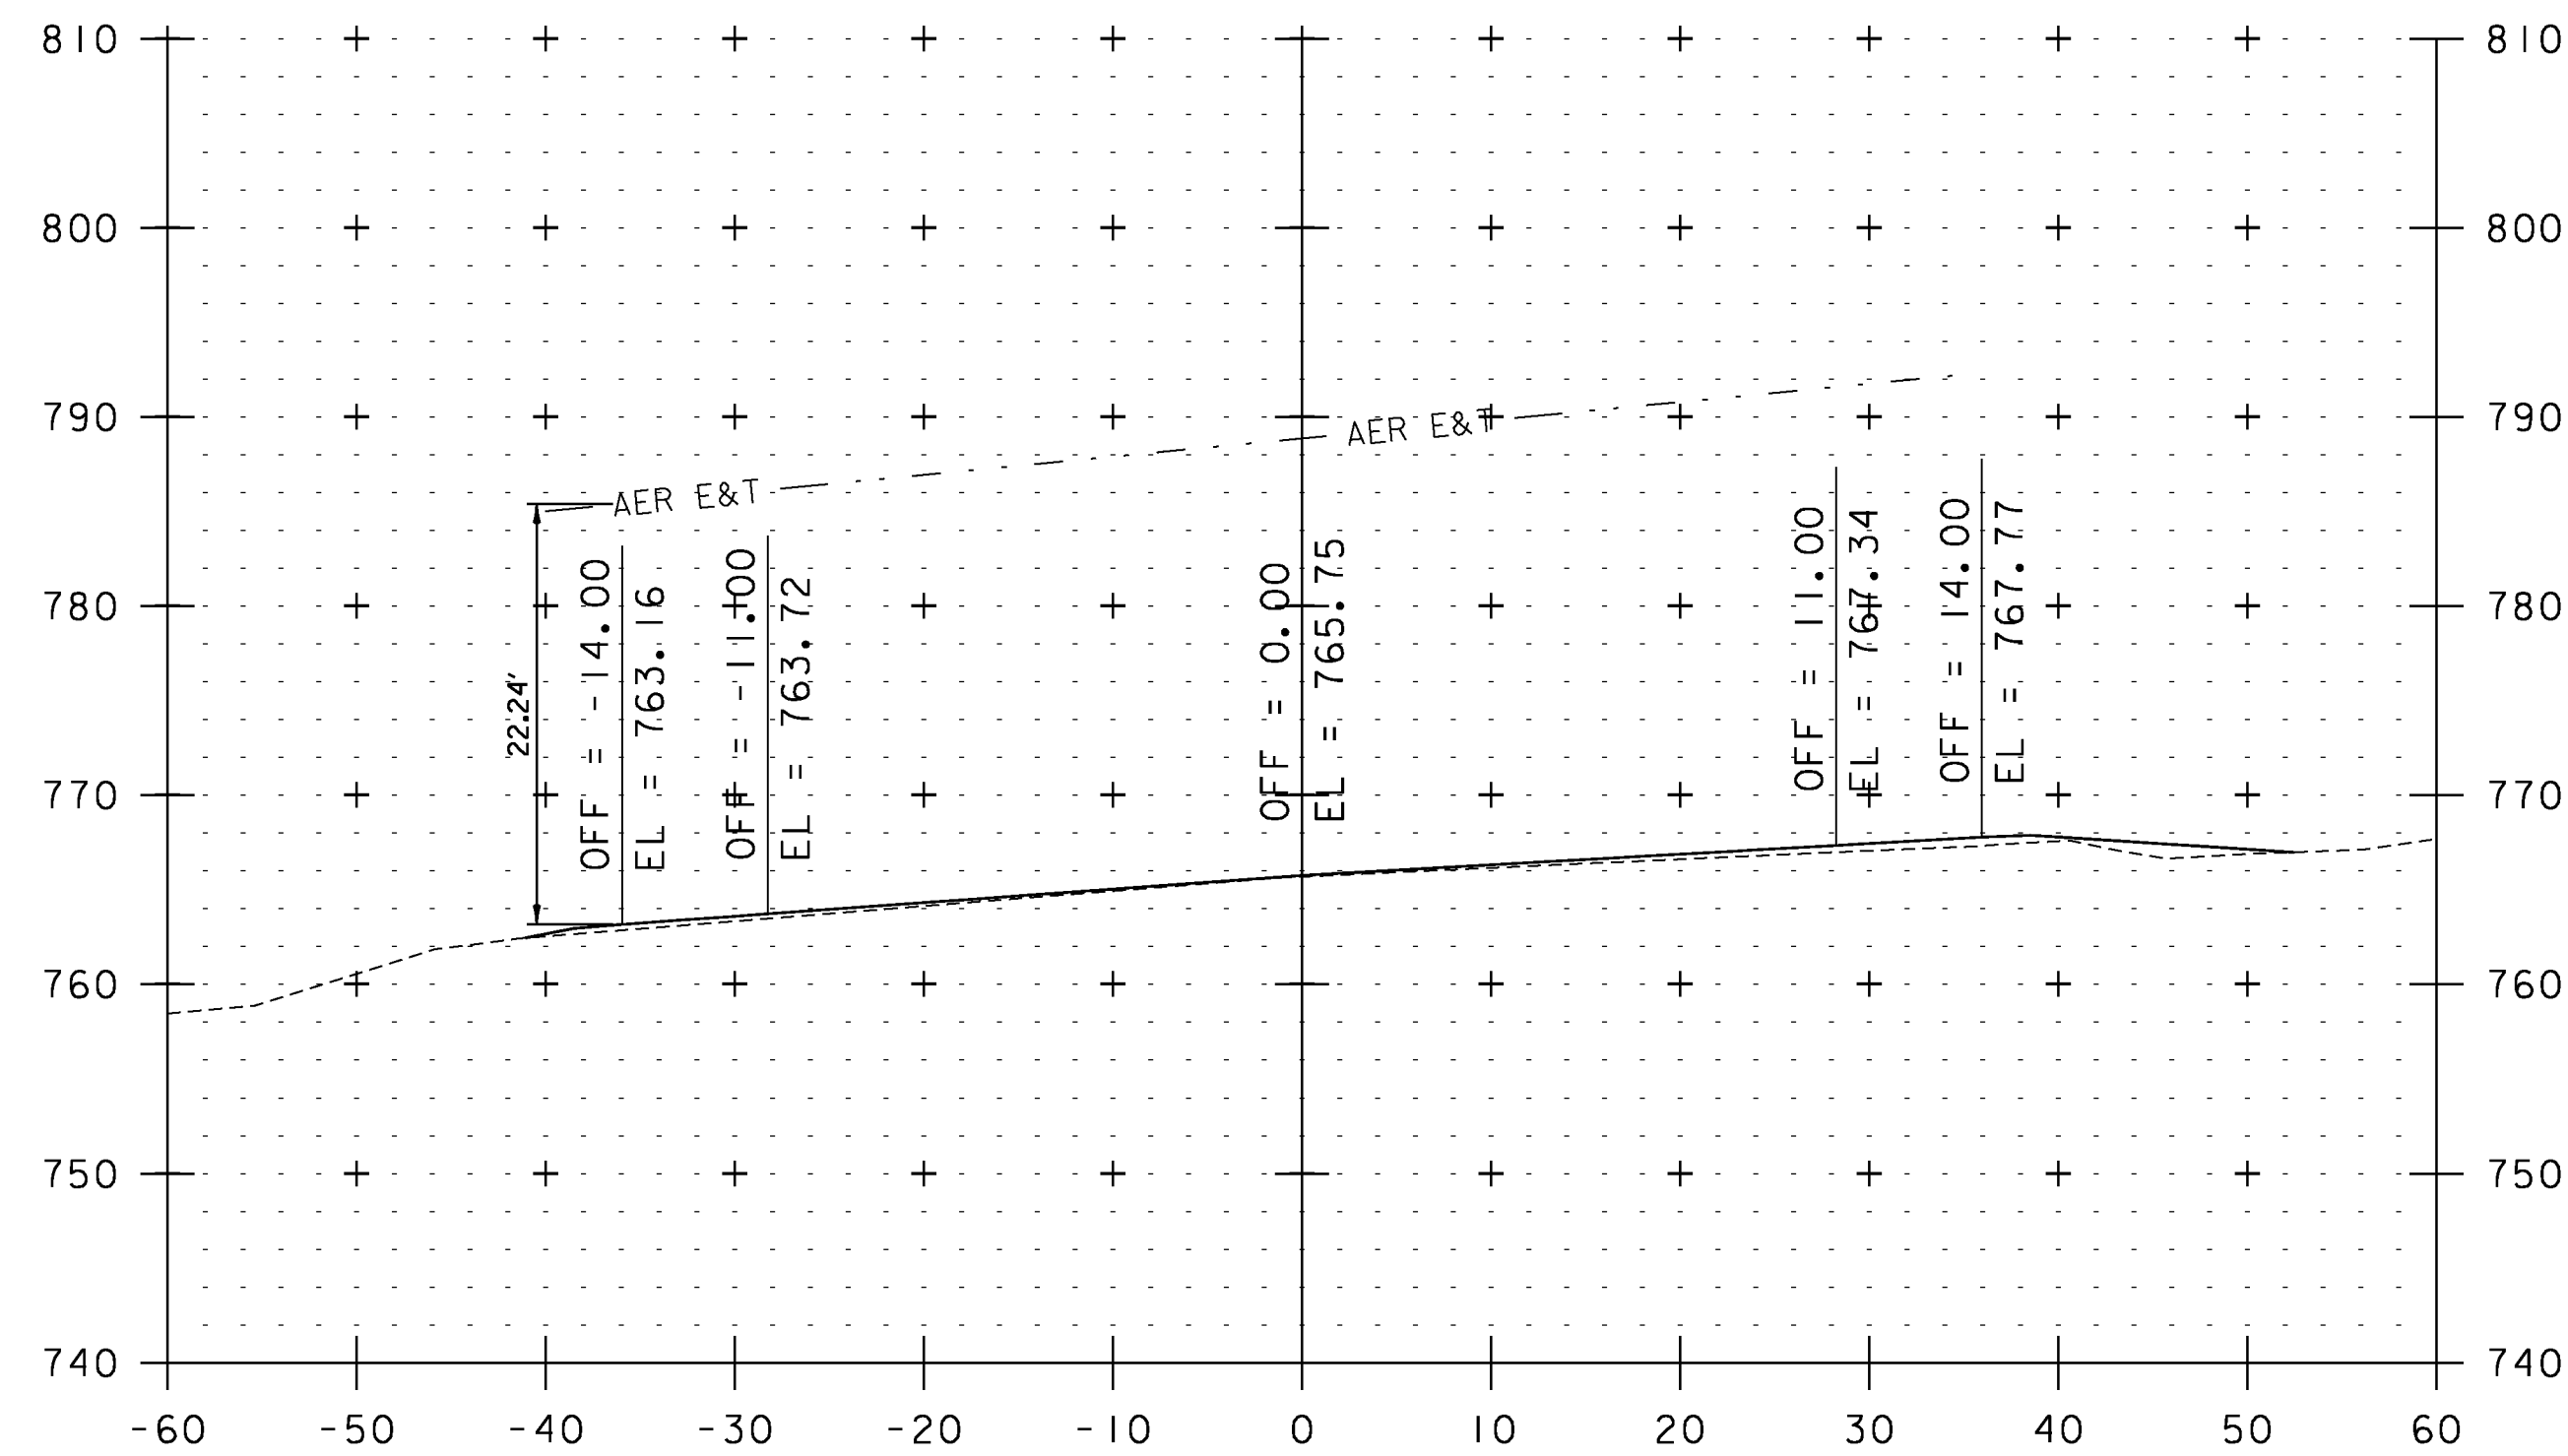


164+73

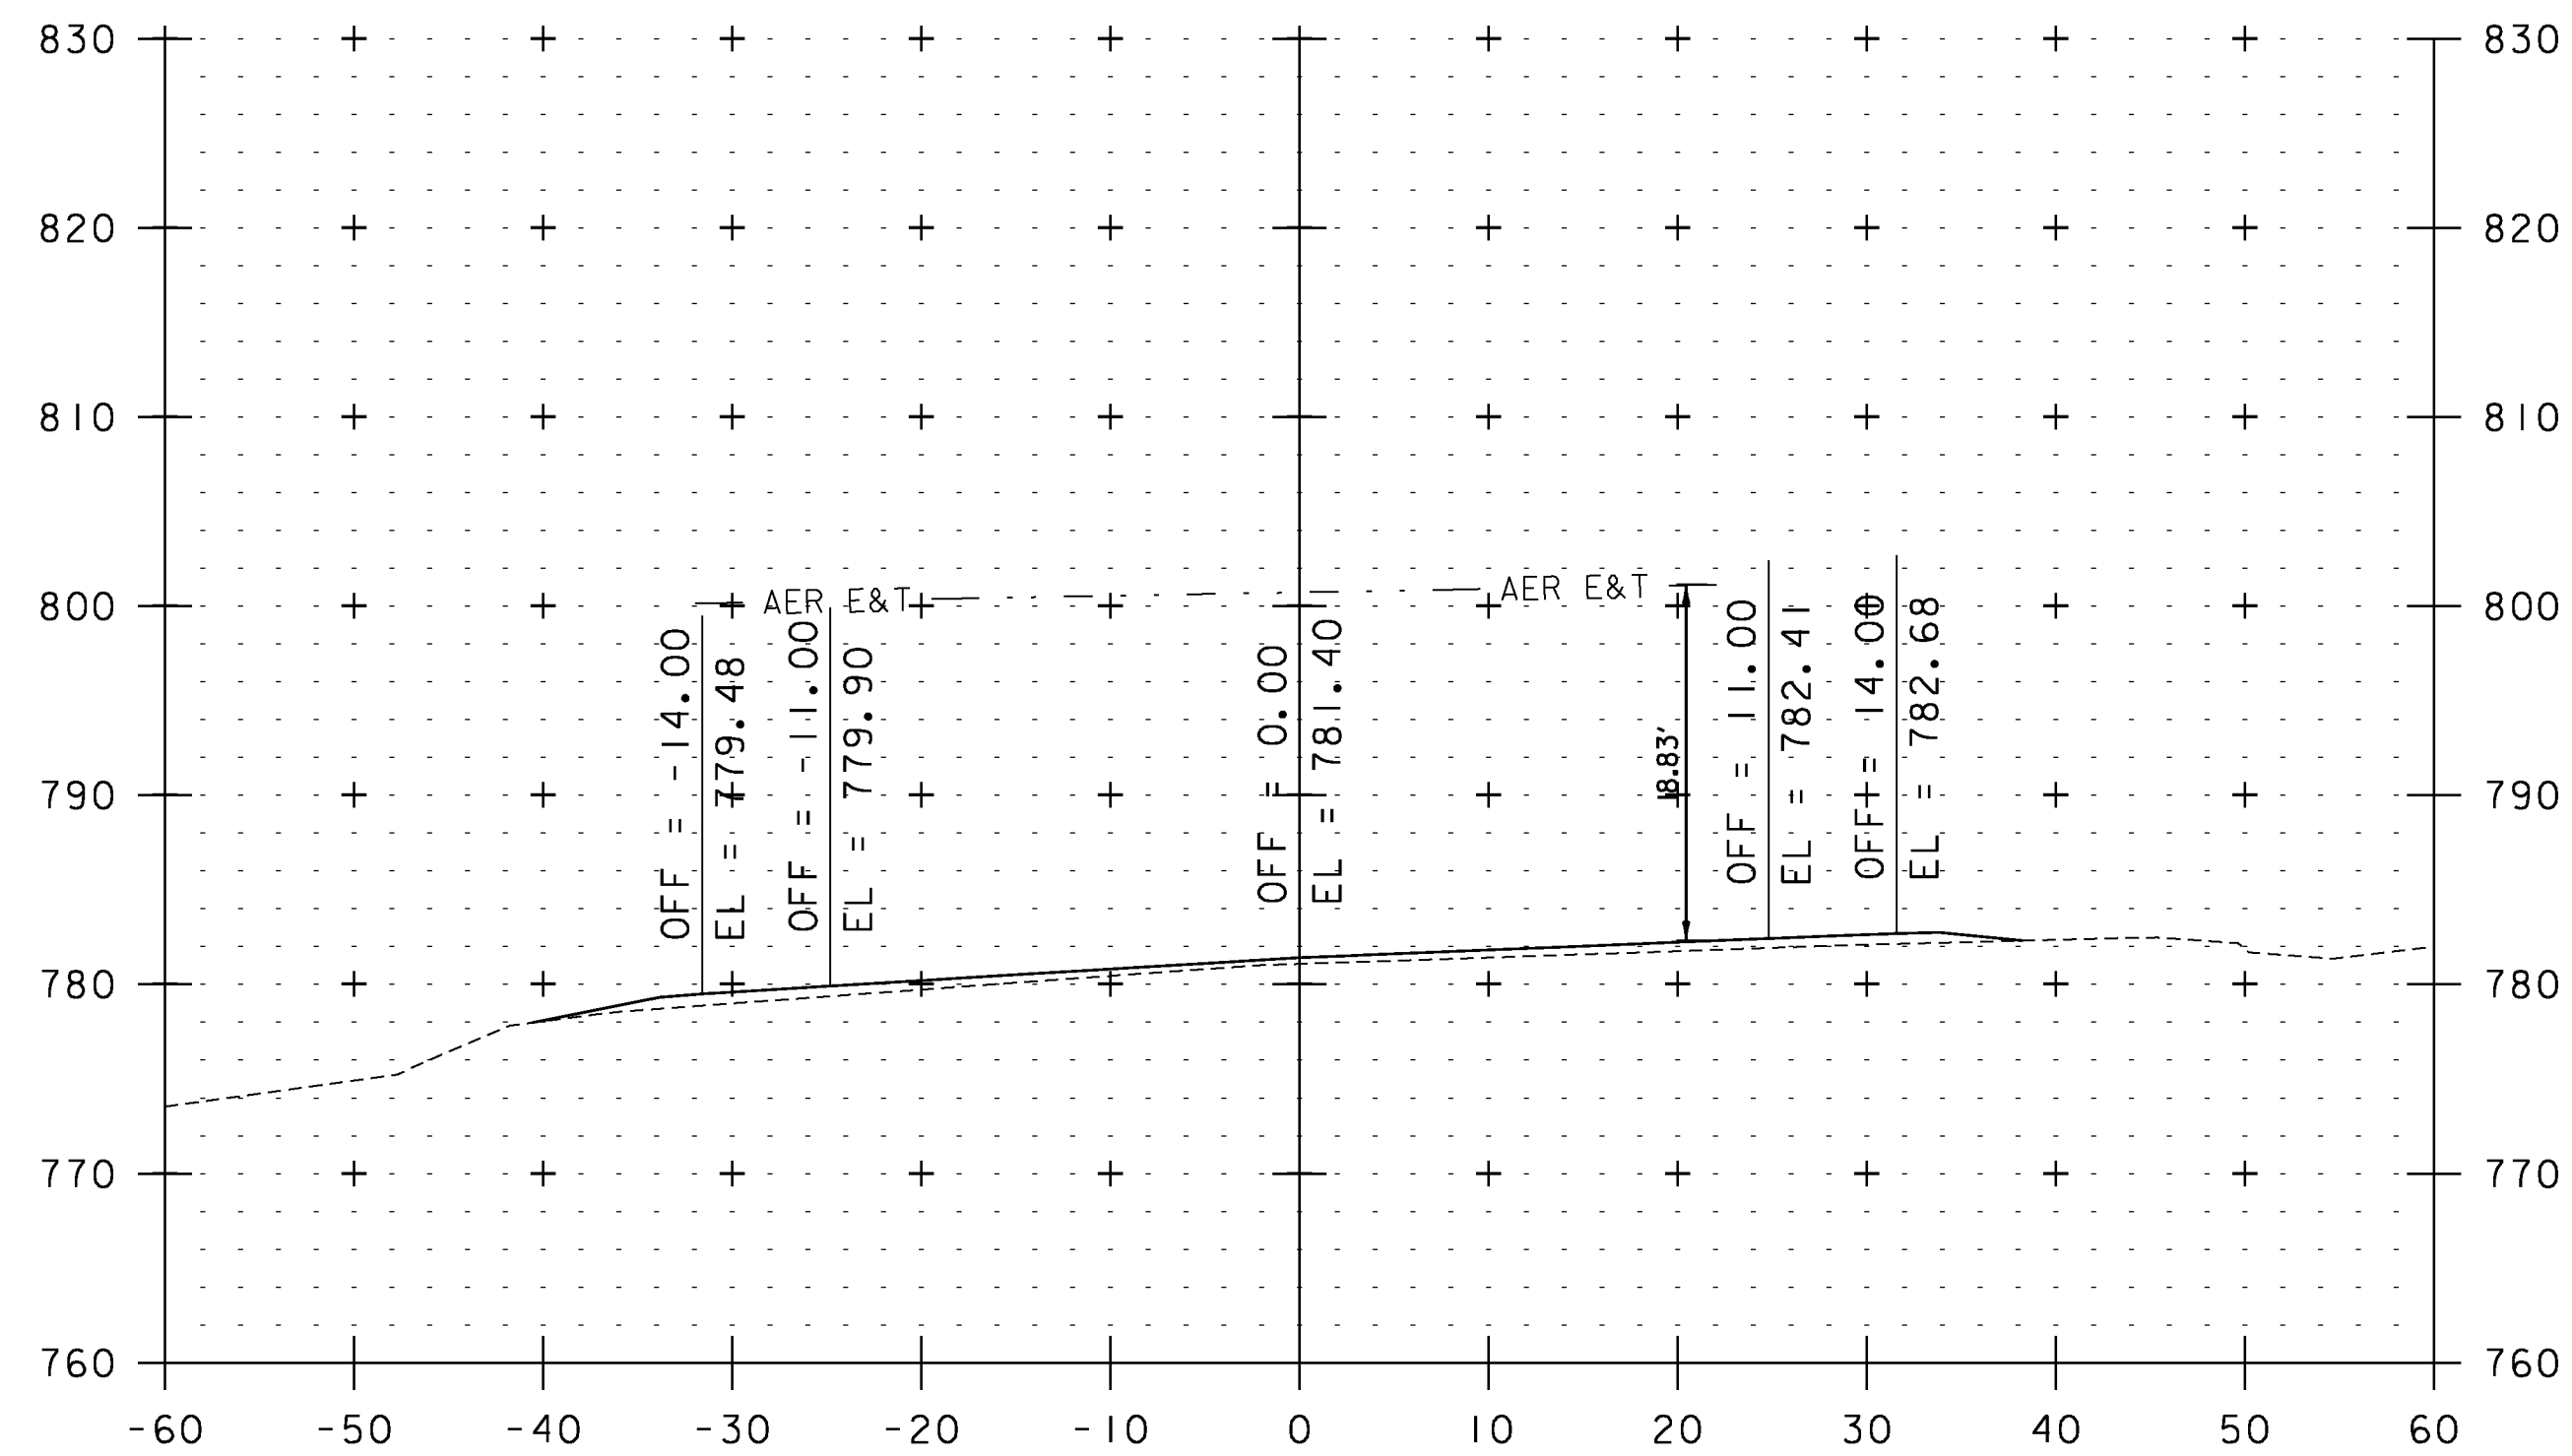

167+13

**UTILITY CROSS SECTION SHEET 7**

PROJECT NAME: WEATHERSFIELD	PLOT DATE: 2/7/2013
PROJECT NUMBER: STP 2913(I)	DRAWN BY: JLS
FILE NAME: I0c228	CHECKED BY: PTS
PROJECT LEADER: PTS	SHEET 189 OF 234
DESIGNED BY: NULL	
IPARM FILE NAME: pI0c228.l89	

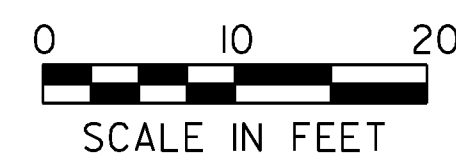

STA. 164+73 TO STA. 170+33