




230+81

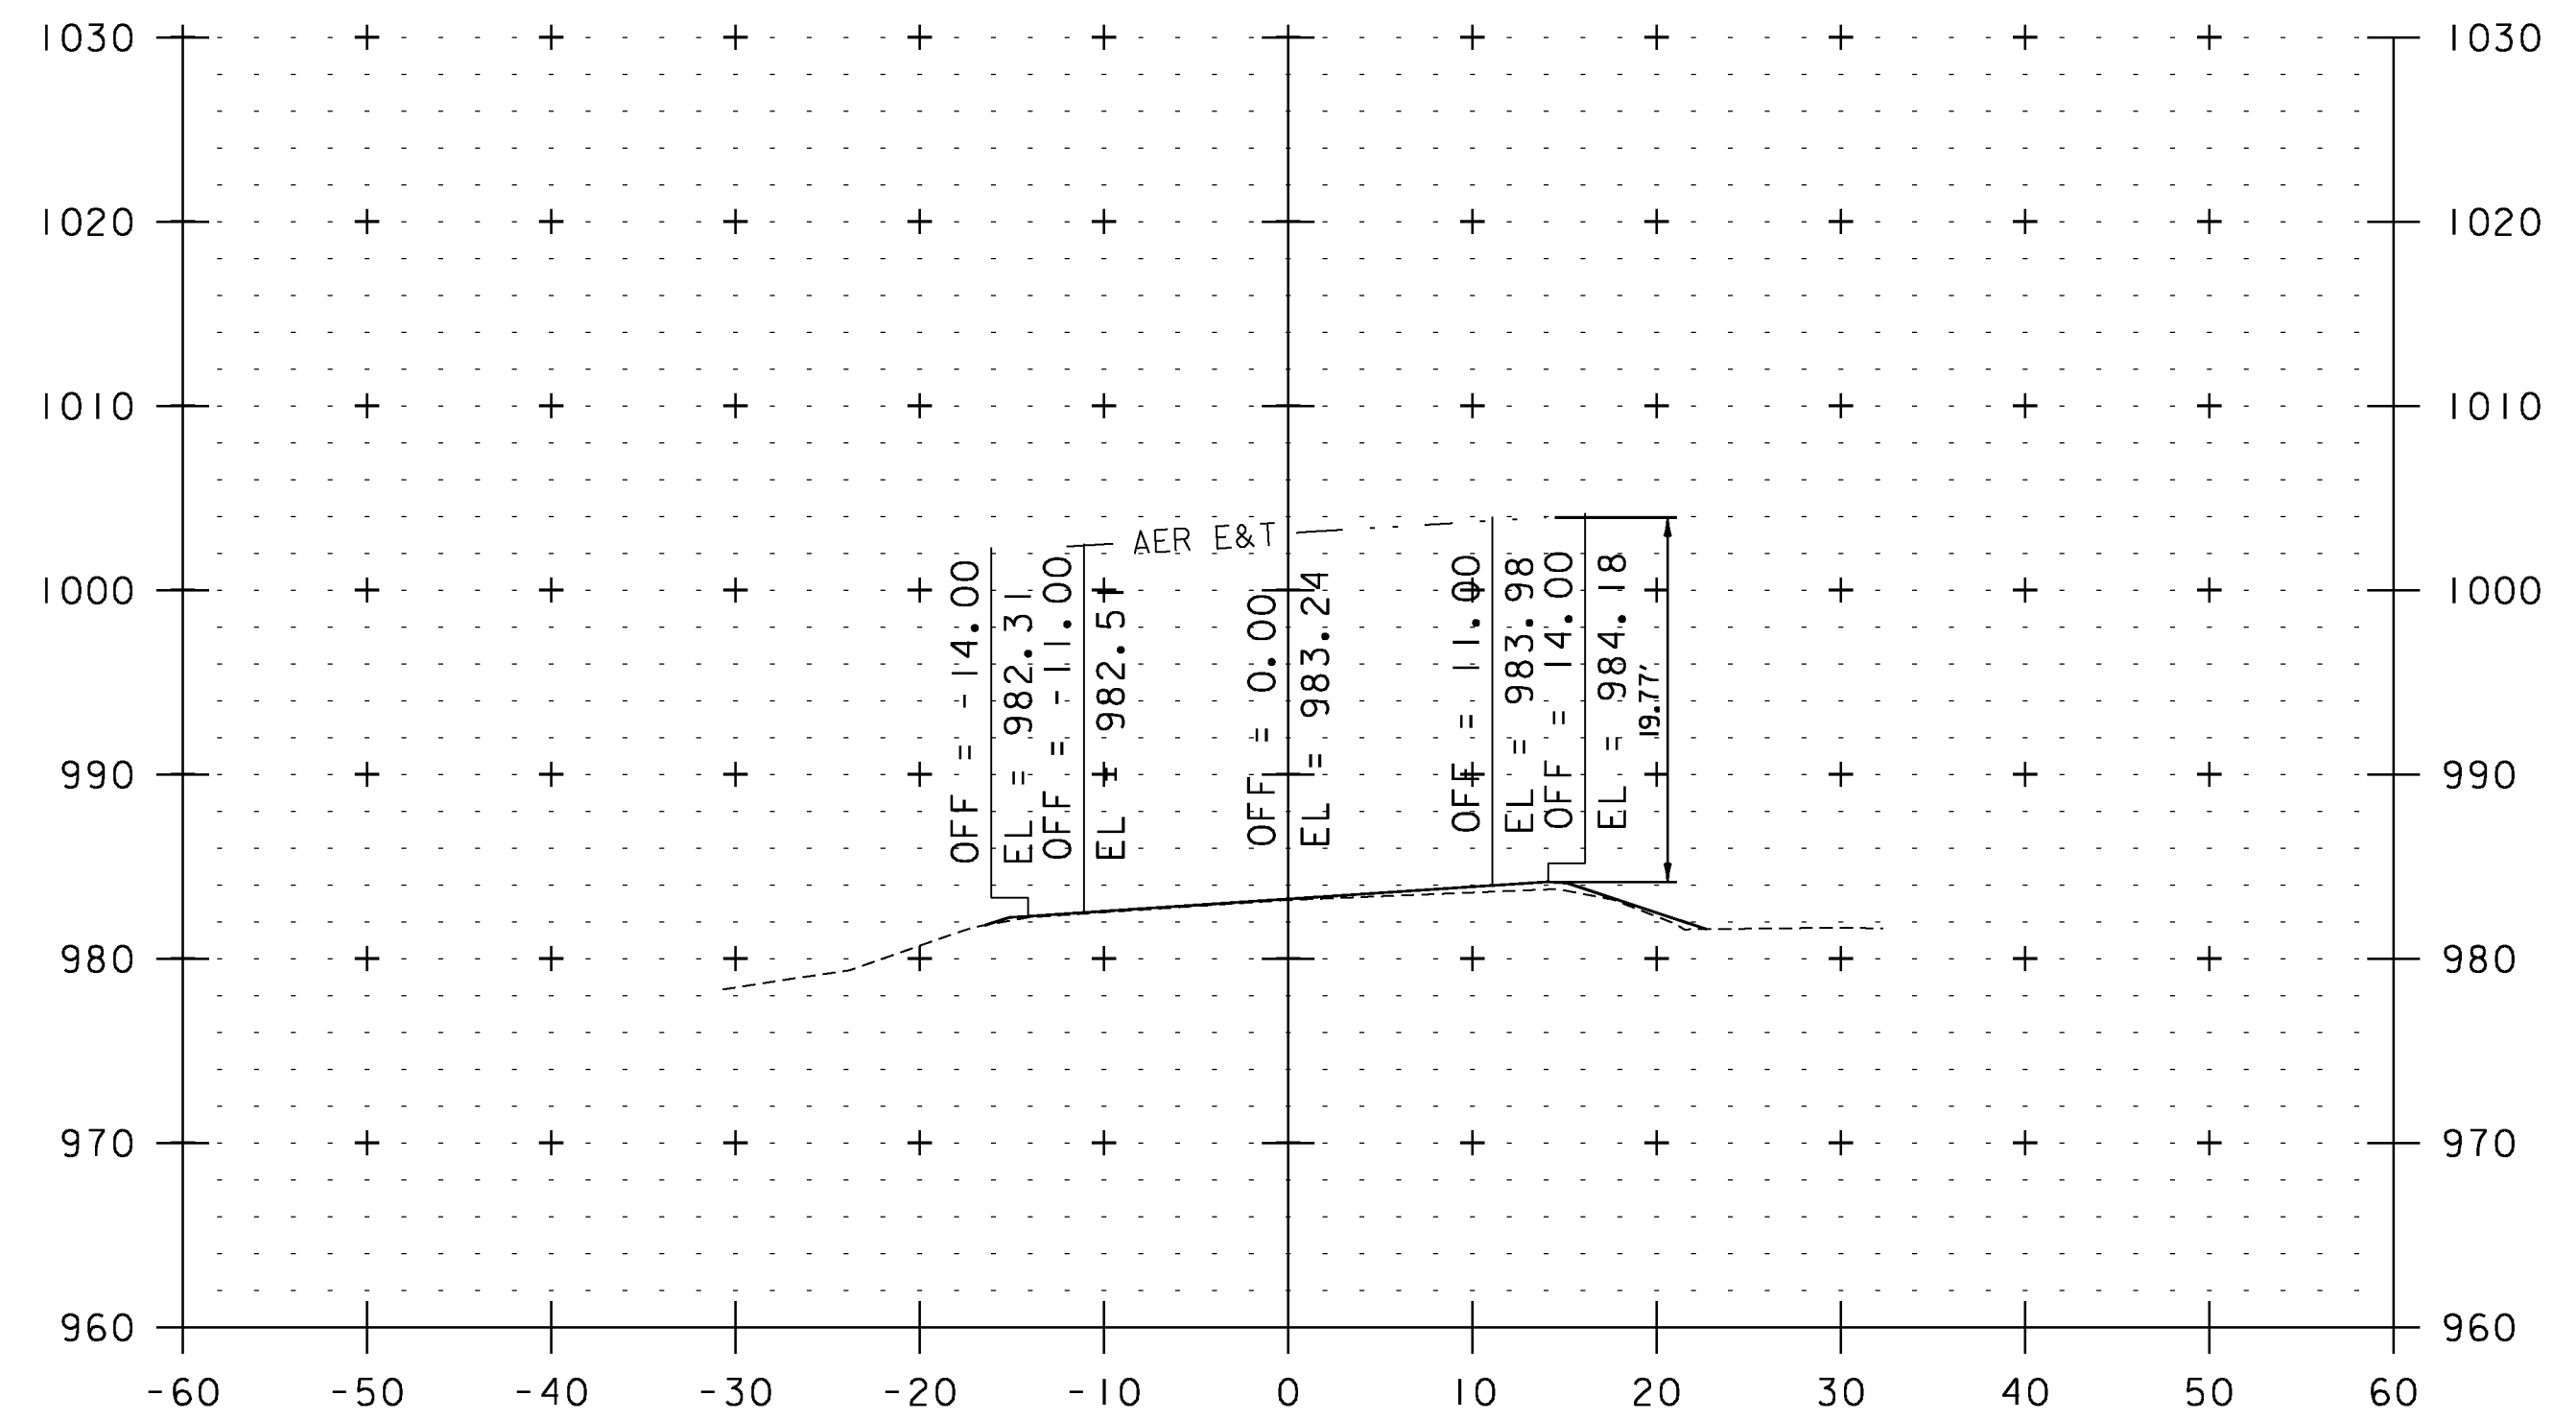

244+73

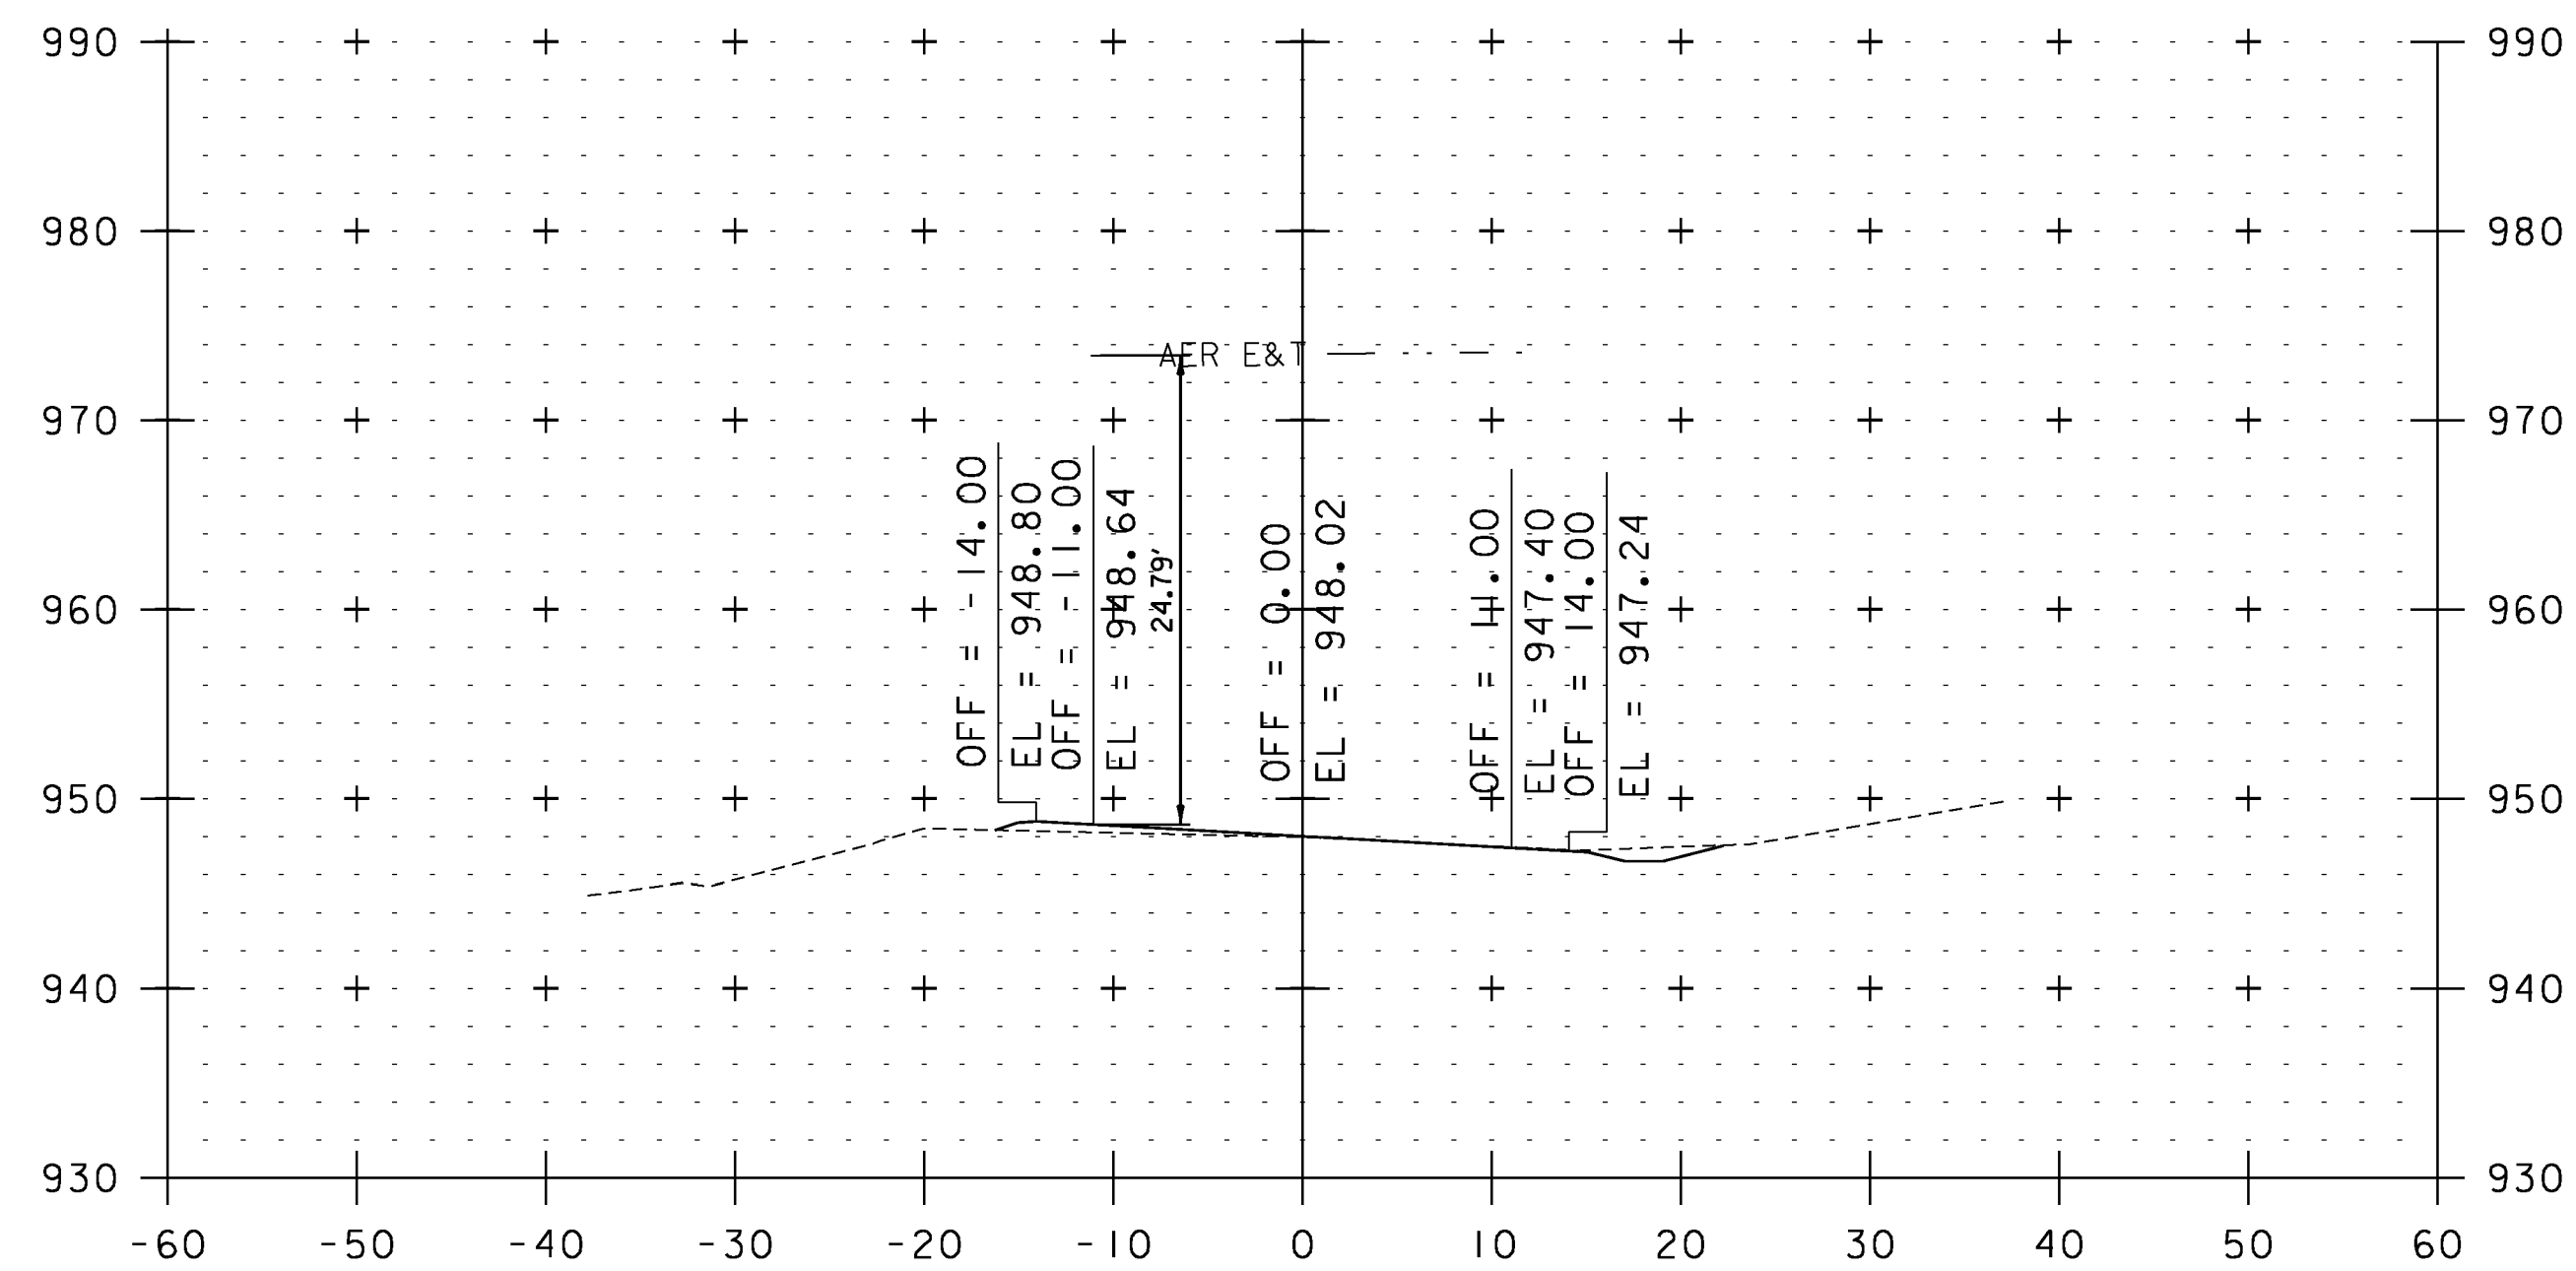

225+69

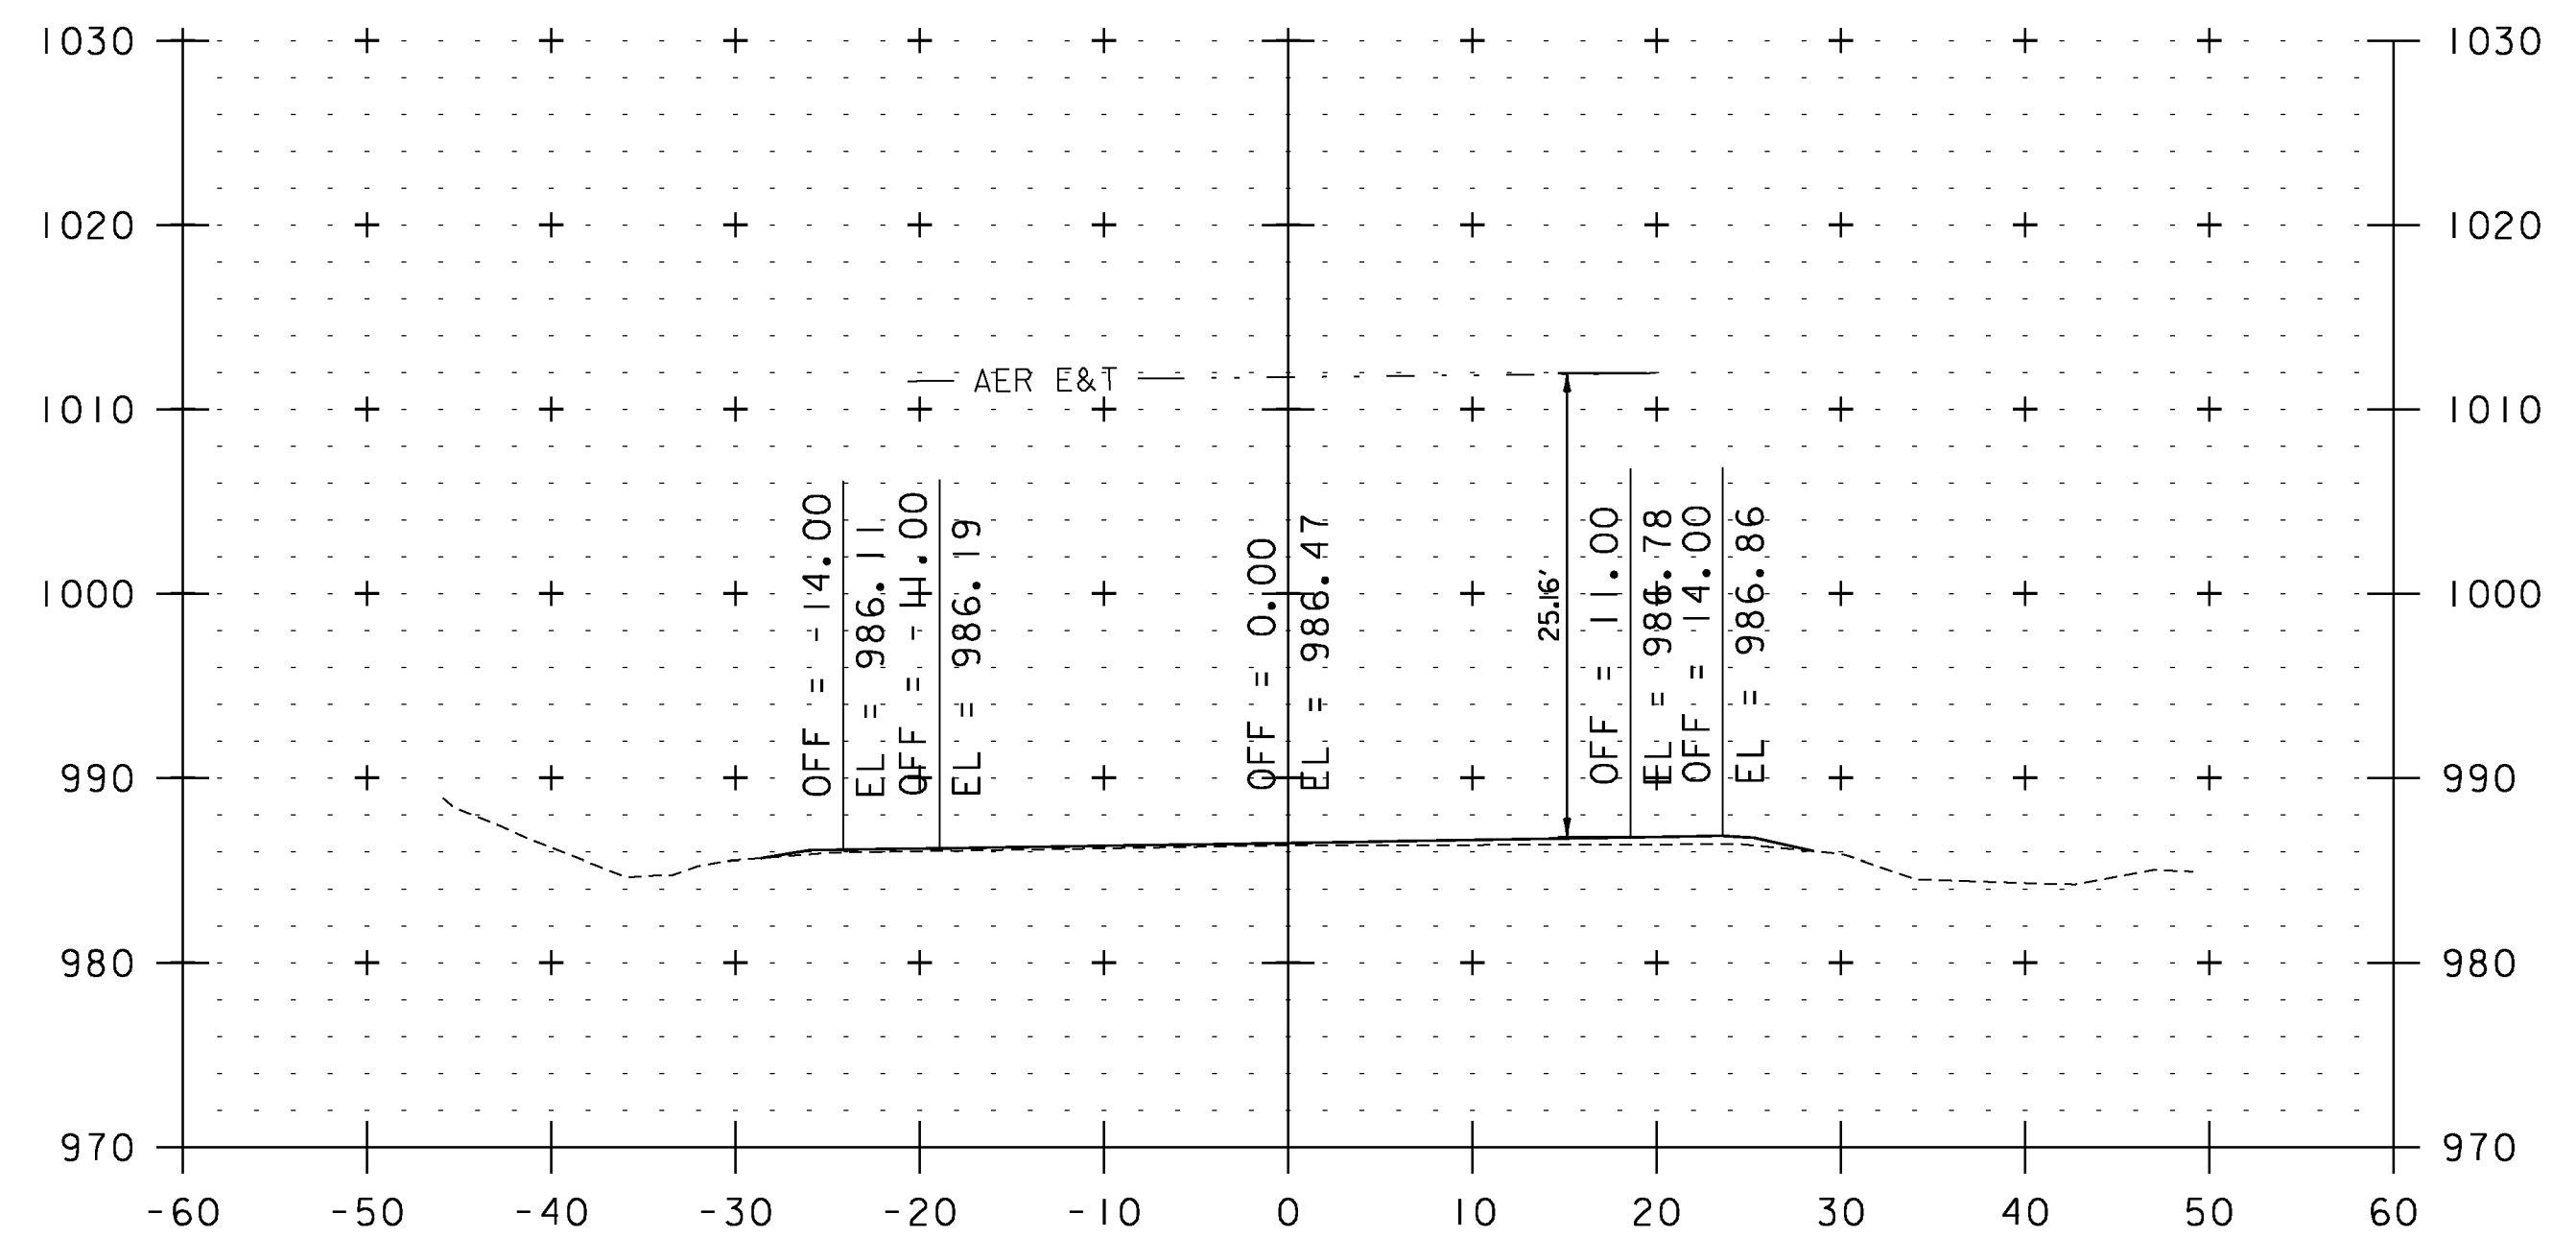

243+72

**UTILITY CROSS SECTION SHEET 11**

PROJECT NAME: WEATHERSFIELD

PROJECT NUMBER: STP 2913(I)

FILE NAME: I0c228

PROJECT LEADER: PTS

DESIGNED BY: NLL

IPARM FILE NAME: pI0c228.I93

PLOT DATE: 2/7/2013

DRAWN BY: JLS

CHECKED BY: PTS

SHEET 193 OF 234



STA. 225+69 TO STA. 244+73