




315+73

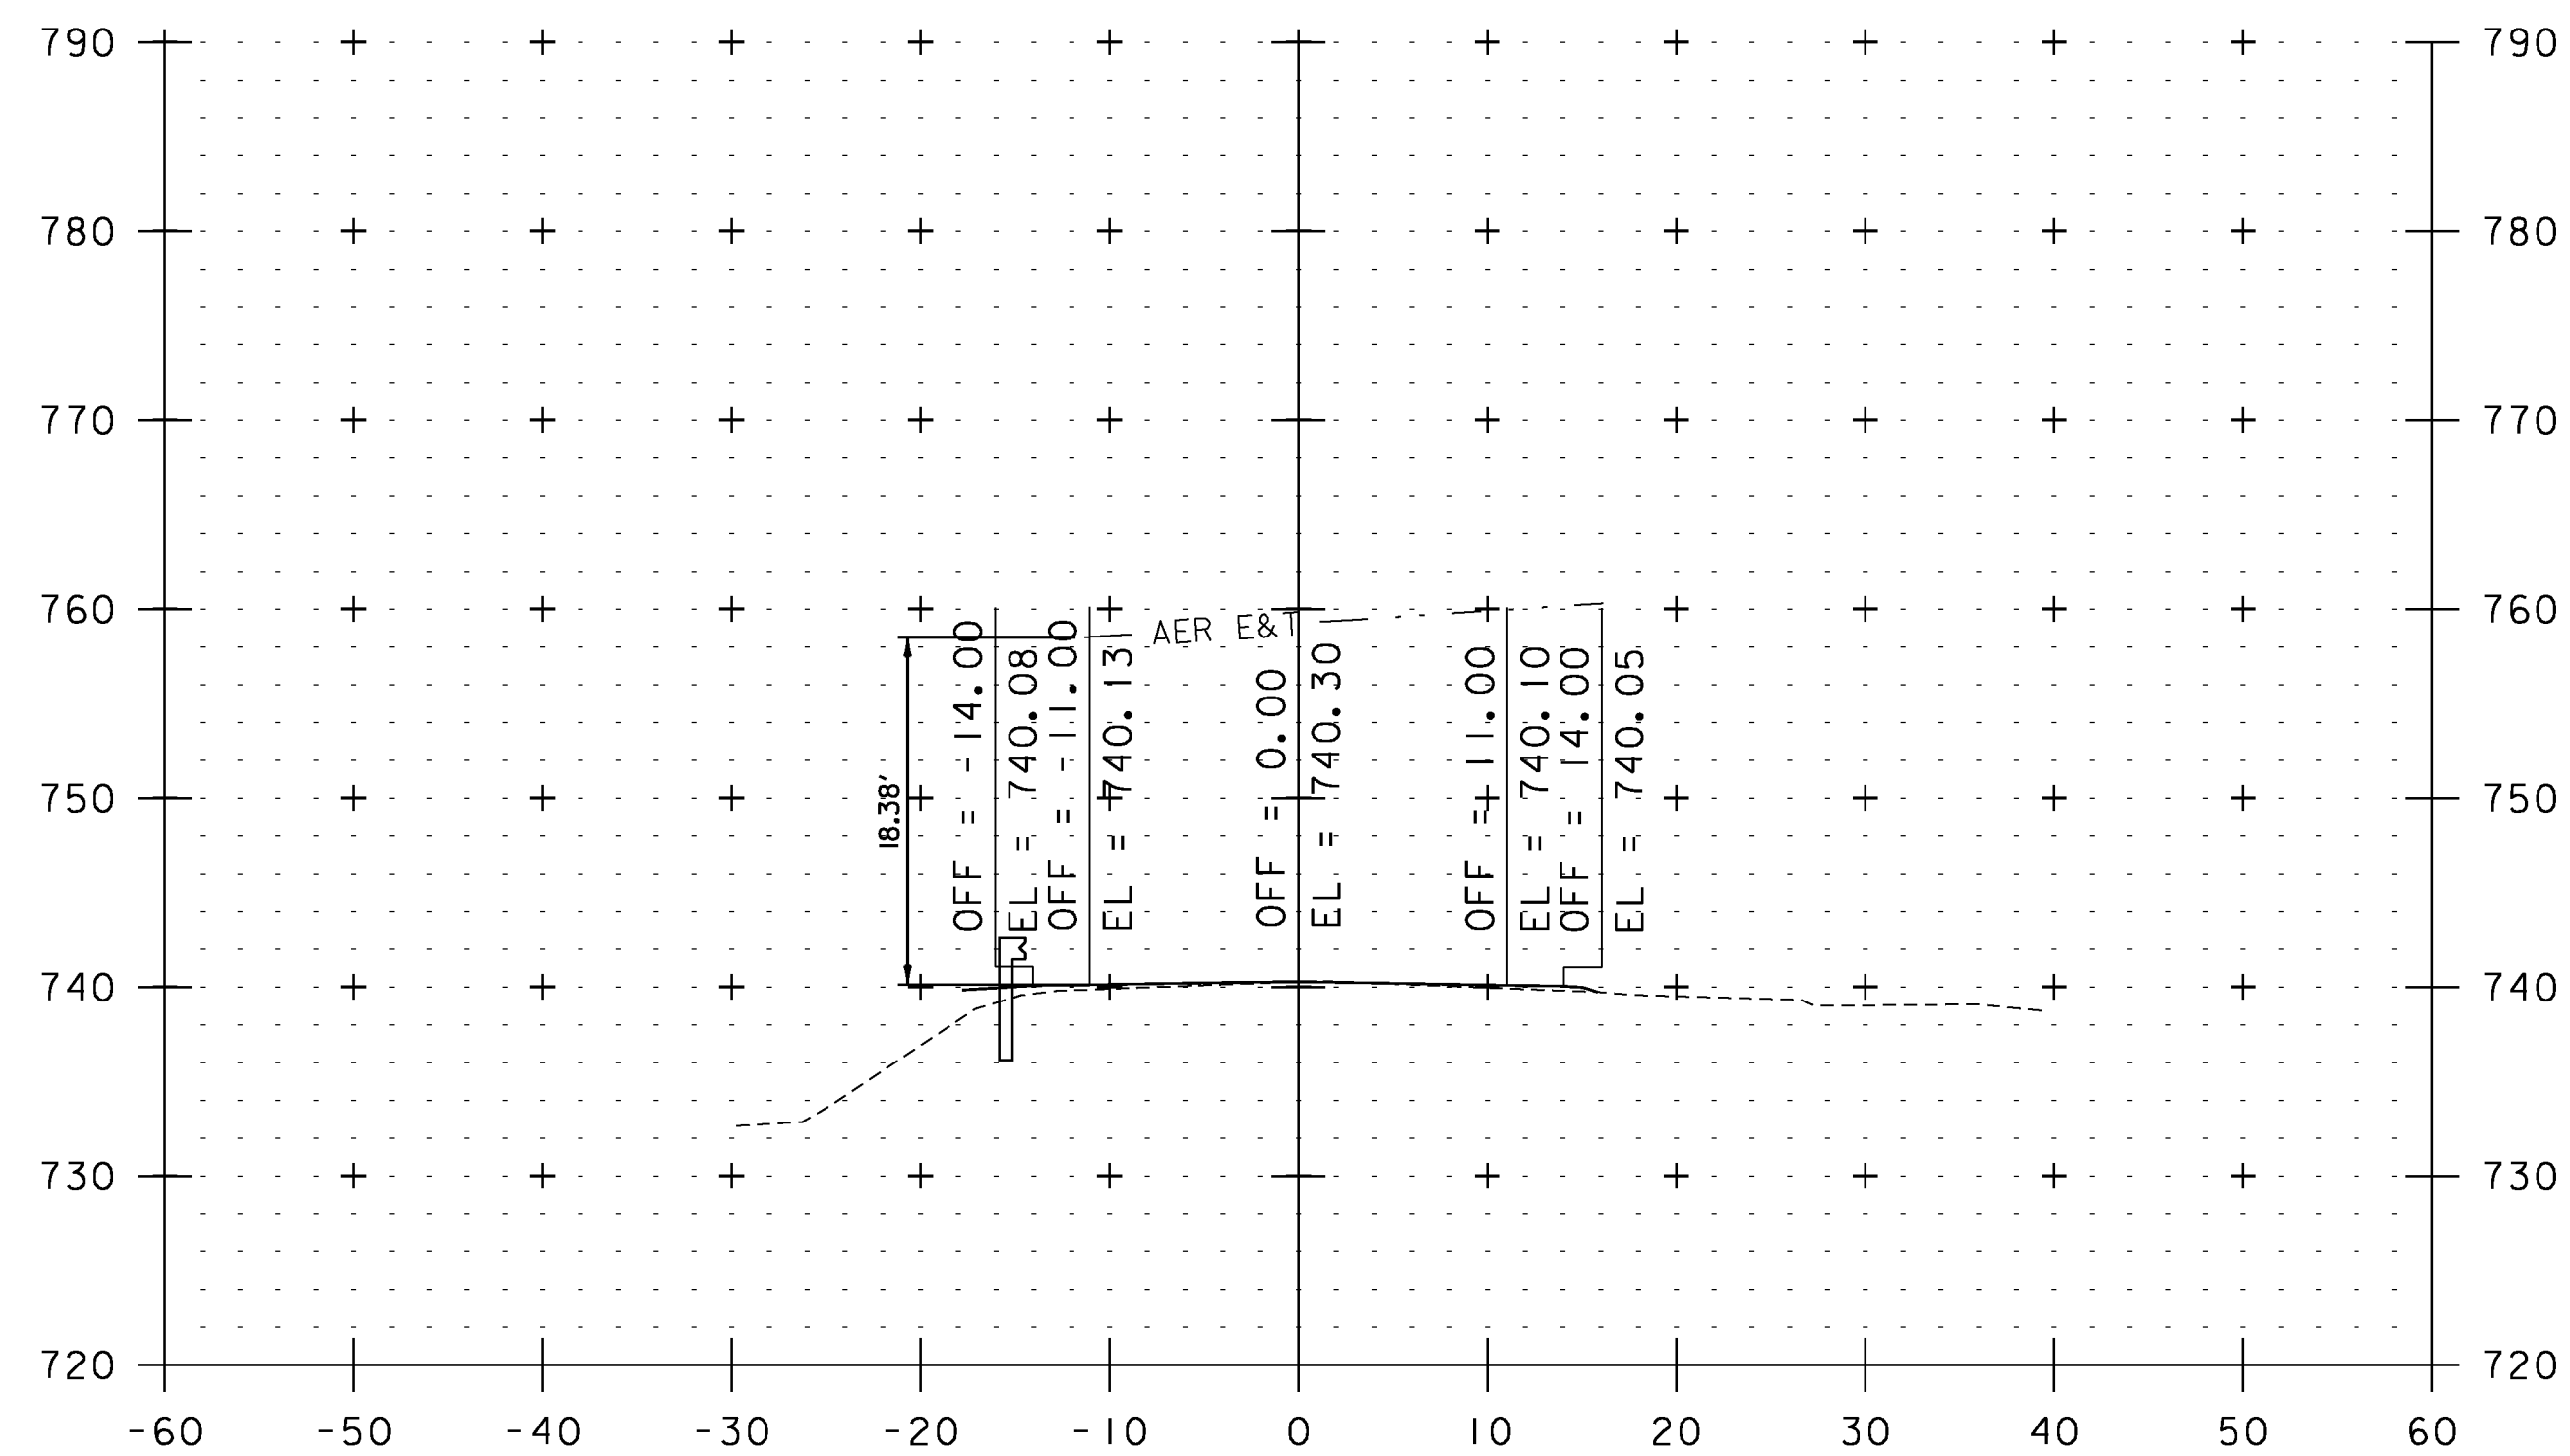


327+13

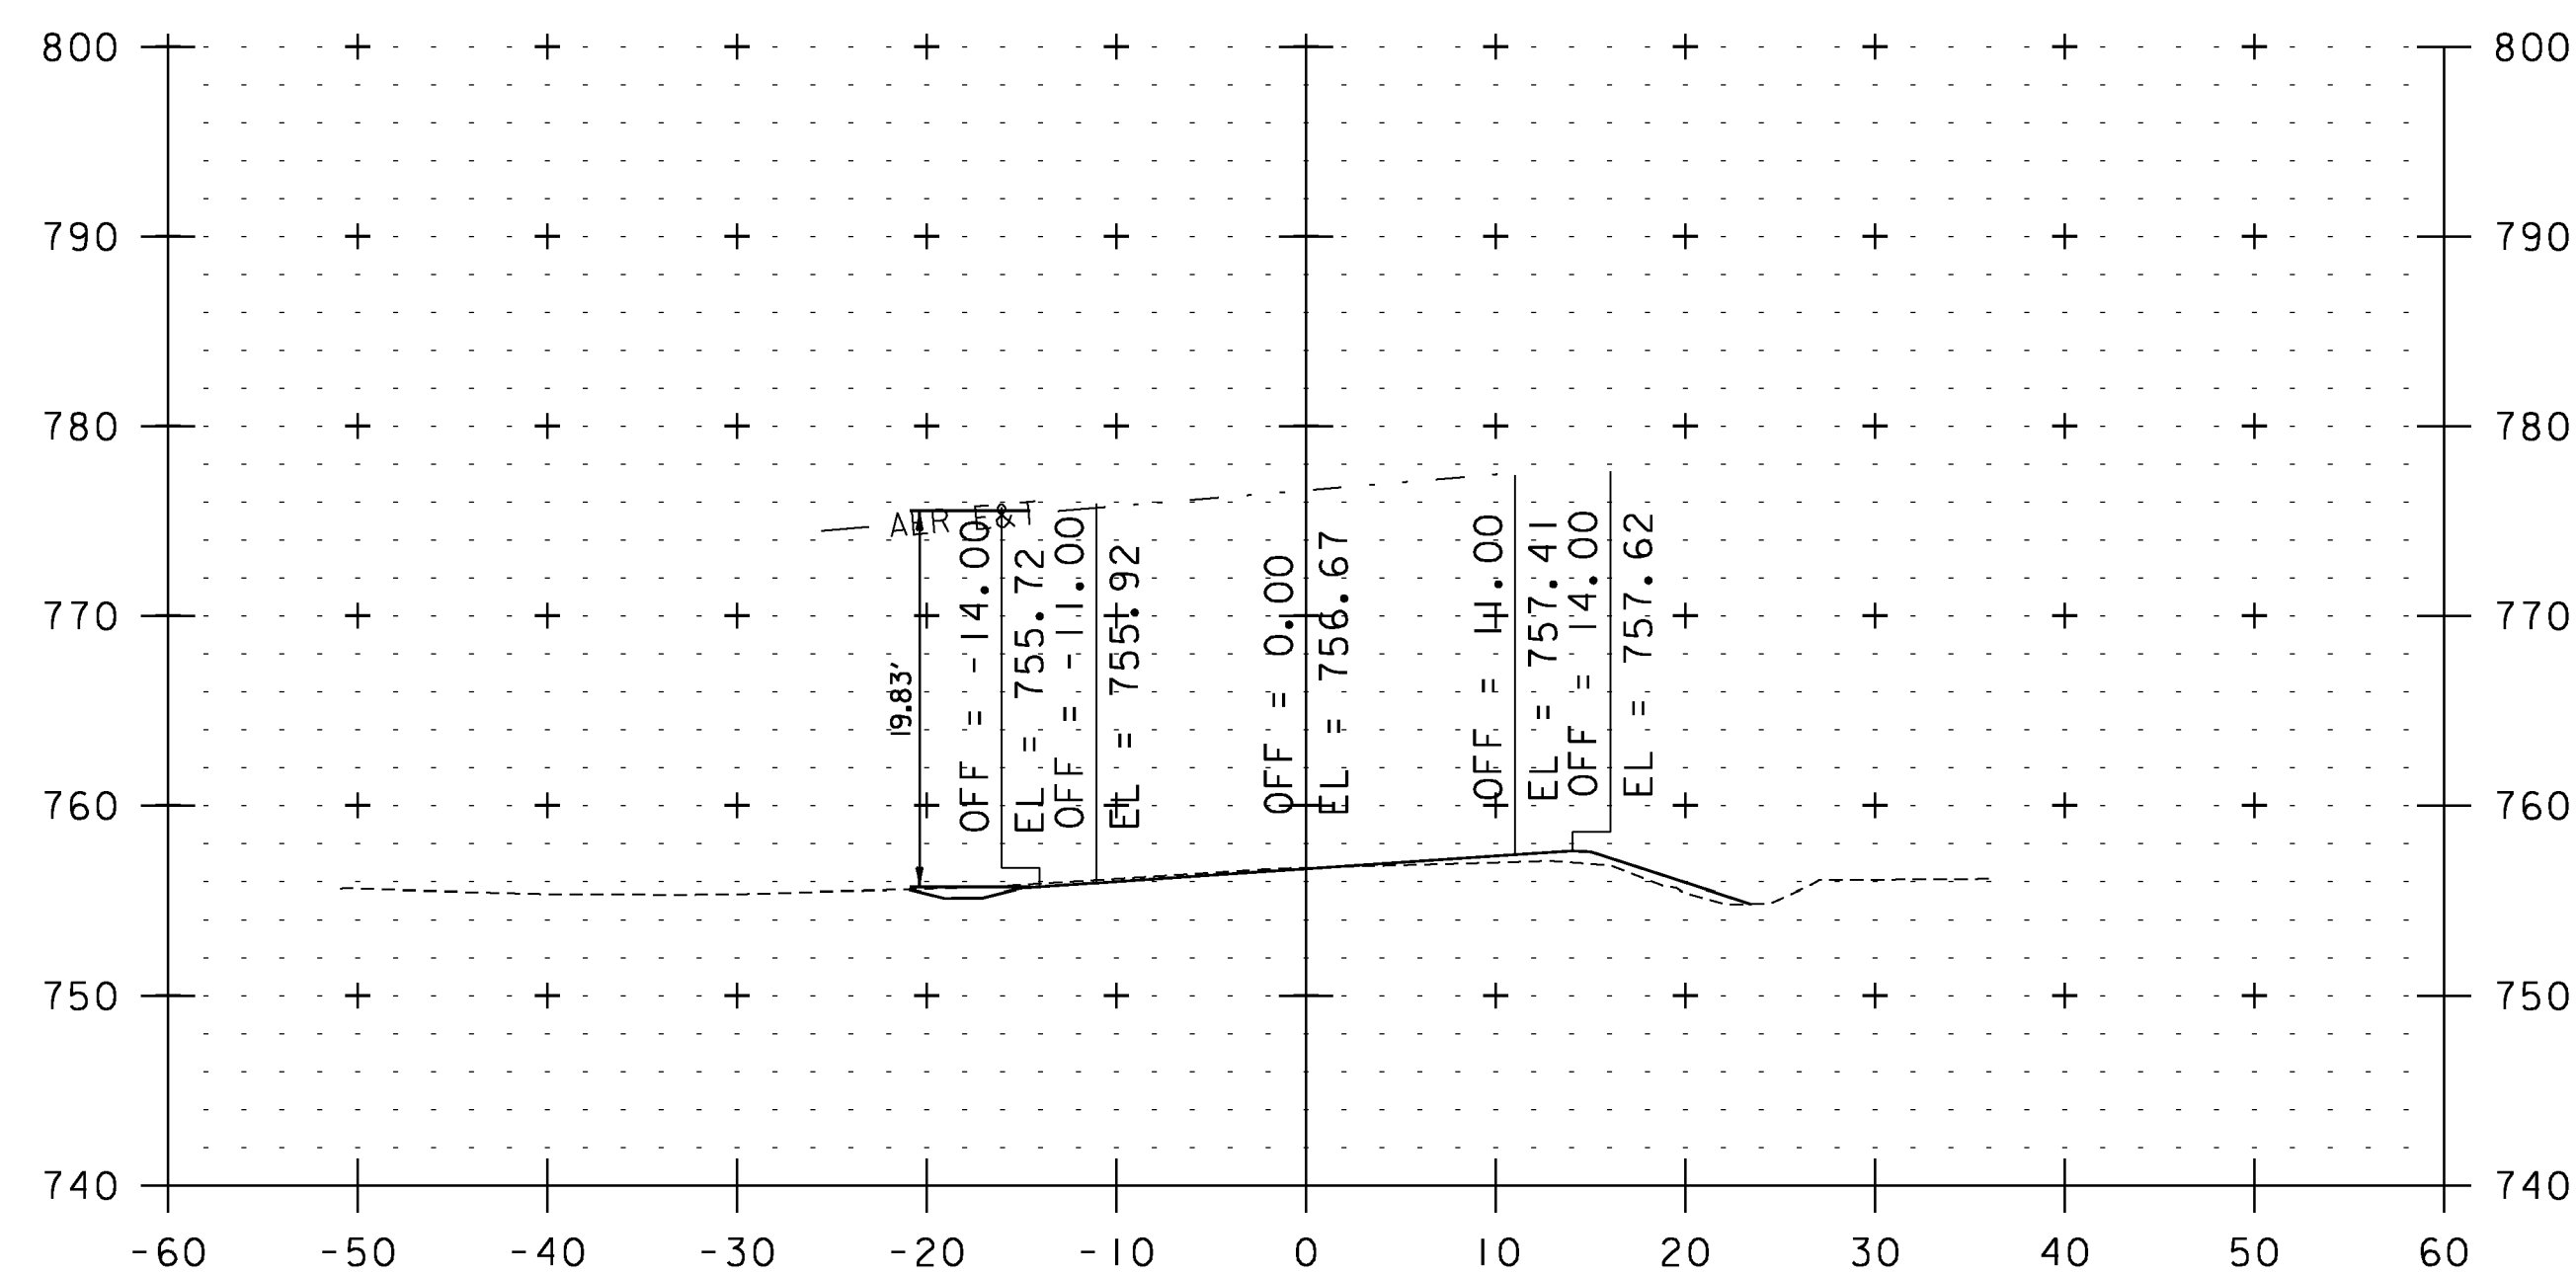

314+80

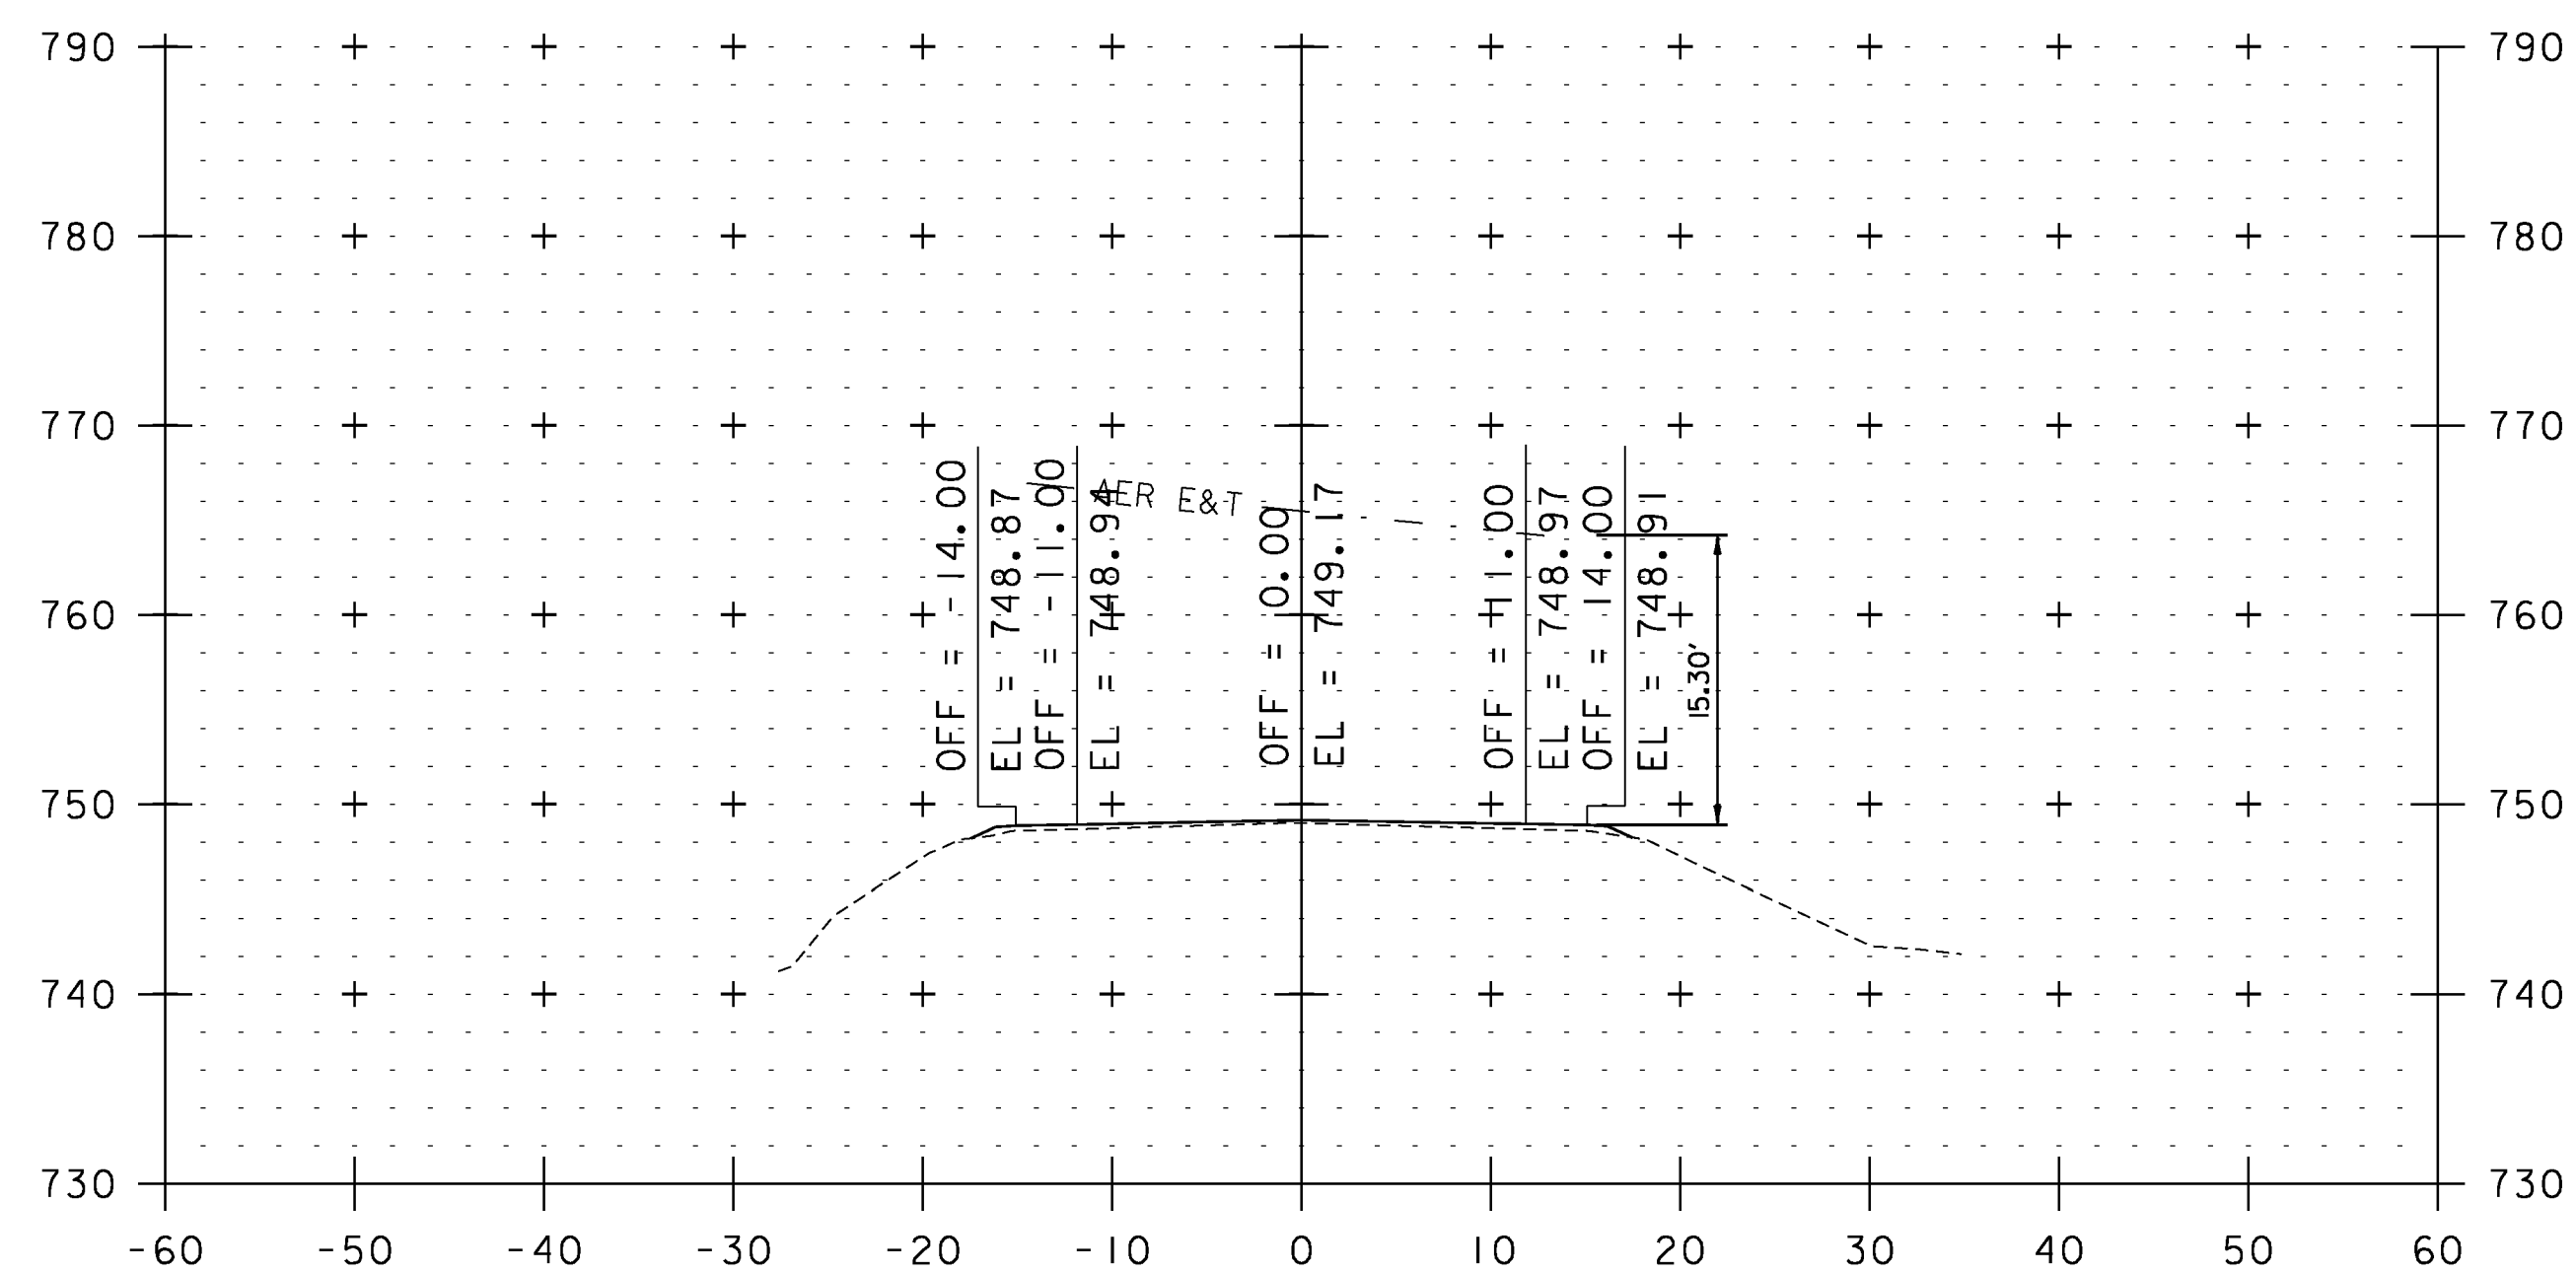

318+32

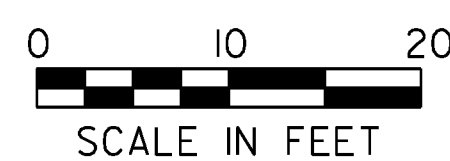

STA. 314+80 TO STA. 327+13

UTILITY CROSS SECTION SHEET 15

PROJECT NAME: WEATHERSFIELD	PLOT DATE: 2/7/2013
PROJECT NUMBER: STP 2913(I)	DRAWN BY: JLS
FILE NAME: I0c228	DESIGNED BY: NULL
PROJECT LEADER: PTS	CHECKED BY: PTS
IPARM FILE NAME: pI0c228.I97	SHEET 197 OF 234