




404+98

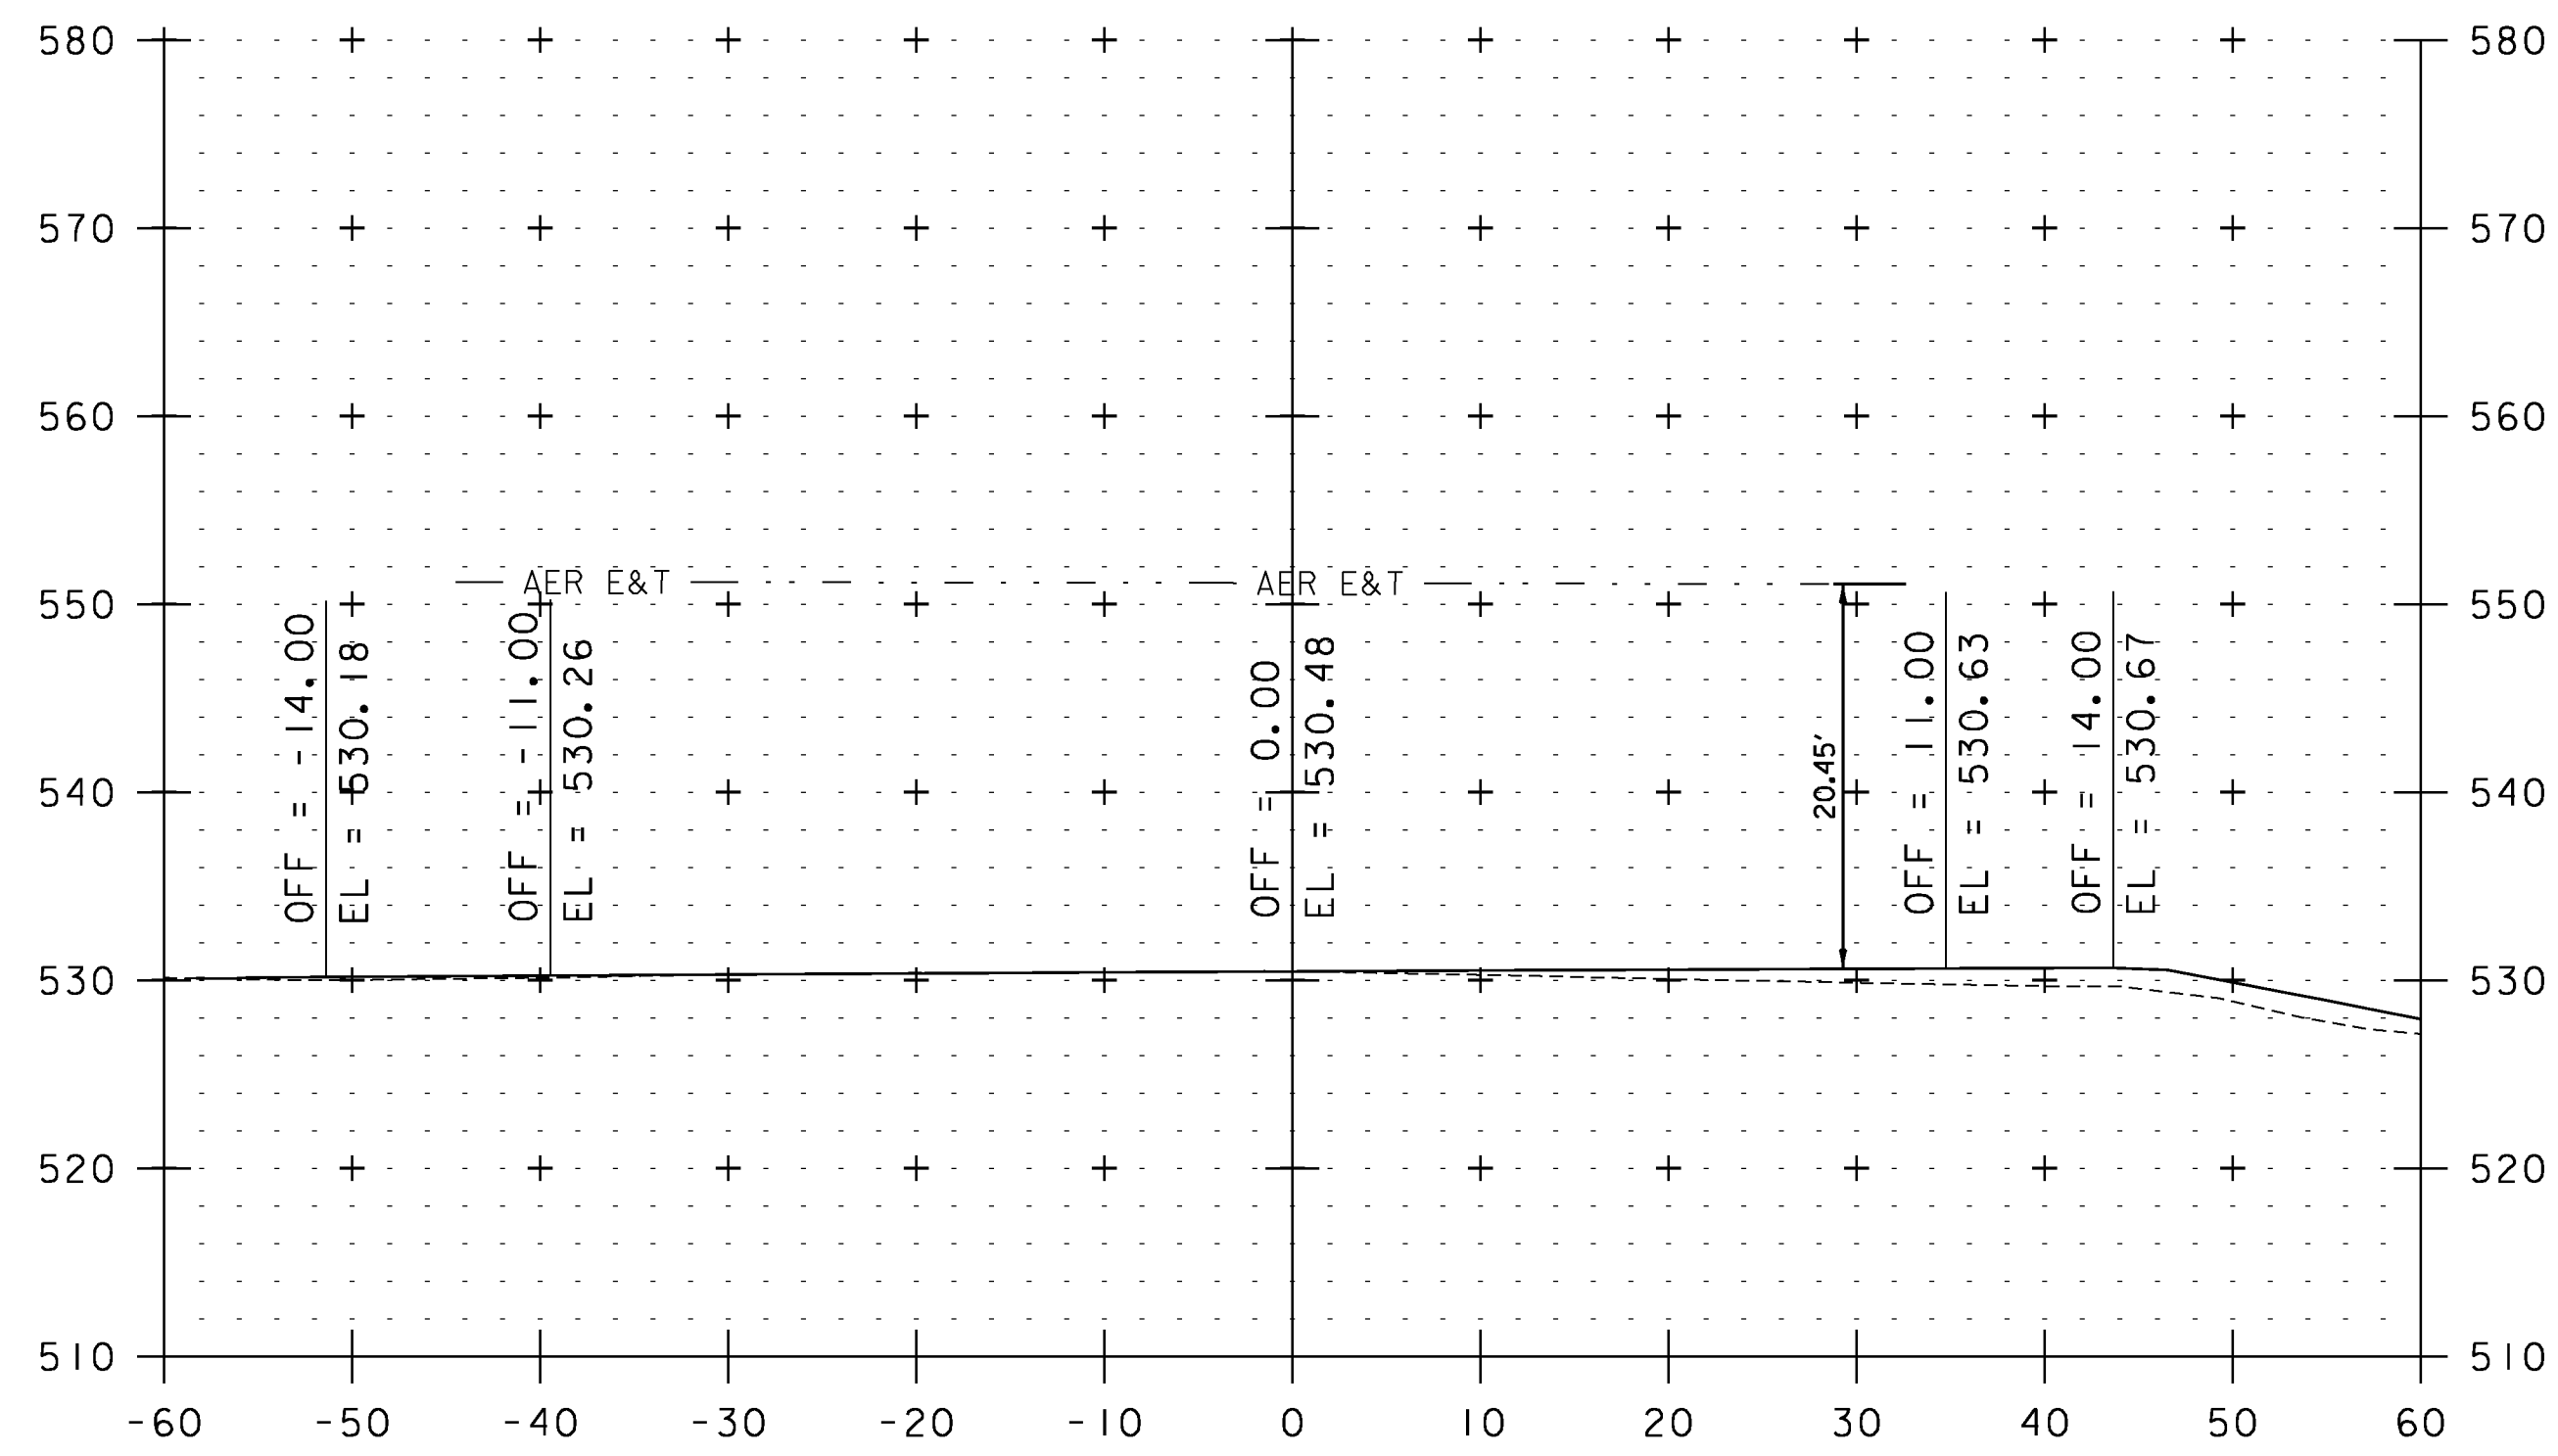

409+59

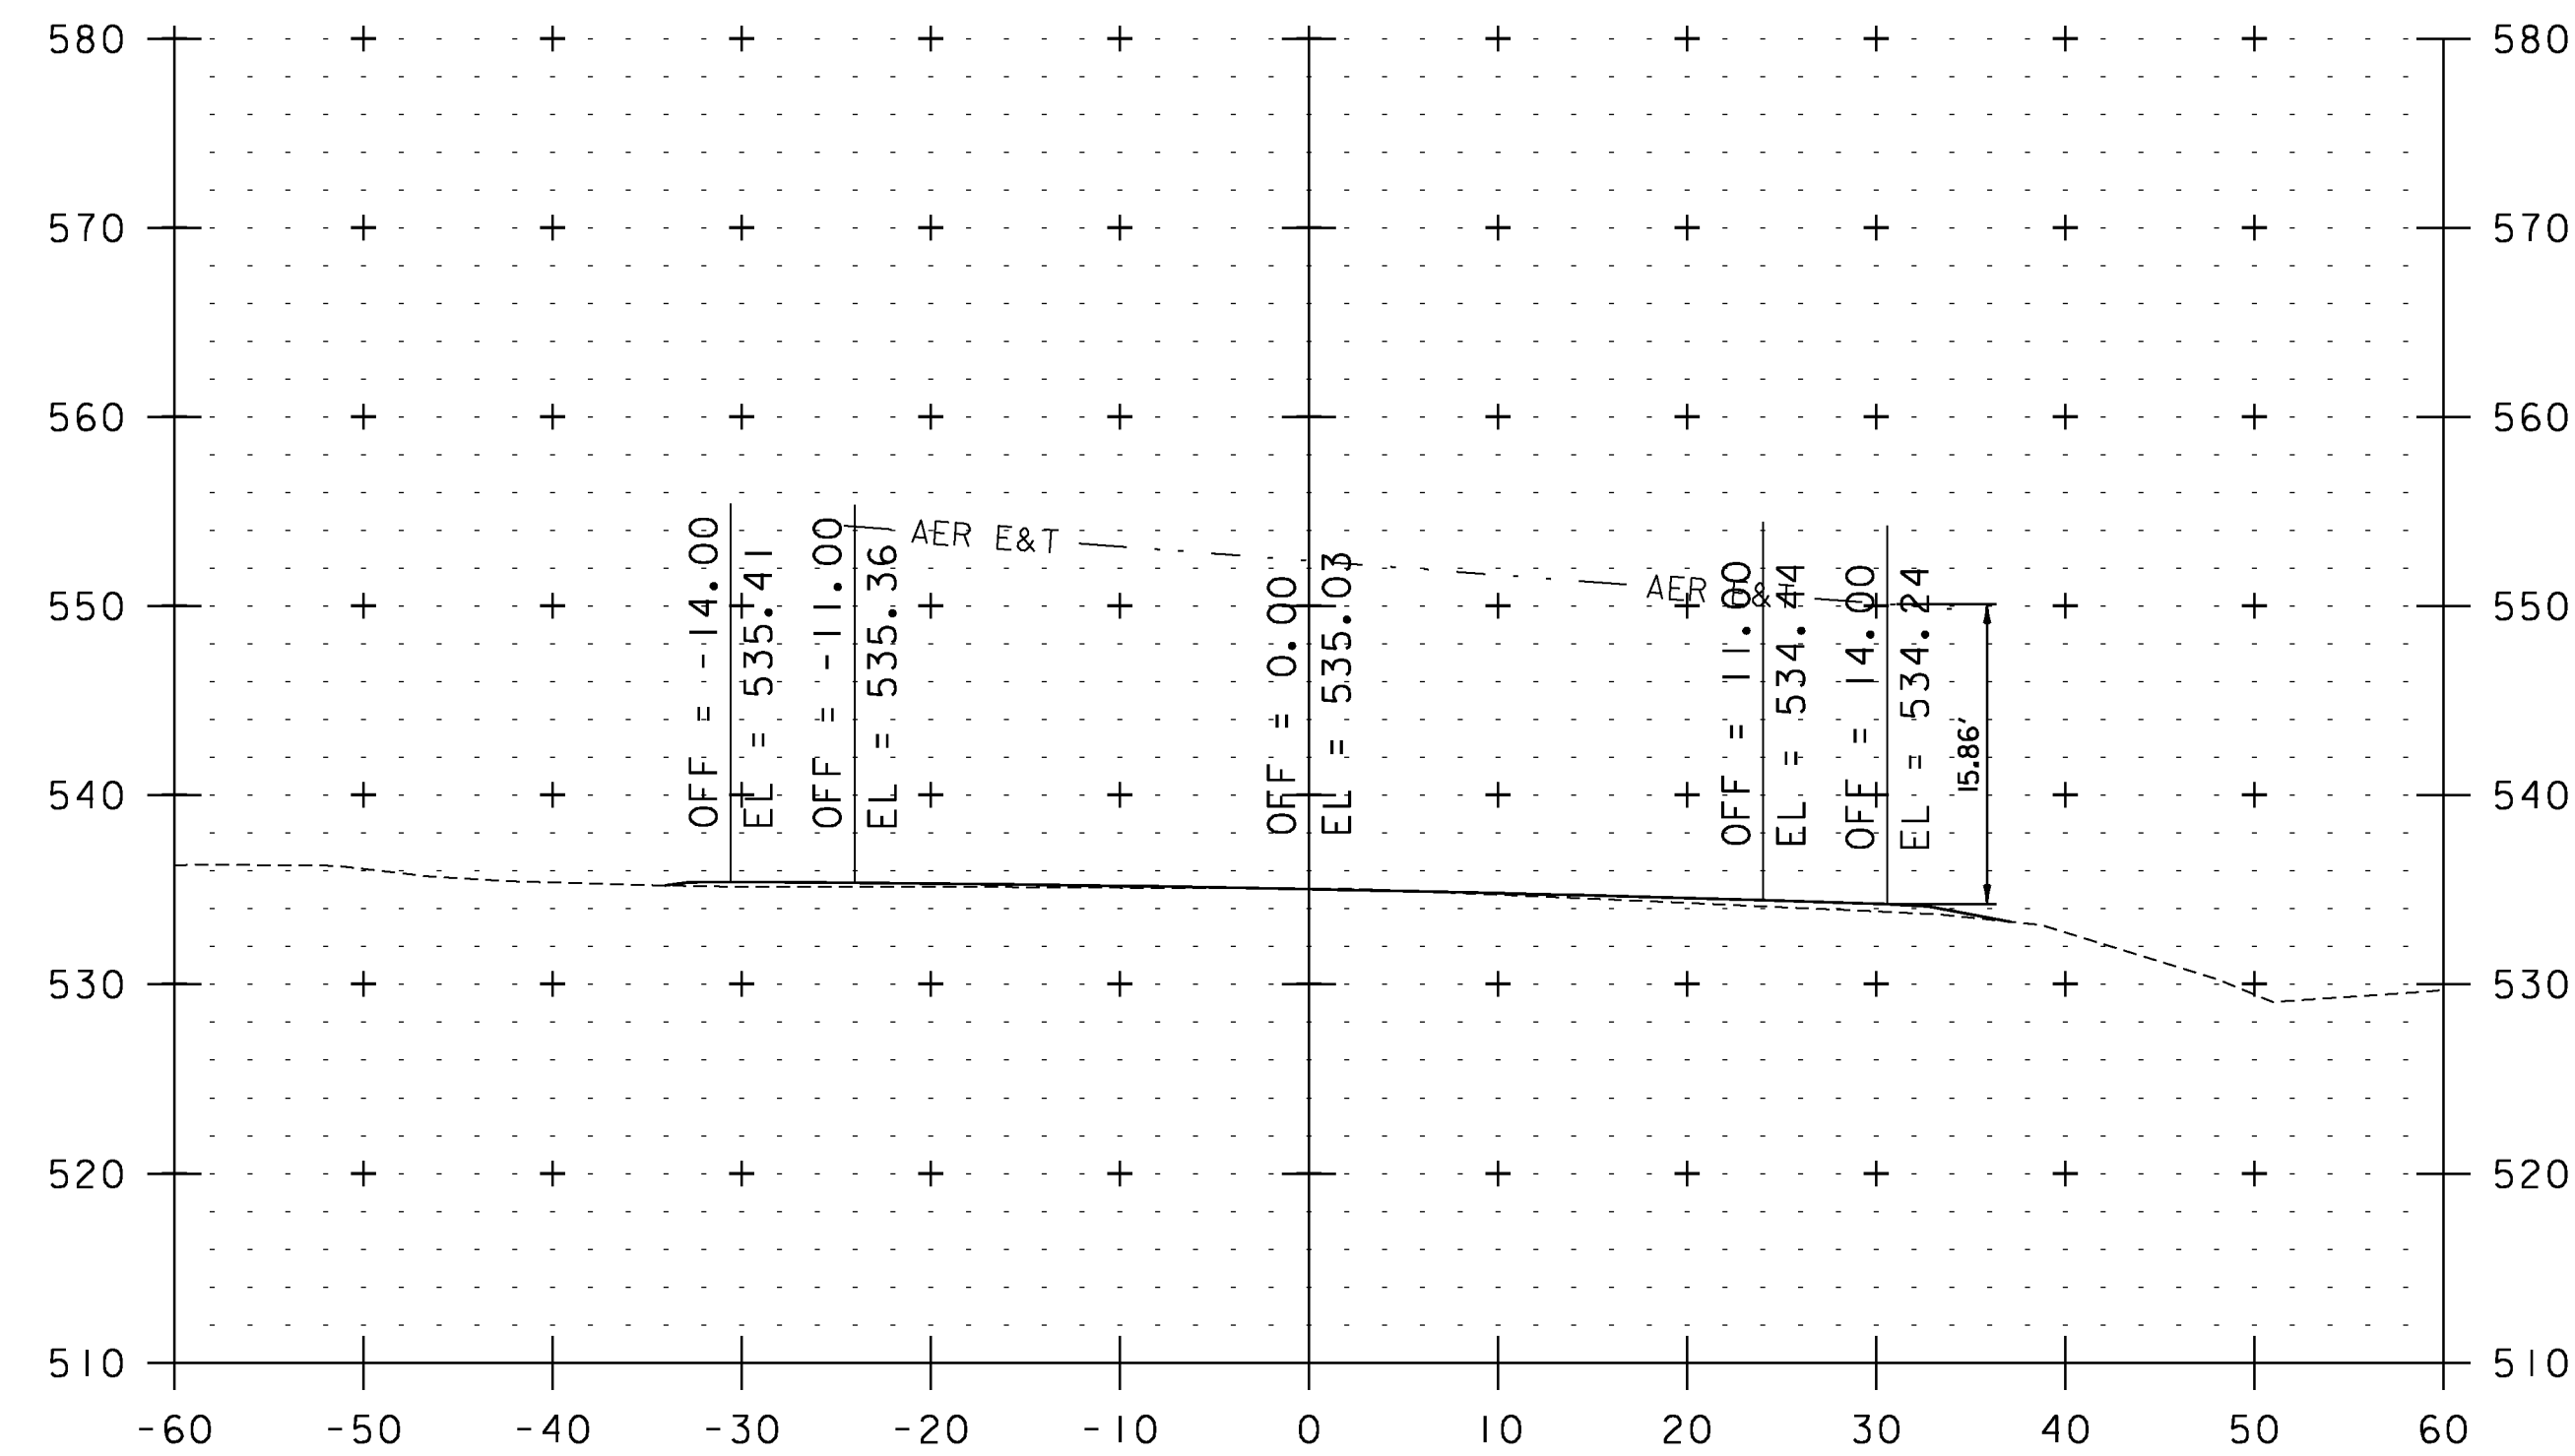


403+84

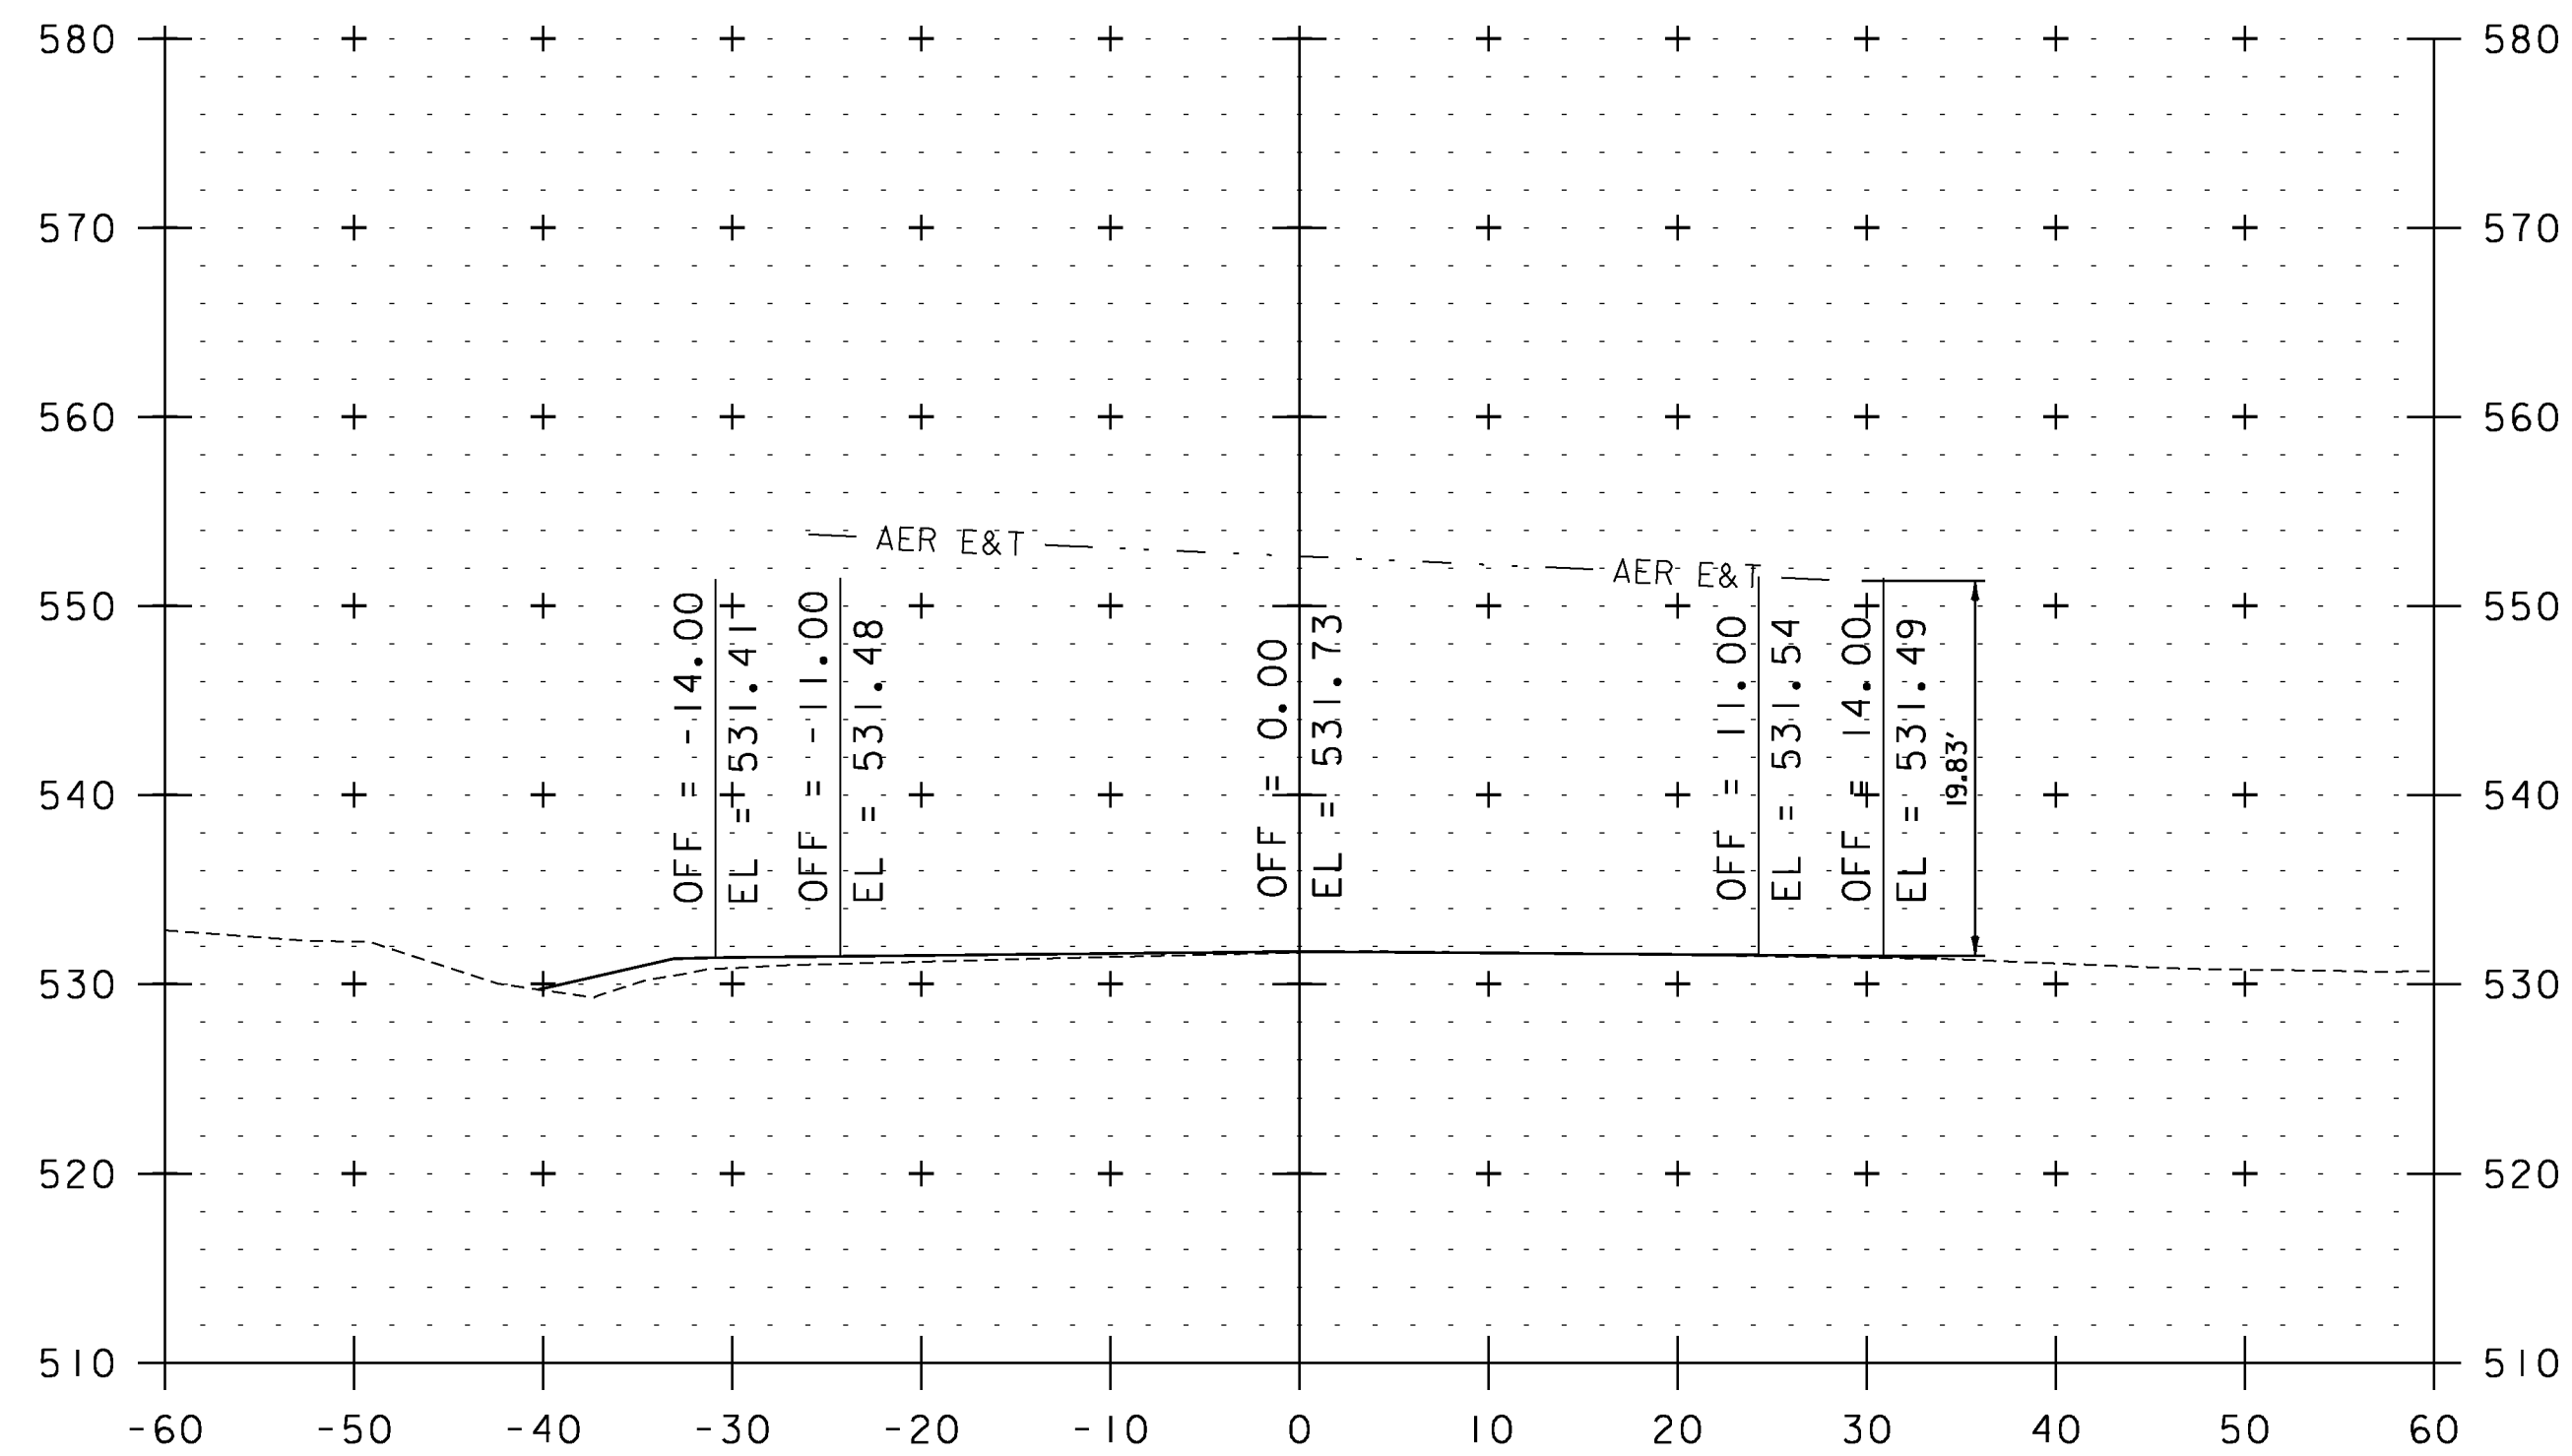

405+99

UTILITY CROSS SECTION SHEET 22

PROJECT NAME: WEATHERSFIELD	PLOT DATE: 2/7/2013
PROJECT NUMBER: STP 2913(I)	DRAWN BY: JLS
FILE NAME: I0c228	CHECKED BY: PTS
PROJECT LEADER: PTS	SHEET 204 OF 234
DESIGNED BY: NLL	
IPARM FILE NAME: pI0C228_204	

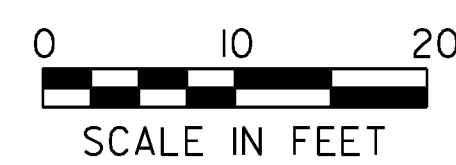

STA. 403+84 TO STA. 409+59