


**VT ROUTE 131  
END PROJECT  
STP 2913(1)**

**428+75.00 (MM 8.120)  
VT ROUTE 131 BEGIN PROJECT  
NH 2948(1)  
BEGIN 2" COLD PLANE  
& OVERLAY**

TEMPORARY 4 INCH WHITE LINE, PAINT  
DURABLE 4 INCH WHITE LINE (OPTION BID ITEM)  
428+75 TO 428+99 SOLID RT  
428+75 TO 429+31 SOLID LT  
429+69 TO 434+25 SOLID RT  
429+91 TO 434+25 SOLID LT  
  
TEMPORARY 4 INCH YELLOW LINE, PAINT  
DURABLE 4 INCH YELLOW LINE (OPTION BID ITEM)  
428+75 TO 429+45 SOLID LT & RT  
429+85 TO 434+25 SOLID LT & RT

TEMPORARY 6 INCH WHITE LINE, PAINT  
DURABLE 6 INCH WHITE LINE (OPTION BID ITEM)  
428+99 TO 429+10 SOLID RT (RAMP A)  
429+31 TO 429+59 SOLID LT (RAMP B)  
  
TEMPORARY 6 INCH YELLOW LINE, PAINT  
DURABLE 6 INCH YELLOW LINE (OPTION BID ITEM)  
429+26 TO 429+69 SOLID RT (RAMP A)  
429+81 TO 429+91 SOLID LT (RAMP B)  
  
TEMPORARY 24 INCH STOP BAR, PAINT  
DURABLE 24 INCH STOP BAR (OPTION BID ITEM)  
429+40 TO 429+88 SOLID LT (RAMP B)  
  
TEMPORARY LETTER OR SYMBOL, PAINT  
DURABLE LETTER OR SYMBOL (OPTION BID ITEM)  
429+64 LT - "STOP" (RAMP B)

STEEL BEAM GUARDRAIL, GALVANIZED  
430+30 TO 433+05 RT  
431+22.5 TO 434+10 LT  
  
ANCHOR FOR STEEL BEAM RAIL  
430+30 RT  
431+22.5 LT  
433+05 RT  
434+10 LT  
  
REMOVAL AND DISPOSAL OF GUARDRAIL  
430+43 TO 432+95 RT  
431+20 TO 434+09 LT  
  
DELINEATOR WITH STEEL POST  
430+30 RT  
431+22.5 LT  
433+05 RT  
434+10 LT  
  
REMOVING SIGNS  
AS SHOWN - 4

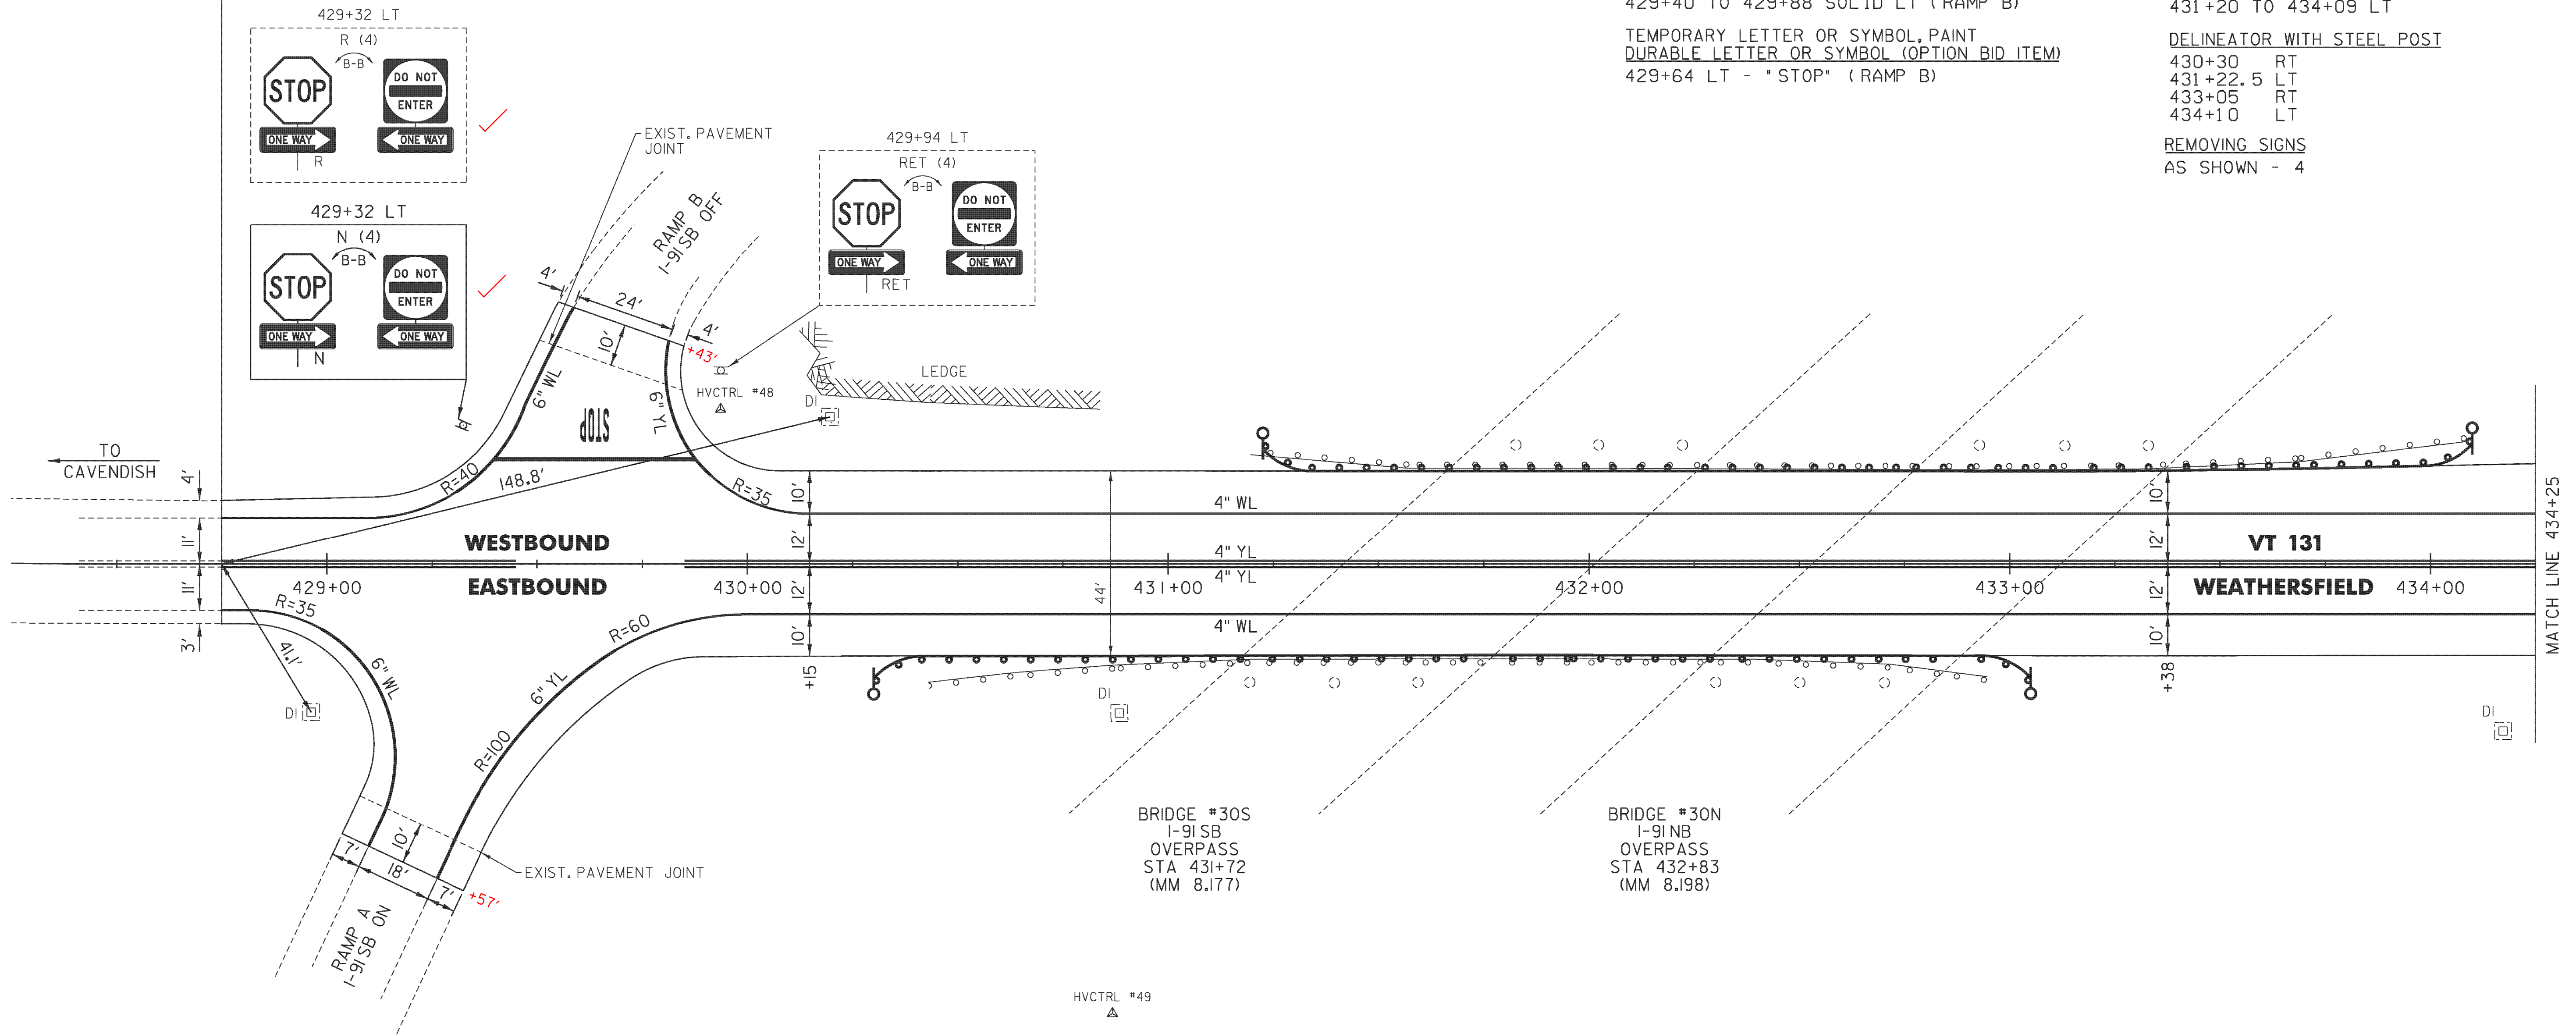

NOT TO SCALE

**LEGEND**

R	=	REMOVE EXISTING
S	=	SALVAGE
R&S	=	REMOVE AND SALVAGE
N	=	NEW
RET	=	RETAIN
B-B	=	BACK TO BACK
—○	=	EXISTING GUARDRAIL
—○	=	PROPOSED GUARDRAIL
YL	=	YELLOW LINE
WL	=	WHITE LINE
—○	=	DELINEATOR

**ROADWAY LAYOUT SHEET 1**

PROJECT NAME:	WEATHERSFIELD
PROJECT NUMBER:	NH 2948(1)
FILE NAME:	p12b126.dgn
PROJECT LEADER:	PTS
DESIGNED BY:	NLL
IPARM FILE NAME:	p12B126_217
PLOT DATE:	2/7/2013
DRAWN BY:	SNG
CHECKED BY:	PTS
SHEET	217 OF 234