

TEMPORARY 4 INCH WHITE LINE, PAINT
 DURABLE 4 INCH WHITE LINE (OPTION BID ITEM)
 3+50 TO 8+50 SOLID LT & RT

TEMPORARY 4 INCH YELLOW LINE, PAINT
 DURABLE 4 INCH YELLOW LINE (OPTION BID ITEM)
 3+50 TO 8+50 SOLID LT & RT

STEEL BEAM GUARDRAIL, GALVANIZED
 3+50 TO 4+99.5 RT
 3+50 TO 7+58 LT

ANCHOR FOR STEEL BEAM RAIL
 4+99.5 RT
 7+58 LT


REMOVAL AND DISPOSAL OF GUARDRAIL
 3+50 TO 5+04 RT
 3+50 TO 7+62 LT

DELINEATOR WITH STEEL POST
 4+99.5 RT
 7+44 LT

REMOVING SIGNS
 AS SHOWN - 4

THINNING AND TRIMMING FOR SIGNS
 4+00 RT

REMOVING SIGNS
 AS SHOWN - 4

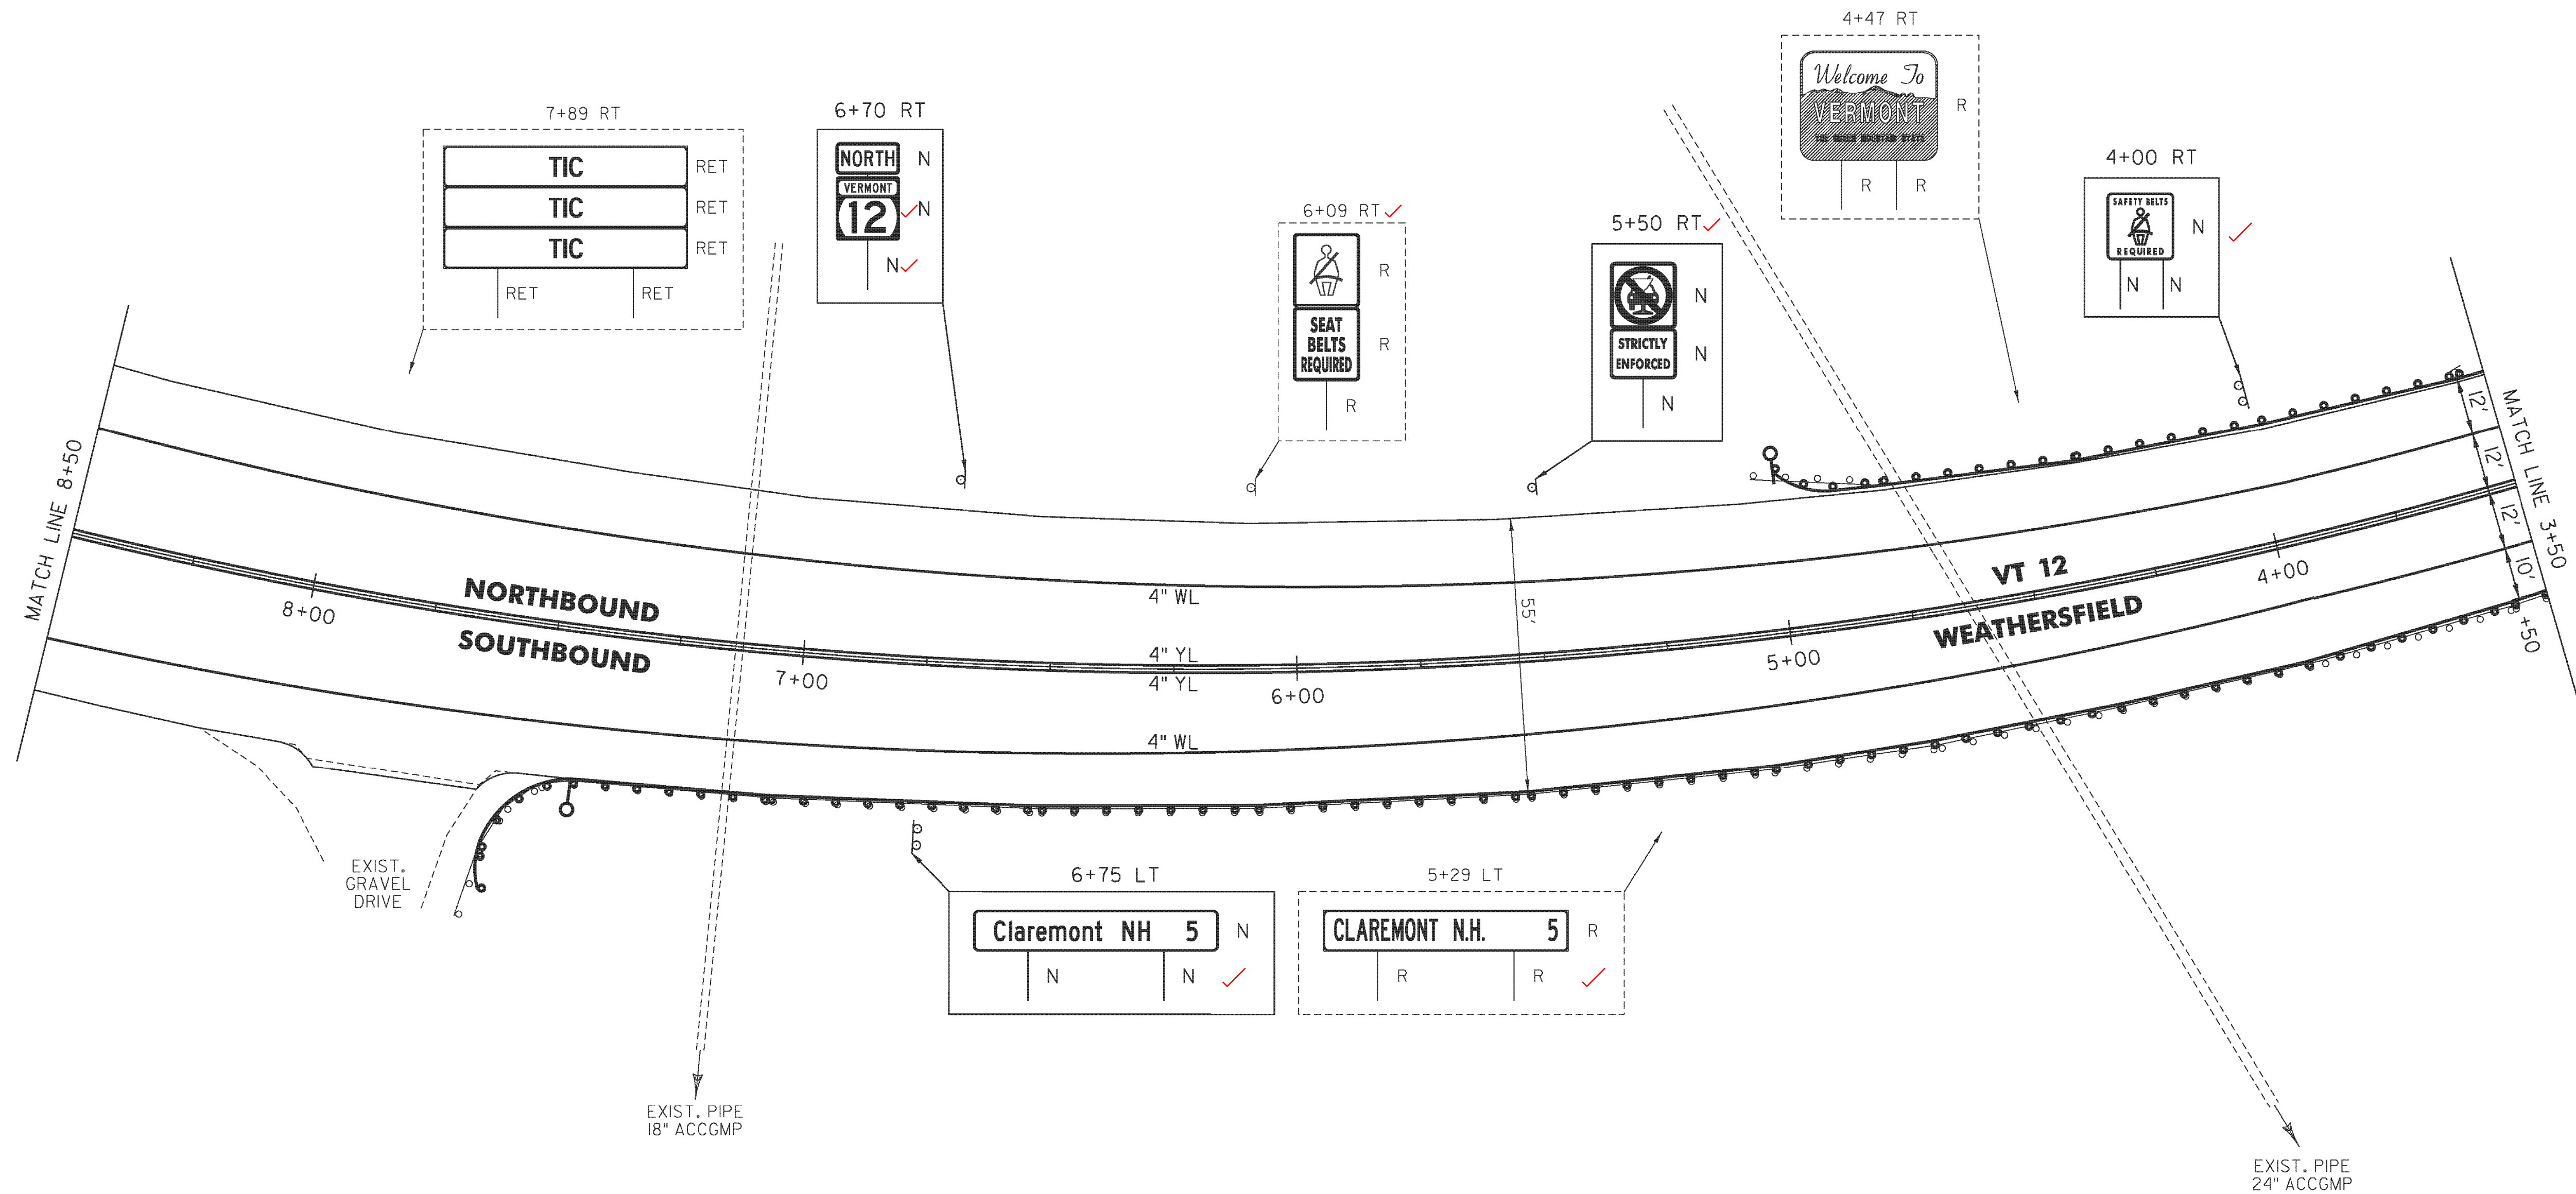

NOT TO SCALE

LEGEND

- R = REMOVE EXISTING
- S = SALVAGE
- R&S = REMOVE AND SALVAGE
- N = NEW
- RET = RETAIN
- B-B = BACK TO BACK
- = EXISTING GUARDRAIL
- = PROPOSED GUARDRAIL
- YL = YELLOW LINE
- WL = WHITE LINE
- = DELINEATOR

ROADWAY LAYOUT SHEET 9

PROJECT NAME: WEATHERSFIELD	FILE NAME: p12b126.dgn	PLOT DATE: 2/7/2013
PROJECT NUMBER: NH 2948(I)	PROJECT LEADER: PTS	DRAWN BY: SNG
	DESIGNED BY: NLL	CHECKED BY: PTS
	IPARM FILE NAME: p12B126_226	SHEET 226 OF 234