


TEMPORARY 4 INCH WHITE LINE, PAINT  
 DURABLE 4 INCH WHITE LINE (OPTION BID ITEM)  
 0+96 TO 3+50 SOLID LT & RT  
 TEMPORARY 4 INCH YELLOW LINE, PAINT  
 DURABLE 4 INCH YELLOW LINE (OPTION BID ITEM)  
 0+96 TO 3+50 SOLID LT & RT

STEEL BEAM GUARDRAIL, GALVANIZED  
 1+12 TO 1+99.5 LT  
 1+12 TO 3+50 RT  
 2+57 TO 3+50 LT  
 ANCHOR FOR STEEL BEAM RAIL  
 1+99.5 LT  
 2+57 LT

REMOVAL AND DISPOSAL OF GUARDRAIL  
 1+12 TO 2+03 LT  
 1+12 TO 3+50 RT  
 2+57 TO 3+50 LT  
 DELINEATOR WITH STEEL POST  
 1+99.5 LT  
 2+57 LT

THINNING AND TRIMMING FOR SIGNS  
 2+50 RT  
 3+25 LT  
 REMOVING SIGNS  
 AS SHOWN - 7

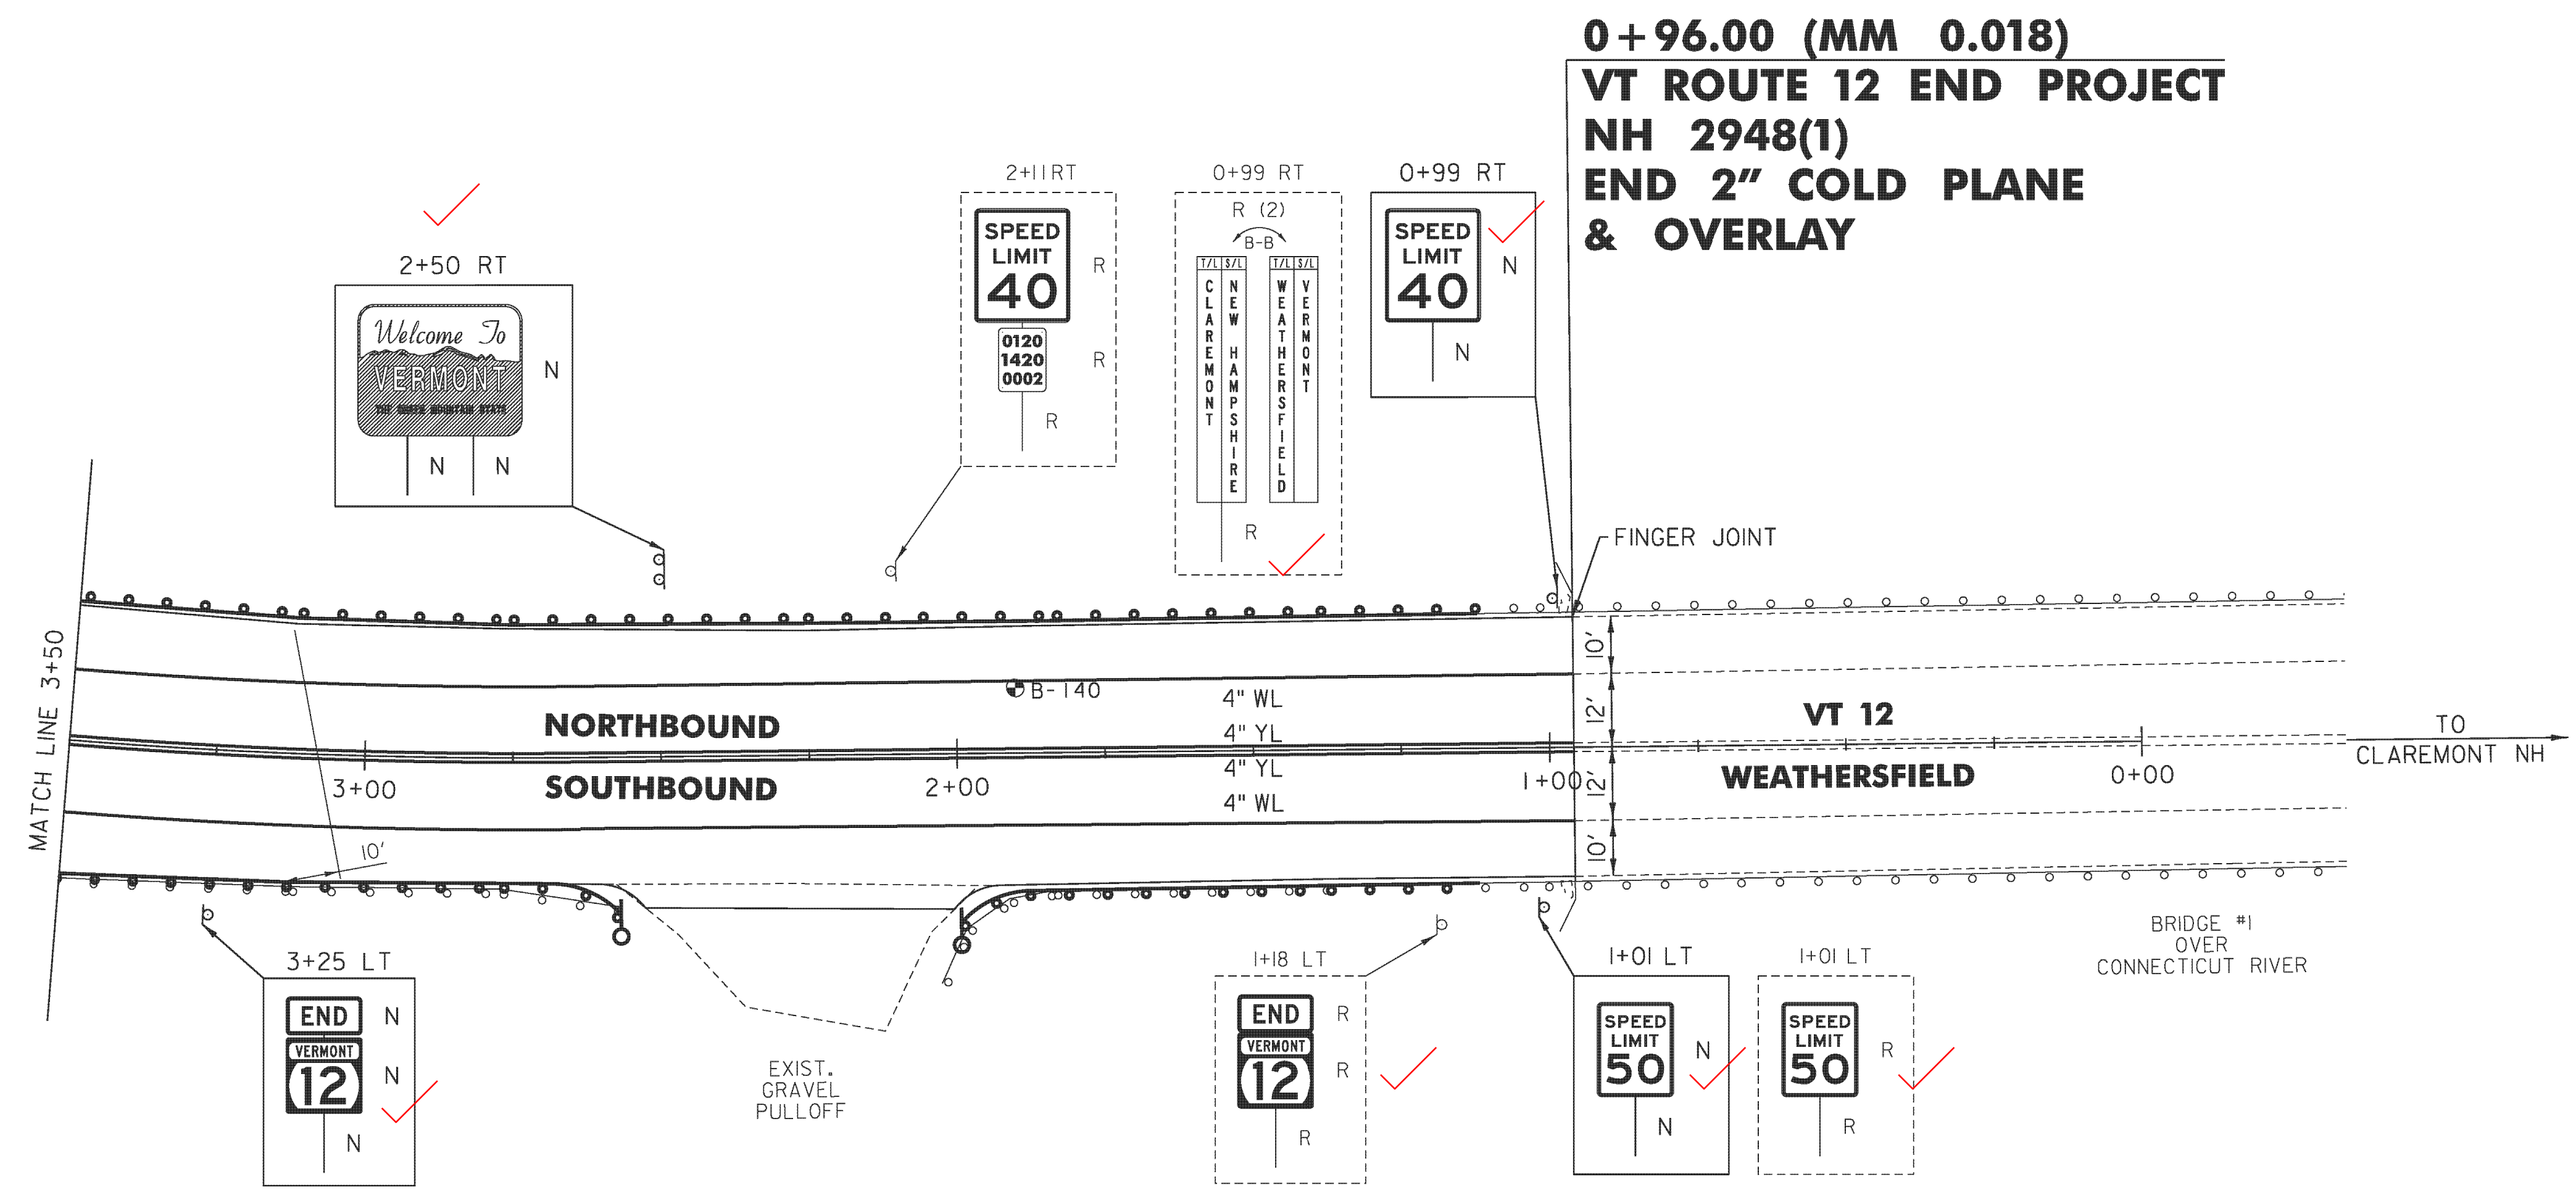

**0+96.00 (MM 0.018)**  
**VT ROUTE 12 END PROJECT**  
**NH 2948(1)**  
**END 2" COLD PLANE**  
**& OVERLAY**

**LEGEND**

- R = REMOVE EXISTING
- S = SALVAGE
- R&S = REMOVE AND SALVAGE
- N = NEW
- RET = RETAIN
- B-B = BACK TO BACK
- = EXISTING GUARDRAIL
- = PROPOSED GUARDRAIL
- YL = YELLOW LINE
- WL = WHITE LINE
- = DELINEATOR

**ROADWAY LAYOUT SHEET 10**

PROJECT NAME: WEATHERSFIELD	FILE NAME: p12b126.dgn	PLOT DATE: 2/7/2013
PROJECT NUMBER: NH 2948(1)	PROJECT LEADER: PTS	DRAWN BY: SNG
	DESIGNED BY: NLL	CHECKED BY: PTS
	IPARM FILE NAME: p12BI26_227	SHEET 227 OF 234

NOT TO SCALE