


PROJECT PAVING LIMITS

TOWN	BEGIN STATION	END STATION	LT SHOULDER	LANE TYPICAL	RT SHOULDER	WEARING DEPTH (in)		INTERMEDIATE DEPTH (in)	NOTES
						TYPE IVS	TYPE IIS		
VT 131									
WEATHERSFIELD	70+00	70+75	VARIES	11.0-11.0	VARIES	1 1/2"	2 1/2"		COLD PLANE AND PAVE (SEE APPROACH AREA DETAIL ON NEXT SHEET)
	70+75	80+00	3.0	11.0-11.0	3.0	1 1/2"	2 1/2"		COLD PLANE 4", RECLAIM 8", PAVE COLD MIX, INTERMEDIATE AND WEARING
	80+00	80+50	3.0	11.0-11.0	VARIES	1 1/2"	2 1/2"		COLD PLANE 4", RECLAIM 8", PAVE COLD MIX, INTERMEDIATE AND WEARING
	80+50	81+00	3.0	11.0-11.0	VARIES	1 1/2"	2 1/2"		COLD PLANE 4", RECLAIM 8", PAVE COLD MIX, INTERMEDIATE AND WEARING
	81+00	106+00	3.0	11.0-11.0	3.0	1 1/2"	2 1/2"		COLD PLANE 4", RECLAIM 8", PAVE COLD MIX, INTERMEDIATE AND WEARING
	106+00	106+87	4.0	11.0-11.0	VARIES	1 1/2"	2 1/2"		COLD PLANE 4", RECLAIM 8", PAVE COLD MIX, INTERMEDIATE AND WEARING
	106+87	107+59	5.0	11.0-11.0	5.0	1 1/4"			COLD PLANE 1 1/4", LEVEL AND OVERLAY APPROACHES AND BRIDGE #10
	107+59	108+45	5.0	11.0-11.0	3.0	1 1/2"	2 1/2"		COLD PLANE 4", RECLAIM 8", PAVE COLD MIX, INTERMEDIATE AND WEARING
	108+45	108+85	VARIES	11.0-11.0	3.0	1 1/2"	2 1/2"		COLD PLANE 4", RECLAIM 8", PAVE COLD MIX, INTERMEDIATE AND WEARING
	108+85	125+18	3.0	11.0-11.0	3.0	1 1/2"	2 1/2"		COLD PLANE 4", RECLAIM 8", PAVE COLD MIX, INTERMEDIATE AND WEARING
	125+18	126+15	VARIES	11.0-11.0	VARIES	1 1/2"	2 1/2"		COLD PLANE 4", RECLAIM 8", PAVE COLD MIX, INTERMEDIATE AND WEARING
	126+15	126+57	4.0	11.0-11.0	4.0	1 1/4"			COLD PLANE 1 1/4", LEVEL AND OVERLAY APPROACHES AND BRIDGE #11
	126+57	127+14	4.0	11.0-11.0	4.0	1 1/2"	2 1/2"		COLD PLANE 4", RECLAIM 8", PAVE COLD MIX, INTERMEDIATE AND WEARING
	127+14	127+39	4.0	11.0-11.0	3.0	1 1/2"	2 1/2"		COLD PLANE 4", RECLAIM 8", PAVE COLD MIX, INTERMEDIATE AND WEARING
	127+39	428+00	3.0	11.0-11.0	3.0	1 1/2"	2 1/2"		COLD PLANE 4", RECLAIM 8", PAVE COLD MIX, INTERMEDIATE AND WEARING
	428+00	428+75	3.0	11.0-11.0	3.0	1 1/2"	2 1/2"		COLD PLANE AND PAVE (SEE APPROACH AREA DETAIL ON NEXT SHEET)

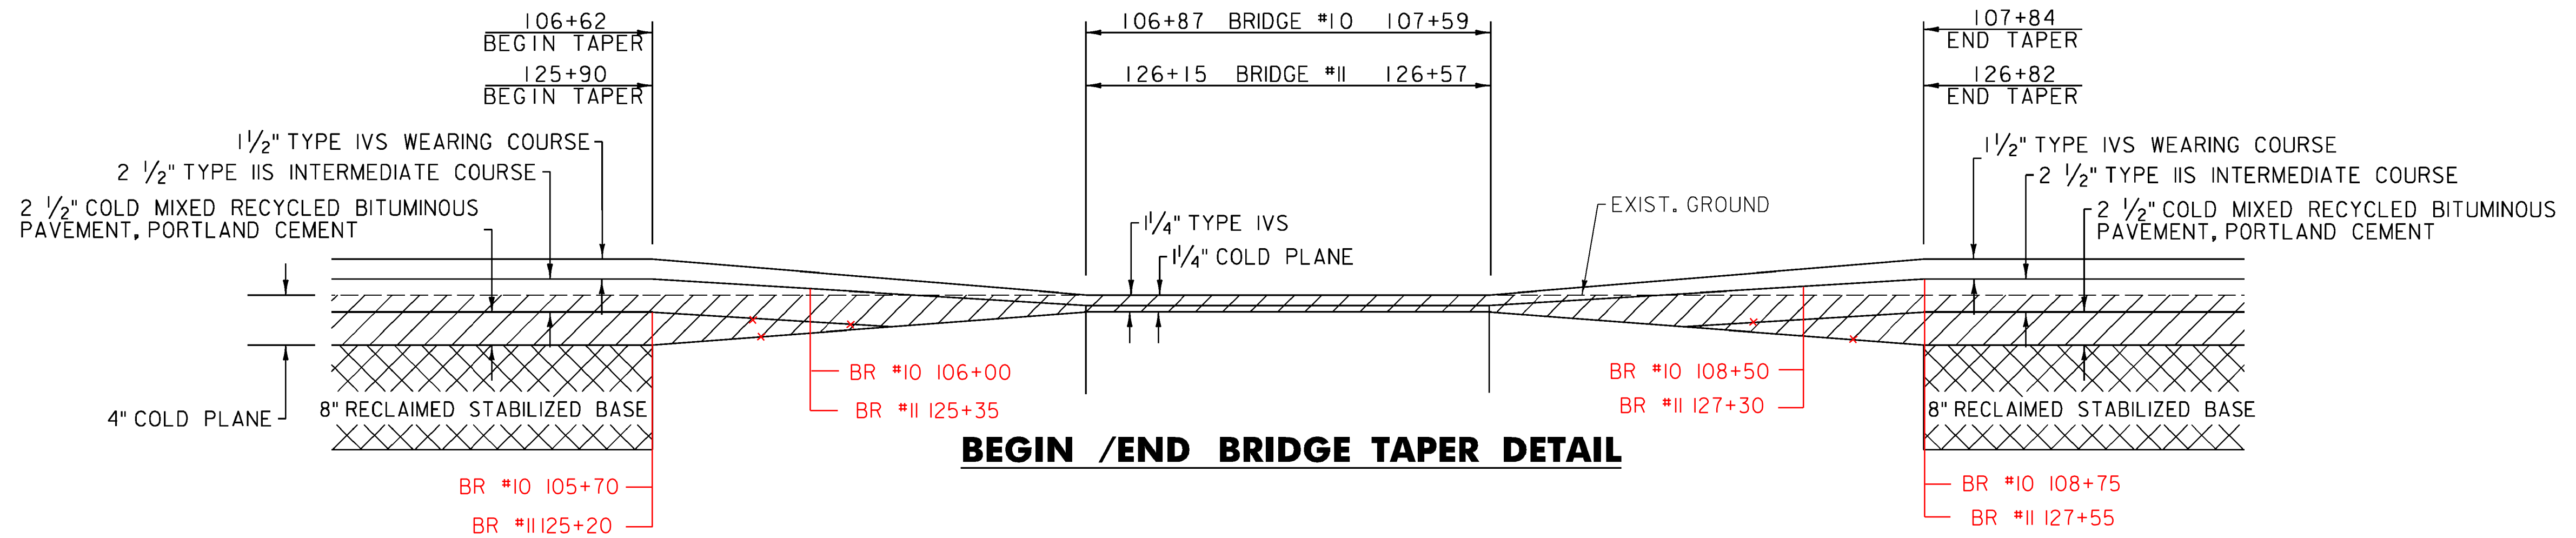

PROJECT TYPICAL SHEET 1

PROJECT NAME: WEATHERSFIELD

PROJECT NUMBER: STP 2913(1)

FILE NAME: 10c228.dgn

PROJECT LEADER: PTS

DESIGNED BY: NULL

IPARM FILE NAME: p10c228_21

PLOT DATE: 2/7/2013

DRAWN BY: WWG

CHECKED BY: PTS

SHEET 21 OF 234

NOT TO SCALE