
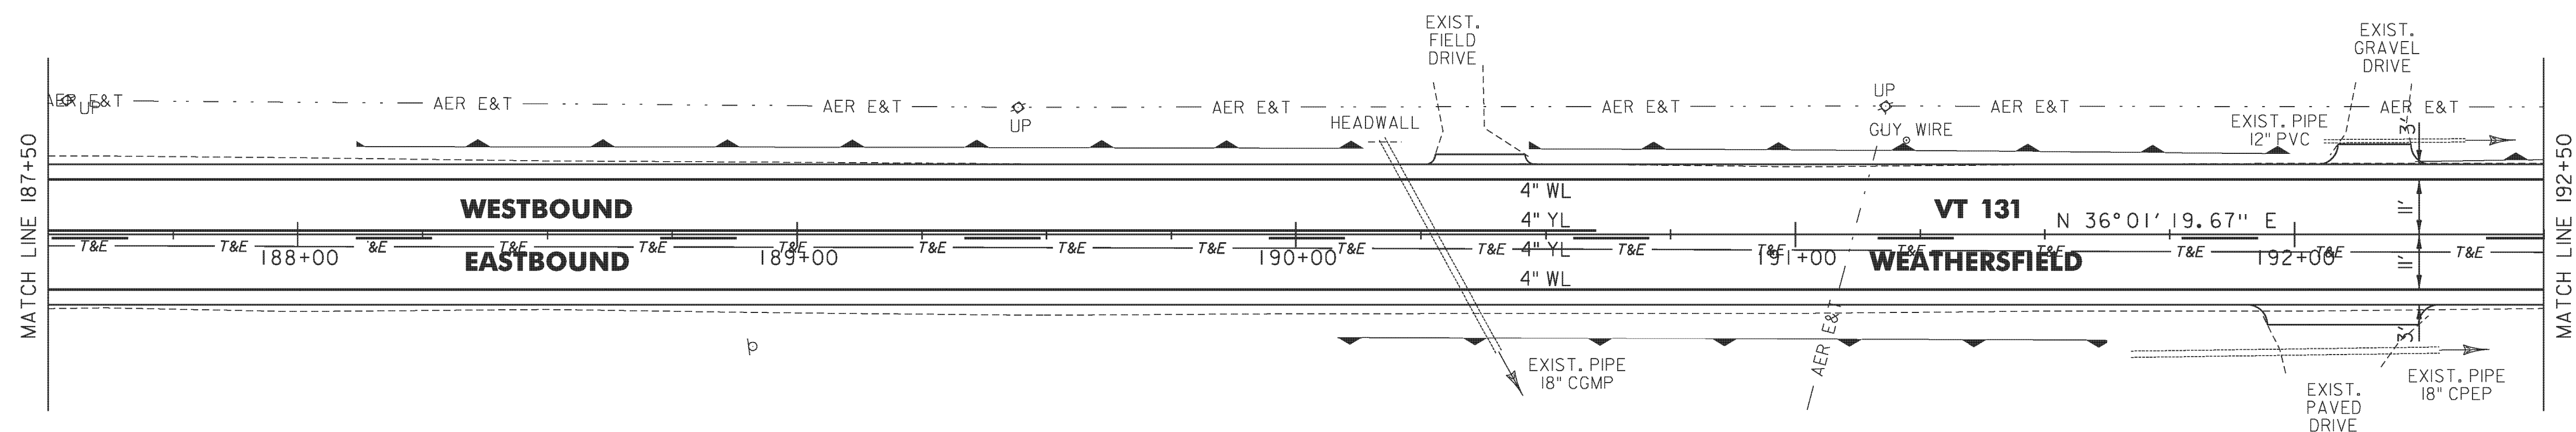


TEMPORARY 4" WHITE LINE, PAINT  
 DURABLE 4" WHITE LINE (OPTION BID ITEM)  
 181+50 TO 192+50 SOLID LT  
 181+50 TO 183+61 SOLID RT  
 183+61 TO 183+84 SOLID RT (TH 4)  
 184+20 TO 184+43 SOLID RT (TH 4)  
 184+43 TO 192+50 SOLID RT

TEMPORARY 4" YELLOW LINE, PAINT  
 DURABLE 4" YELLOW LINE (OPTION BID ITEM)  
 181+50 TO 183+78 SOLID LT & RT  
 184+02 DOUBLE SOLID RT (TH 4)  
 184+18 TO 184+54 SOLID LT & RT  
 184+54 TO 190+60 SOLID LT, DASHED RT  
 190+60 TO 192+50 DASHED CL

TEMPORARY 24" STOP BAR, PAINT  
 DURABLE 24" STOP BAR (OPTION BID ITEM)  
 184+03 TO 184+20 RT (TH 4)

TEMPORARY LETTER OR SYMBOL, PAINT  
 DURABLE LETTER OR SYMBOL (OPTION BID ITEM)  
 184+08 RT - "STOP" (TH 4)

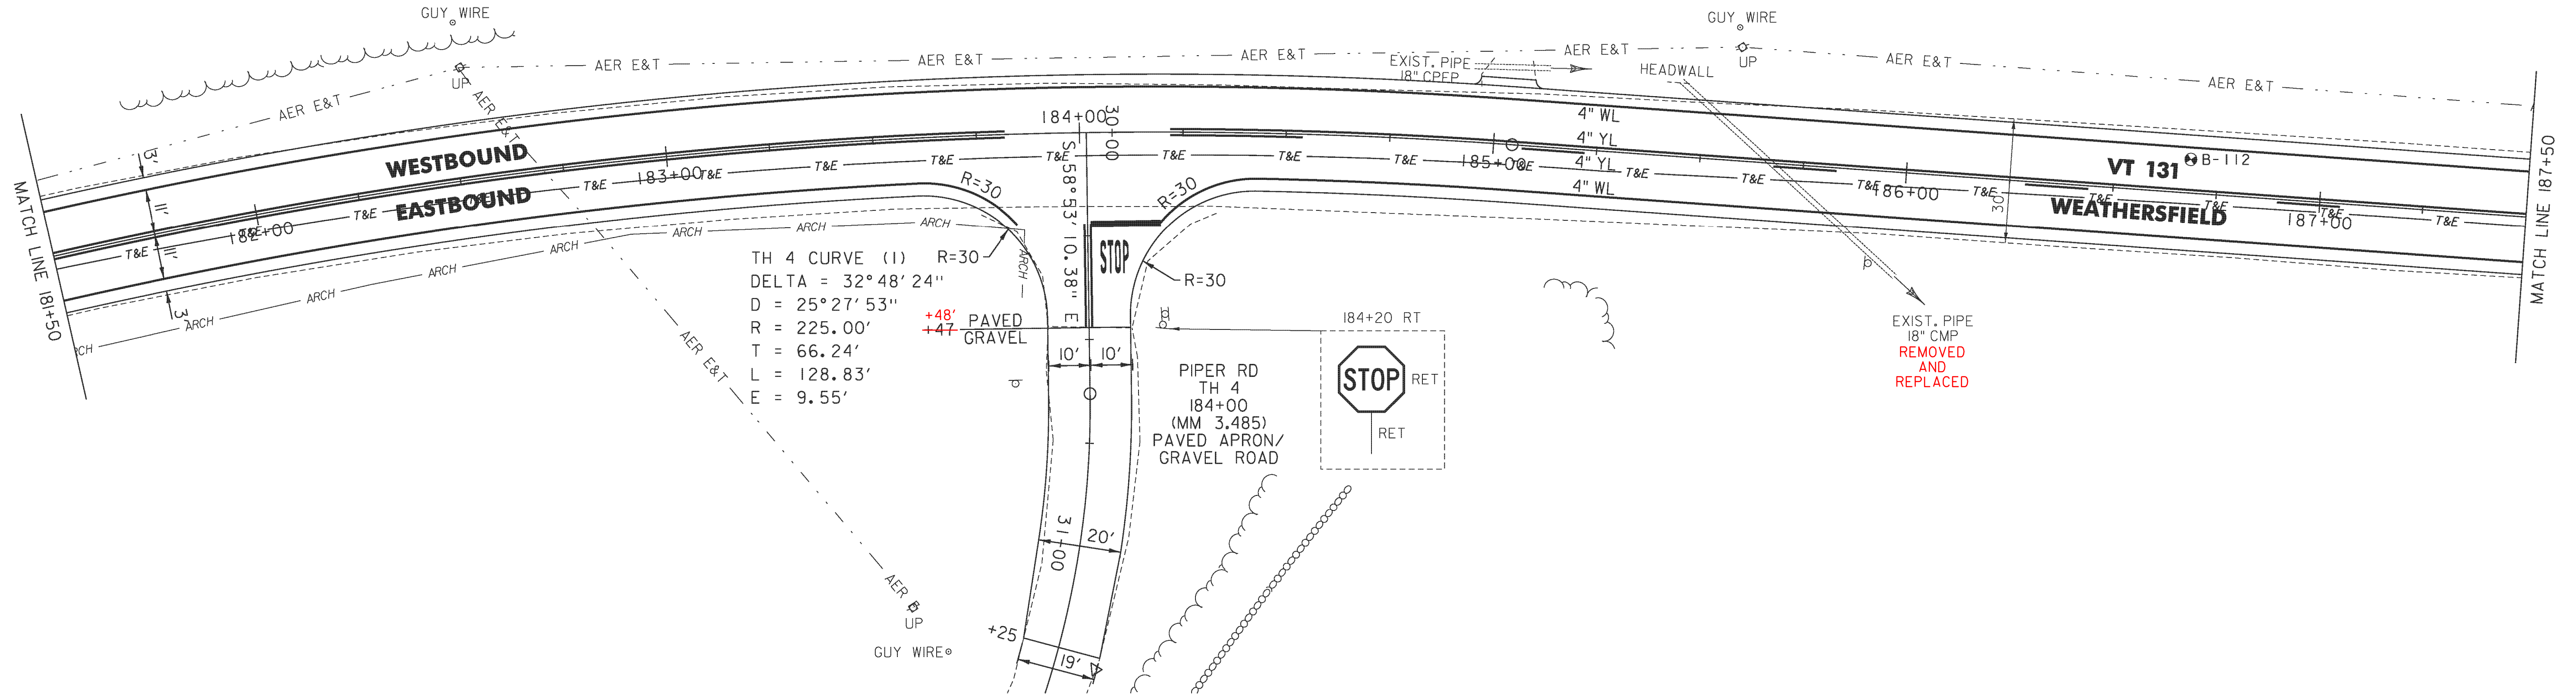

LEGEND

- R = REMOVE EXISTING
- S = SALVAGE
- R&S = REMOVE AND SALVAGE
- N = NEW
- RET = RETAIN
- B-B = BACK TO BACK
- = EXISTING GUARDRAIL
- = PROPOSED GUARDRAIL
- YL = YELLOW LINE
- WL = WHITE LINE
- = DELINEATOR
- ⋯⋯⋯ = UNDERDRAIN
- ⊙ = BORING

ROADWAY LAYOUT SHEET 12

PROJECT NAME: WEATHERSFIELD	PLOT DATE: 3/7/2013
PROJECT NUMBER: STP 2913(1)	DRAWN BY: WWG
FILE NAME: I0c228.dgn	CHECKED BY: PTS
PROJECT LEADER: PTS	SHEET 45 OF 234
DESIGNED BY: NLL	
IPARM FILE NAME: pI0c228_45	

NOT TO SCALE