


TEMPORARY 4" WHITE LINE, PAINT  
 DURABLE 4" WHITE LINE (OPTION BID ITEM)  
 262+50 TO 264+50 SOLID LT  
 262+50 TO 270+90 SOLID RT  
 265+30 TO 274+50 SOLID LT  
 271+70 TO 274+50 SOLID RT

TH 79 CURVE (1)  
 DELTA = 21° 18' 21"  
 D = 114° 35' 30"  
 R = 50.00'  
 T = 9.41'  
 L = 18.59'  
 E = 0.88'  
 BANK = NC

TEMPORARY 4" YELLOW LINE, PAINT  
 DURABLE 4" YELLOW LINE (OPTION BID ITEM)  
 262+50 TO 264+70 SOLID LT & RT  
 265+10 TO 271+10 SOLID LT & RT  
 271+23 TO 271+30 DOUBLE SOLID RT (TH 8)  
 271+50 TO 274+50 SOLID LT & RT

TEMPORARY 24" STOP BAR, PAINT  
 DURABLE 24" STOP BAR (OPTION BID ITEM)  
 271+31 TO 271+61 RT (TH 8)  
 TEMPORARY LETTER OR SYMBOL, PAINT  
 DURABLE LETTER OR SYMBOL (OPTION BID ITEM)  
 271+34 RT - "STOP" (TH 8)

RELOCATE MAILBOX, SINGLE SUPPORT  
 272+85 LT  
 REMOVING SIGNS  
 AS SHOWN - 3  
 ERECTING SALVAGED SIGNS  
 AS SHOWN - 3

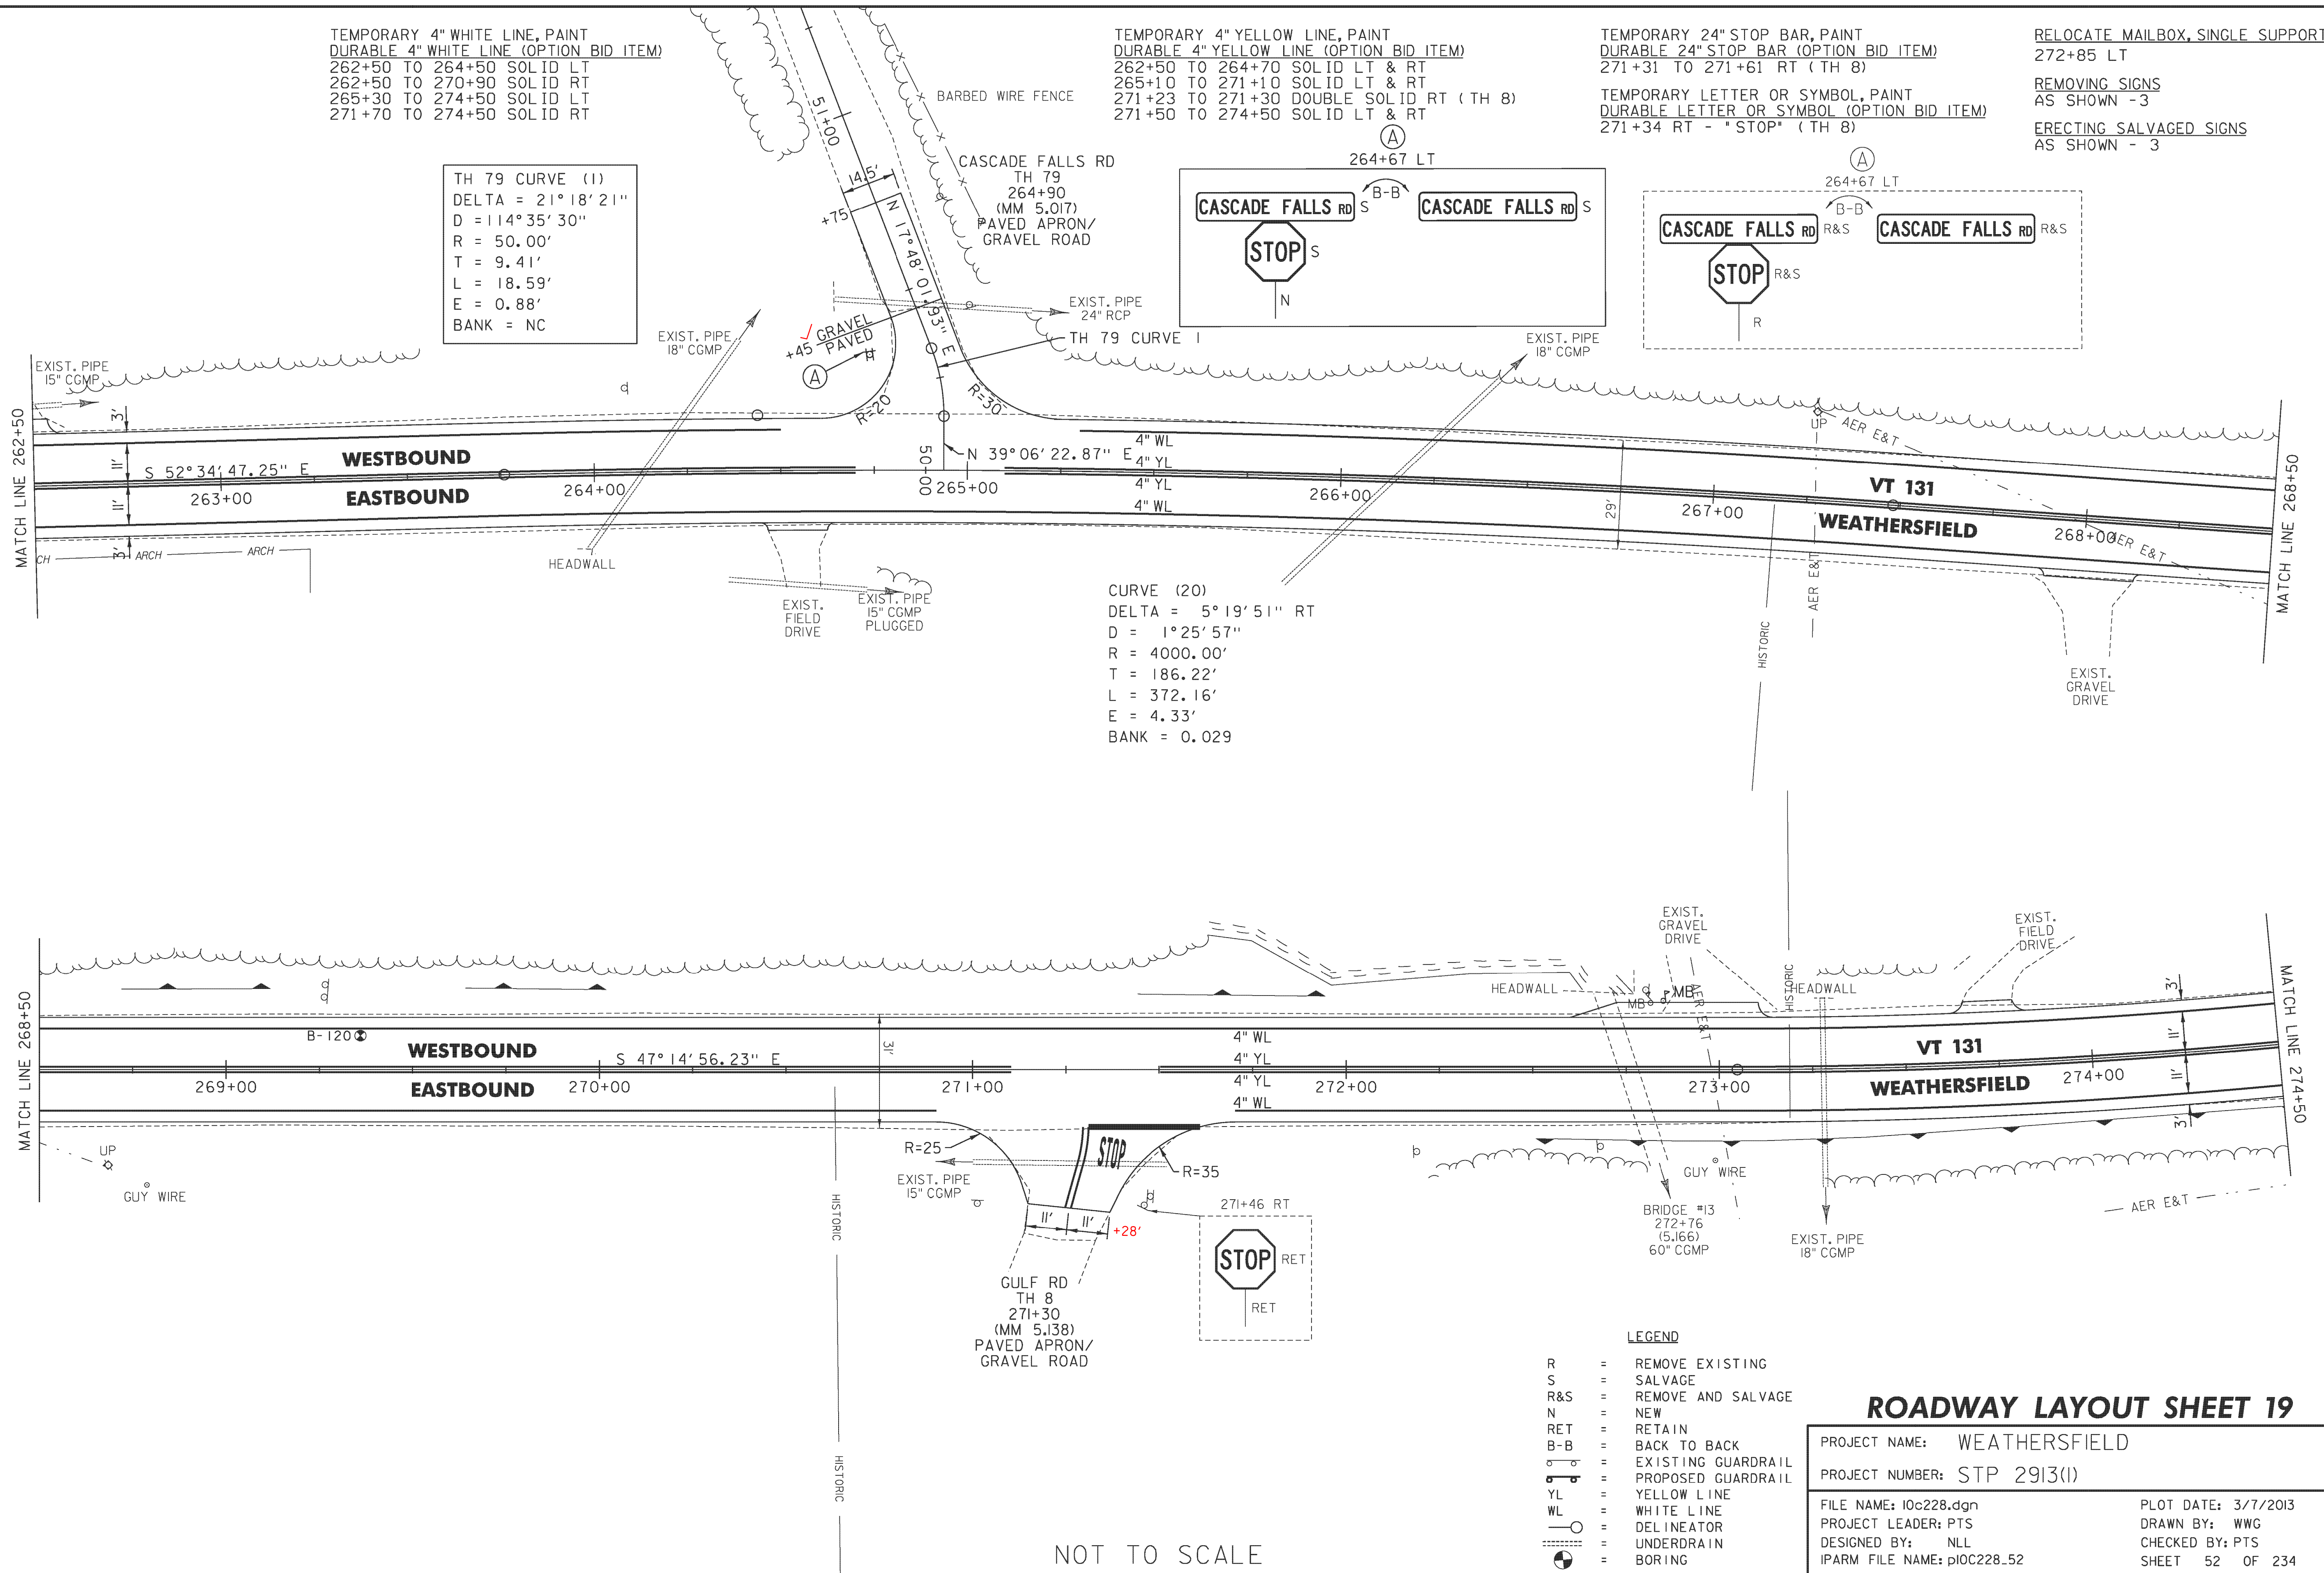

NOT TO SCALE

- LEGEND**
- R = REMOVE EXISTING
  - S = SALVAGE
  - R&S = REMOVE AND SALVAGE
  - N = NEW
  - RET = RETAIN
  - B-B = BACK TO BACK
  - = EXISTING GUARDRAIL
  - = PROPOSED GUARDRAIL
  - YL = YELLOW LINE
  - WL = WHITE LINE
  - = DELINEATOR
  - = UNDERDRAIN
  - = BORING

**ROADWAY LAYOUT SHEET 19**

|                             |                     |
|-----------------------------|---------------------|
| PROJECT NAME: WEATHERSFIELD | PLOT DATE: 3/7/2013 |
| PROJECT NUMBER: STP 2913(1) | DRAWN BY: WWG       |
| FILE NAME: I0c228.dgn       | CHECKED BY: PTS     |
| DESIGNED BY: NLL            | SHEET 52 OF 234     |
| IPARM FILE NAME: pI0c228.52 |                     |