

TEMPORARY 4" WHITE LINE, PAINT
 DURABLE 4" WHITE LINE (OPTION BID ITEM)
 379+50 TO 391+50 SOLID LT
 379+50 TO 391+50 SOLID RT

TEMPORARY 4" YELLOW LINE, PAINT
 DURABLE 4" YELLOW LINE (OPTION BID ITEM)
 379+50 TO 391+50 SOLID LT & RT

STONE FILL, TYPE I
 GEOTEXTILE UNDER STONE FILL
 379+50 TO 381+50 LT
 383+00 TO 385+50 RT
 386+50 TO 387+25 RT
 389+75 TO 391+50 RT

6 INCH UNDERDRAIN PIPE
 383+50 TO 385+30 LT
 390+25 TO 391+50 LT

STEEL BEAM GUARDRAIL, GALVANIZED
 W/8 FEET POSTS
 381+29.5 TO 385+54.5 RT
 388+93.5 TO 391+50 RT


ANCHOR FOR STEEL BEAM RAIL
 381+29.5 RT
 385+54.5 RT
 388+93.5 RT

REMOVAL AND DISPOSAL OF GUARDRAIL
 382+18 TO 385+55 RT
 389+18 TO 391+50 RT

DELINEATOR WITH STEEL POST
 381+29.5 RT
 385+54.5 RT
 388+93.5 RT


RELOCATE MAILBOX, SINGLE SUPPORT
 387+95 LT

CURVE (36)
 DELTA = 7°06'55" LT
 D = 2°12'13"
 R = 2600.00'
 T = 161.65'
 L = 322.88'
 E = 5.02'
 BANK = 0.041

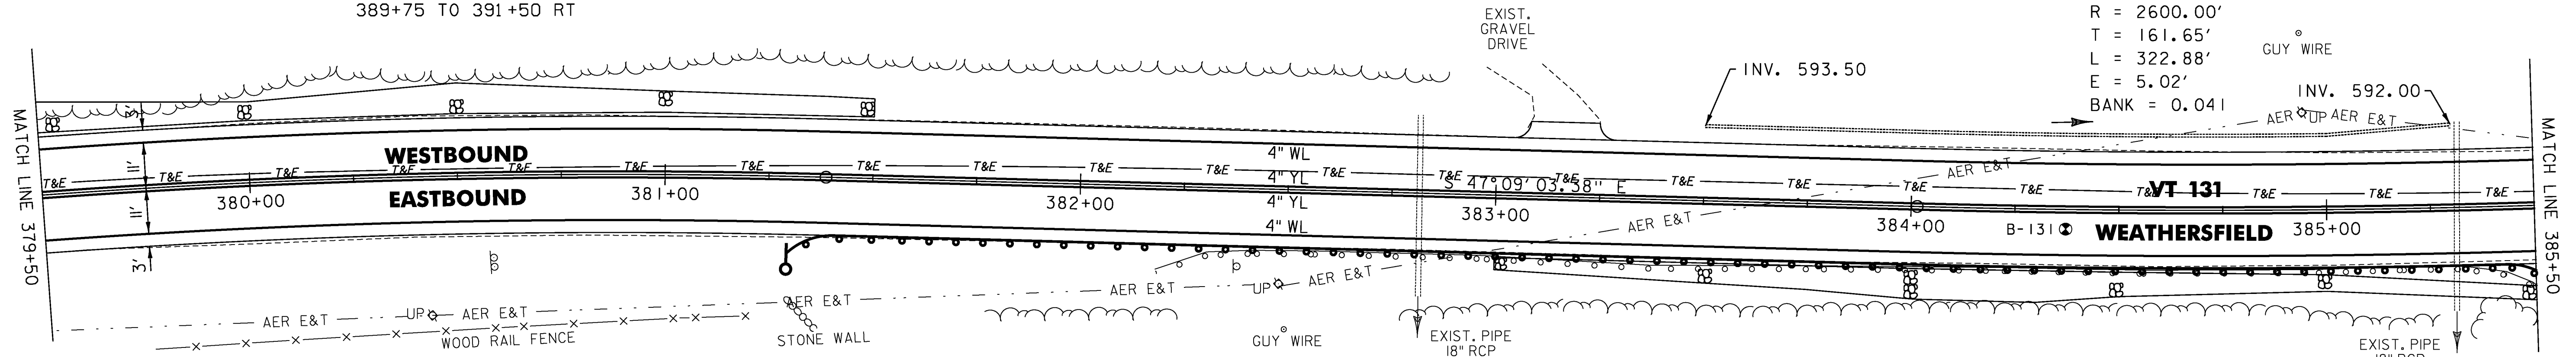

CURVE (35)
 DELTA = 10°40'34" RT
 D = 3°00'56"
 R = 1900.00'
 T = 177.53'
 L = 354.03'
 E = 8.28'
 BANK = 0.053

CURVE (37)
 DELTA = 13°29'42" LT
 D = 3°34'52"
 R = 1600.00'
 T = 189.30'
 L = 376.85'
 E = 11.16'
 BANK = 0.059

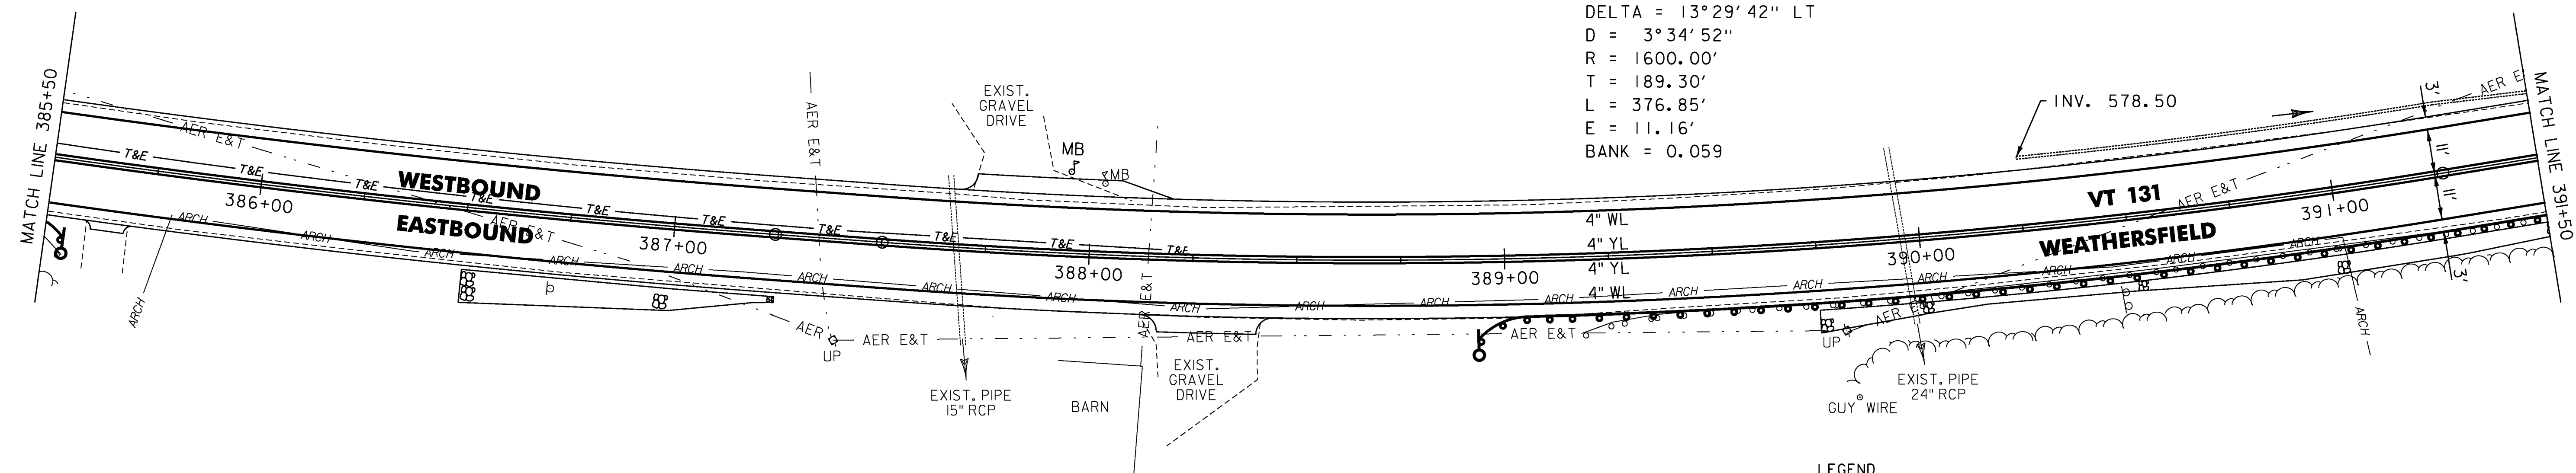

LEGEND

- R = REMOVE EXISTING
- S = SALVAGE
- R&S = REMOVE AND SALVAGE
- N = NEW
- RET = RETAIN
- B-B = BACK TO BACK
- = EXISTING GUARDRAIL
- = PROPOSED GUARDRAIL
- YL = YELLOW LINE
- WL = WHITE LINE
- = DELINEATOR
- = UNDERDRAIN
- = BORING

ROADWAY LAYOUT SHEET 29

PROJECT NAME: WEATHERSFIELD

PROJECT NUMBER: STP 2913(I)

FILE NAME: I0c228.dgn

PROJECT LEADER: PTS

DESIGNED BY: NLL

IPARM FILE NAME: pI0C228_62

PLOT DATE: 3/7/2013

DRAWN BY: WWG

CHECKED BY: PTS

SHEET 62 OF 234

NOT TO SCALE