

TEMPORARY 4" WHITE LINE, PAINT
 DURABLE 4" WHITE LINE (OPTION BID ITEM)
 403+50 TO 415+50 SOLID LT
 403+50 TO 404+30 SOLID RT (TH 46)
 404+30 TO 404+55 SOLID RT (TH 46)
 404+76 TO 405+01 SOLID RT
 405+01 TO 415+50 SOLID RT

TEMPORARY 4" YELLOW LINE, PAINT
 DURABLE 4" YELLOW LINE (OPTION BID ITEM)
 403+50 TO 404+45 SOLID LT & RT
 404+65 DOUBLE SOLID RT (TH 46) (20' LONG)
 404+85 TO 415+50 SOLID LT & RT

TEMPORARY 24" STOP BAR, PAINT
 DURABLE 24" STOP BAR (OPTION BID ITEM)
 404+66 TO 404+84 RT (TH 46)



TEMPORARY LETTER OR SYMBOL, PAINT
 DURABLE LETTER OR SYMBOL (OPTION BID ITEM)
 404+72 RT - "STOP" (TH 46)

REHAB DROP INLETS, CATCH BASINS,
 OR MANHOLES, CLASS II
 410+45 LT

REMOVAL AND DISPOSAL OF GUIDE POSTS
 411+32 RT (1)
 412+49 RT (1)

REMOVING SIGNS
 AS SHOWN - 2
 ERECTING SALVAGED SIGNS
 AS SHOWN - 2

CURVE (41)
 DELTA = 20°30'29" LT
 D = 6°21'58"
 R = 900.00'
 T = 162.81'
 L = 322.14'
 E = 14.61'
 BANK = 0.062

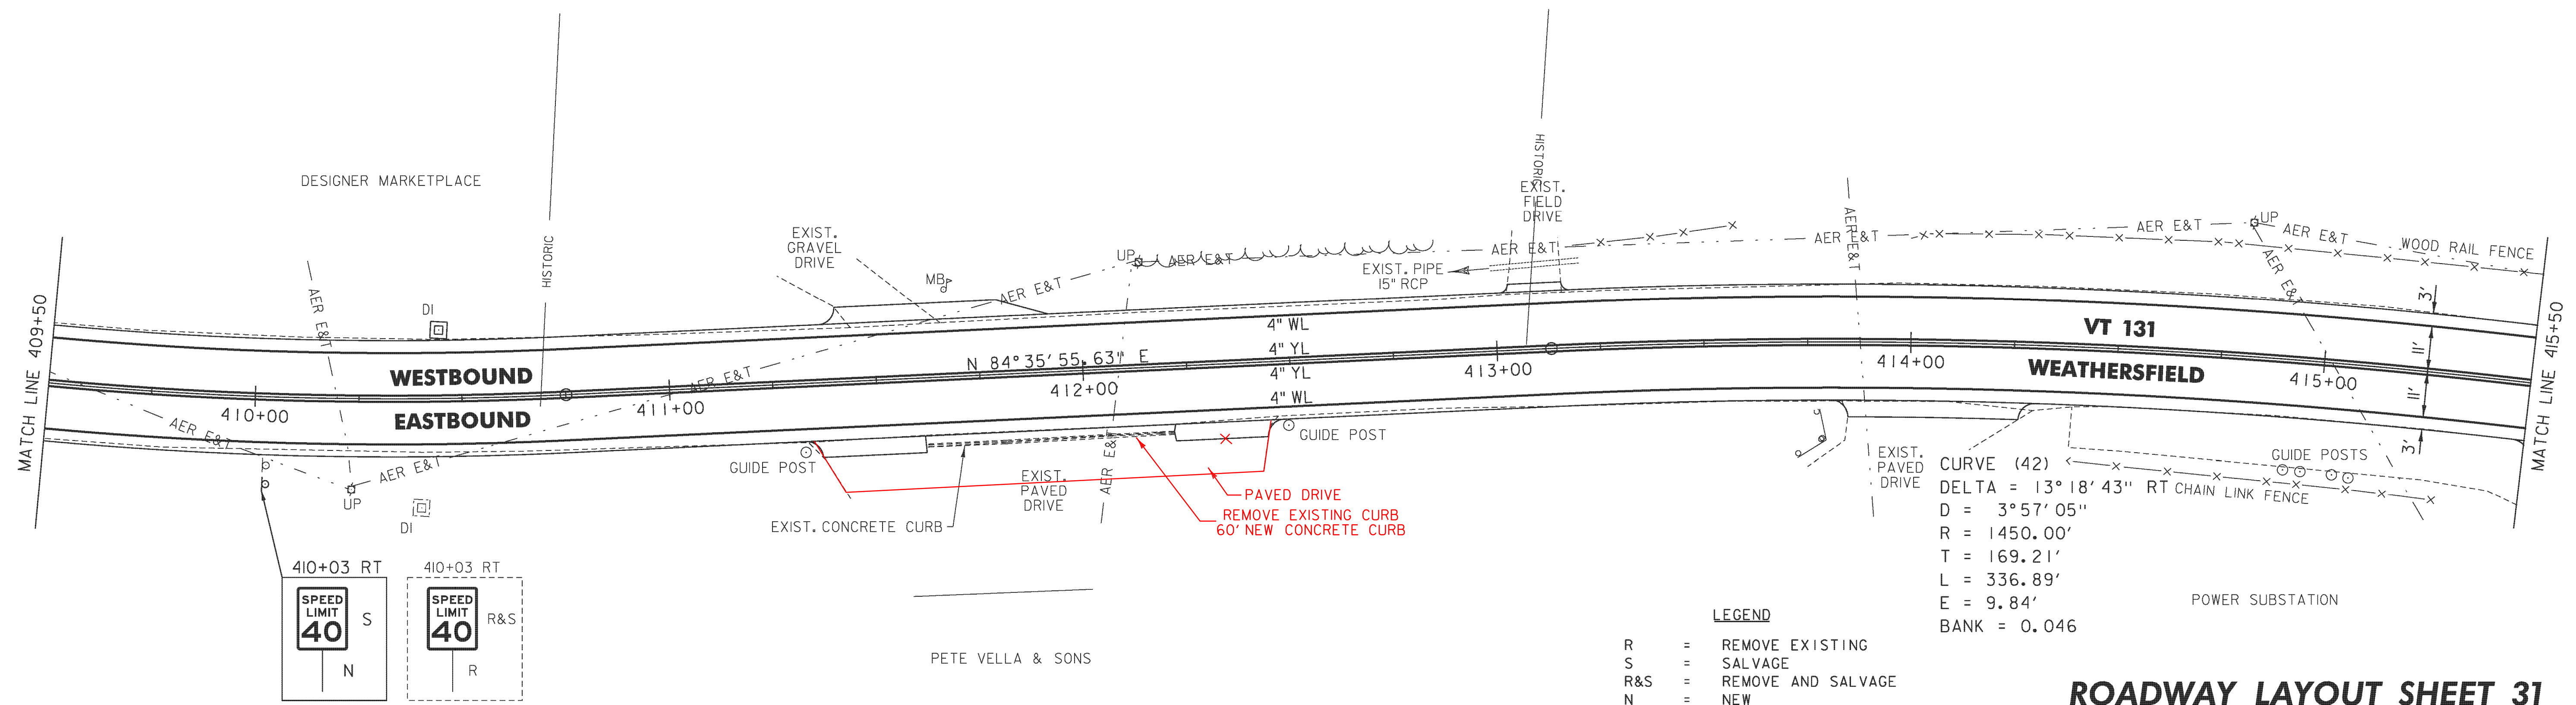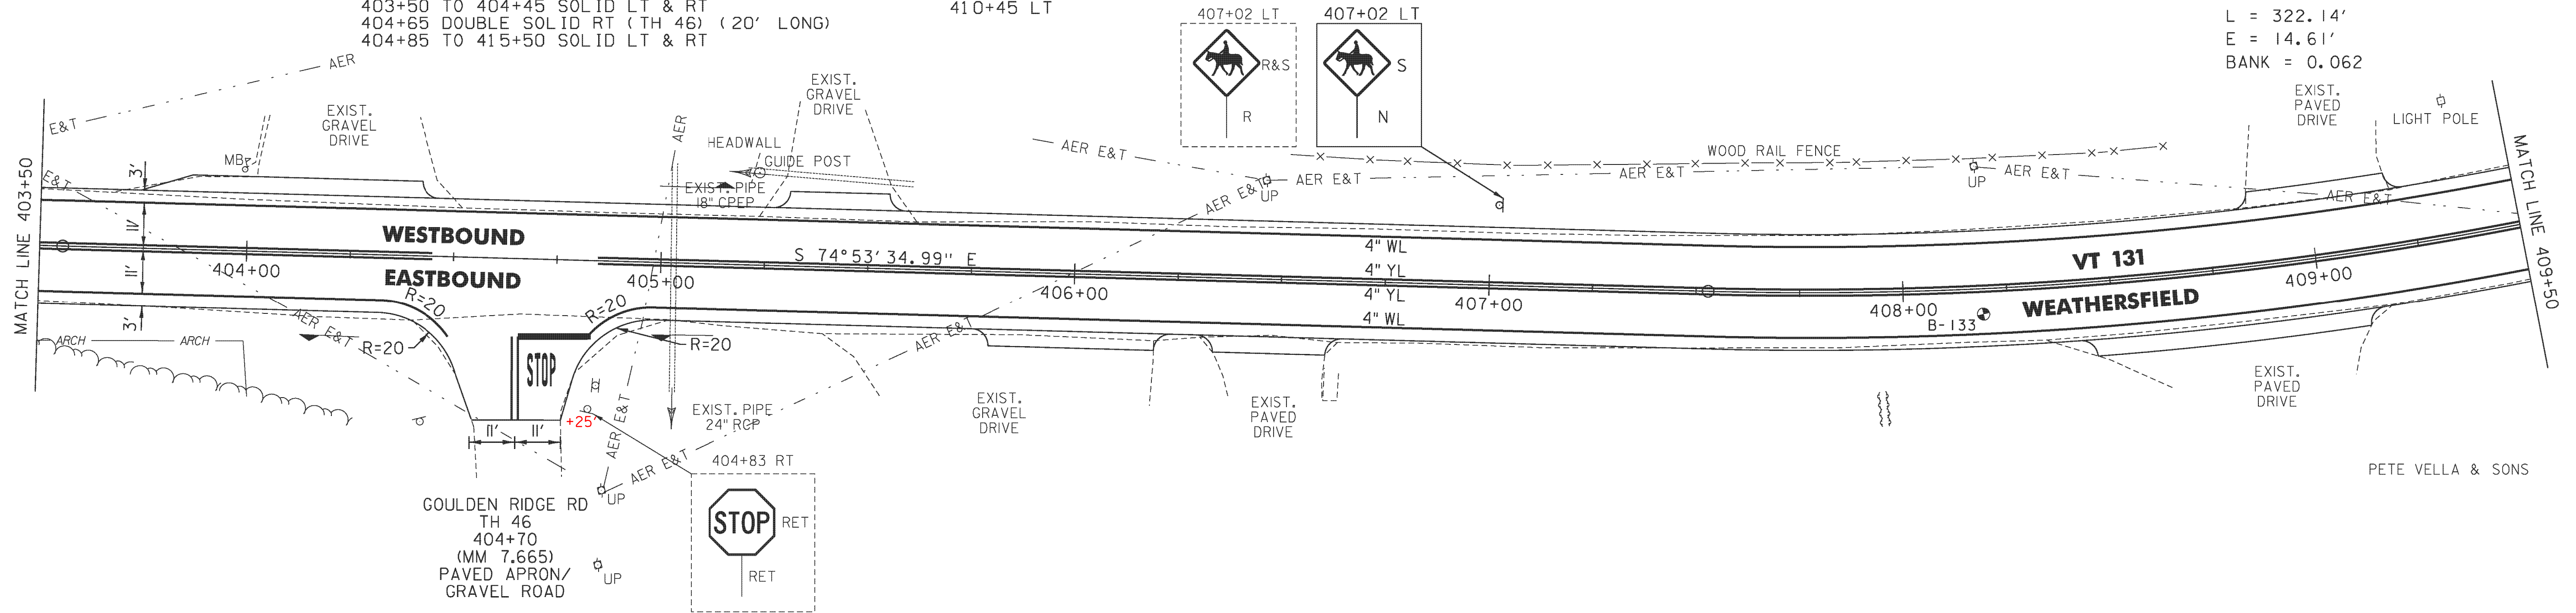

- LEGEND**
- R = REMOVE EXISTING
 - S = SALVAGE
 - R&S = REMOVE AND SALVAGE
 - N = NEW
 - RET = RETAIN
 - B-B = BACK TO BACK
 - = EXISTING GUARDRAIL
 - ⊕ = PROPOSED GUARDRAIL
 - YL = YELLOW LINE
 - WL = WHITE LINE
 - = DELINEATOR
 - ⋯ = UNDERDRAIN
 - ⊙ = BORING

ROADWAY LAYOUT SHEET 31

| | |
|-----------------------------|---------------------|
| PROJECT NAME: WEATHERSFIELD | PLOT DATE: 3/7/2013 |
| PROJECT NUMBER: STP 2913(1) | DRAWN BY: WWG |
| FILE NAME: I0c228.dgn | CHECKED BY: PTS |
| PROJECT LEADER: PTS | SHEET 64 OF 234 |
| DESIGNED BY: NLL | |
| IPARM FILE NAME: pI0c228.64 | |

NOT TO SCALE