


CURVE 1 - WEATHERSFIELD

CURVE 2 - WEATHERSFIELD

CURVE 3 - WEATHERSFIELD

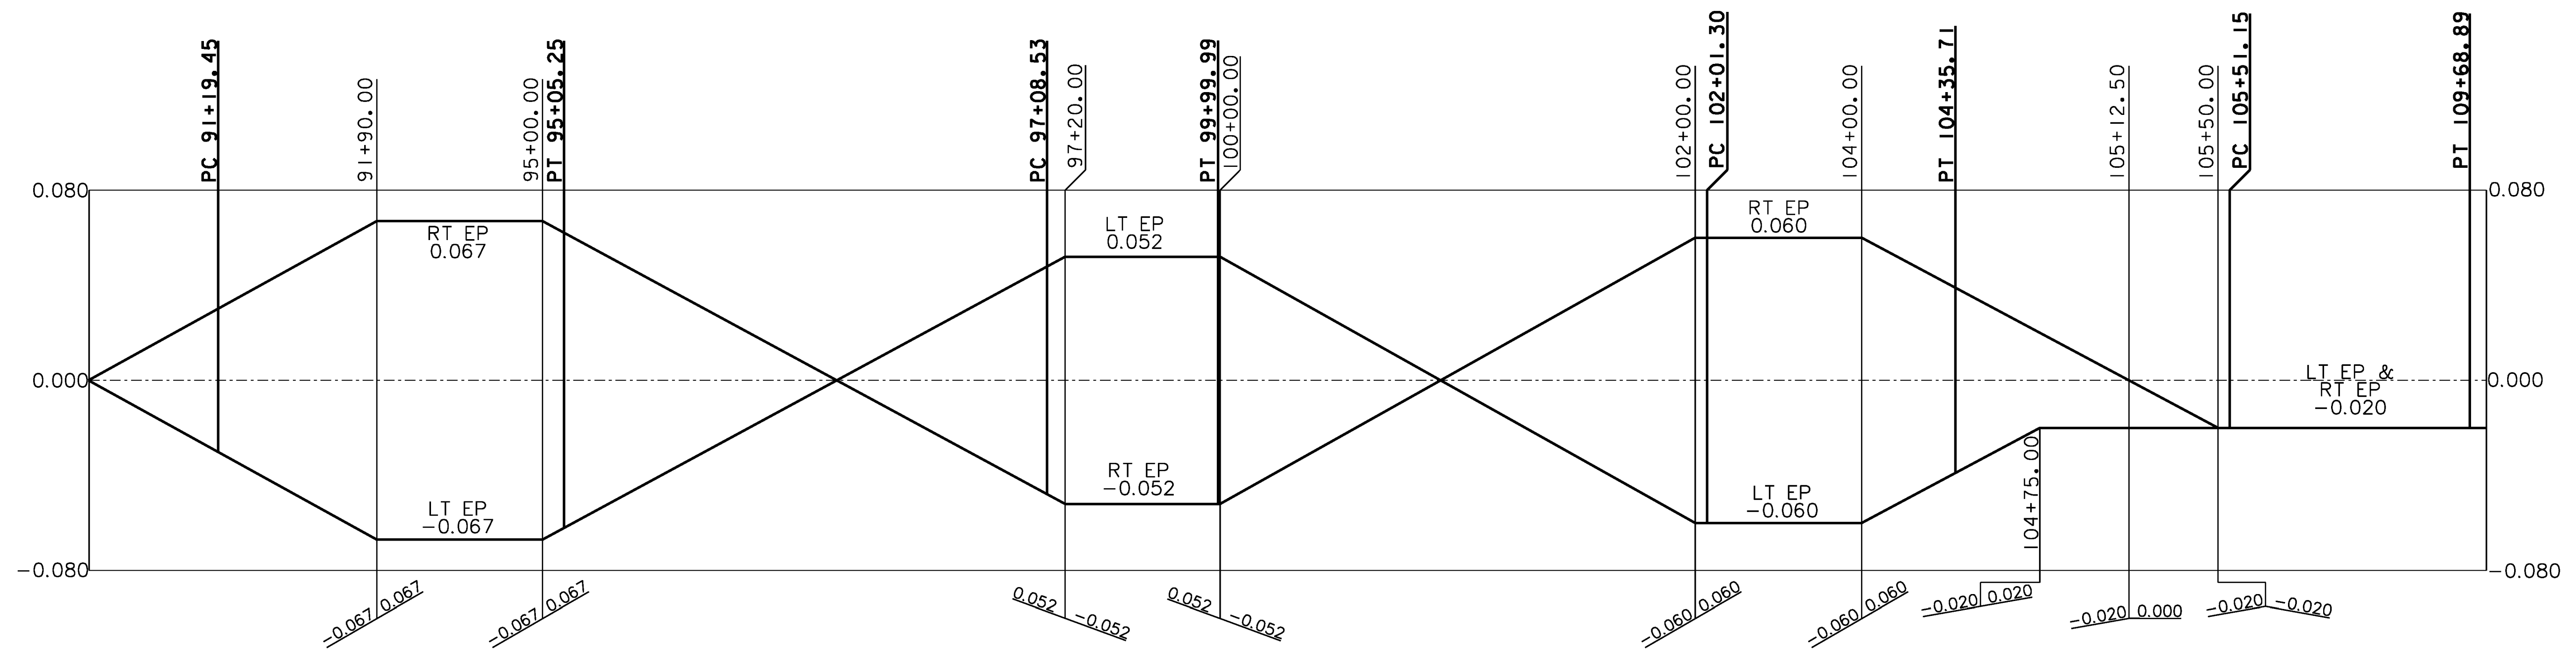

CURVE 4 - WEATHERSFIELD

CURVE 5 - WEATHERSFIELD

CURVE 6 - WEATHERSFIELD

CURVE 7 - WEATHERSFIELD

BANKING DIAGRAM 1

PROJECT NAME: WEATHERSFIELD	PLOT DATE: 2/7/2013
PROJECT NUMBER: STP 2913(1)	DRAWN BY: JLS
FILE NAME: I0c228.dgn	CHECKED BY: PTS
PROJECT LEADER: PTS	SHEET 69 OF 234
DESIGNED BY: NULL	
IPARM FILE NAME: pi0c228_69	