


CURVE 8 - WEATHERSFIELD

CURVE 9 - WEATHERSFIELD

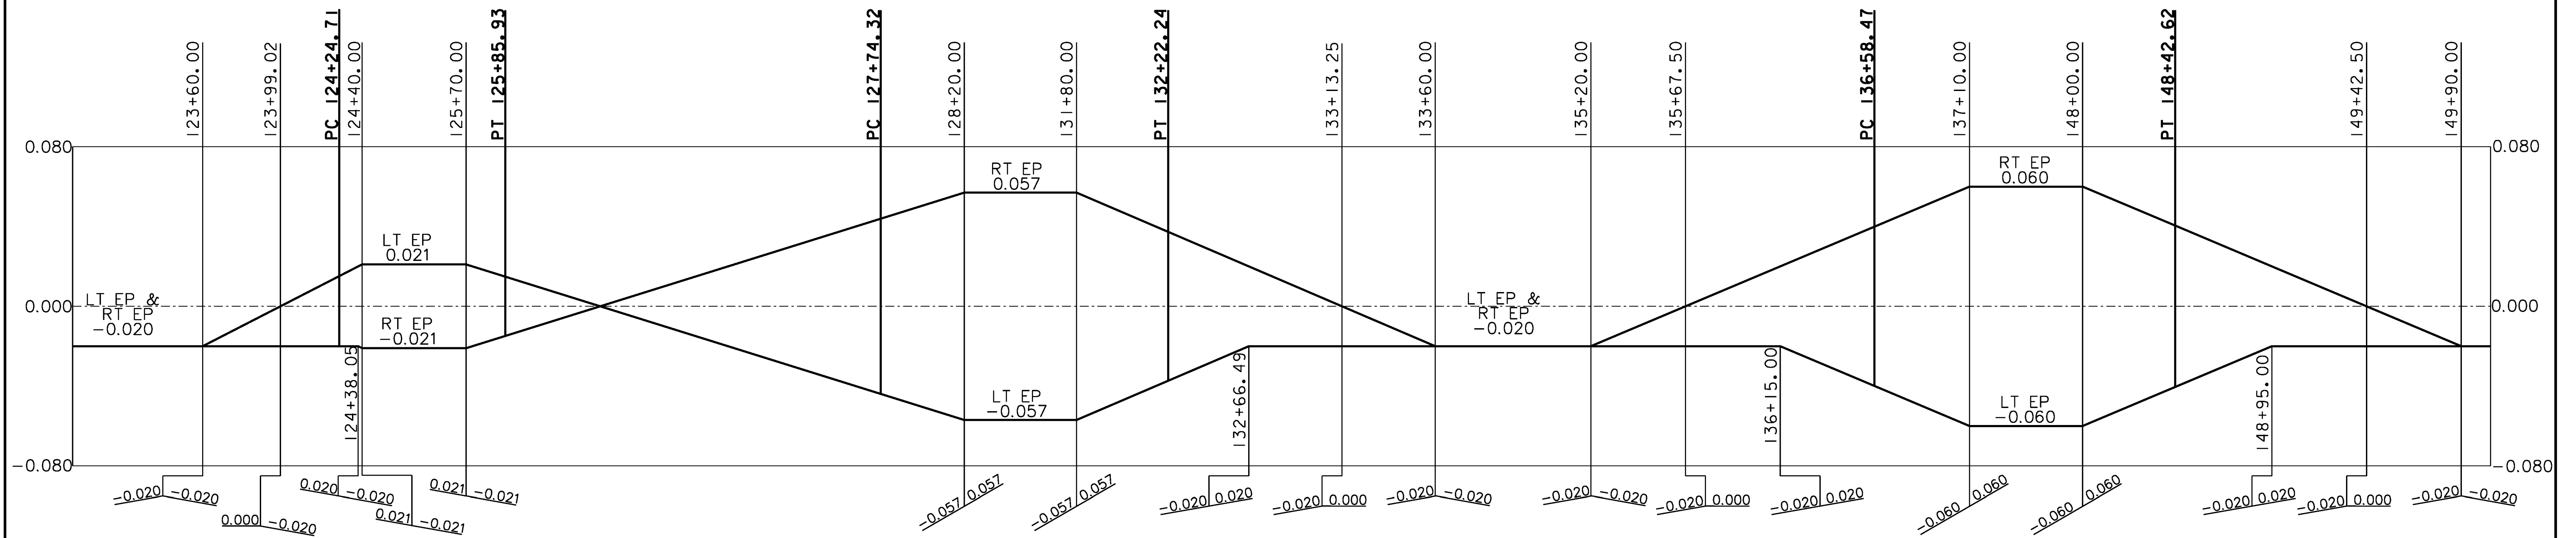

CURVE 10 - WEATHERSFIELD

CURVE 11 - WEATHERSFIELD

CURVE 12 - WEATHERSFIELD

BANKING DIAGRAM 2

PROJECT NAME: WEATHERSFIELD	
PROJECT NUMBER: STP 2913(I)	
FILE NAME: I0c228.dgn	PLOT DATE: 2/7/2013
PROJECT LEADER: PTS	DRAWN BY: JLS
DESIGNED BY: NULL	CHECKED BY: PTS
IPARM FILE NAME: pi0c228_70	SHEET 70 OF 234