




TH 94

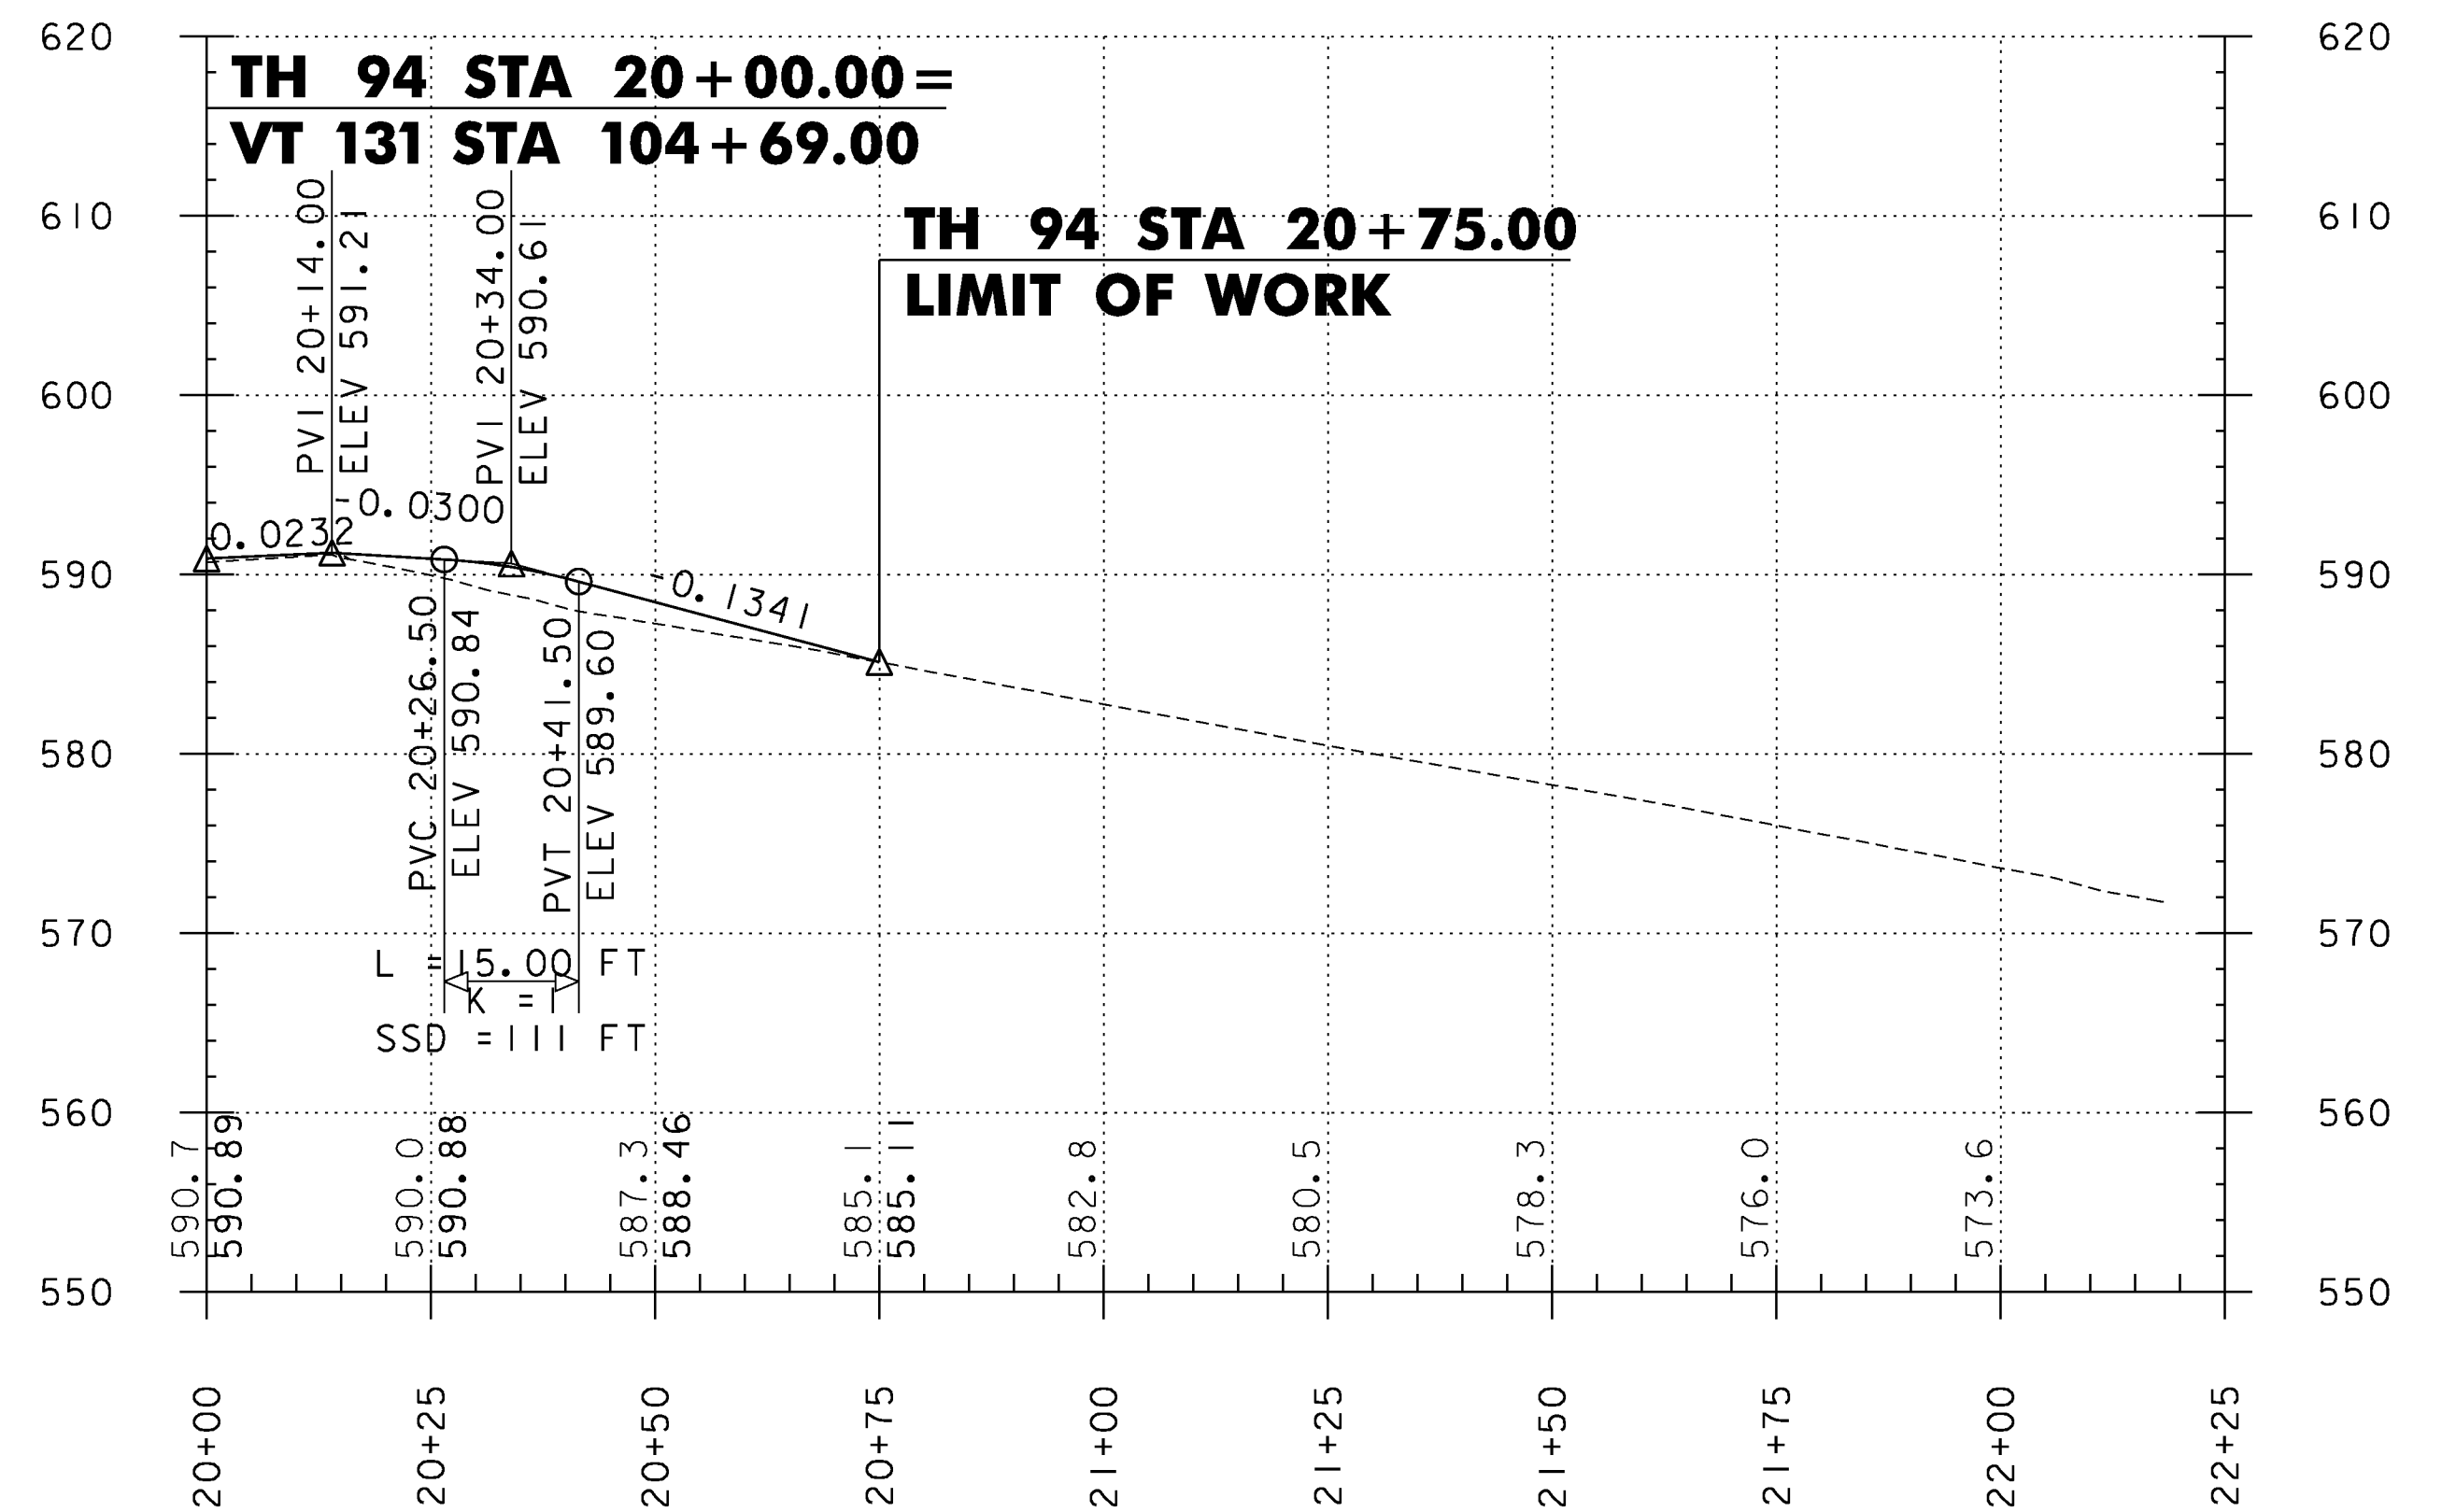

TH 94

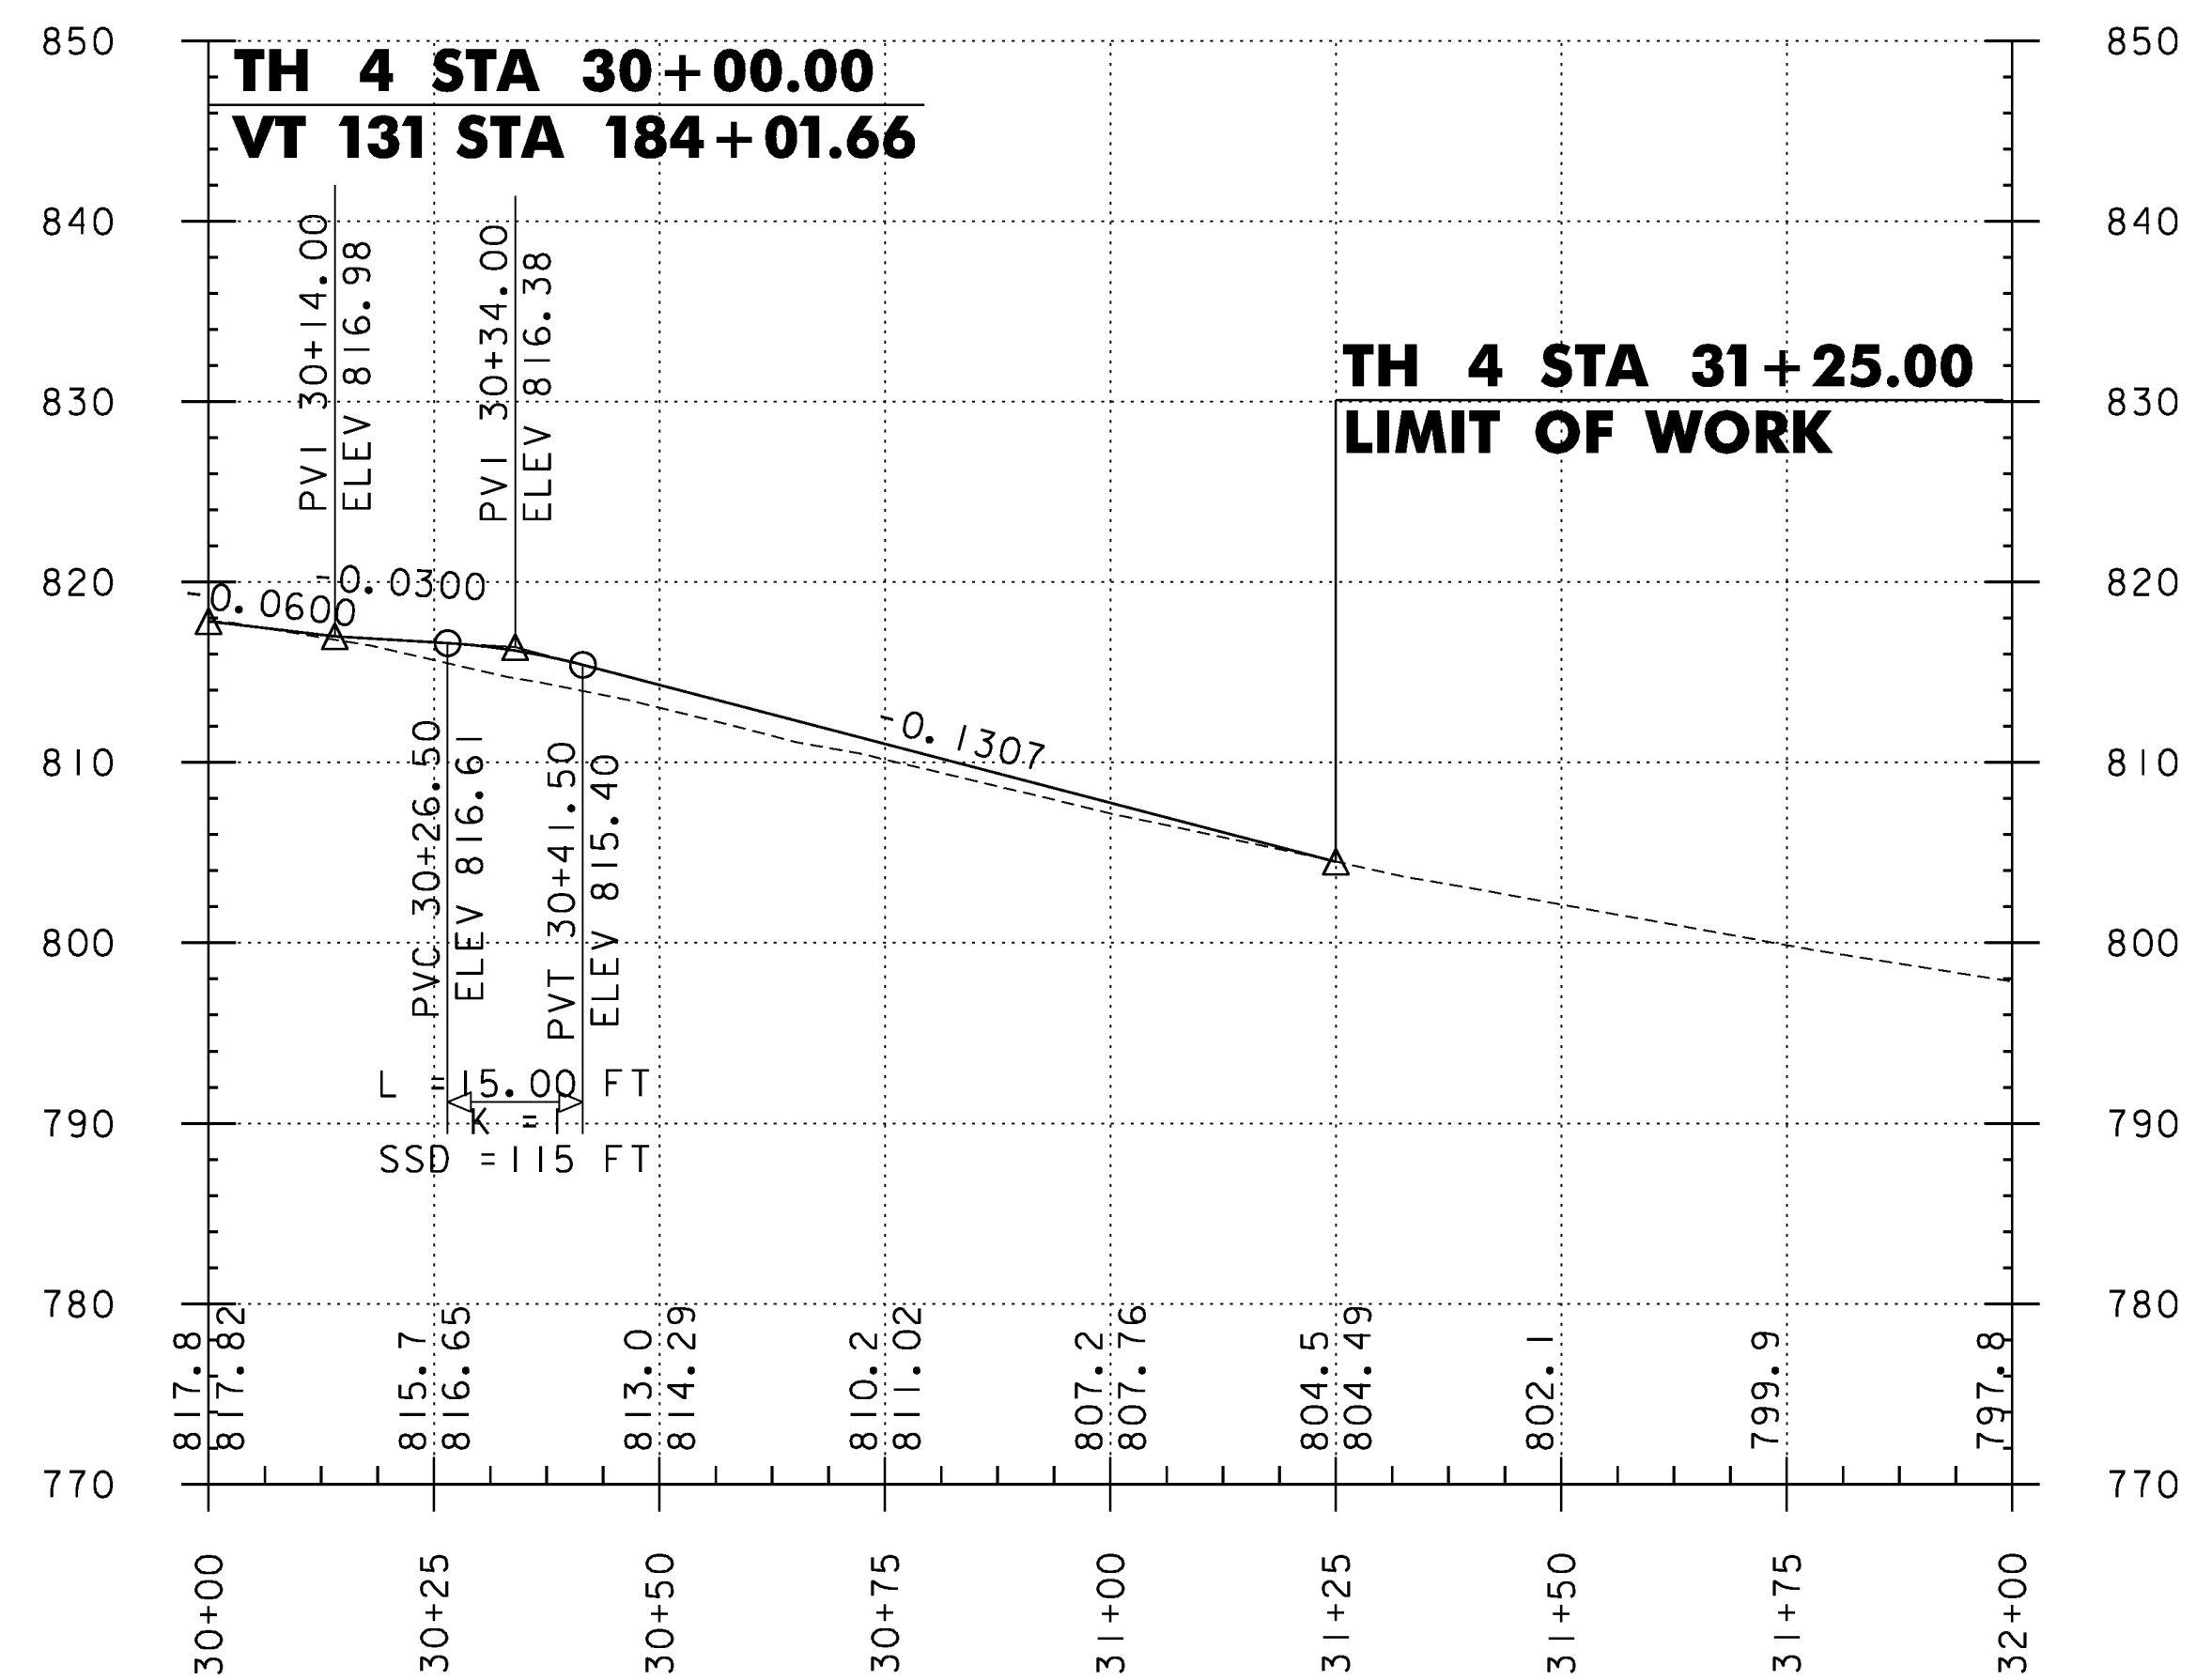

TH 4

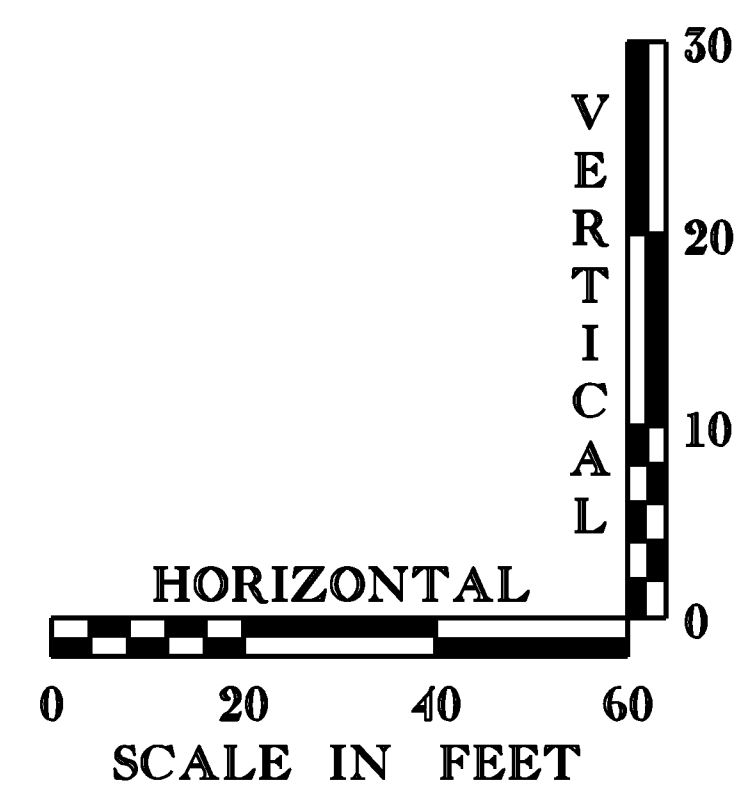

TOWN HIGHWAY PROFILES 1

PROJECT NAME: WEATHERSFIELD
 PROJECT NUMBER: STP 2913(I)
 FILE NAME: I0c228.dgn
 PROJECT LEADER: PTS
 DESIGNED BY: JLS
 IPARM FILE NAME: pI0C228_89
 PLOT DATE: 2/7/2013
 DRAWN BY: JLS
 CHECKED BY: PTS
 SHEET 89 OF 234