




87+00

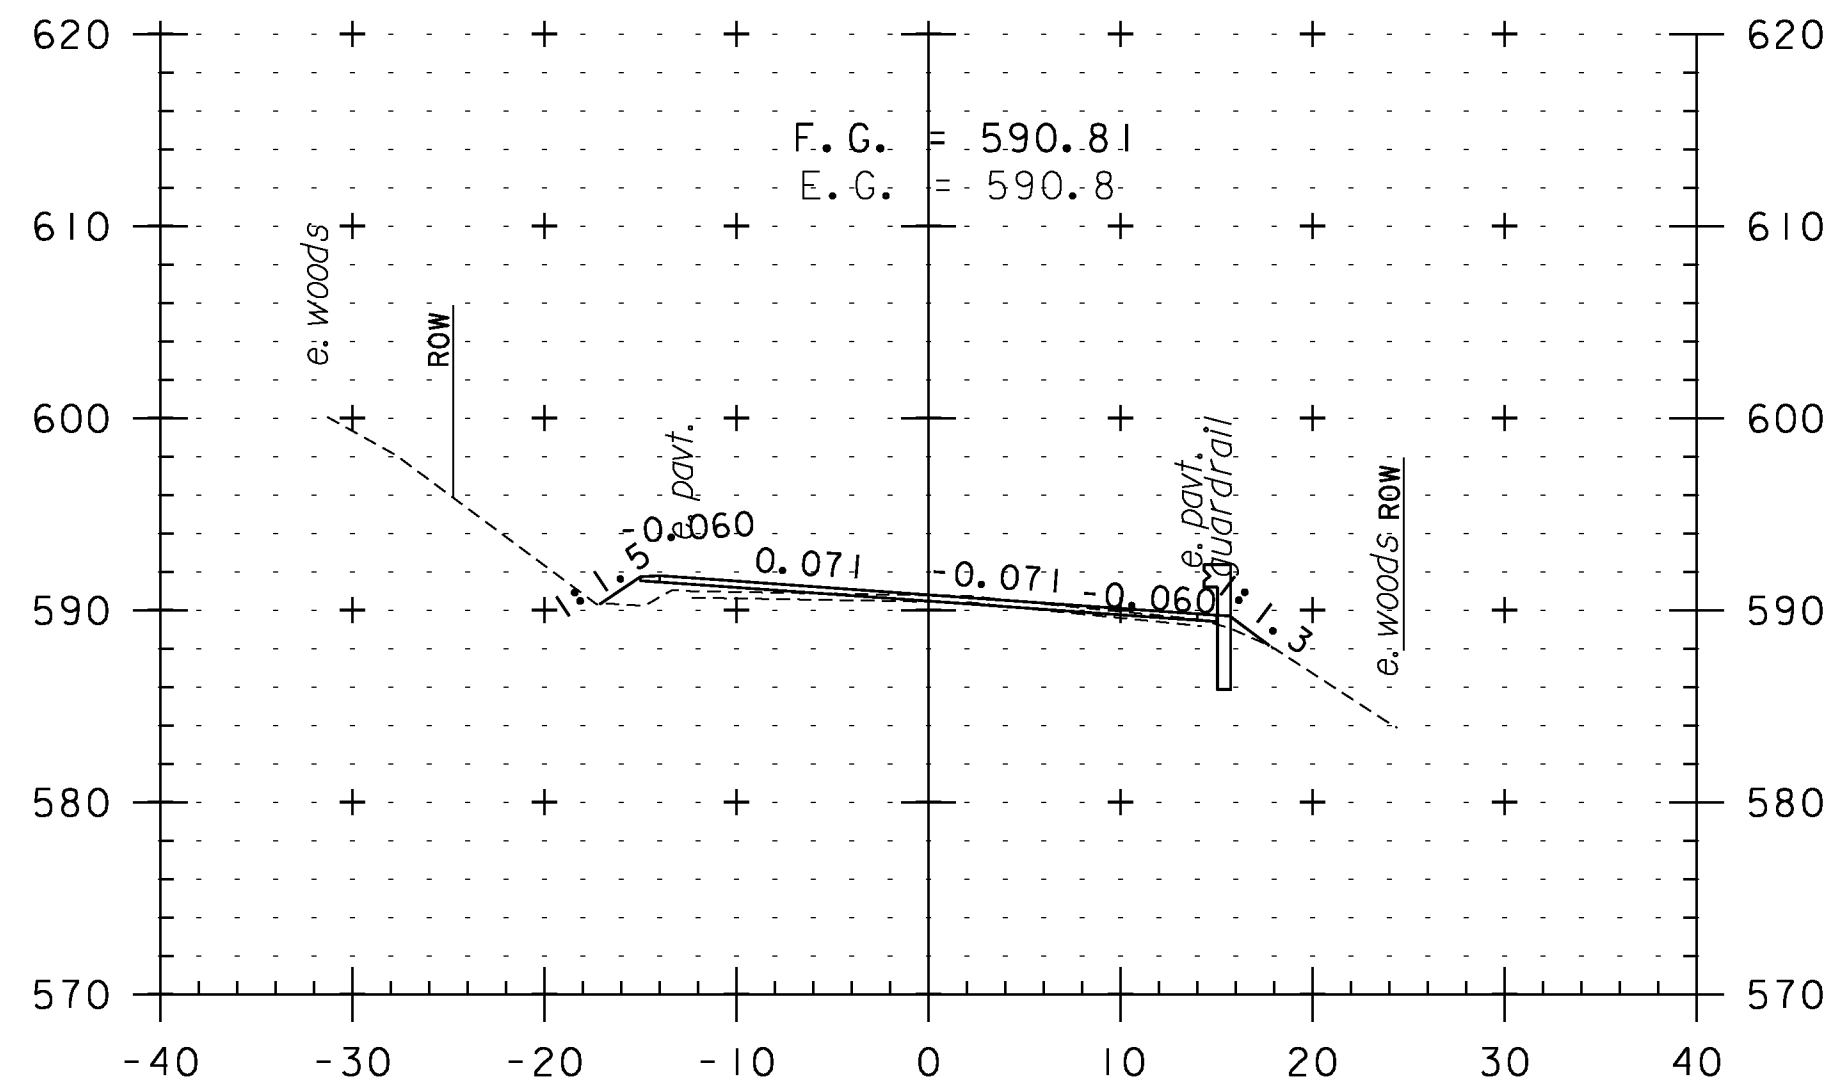


88+00

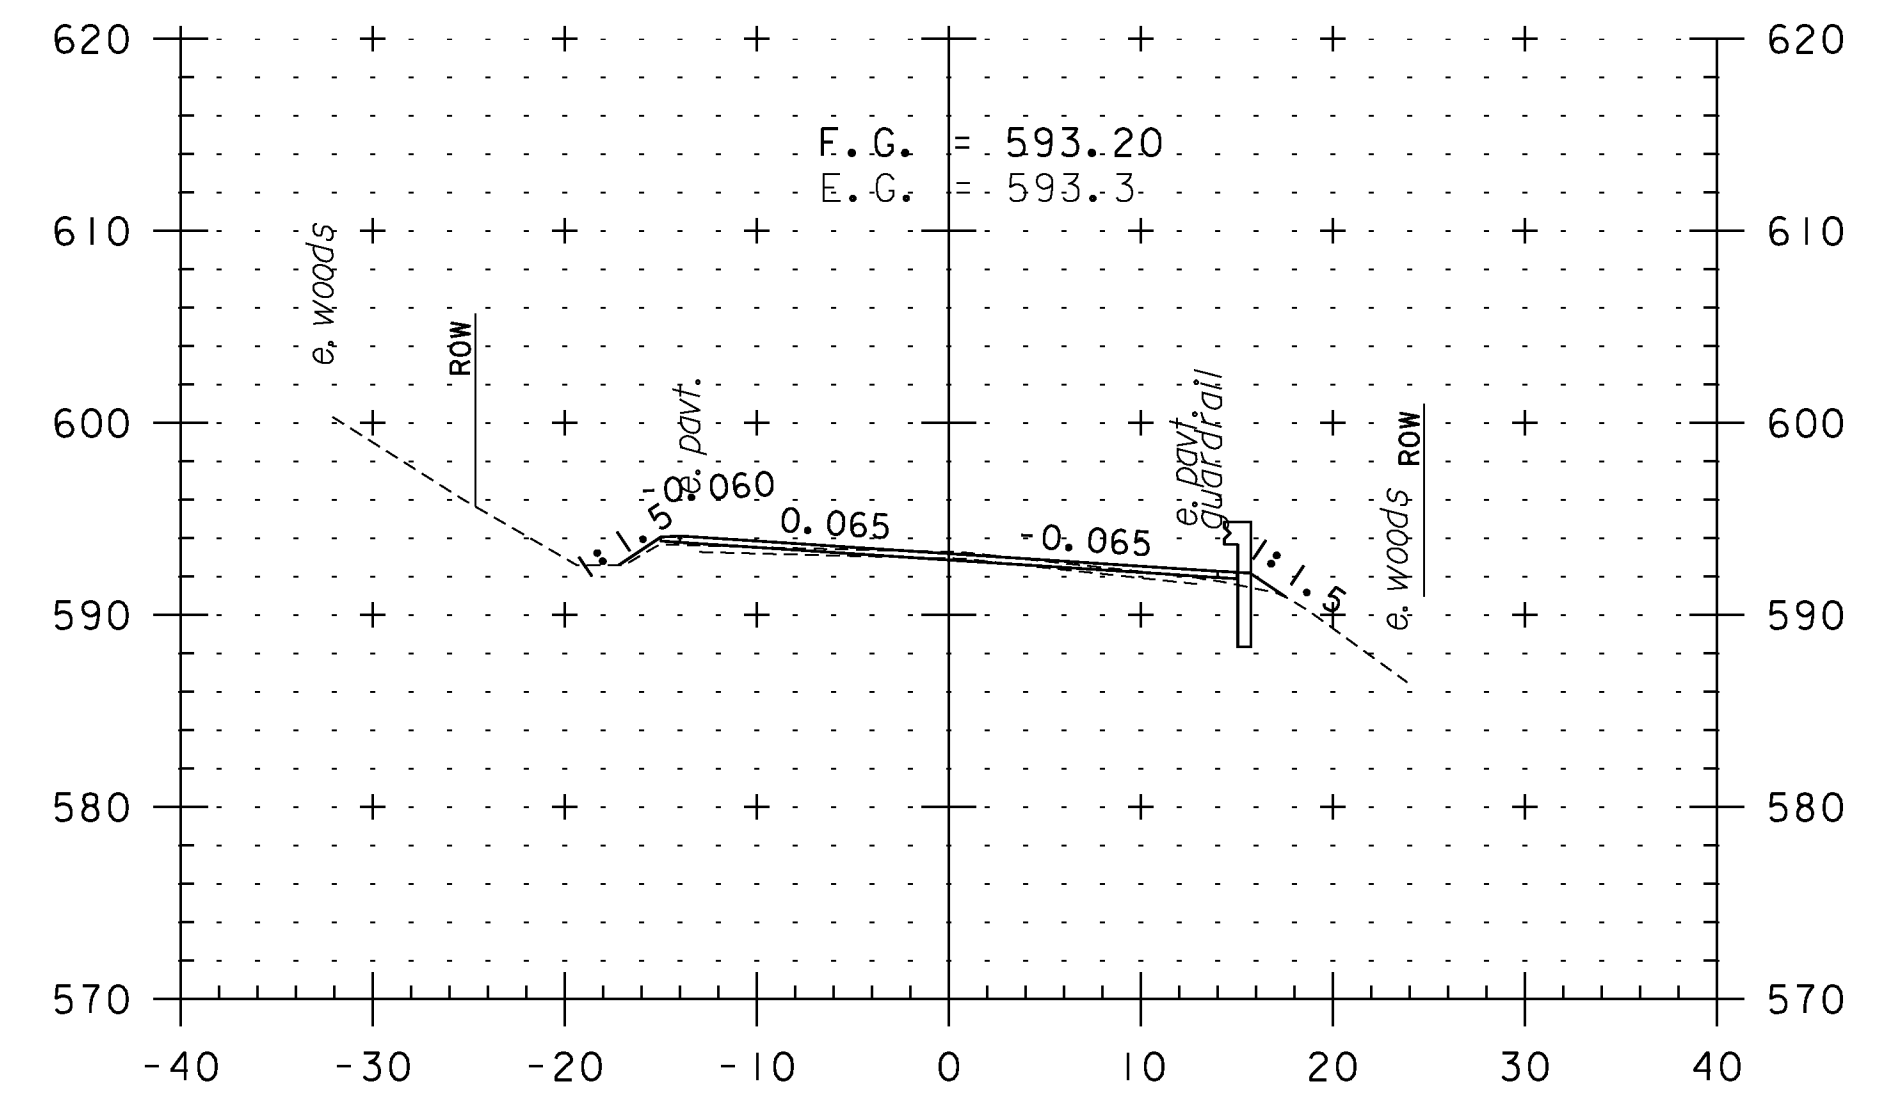


89+50

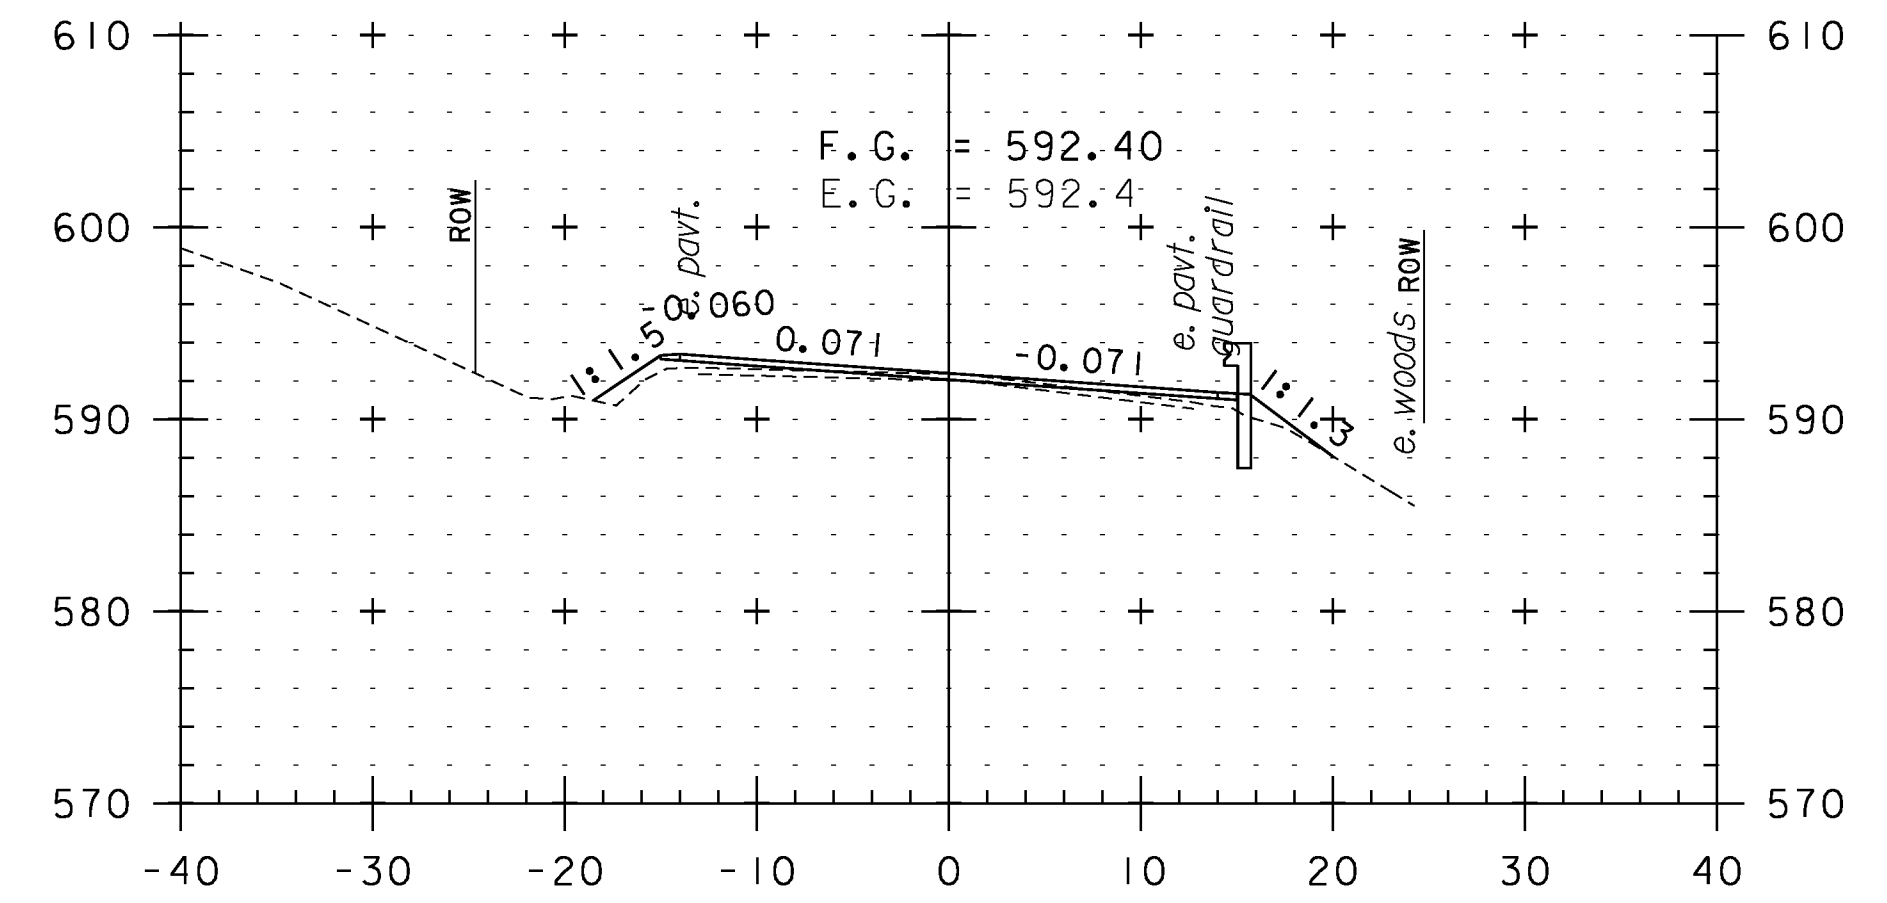


89+00

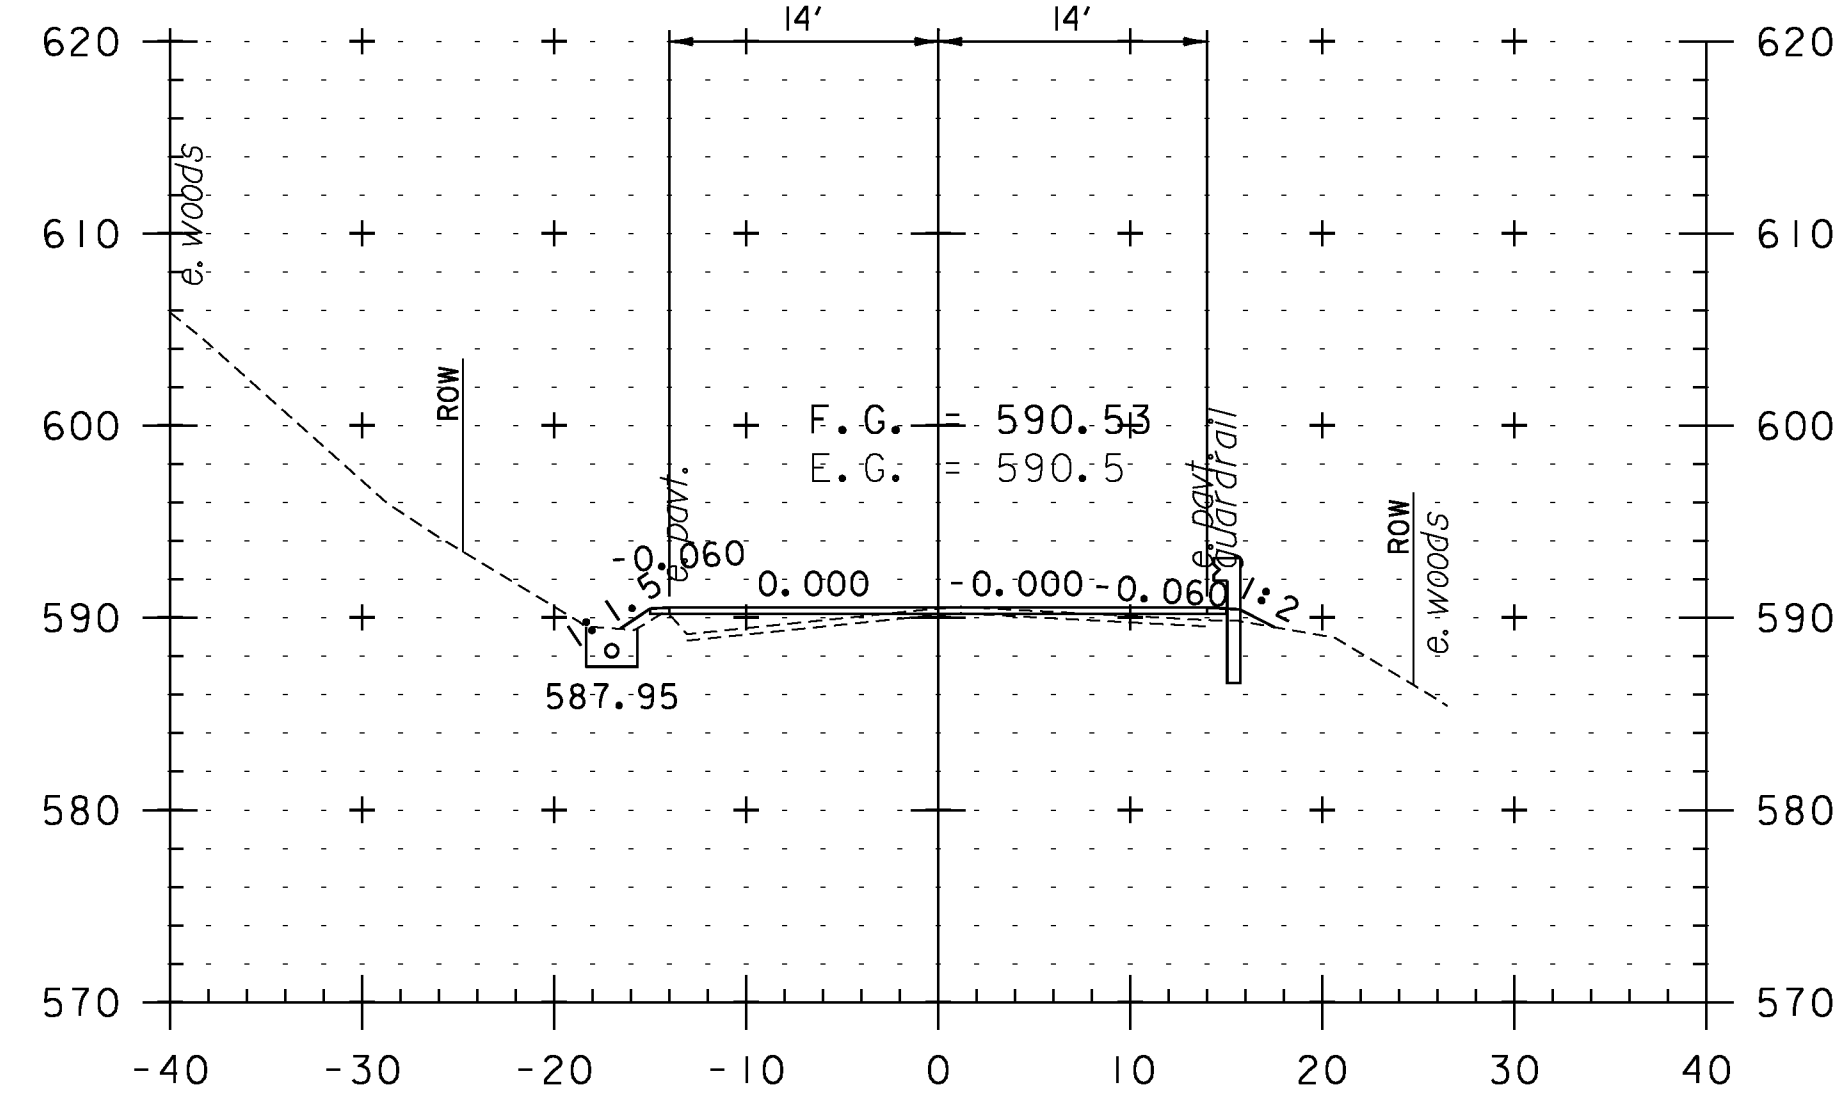

86+50

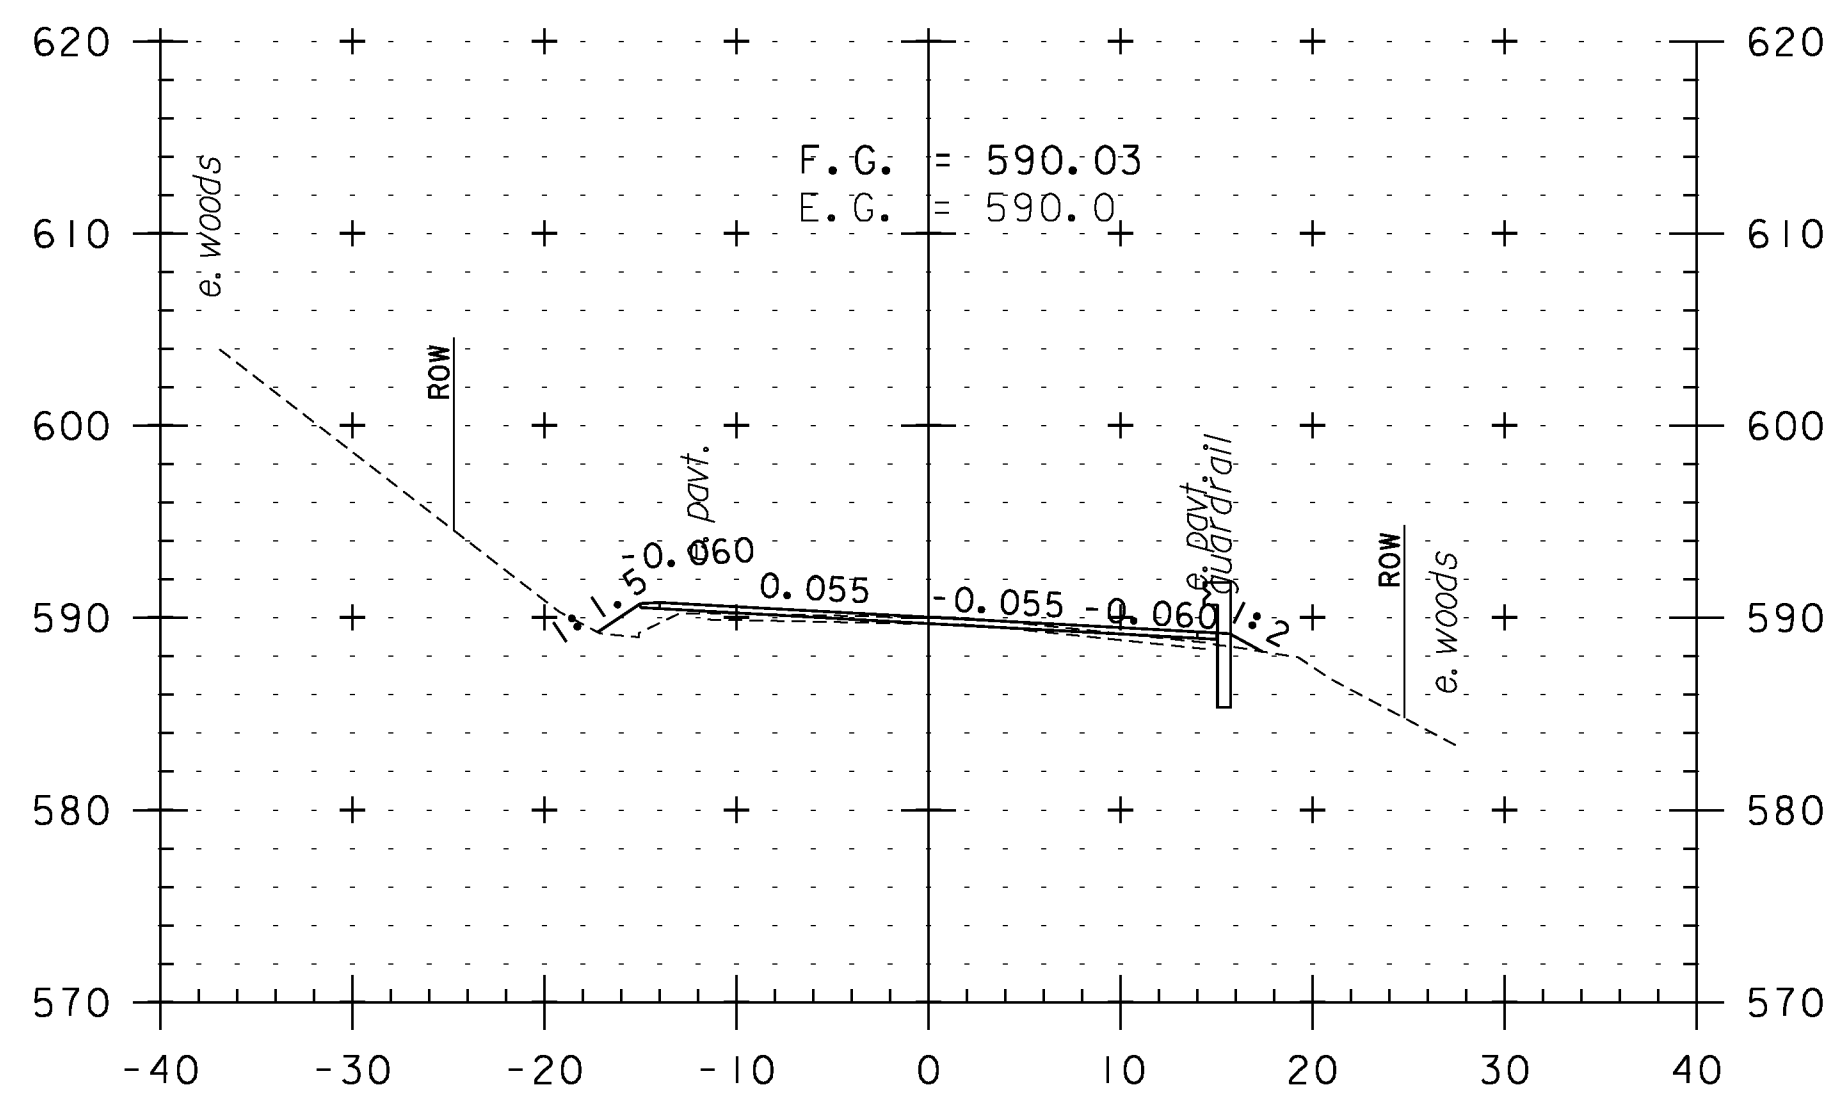

87+50

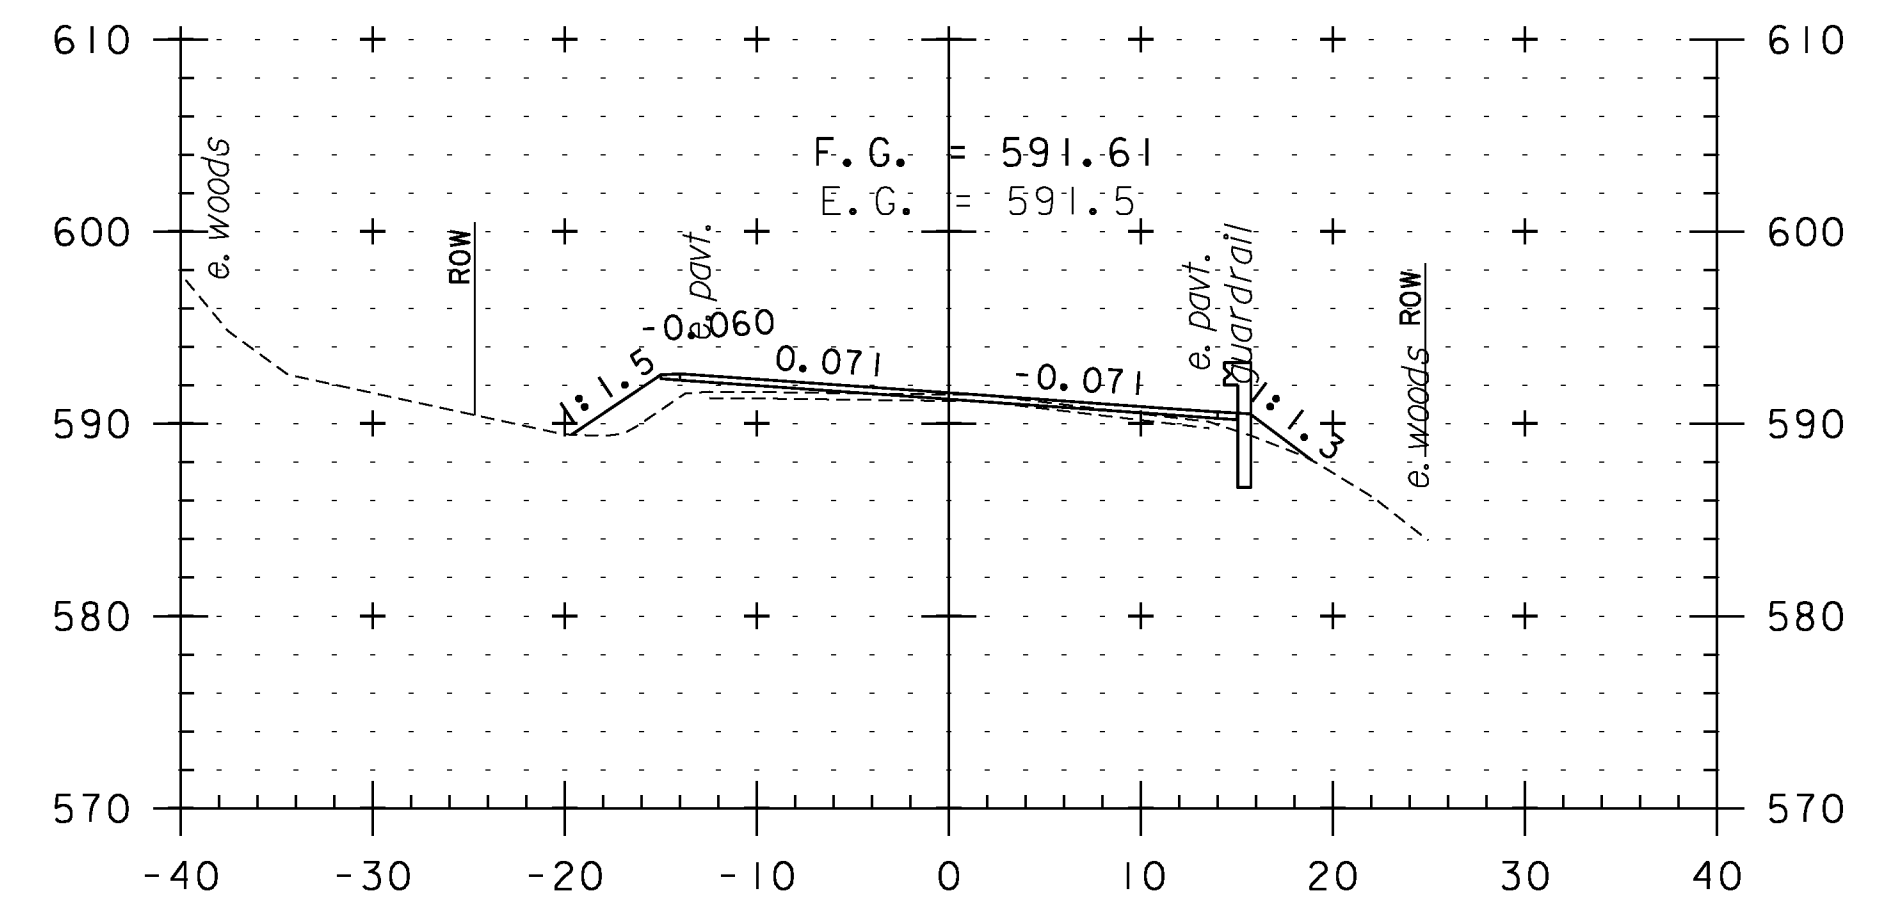

88+50

CROSS SECTION SHEET 5

PROJECT NAME: WEATHERSFIELD

PROJECT NUMBER: STP 2913(I)

FILE NAME: I0c228

PROJECT LEADER: PTS

DESIGNED BY: NLL

IPARM FILE NAME: pI0c228_95

PLOT DATE: 2/7/2013

DRAWN BY: WWG

CHECKED BY: PTS

SHEET 95 OF 234



STA. 86+50 TO STA. 89+50