




107+00  
BRIDGE 10

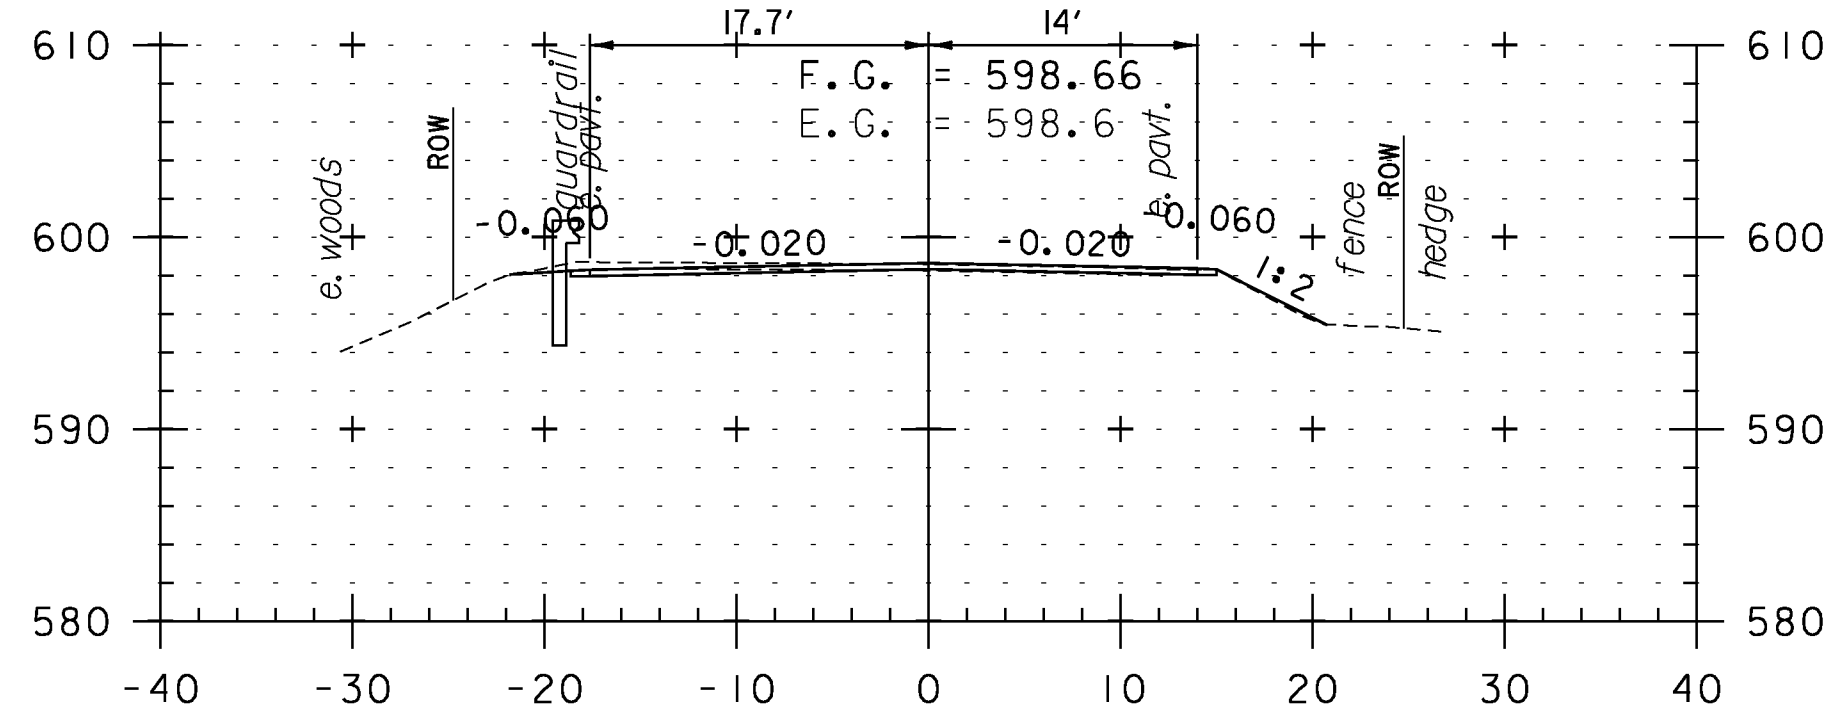


108+00

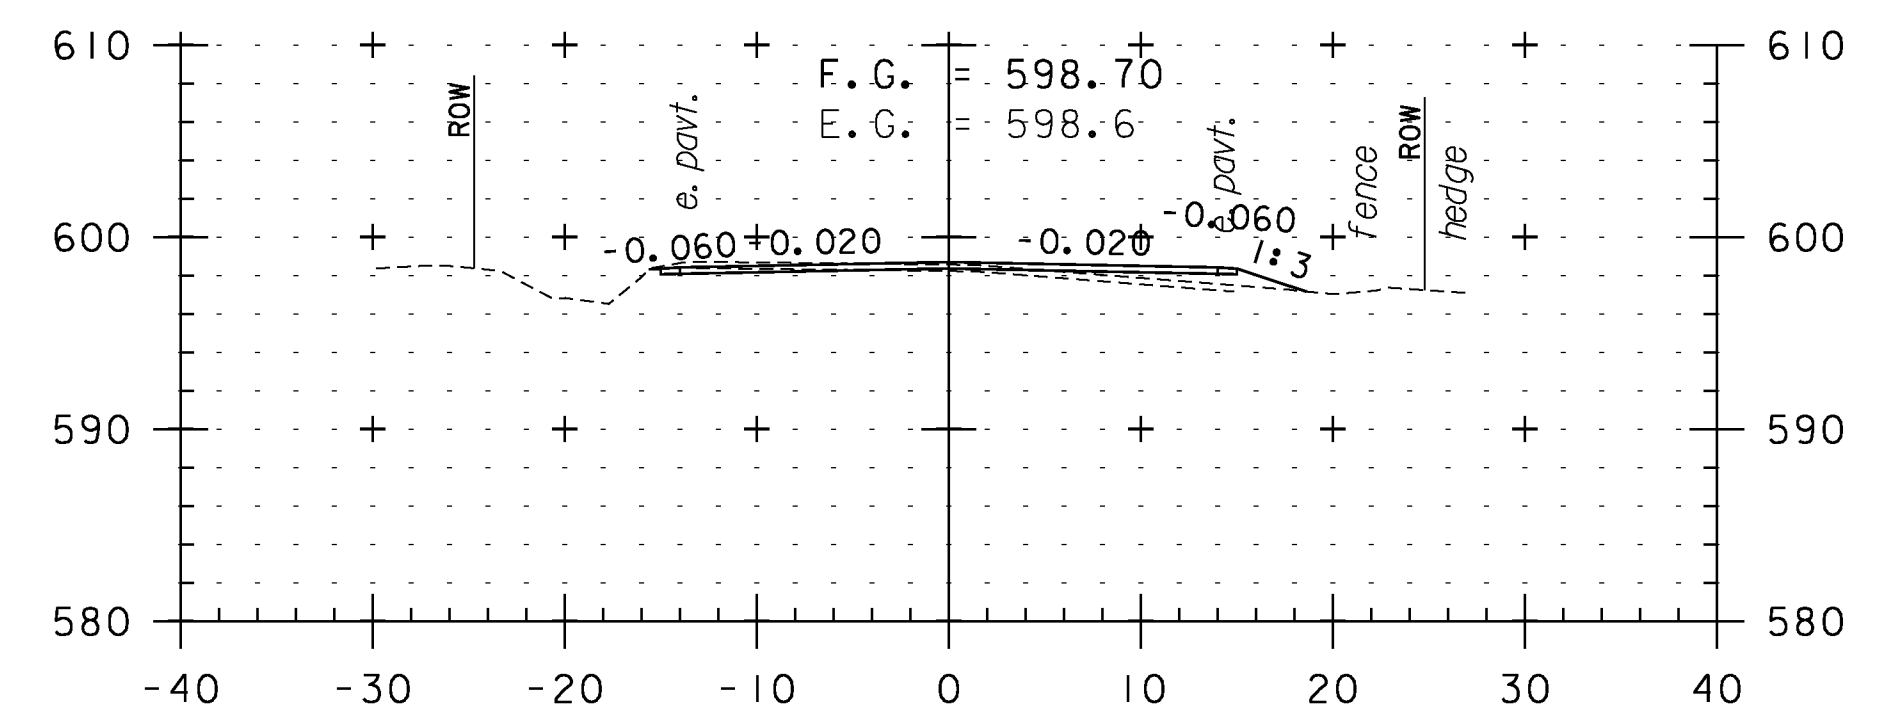


109+50

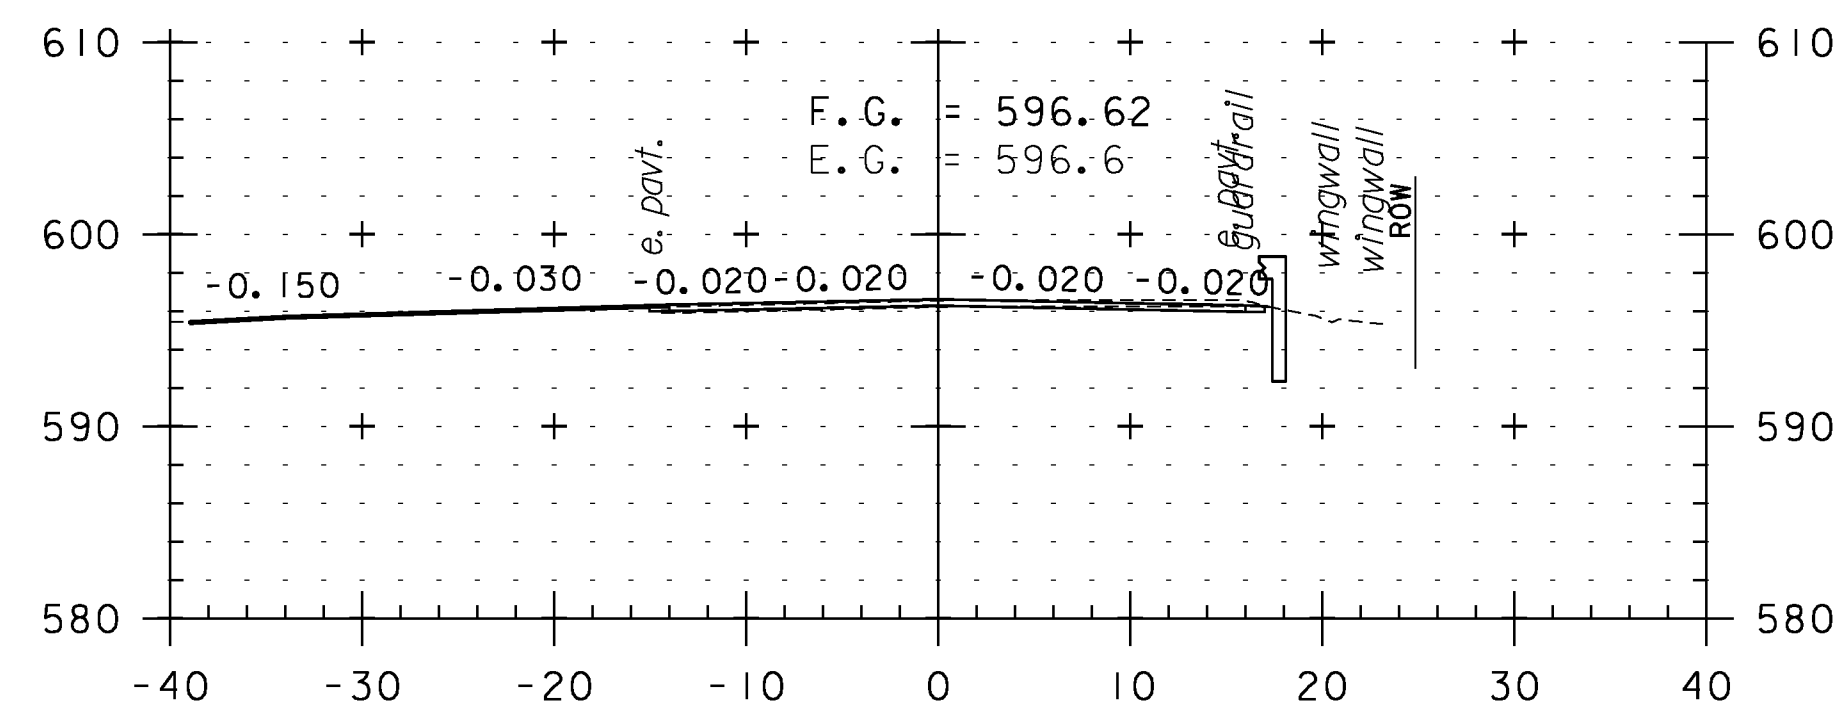


106+64  
TH 10

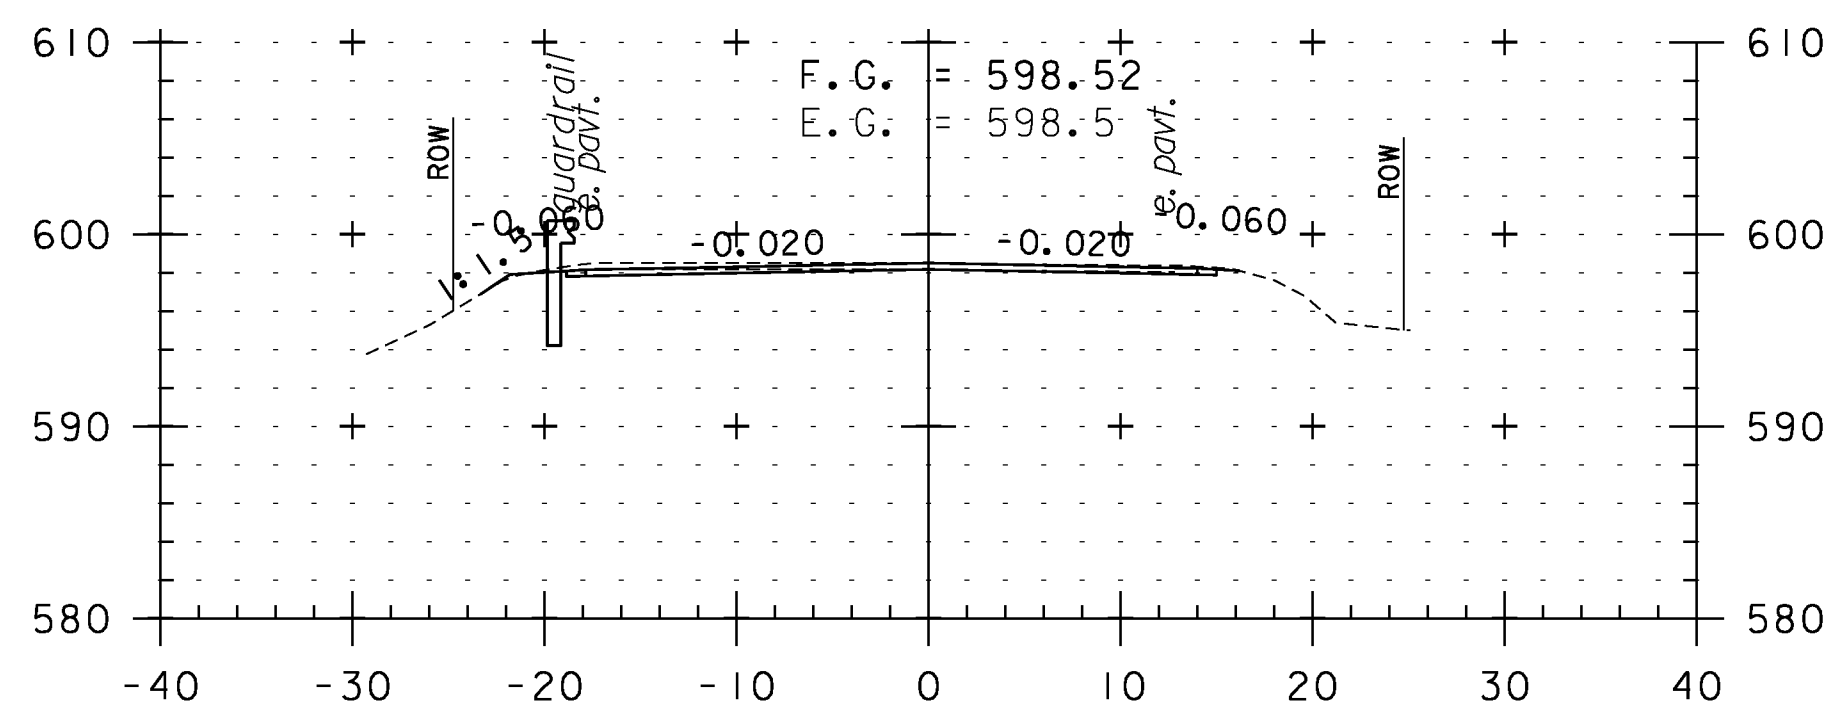


107+86  
BRIDGE 10 APPROACH

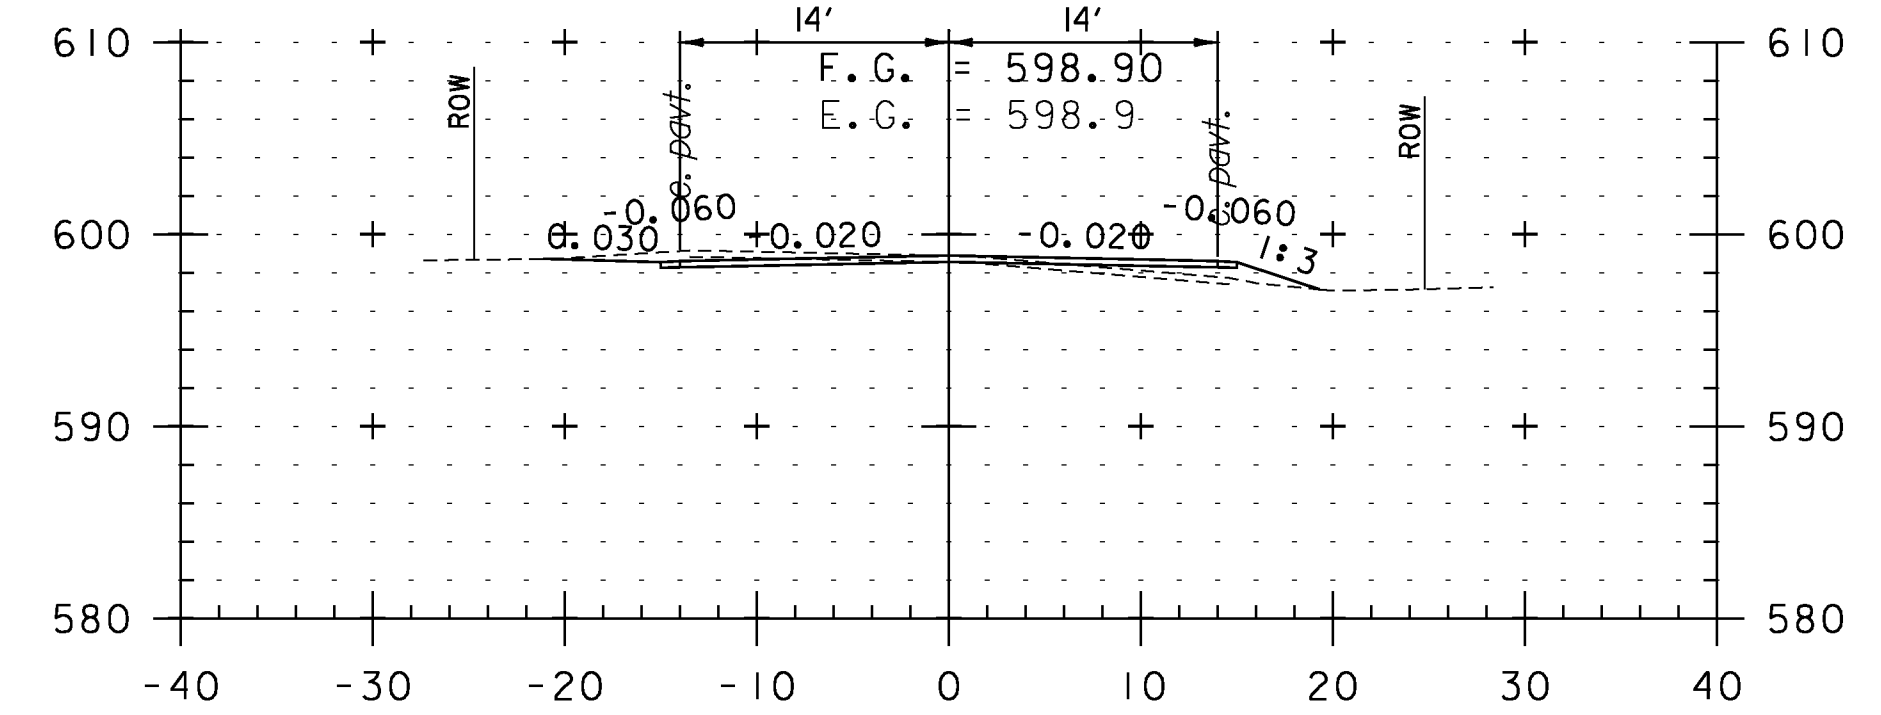


109+00

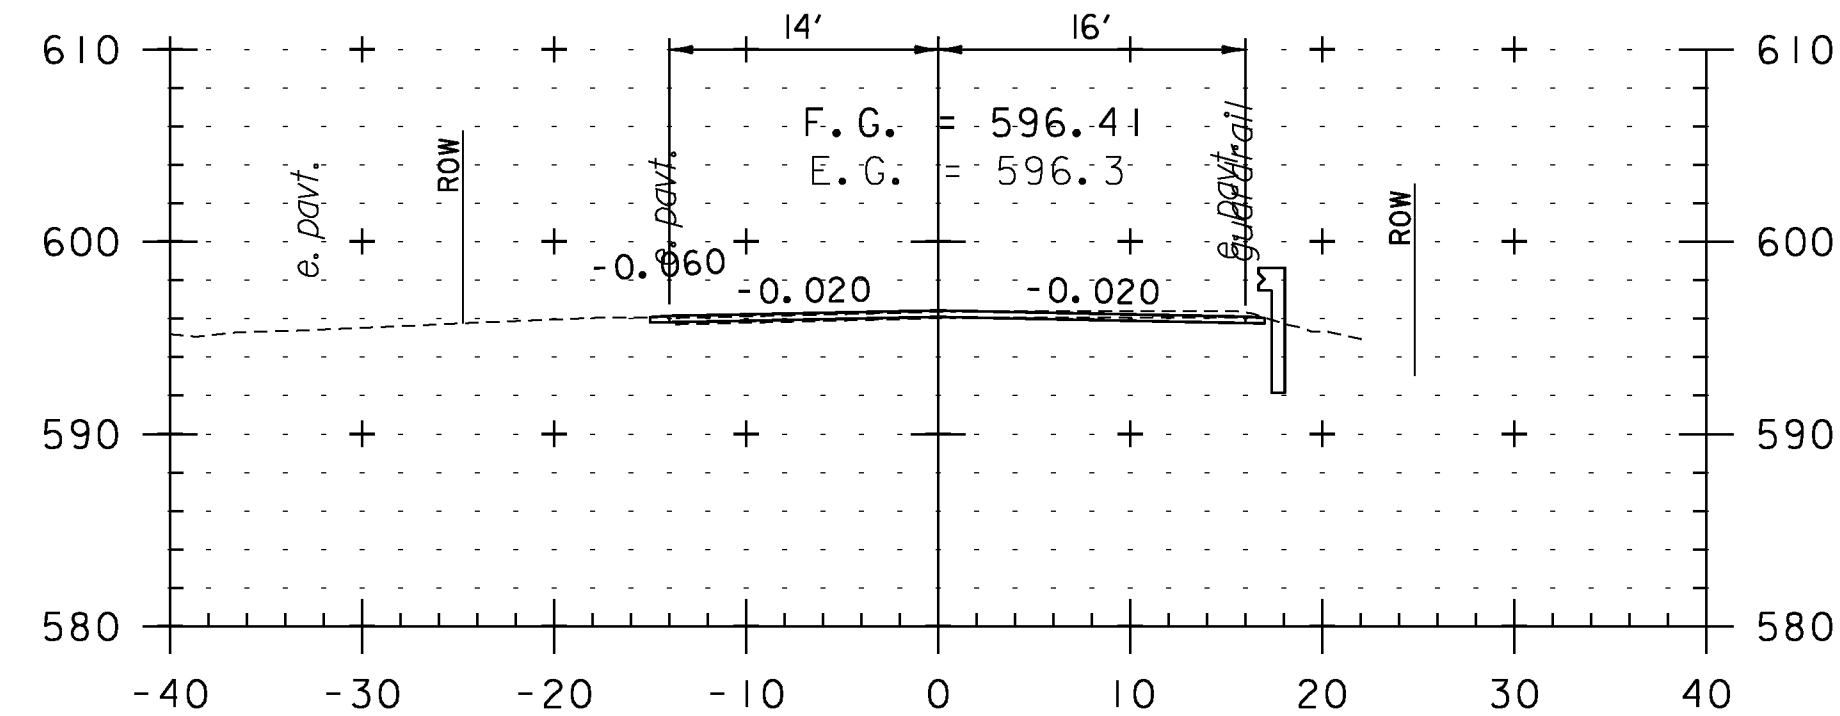

106+57  
BRIDGE 10 APPROACH

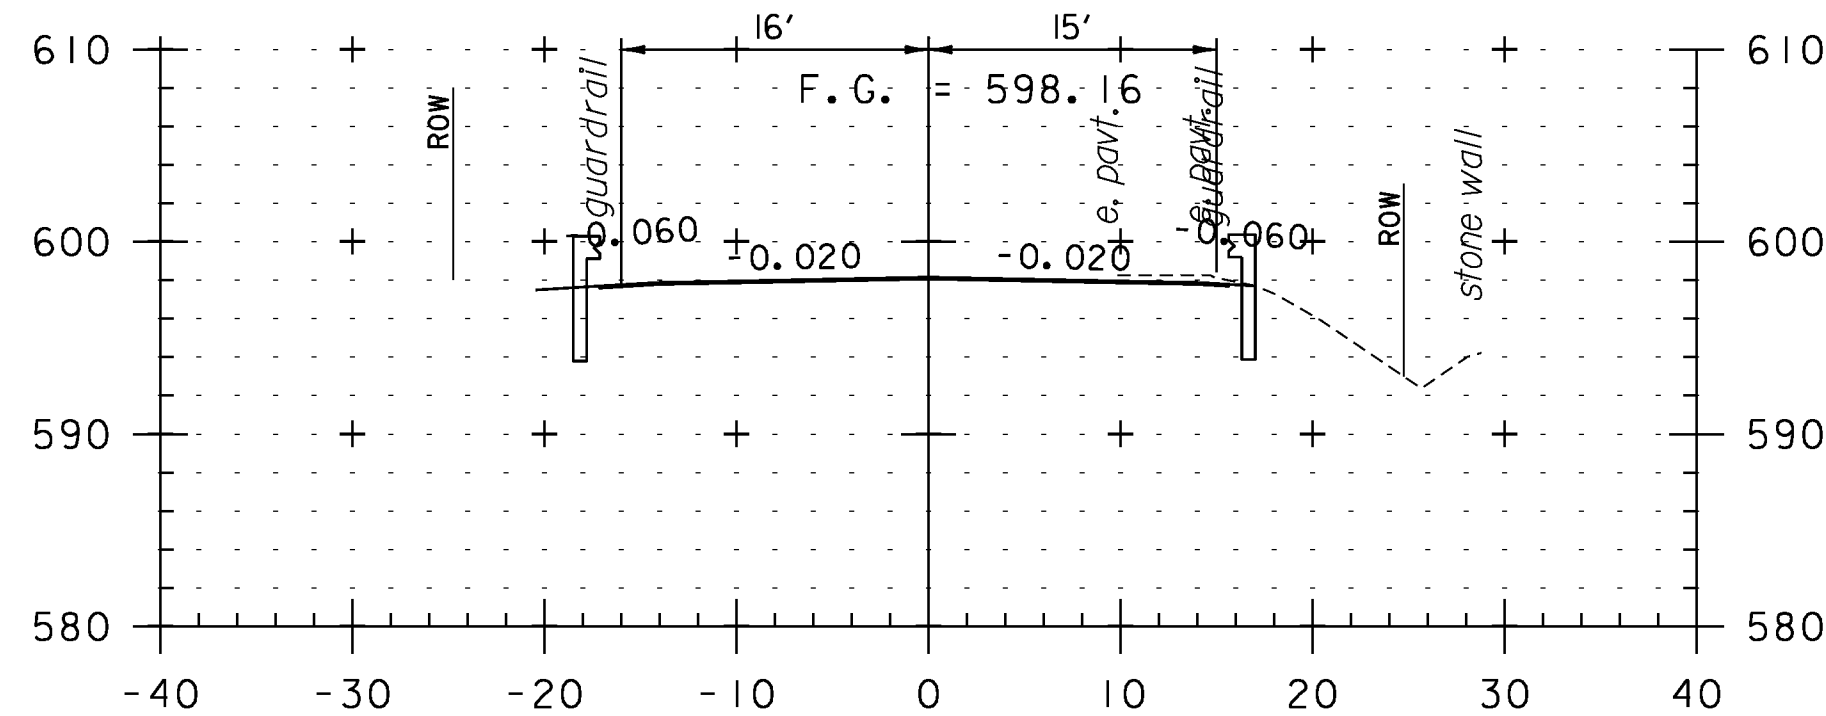

107+50  
BRIDGE 10

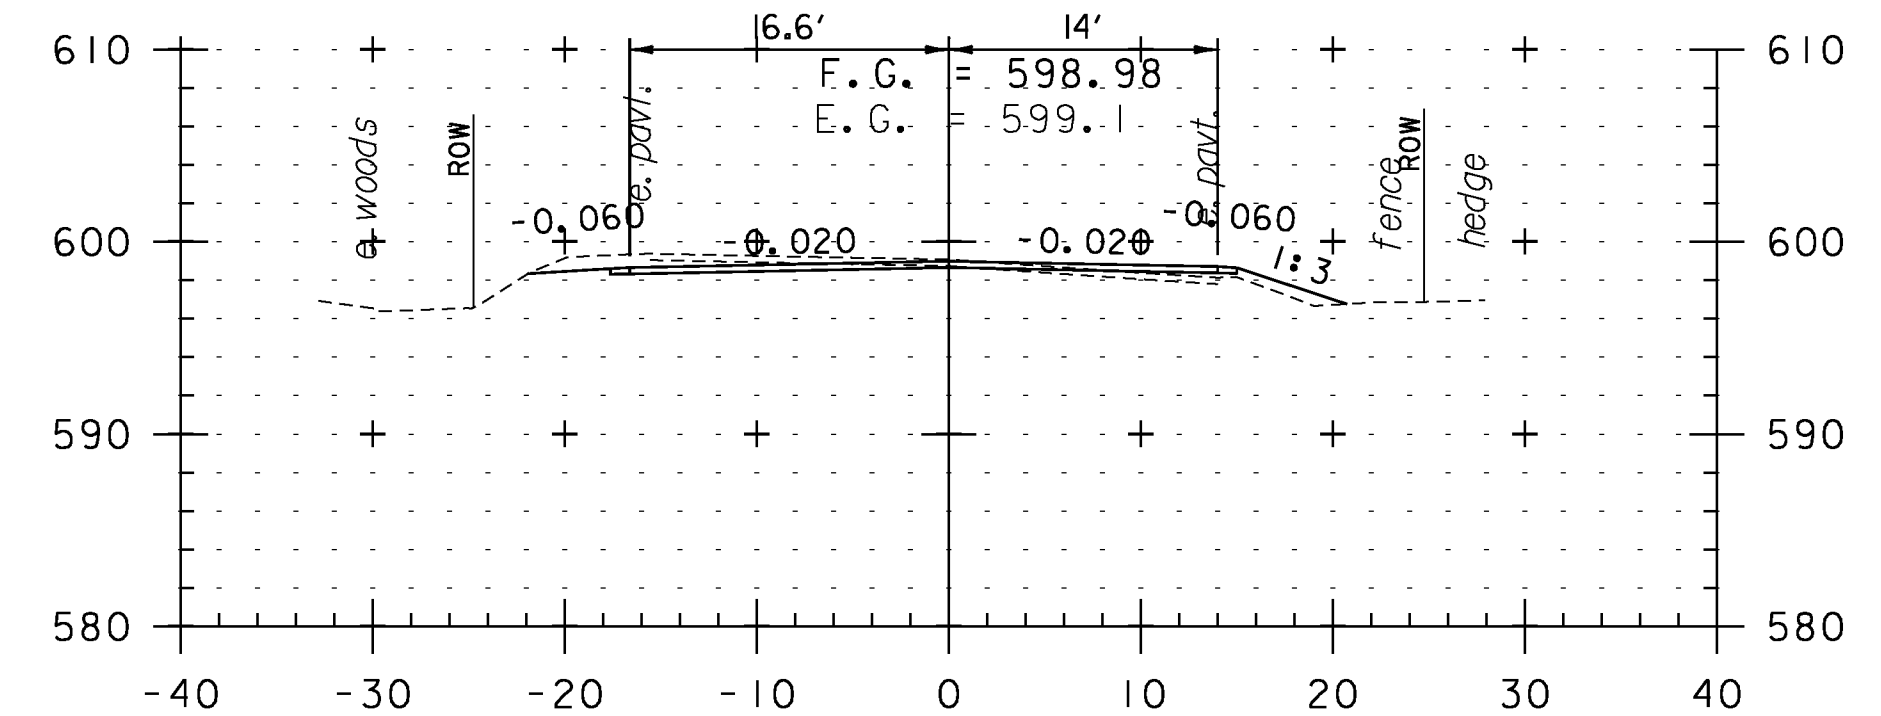

108+50

**CROSS SECTION SHEET 10**

PROJECT NAME: WEATHERSFIELD

PROJECT NUMBER: STP 2913(I)

FILE NAME: I0c228

PROJECT LEADER: PTS

DESIGNED BY: NLL


IPARM FILE NAME: pI0c228\_I00

PLOT DATE: 2/7/2013

DRAWN BY: WWG

CHECKED BY: PTS

SHEET 100 OF 234

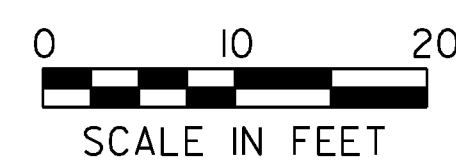

STA. 106+57 TO STA. 109+50