




136+50

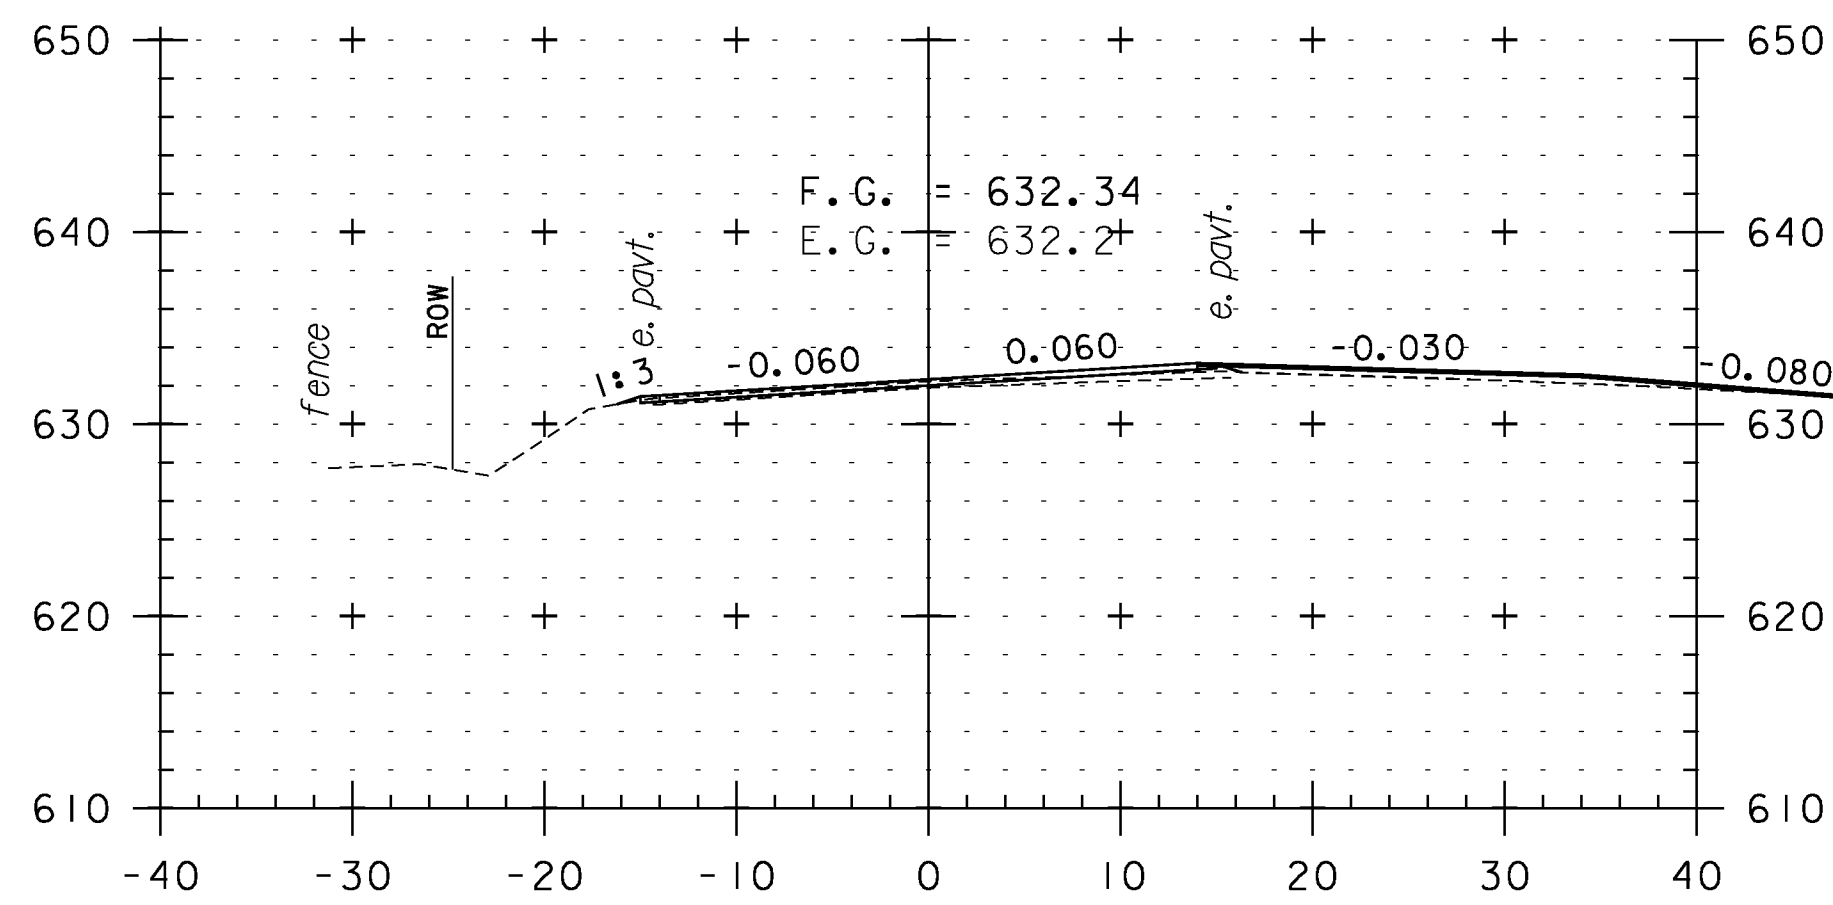


137+75  
TH 8

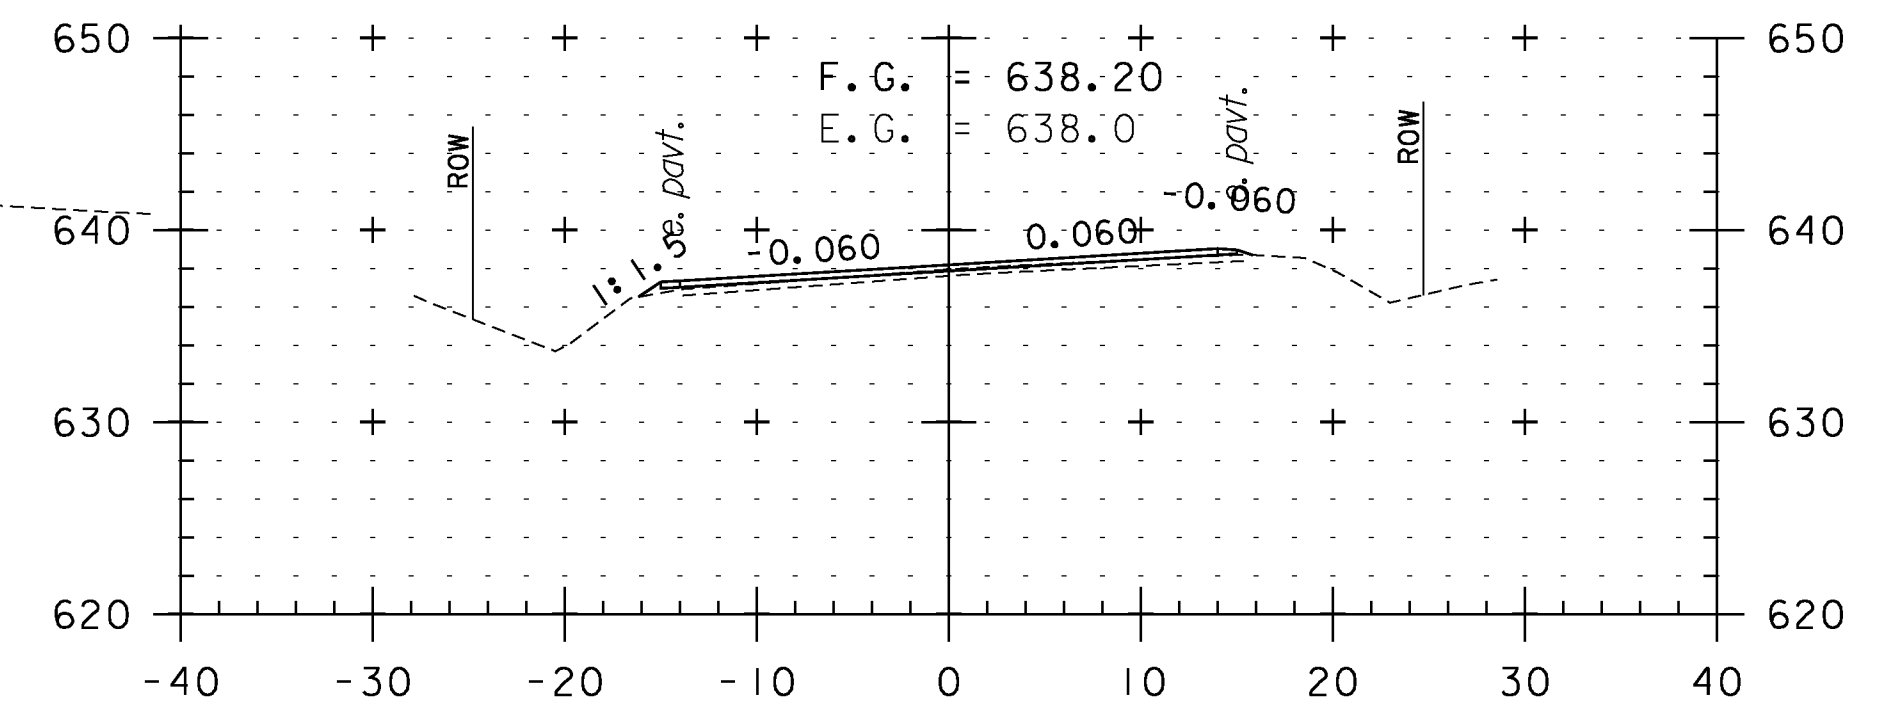


139+00

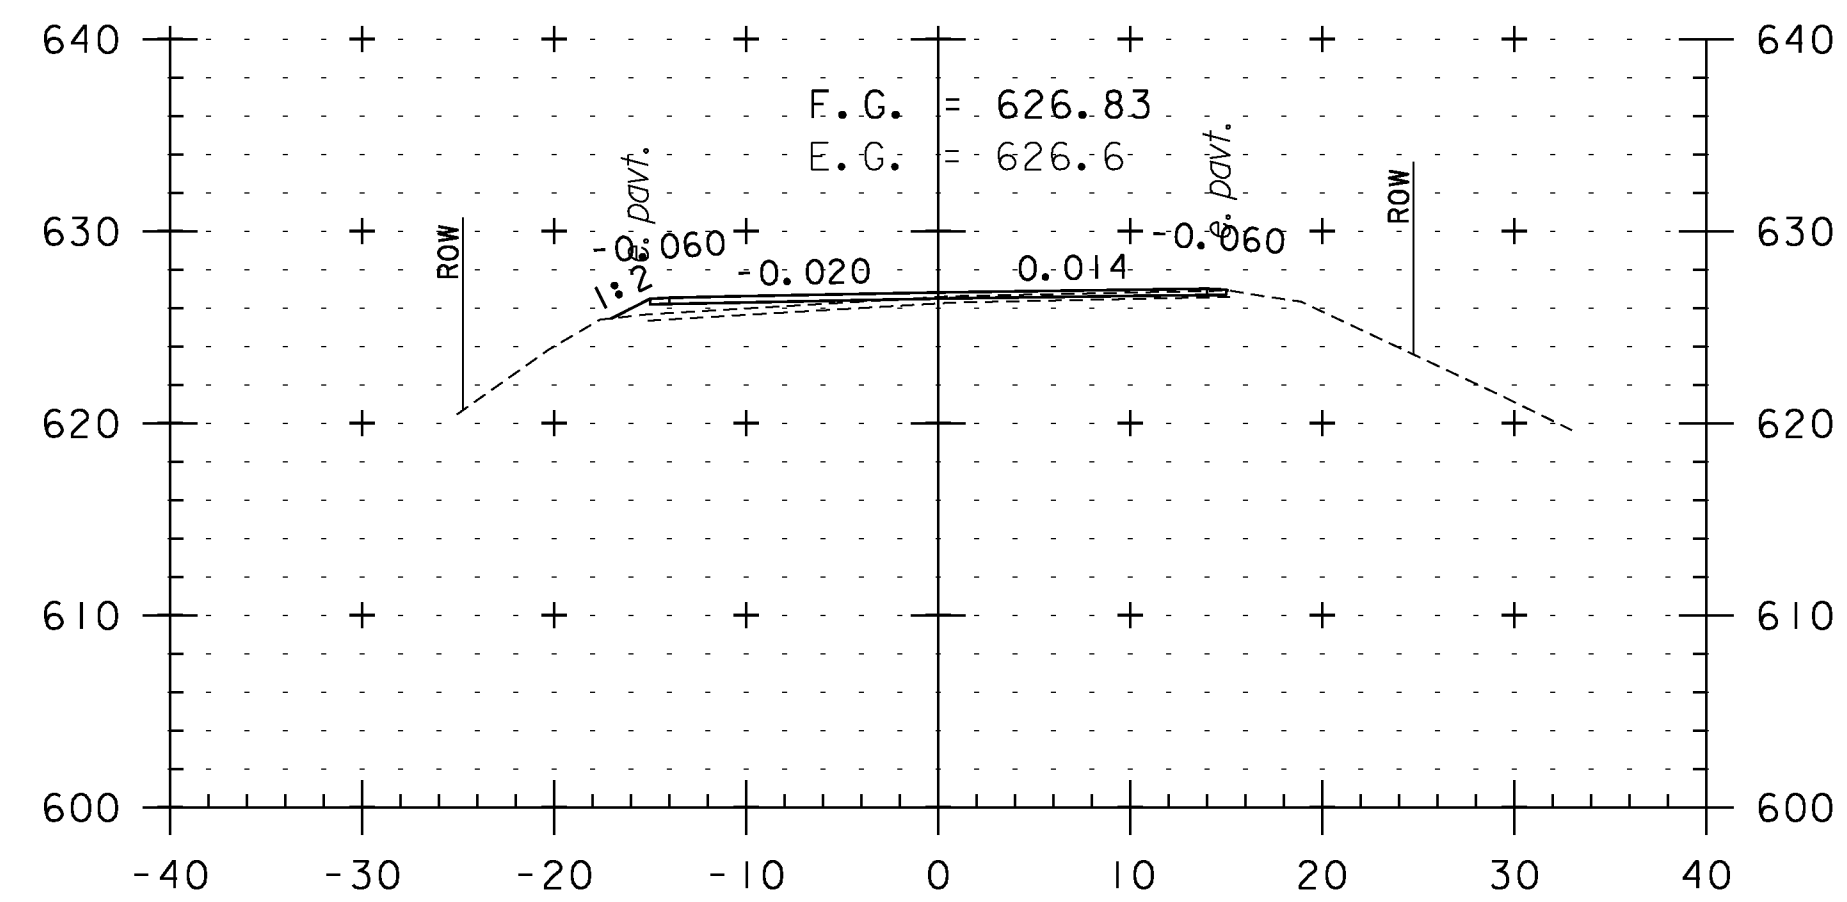


136+00

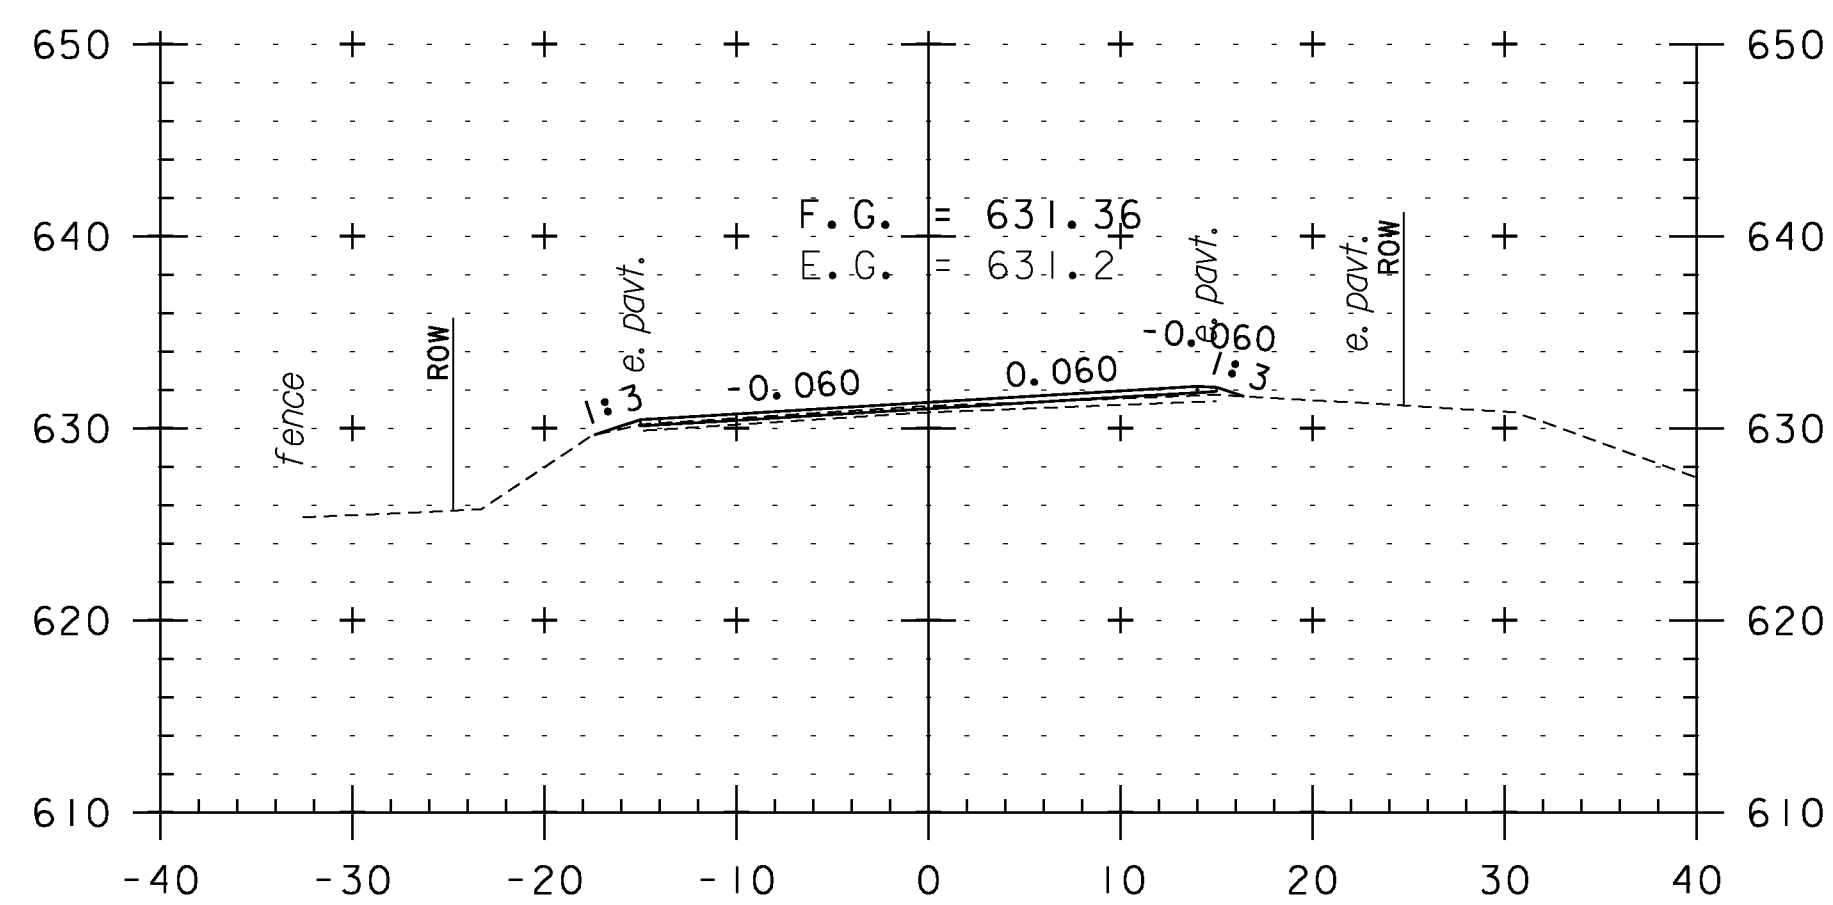


137+50

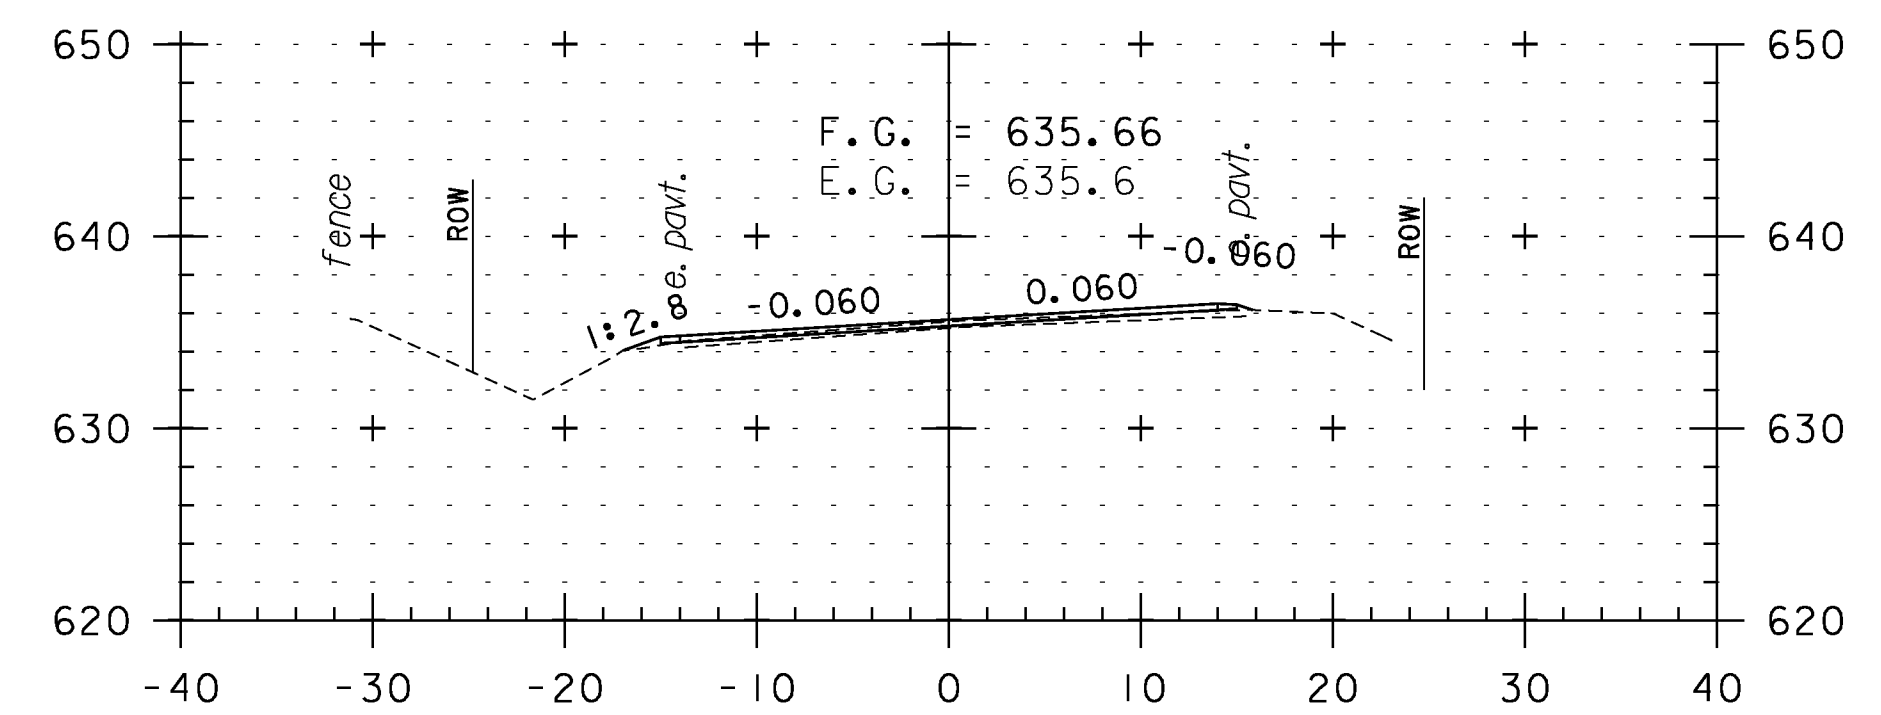


138+50

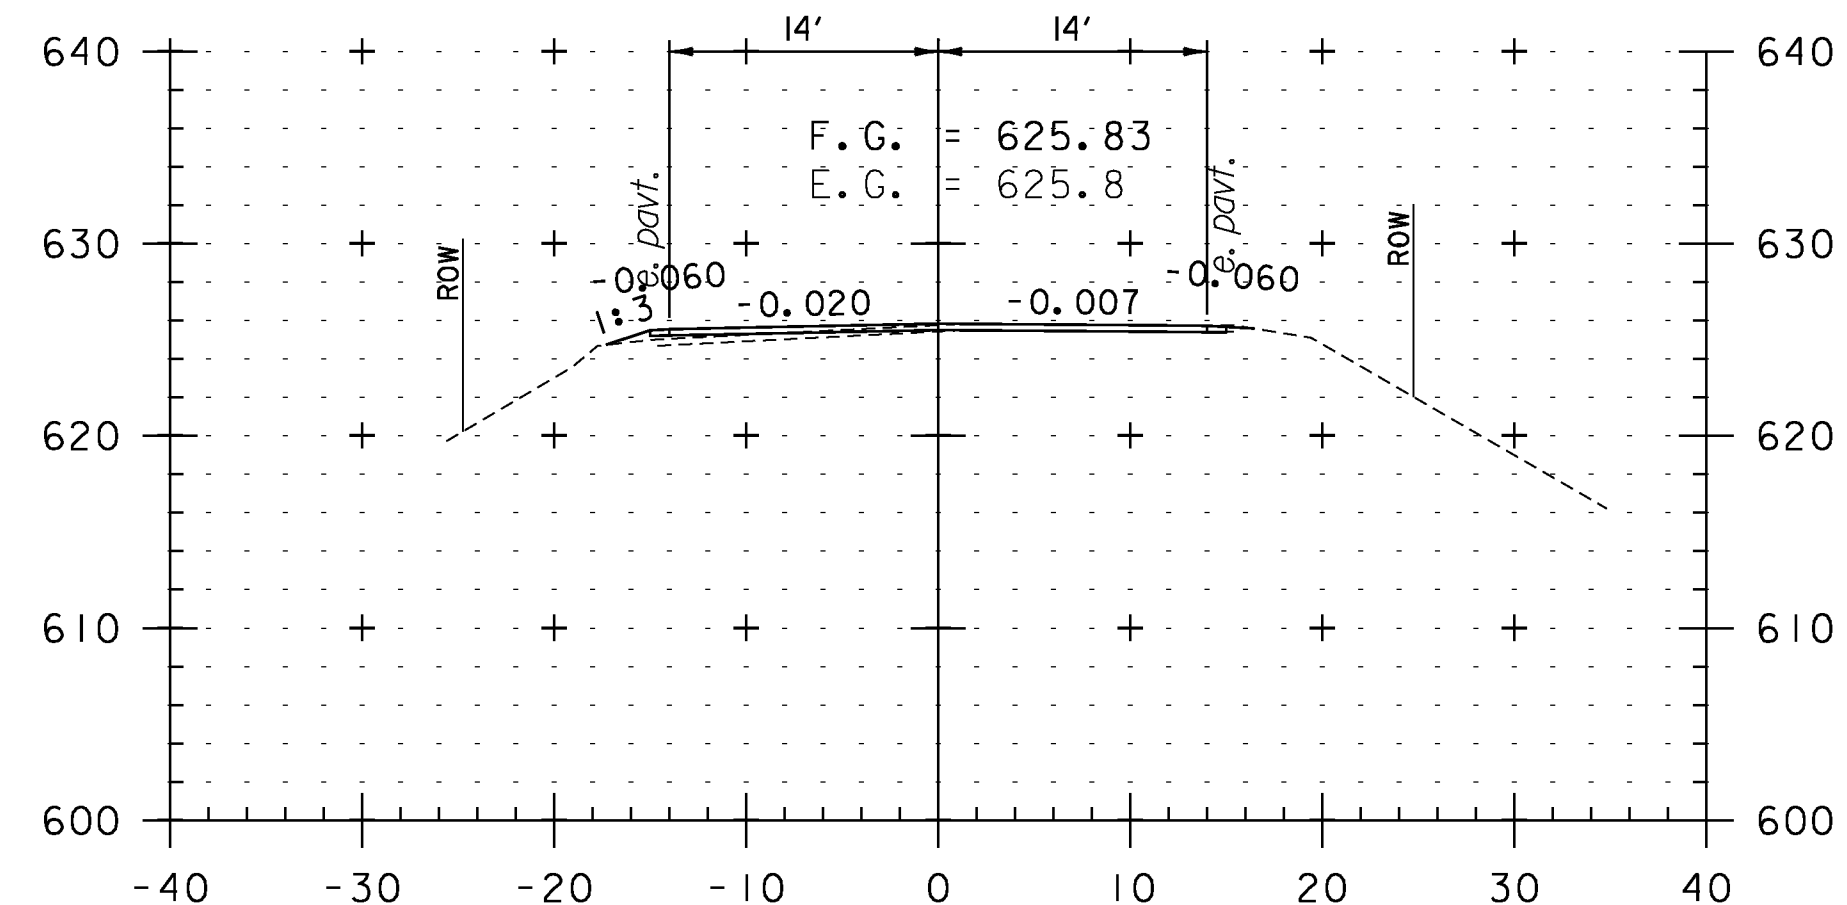

135+50

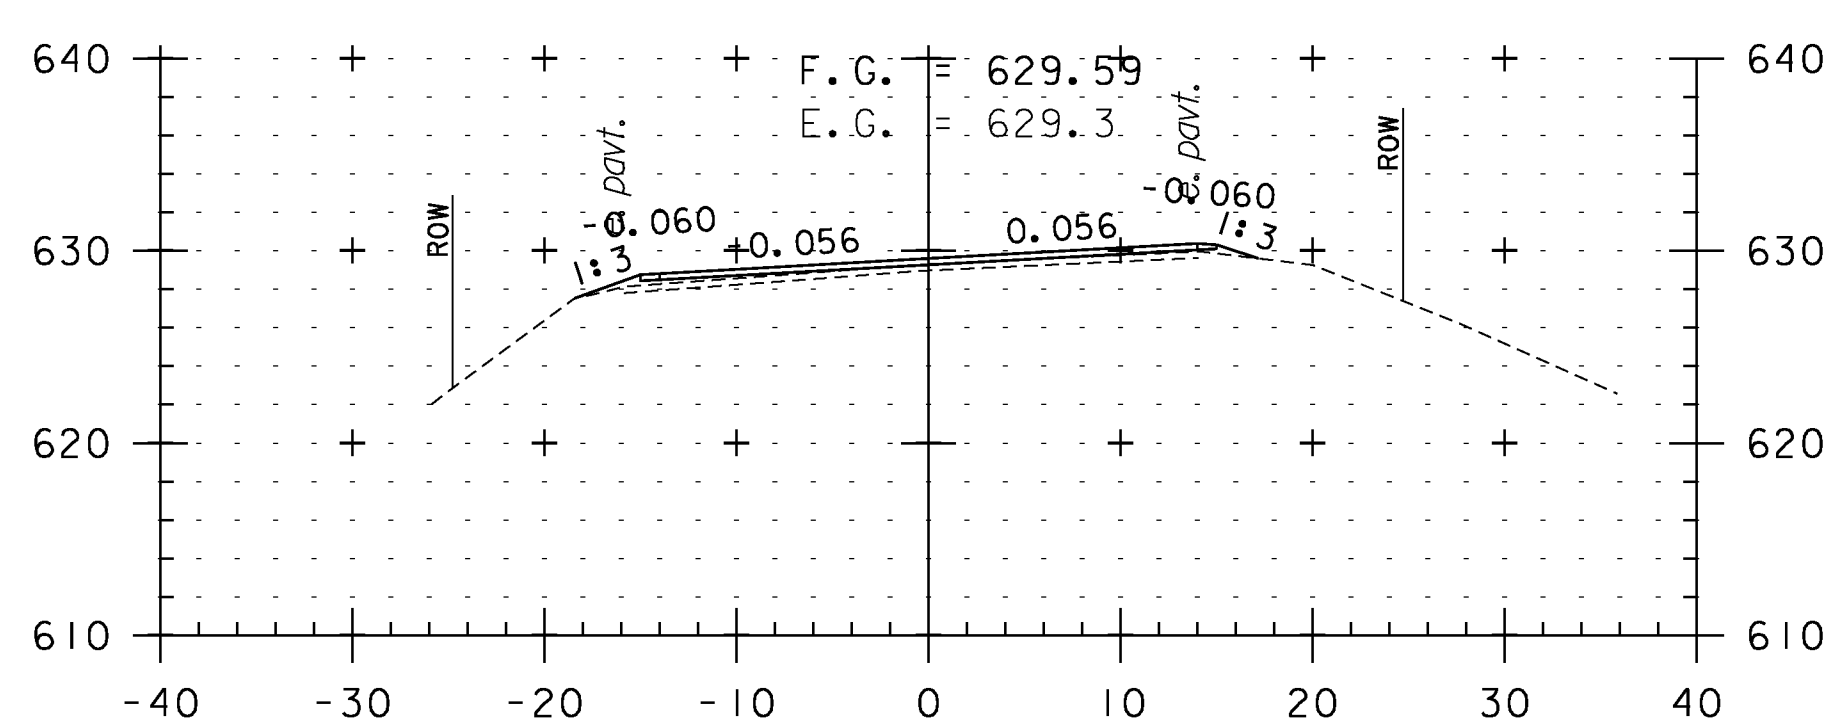

137+00

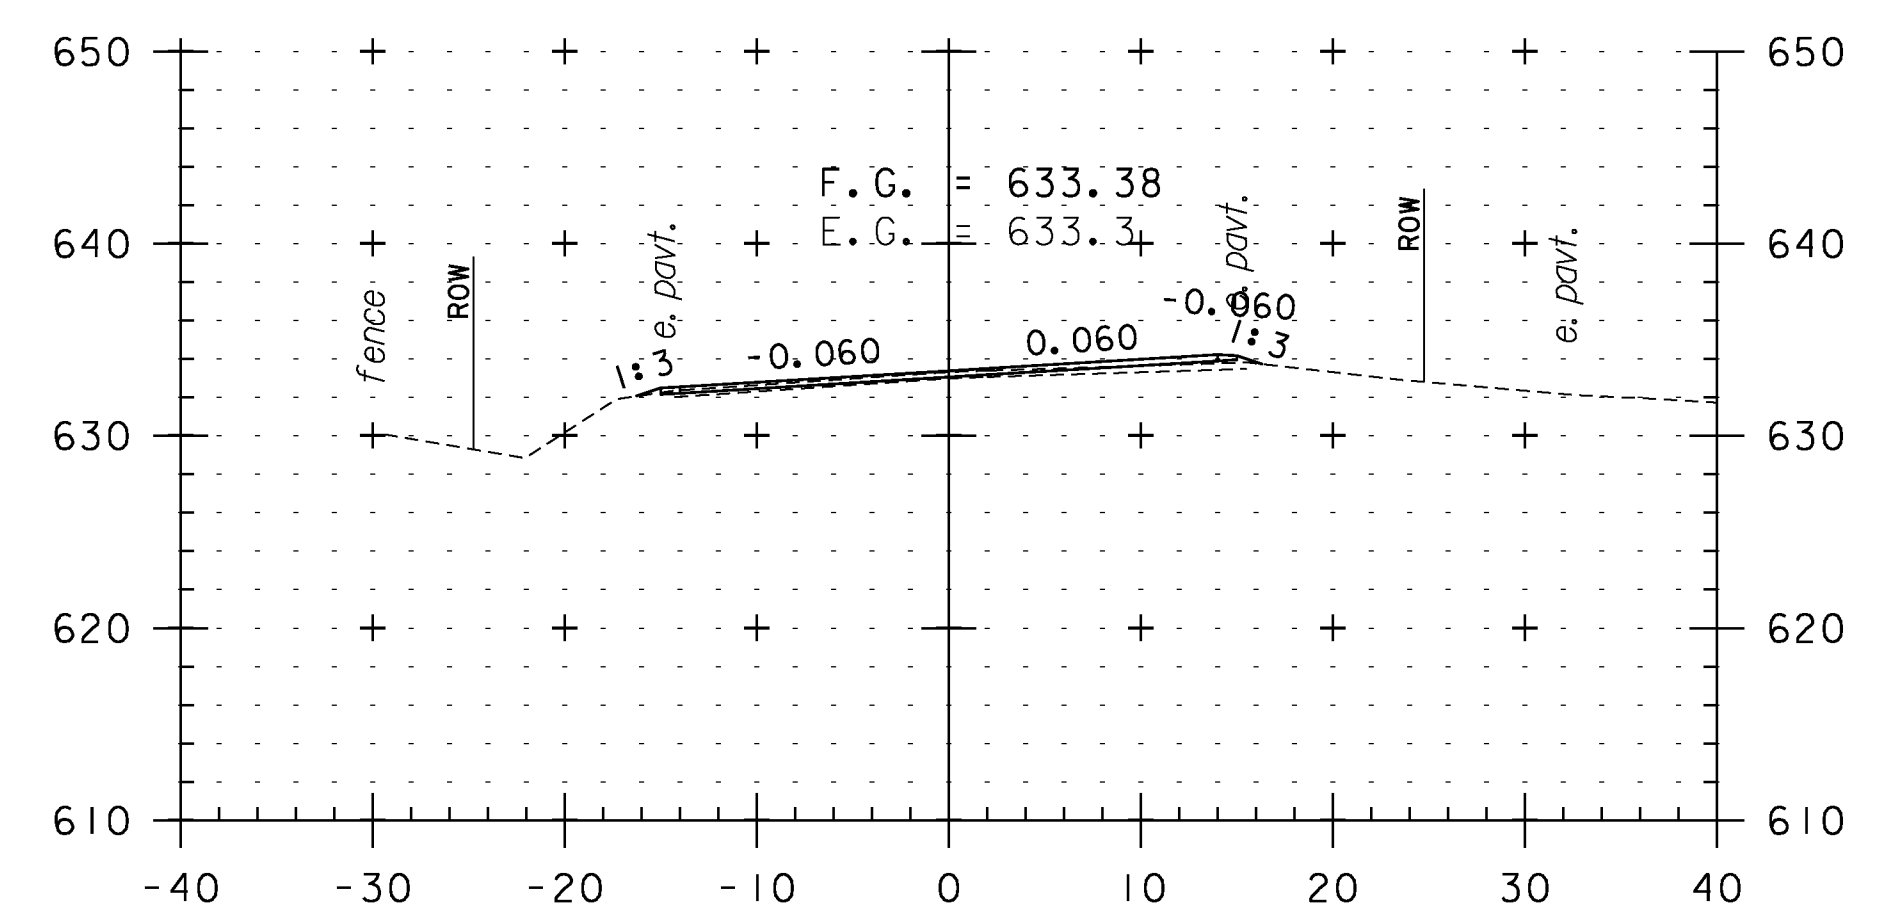

138+00

**CROSS SECTION SHEET 17**

PROJECT NAME: WEATHERSFIELD

PROJECT NUMBER: STP 2913(I)

FILE NAME: I0c228

PROJECT LEADER: PTS

DESIGNED BY: NLL


IPARM FILE NAME: pI0c228.I07

PLOT DATE: 2/7/2013

DRAWN BY: WWG

CHECKED BY: PTS

SHEET 107 OF 234

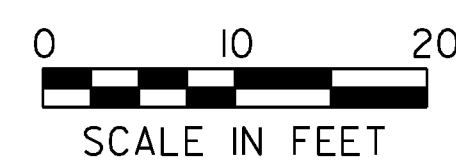

STA. 135+50 TO STA. 139+00