




153+50

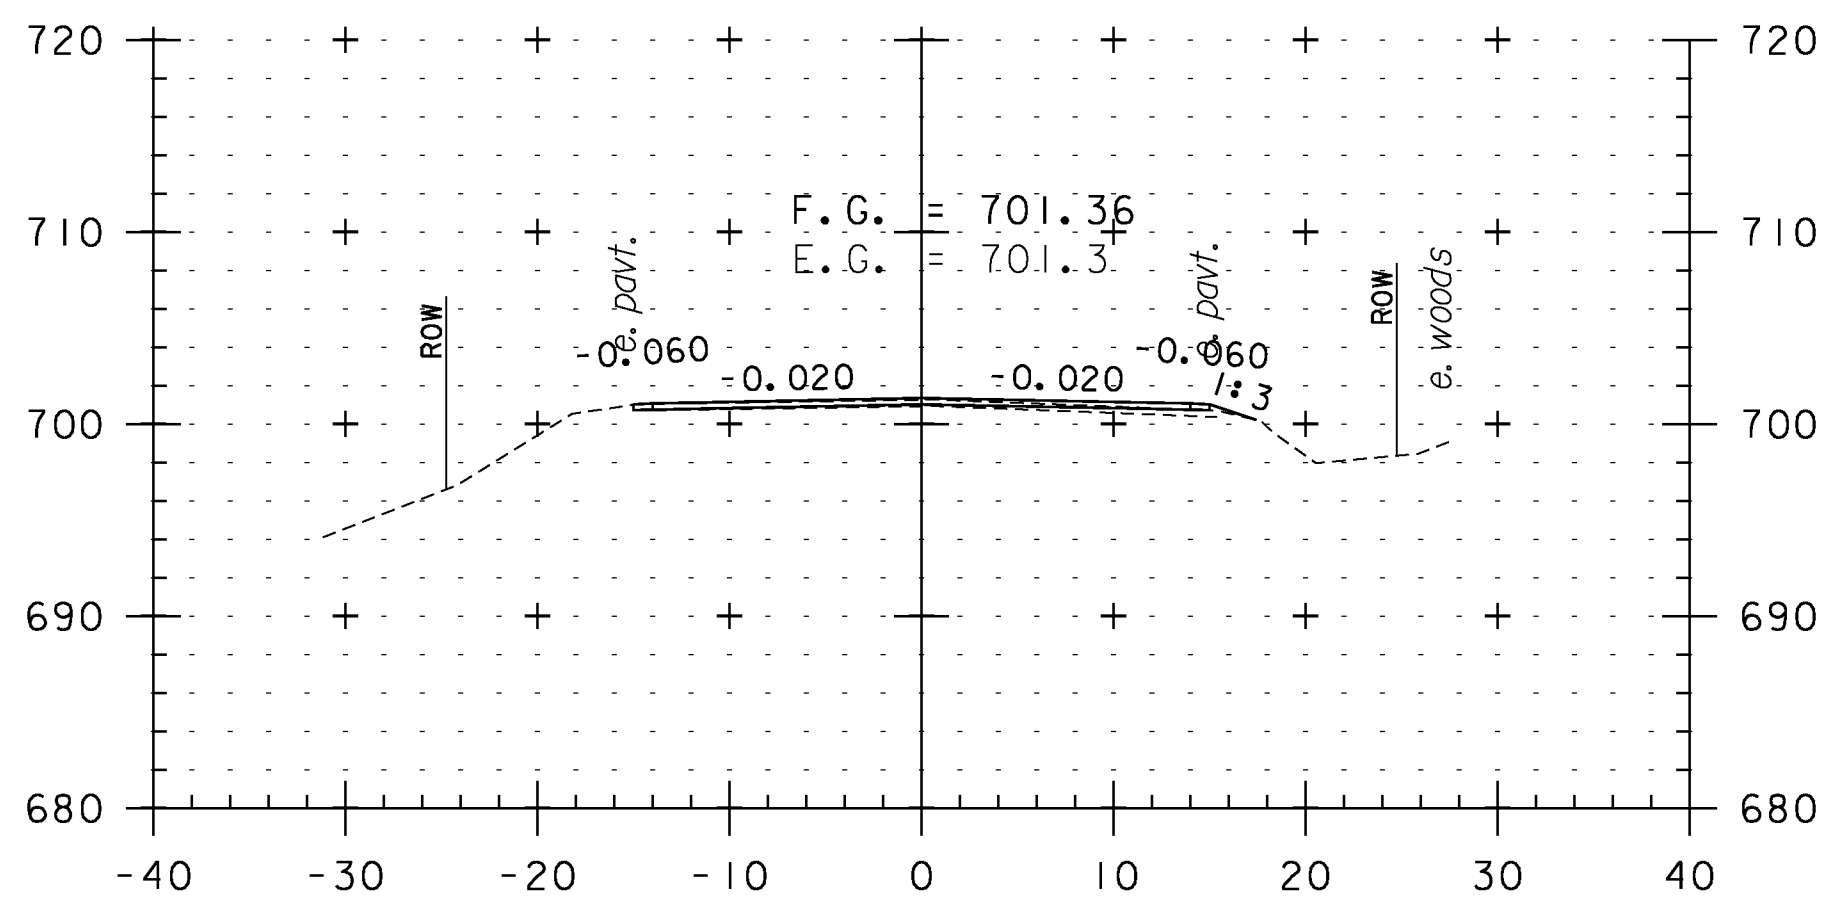


155+00

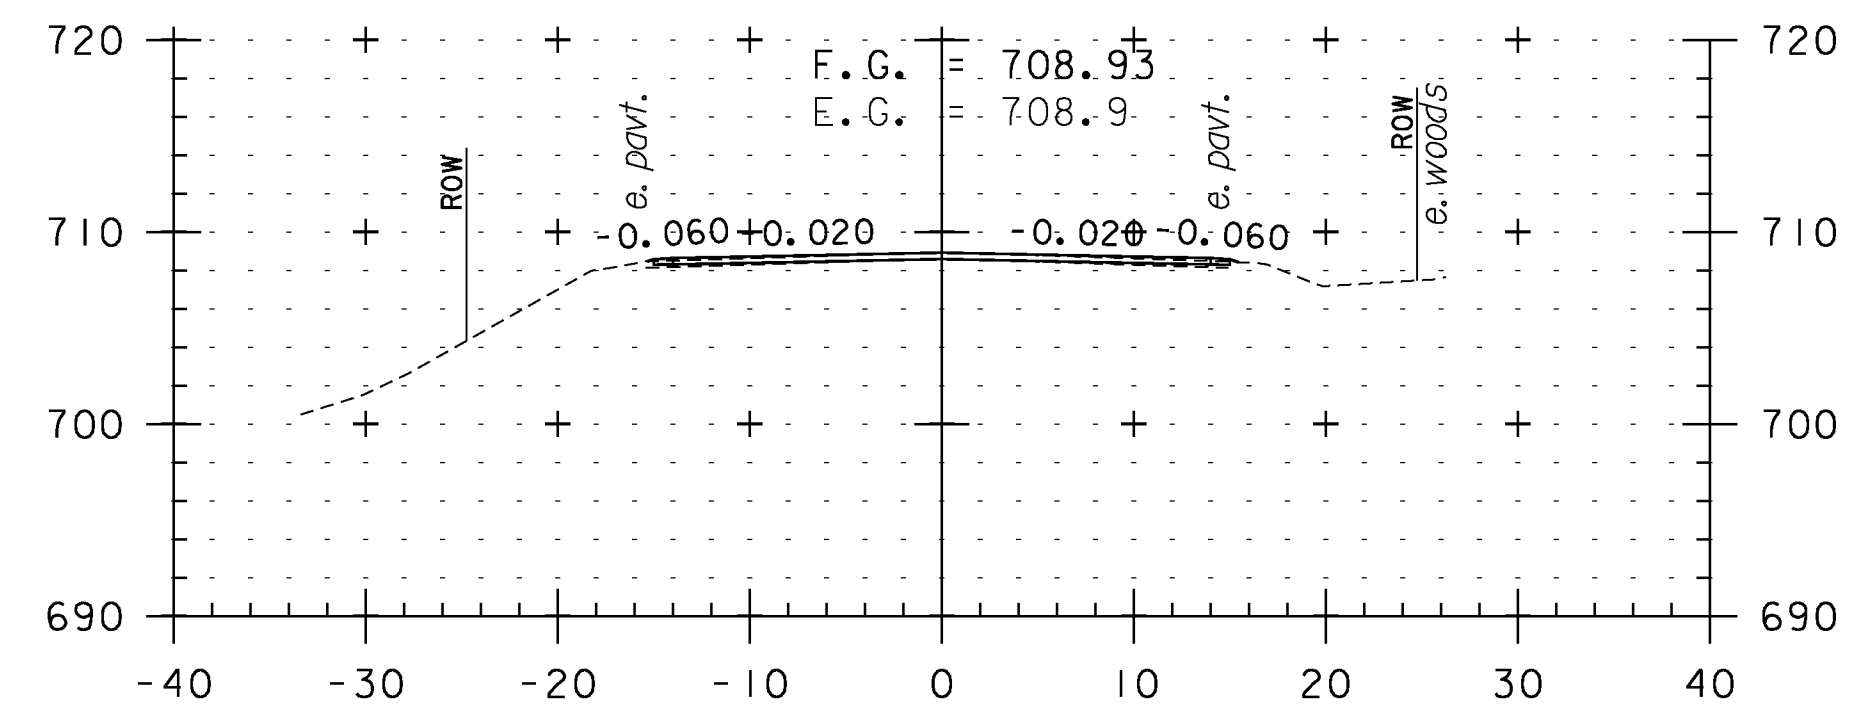


156+50

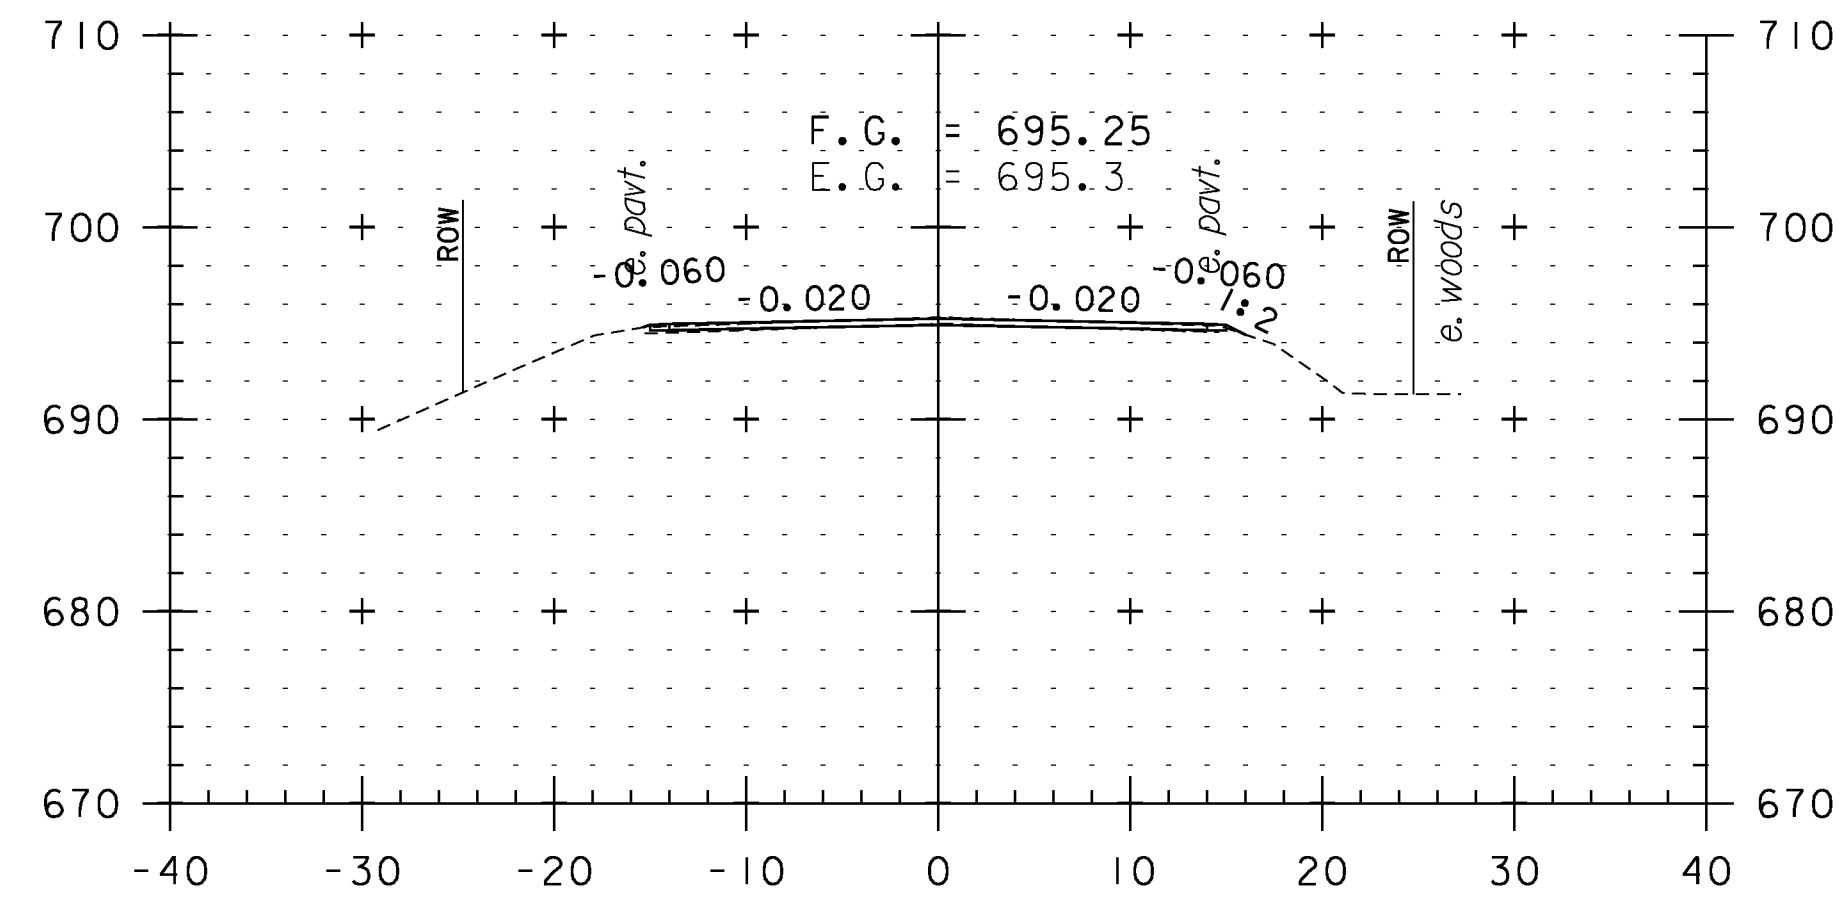


153+00

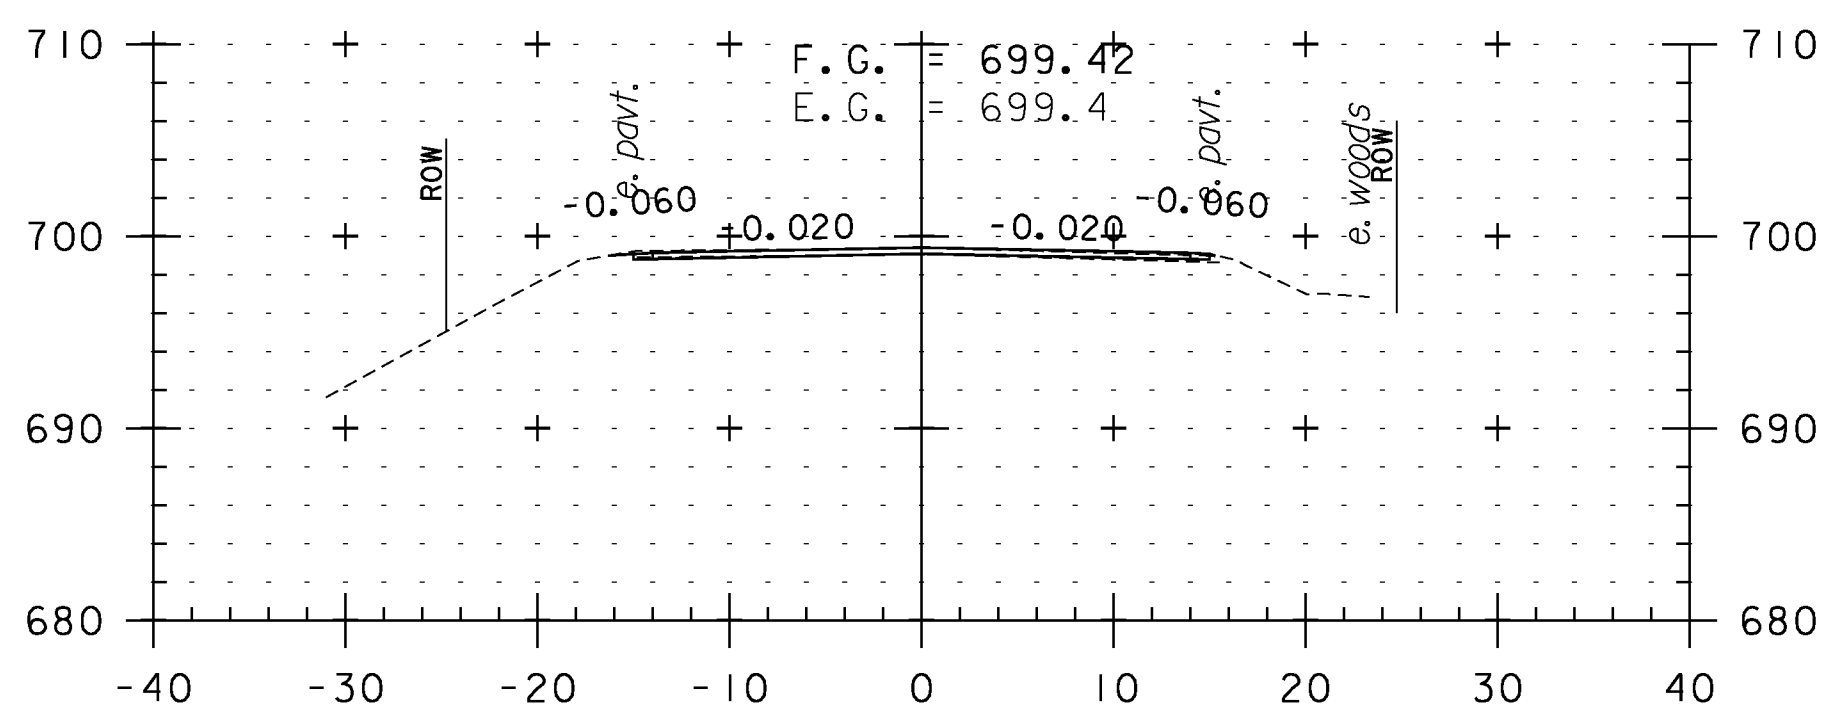


154+50

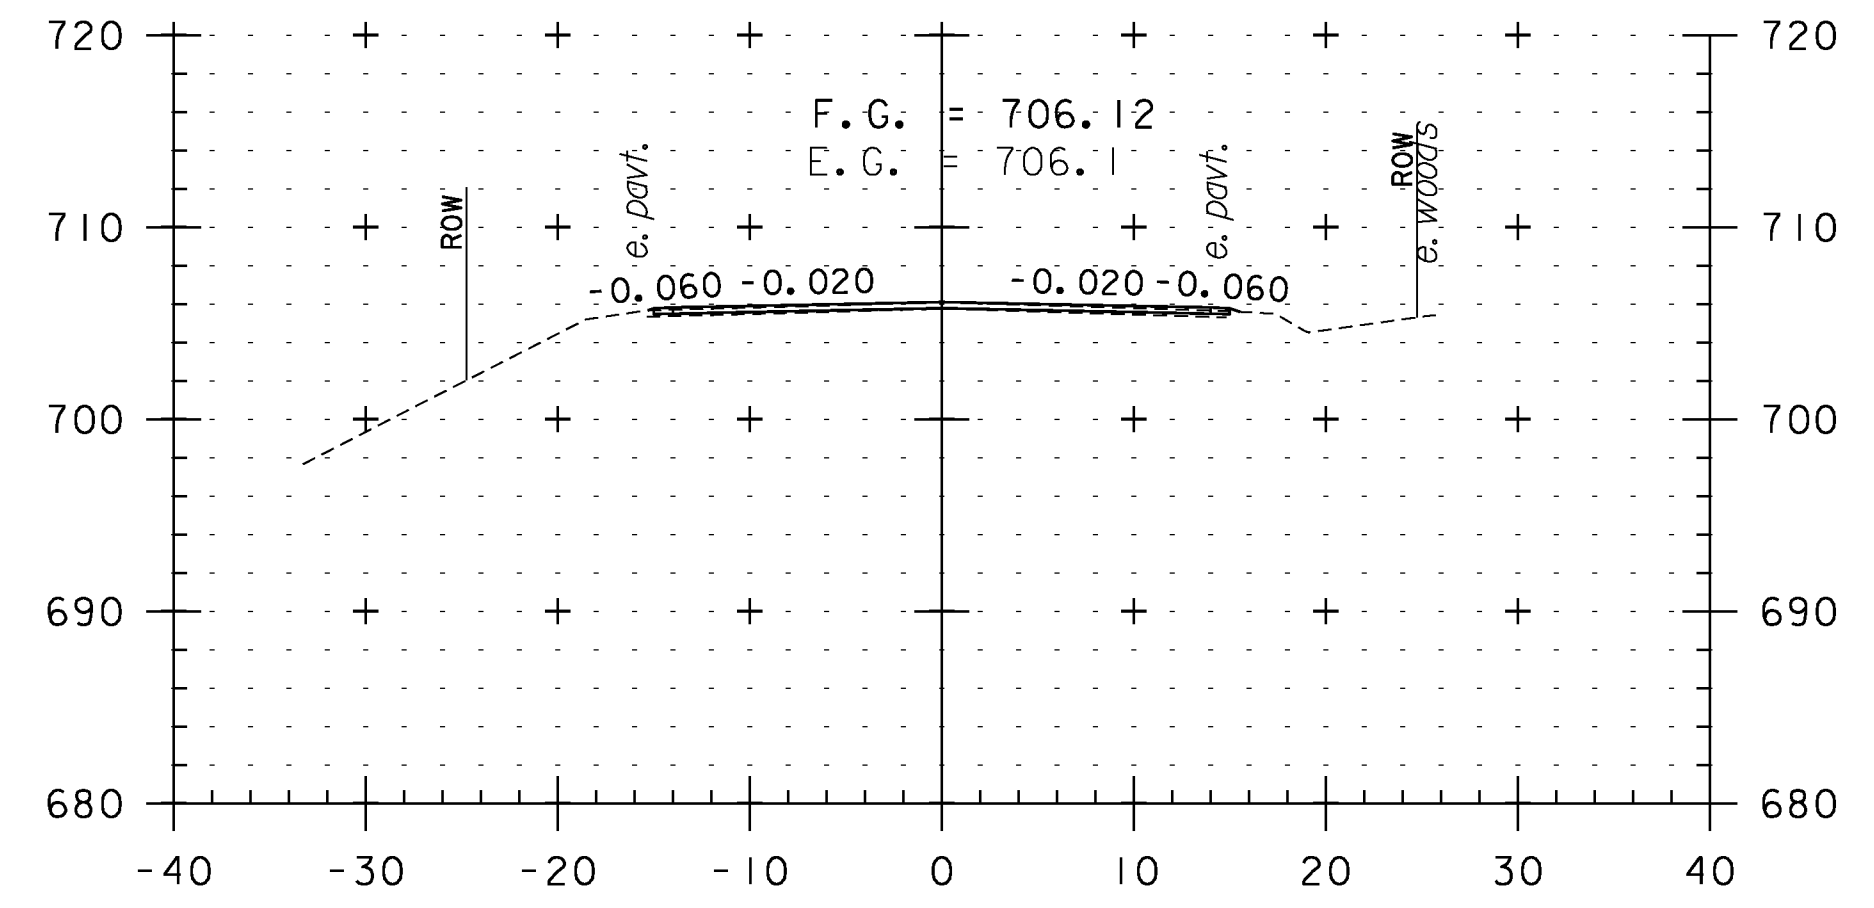


156+00

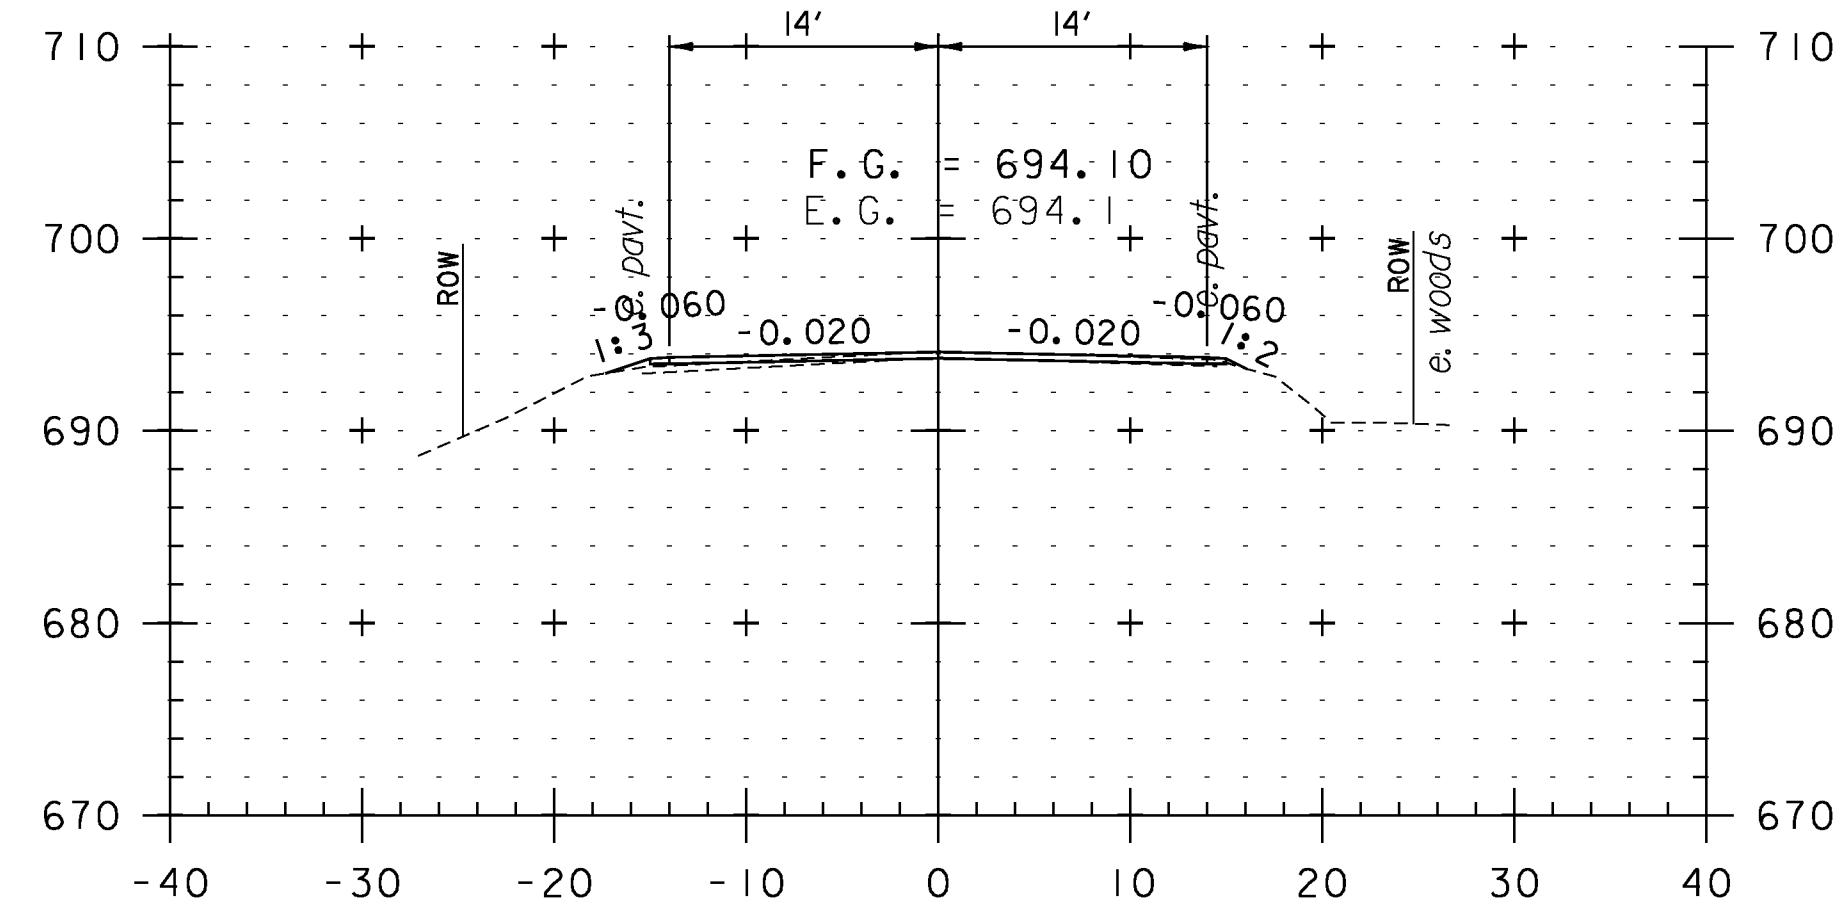

152+50

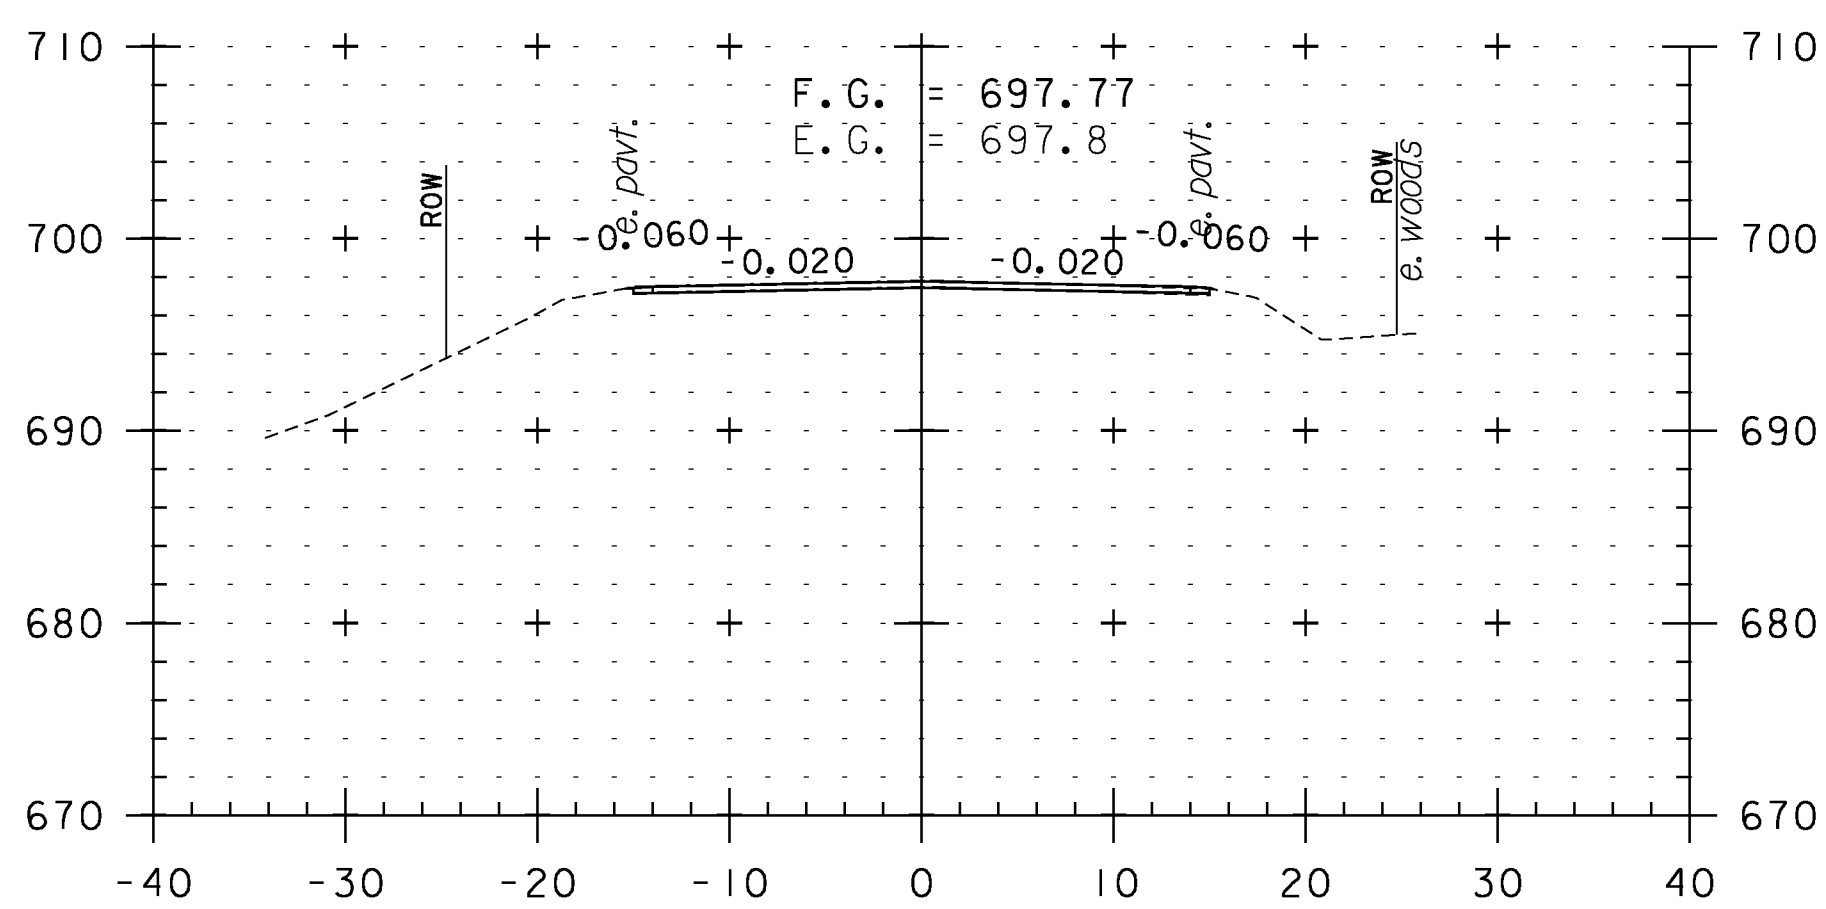

154+00

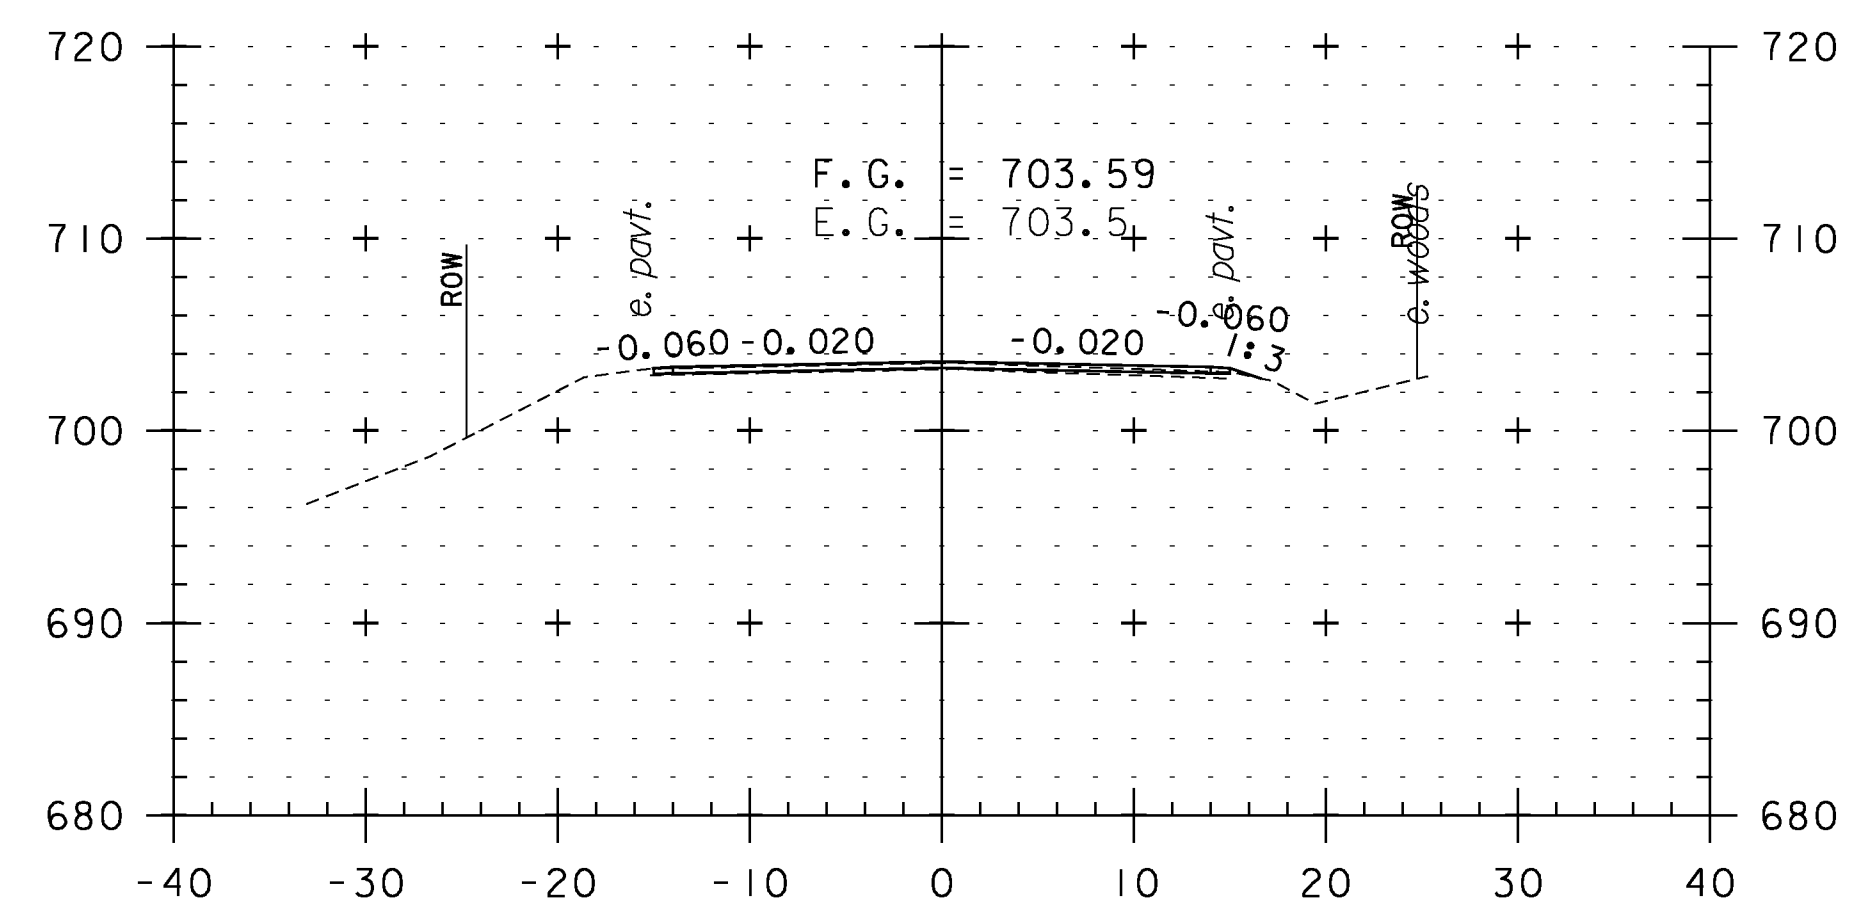

155+50

**CROSS SECTION SHEET 21**

PROJECT NAME: WEATHERSFIELD	
PROJECT NUMBER: STP 2913(I)	
FILE NAME: I0c228	PLOT DATE: 2/7/2013
PROJECT LEADER: PTS	DRAWN BY: WWG
DESIGNED BY: NLL	CHECKED BY: PTS
IPARM FILE NAME: pI0C228.III	SHEET III OF 234



STA. 152+50 TO STA. 156+50