


CROSS SECTION SHEET 23

PROJECT NAME: WEATHERSFIELD	PLOT DATE: 2/7/2013
PROJECT NUMBER: STP 2913(I)	DRAWN BY: WWG
FILE NAME: I0c228	CHECKED BY: PTS
PROJECT LEADER: PTS	SHEET I13 OF 234
DESIGNED BY: NLL	
IPARM FILE NAME: pI0c228_I13	

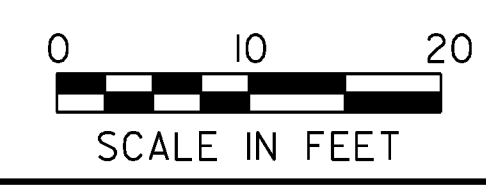

STA. 161+50 TO STA. 165+50