




171+50

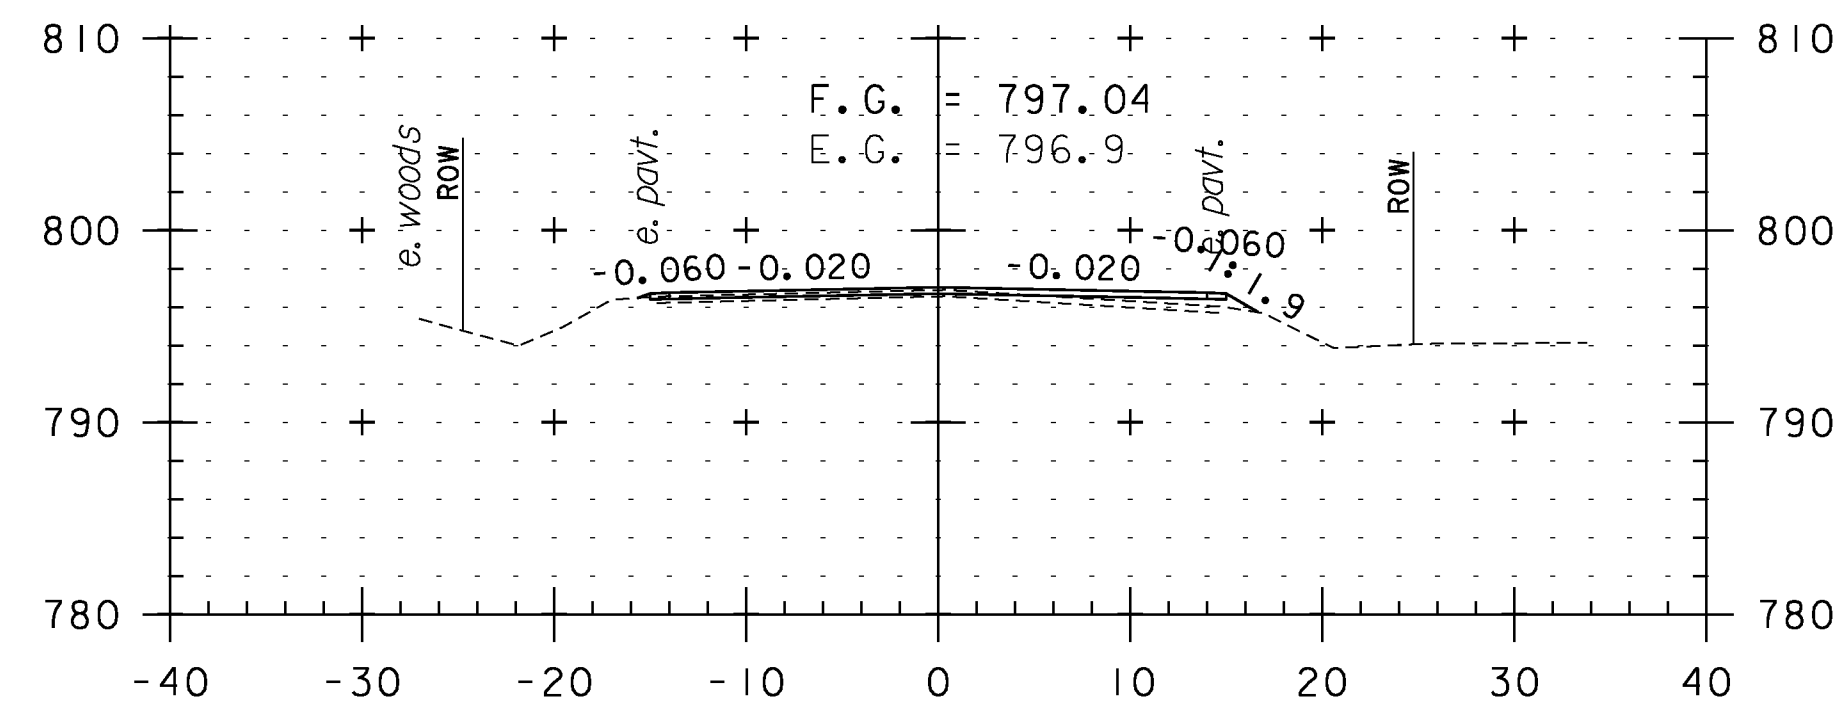


171+00

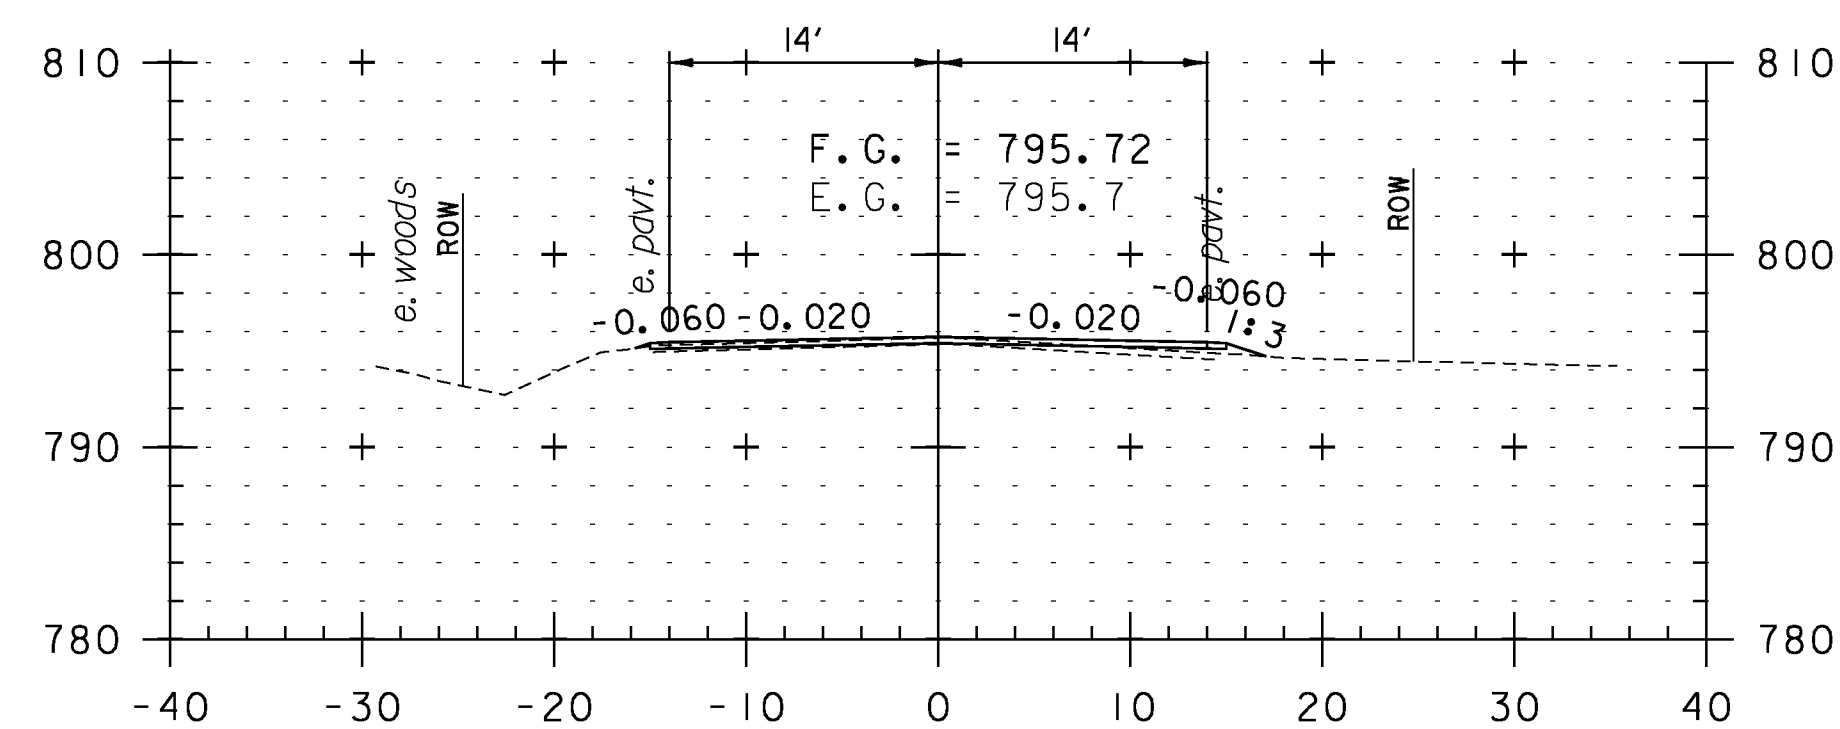


170+50

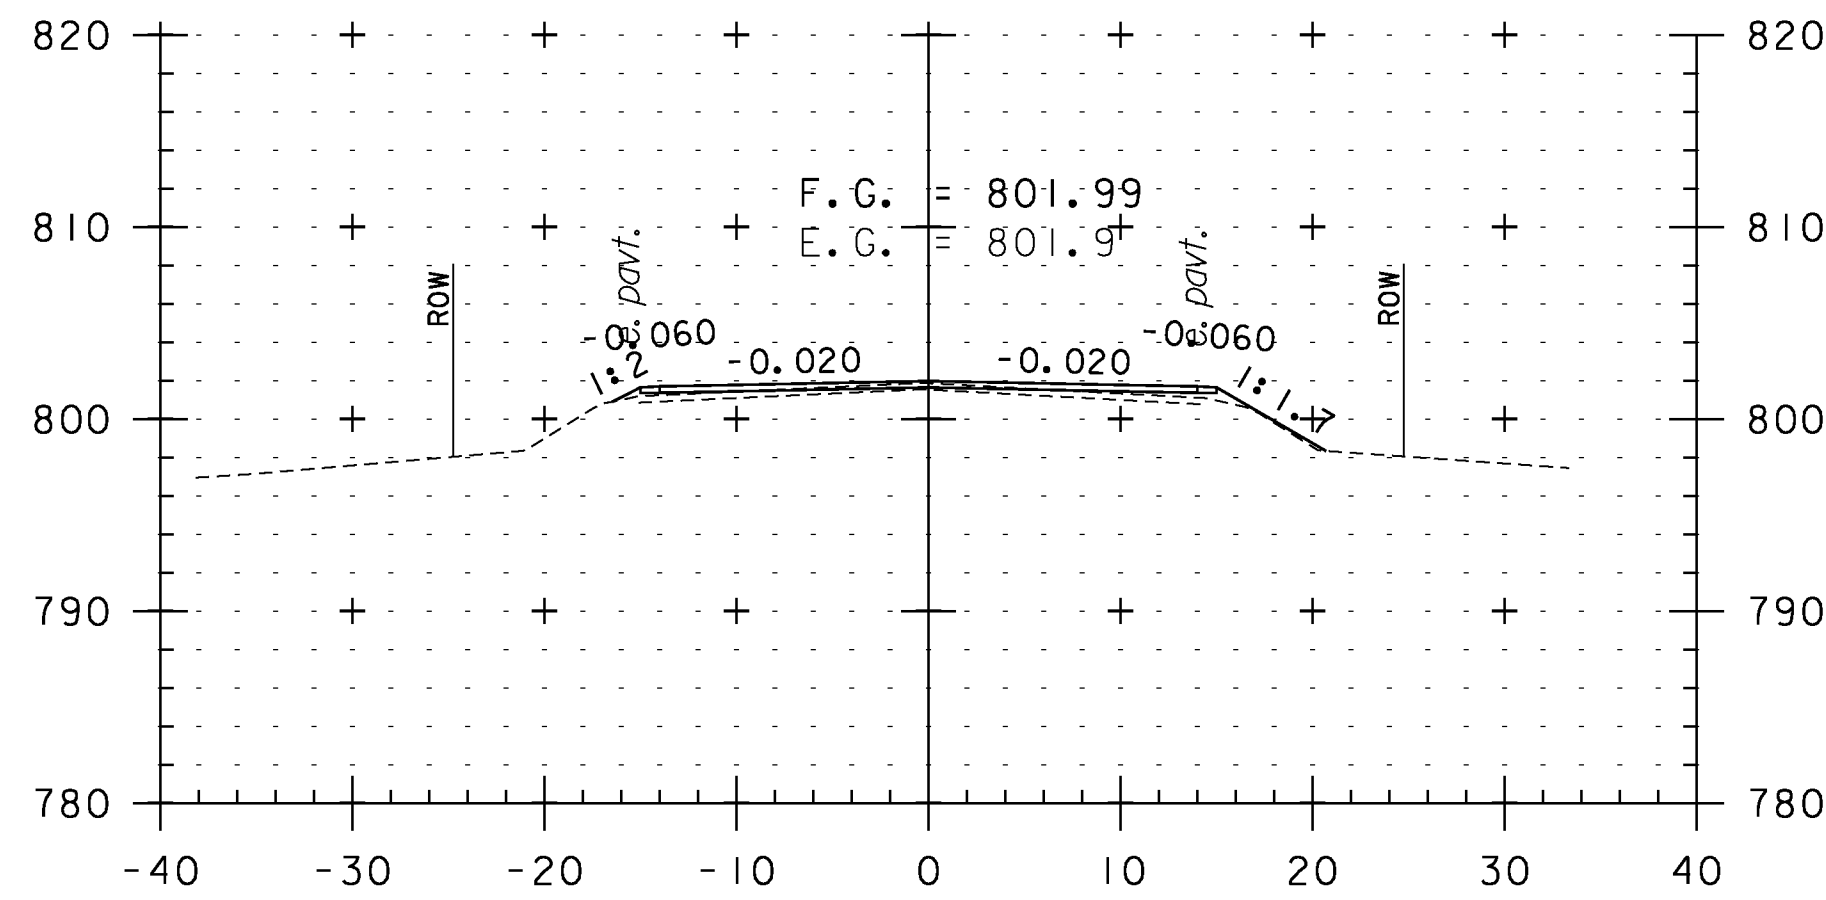


173+00

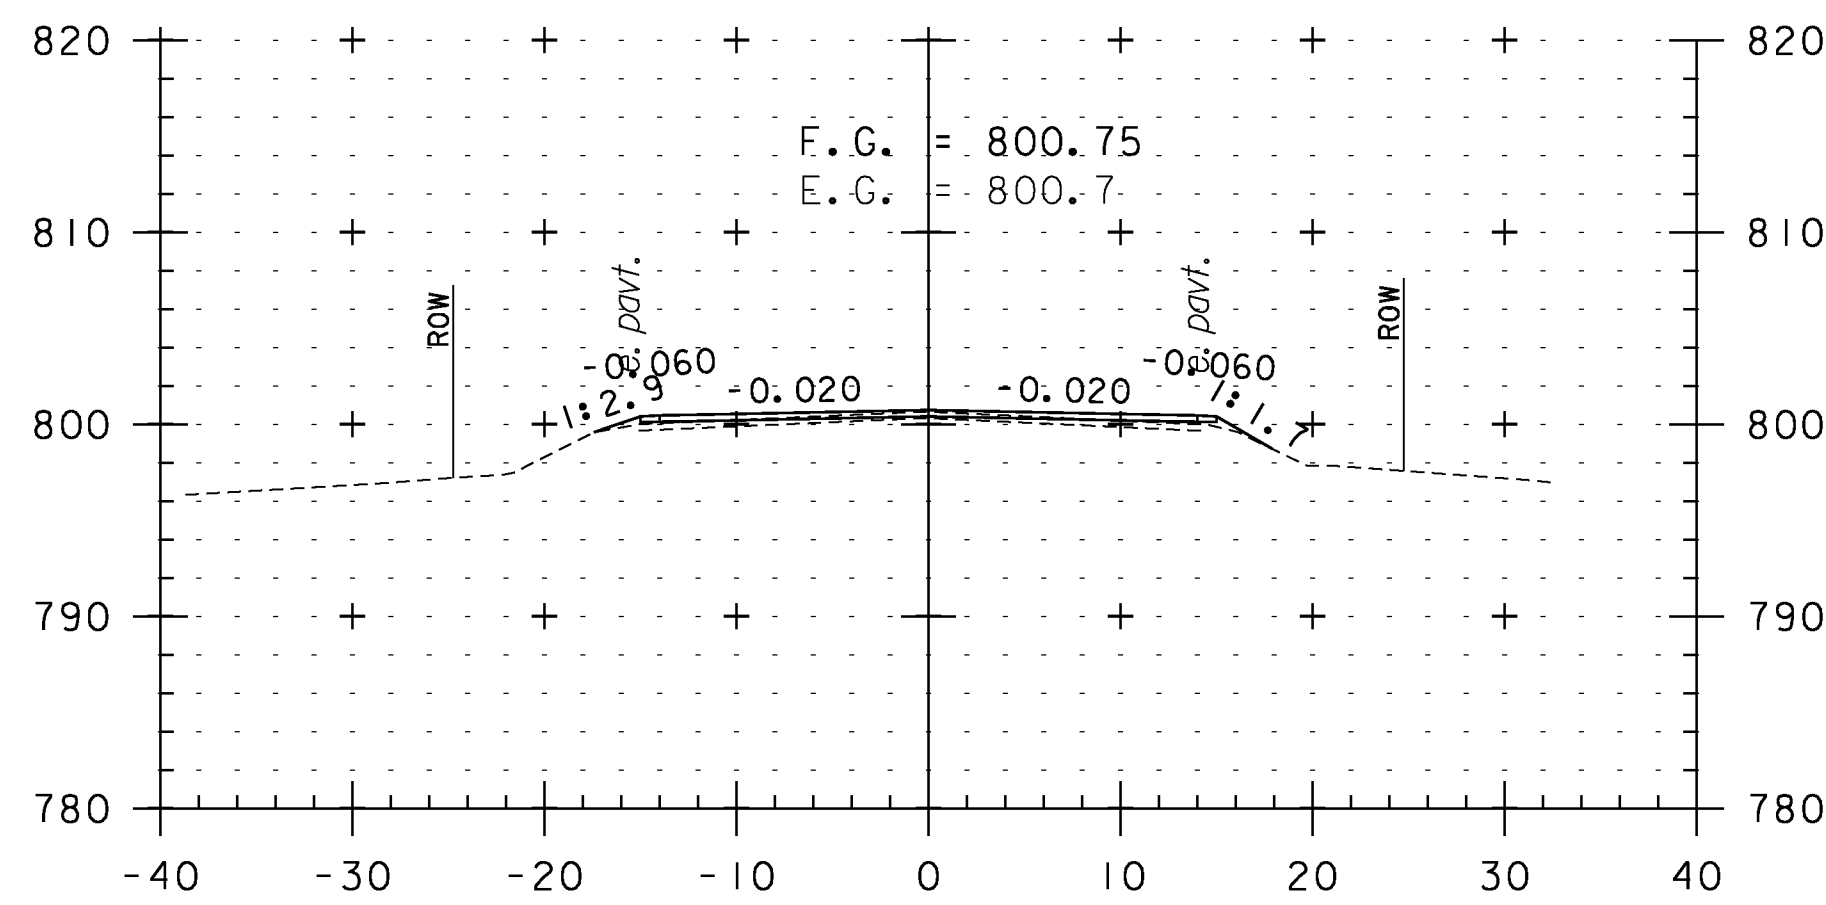


172+50

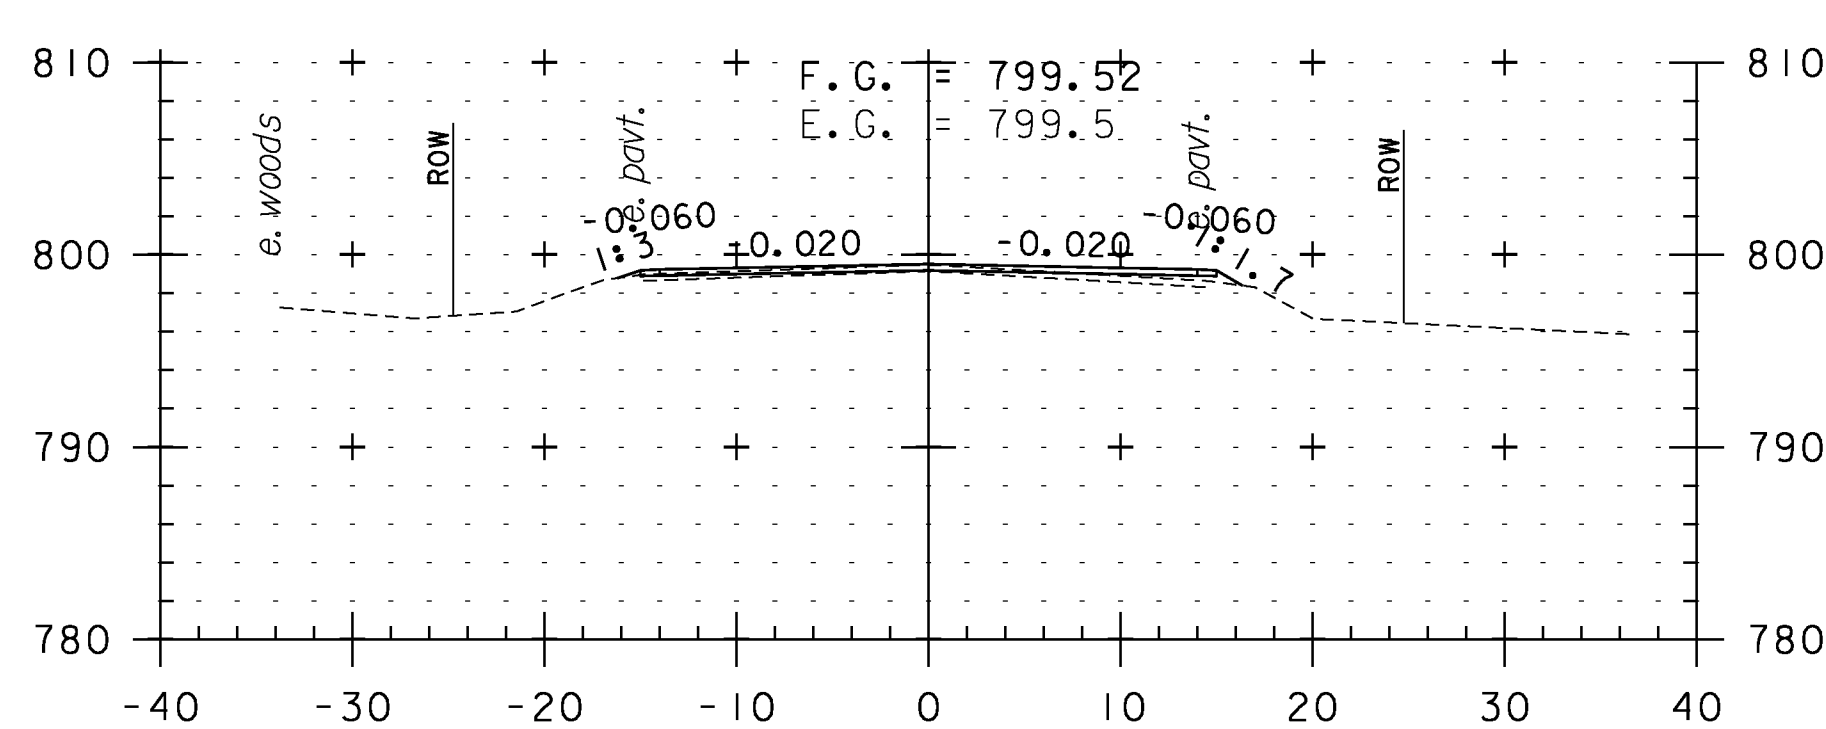


172+00

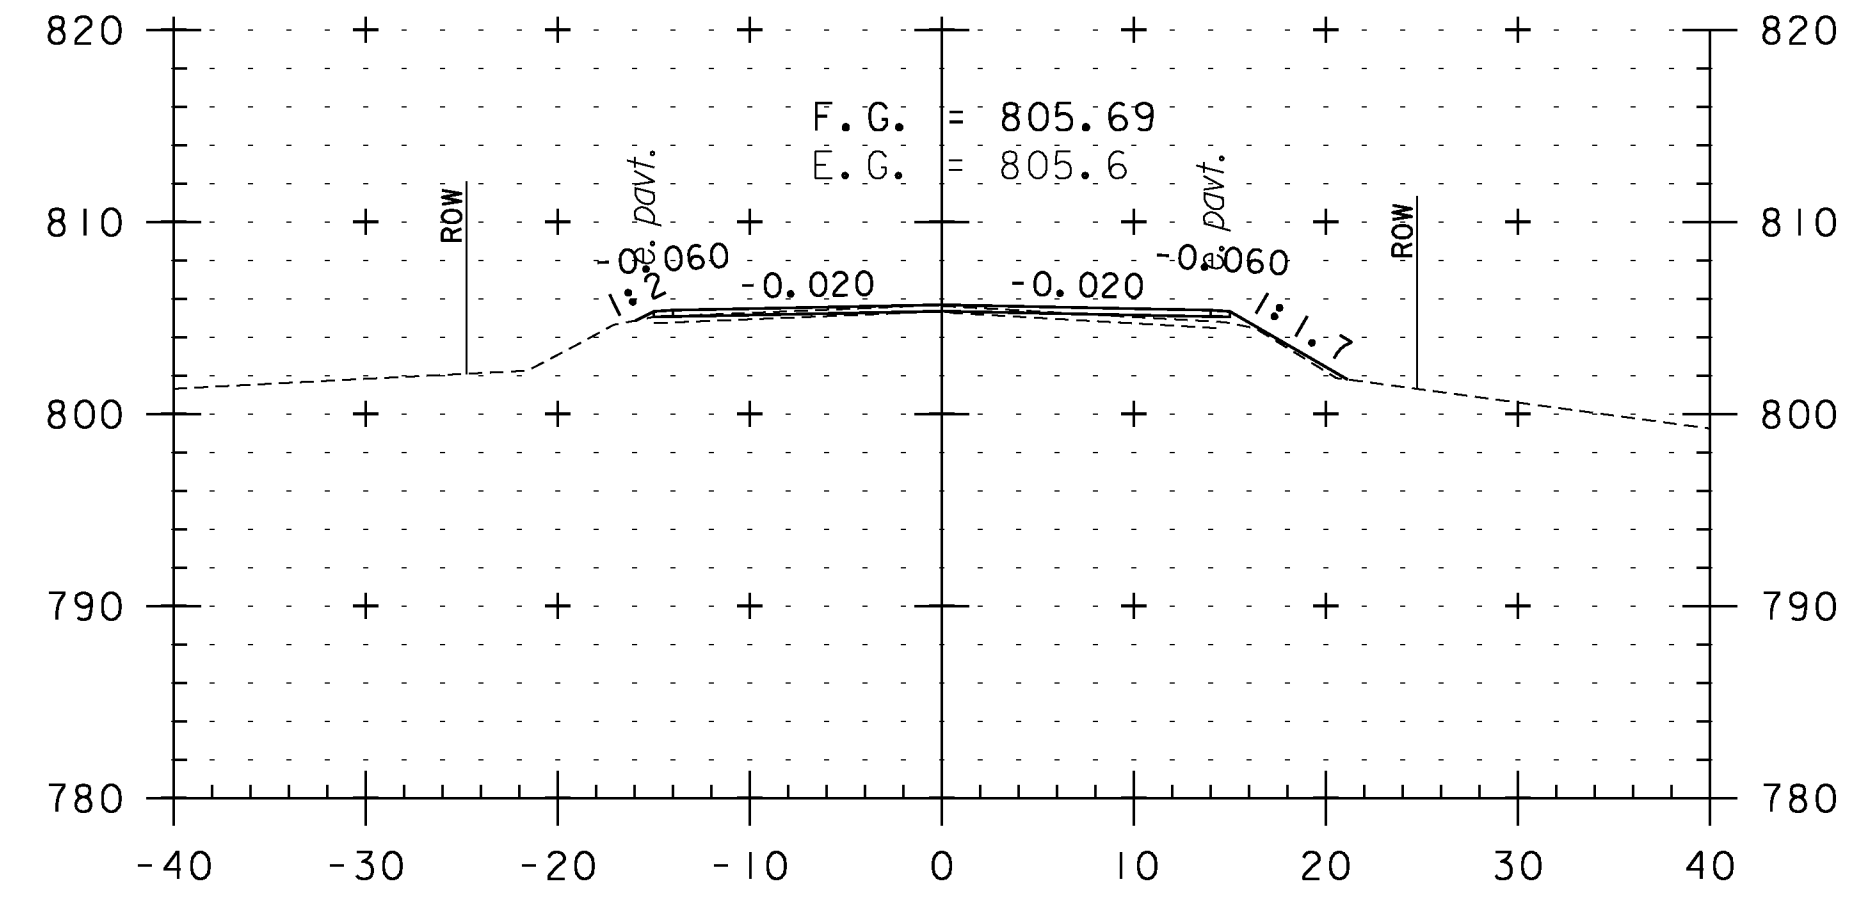

174+50

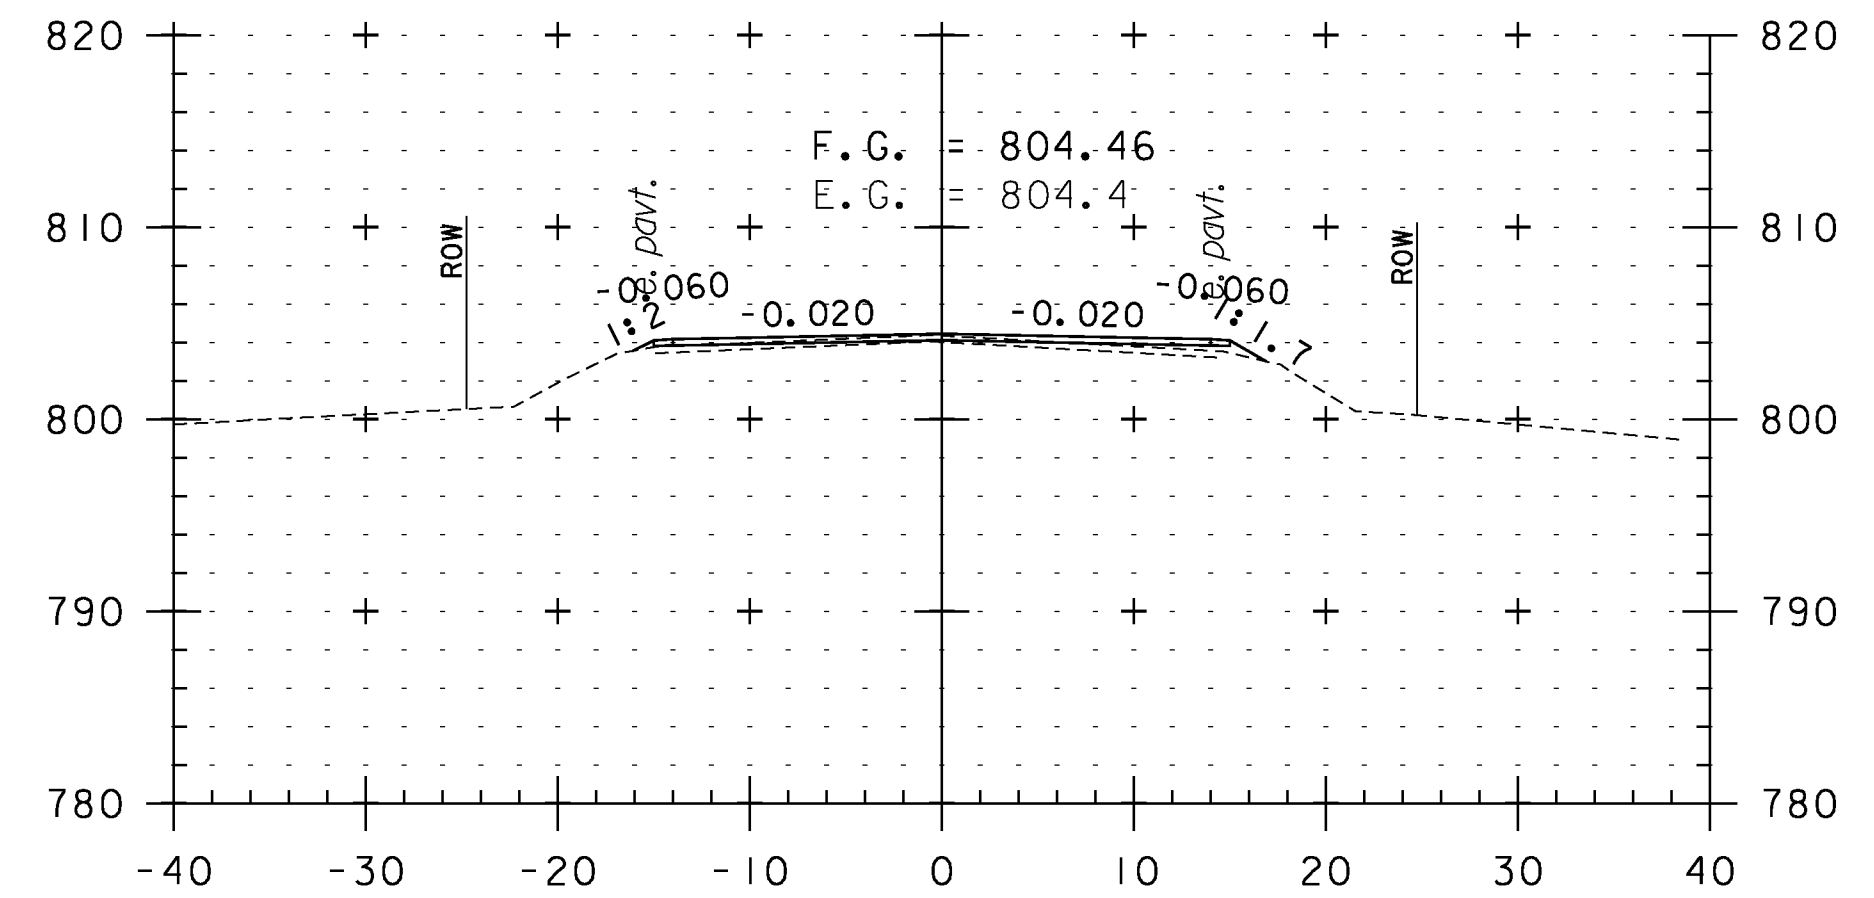

174+00

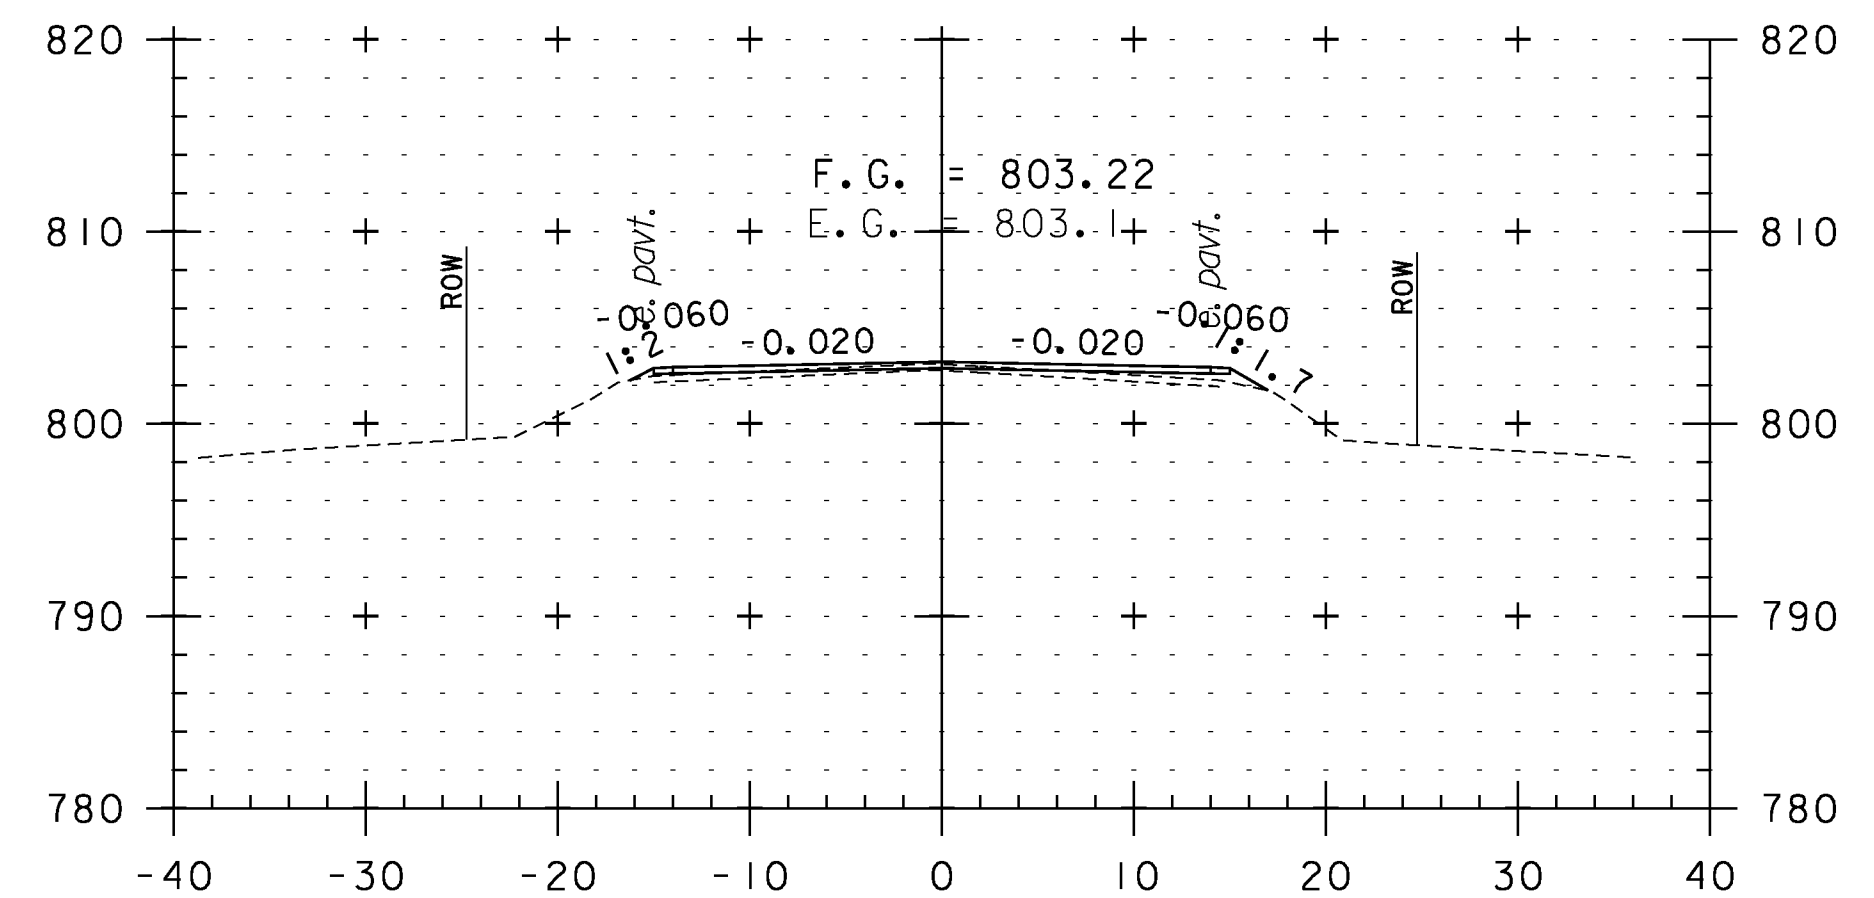

173+50

CROSS SECTION SHEET 25

PROJECT NAME: WEATHERSFIELD

PROJECT NUMBER: STP 2913(I)

FILE NAME: I0c228

PROJECT LEADER: PTS

DESIGNED BY: NLL


IPARM FILE NAME: pI0C228.I15

PLOT DATE: 2/7/2013

DRAWN BY: WWG

CHECKED BY: PTS

SHEET 115 OF 234

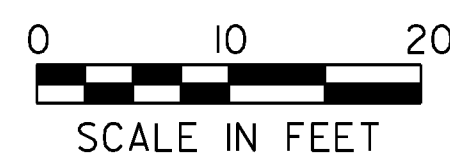

STA. 170+50 TO STA. 174+50