




180+45
TH 5

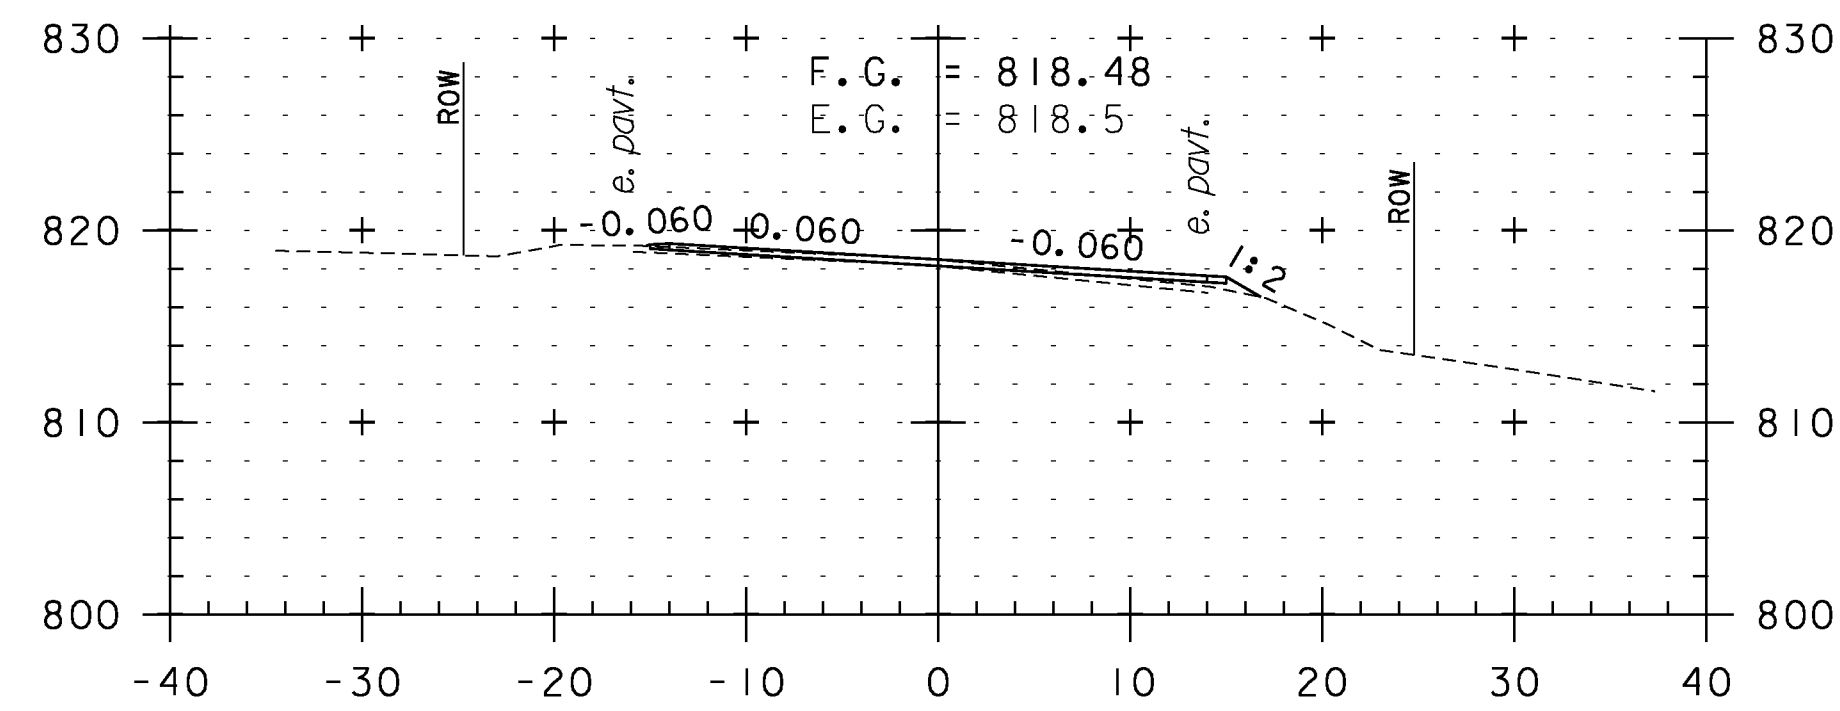


180+00

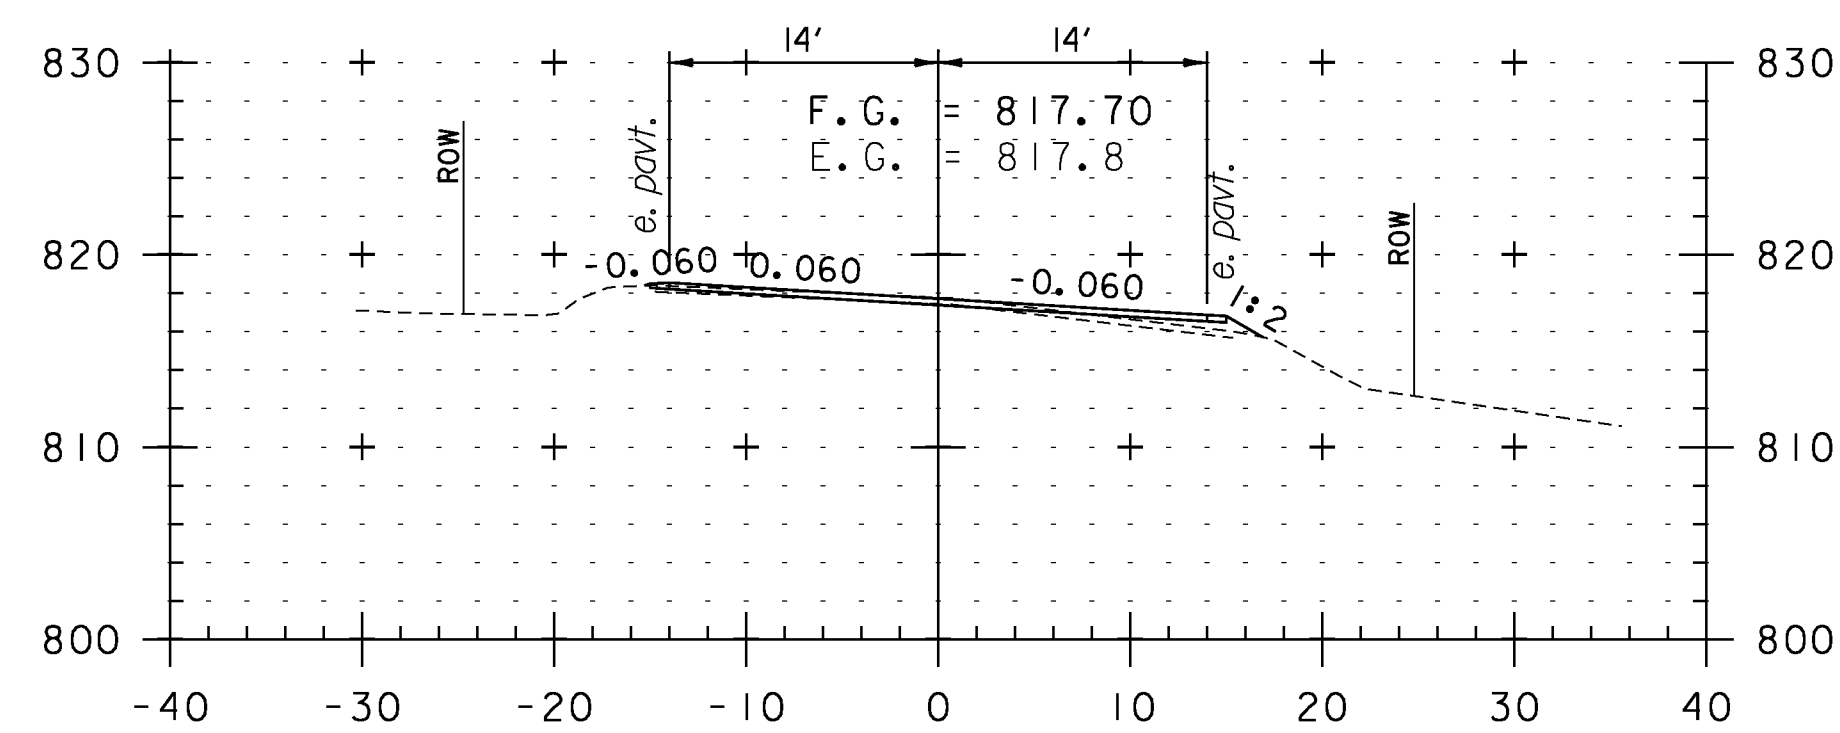


179+50

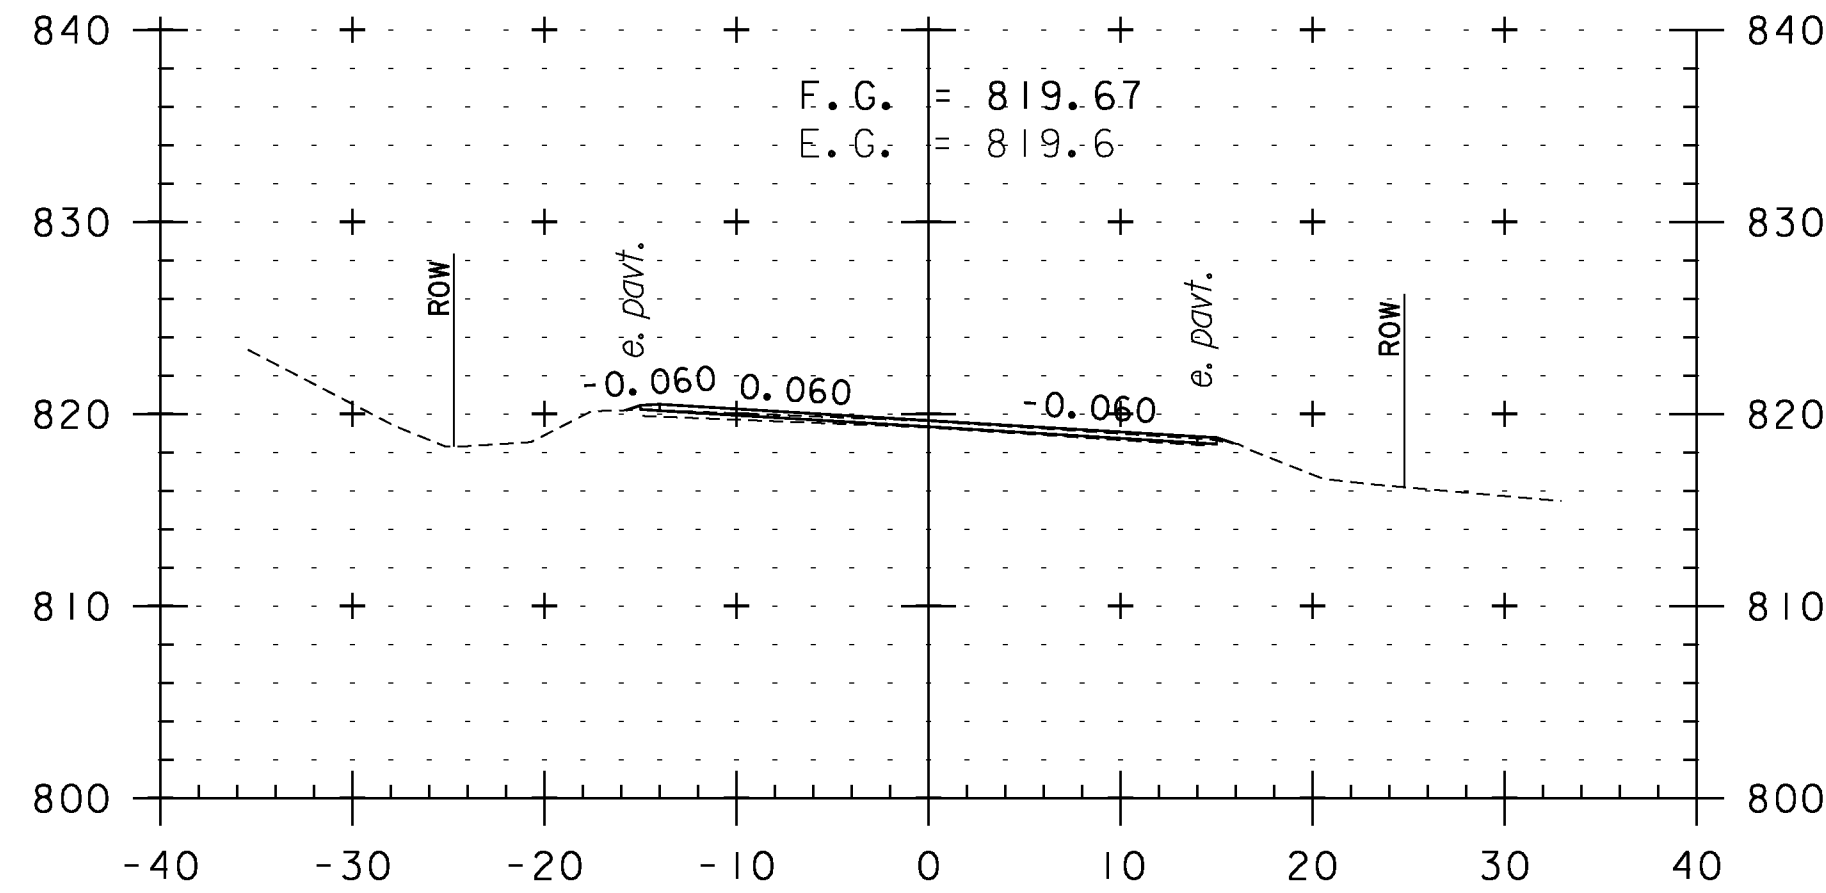


181+50

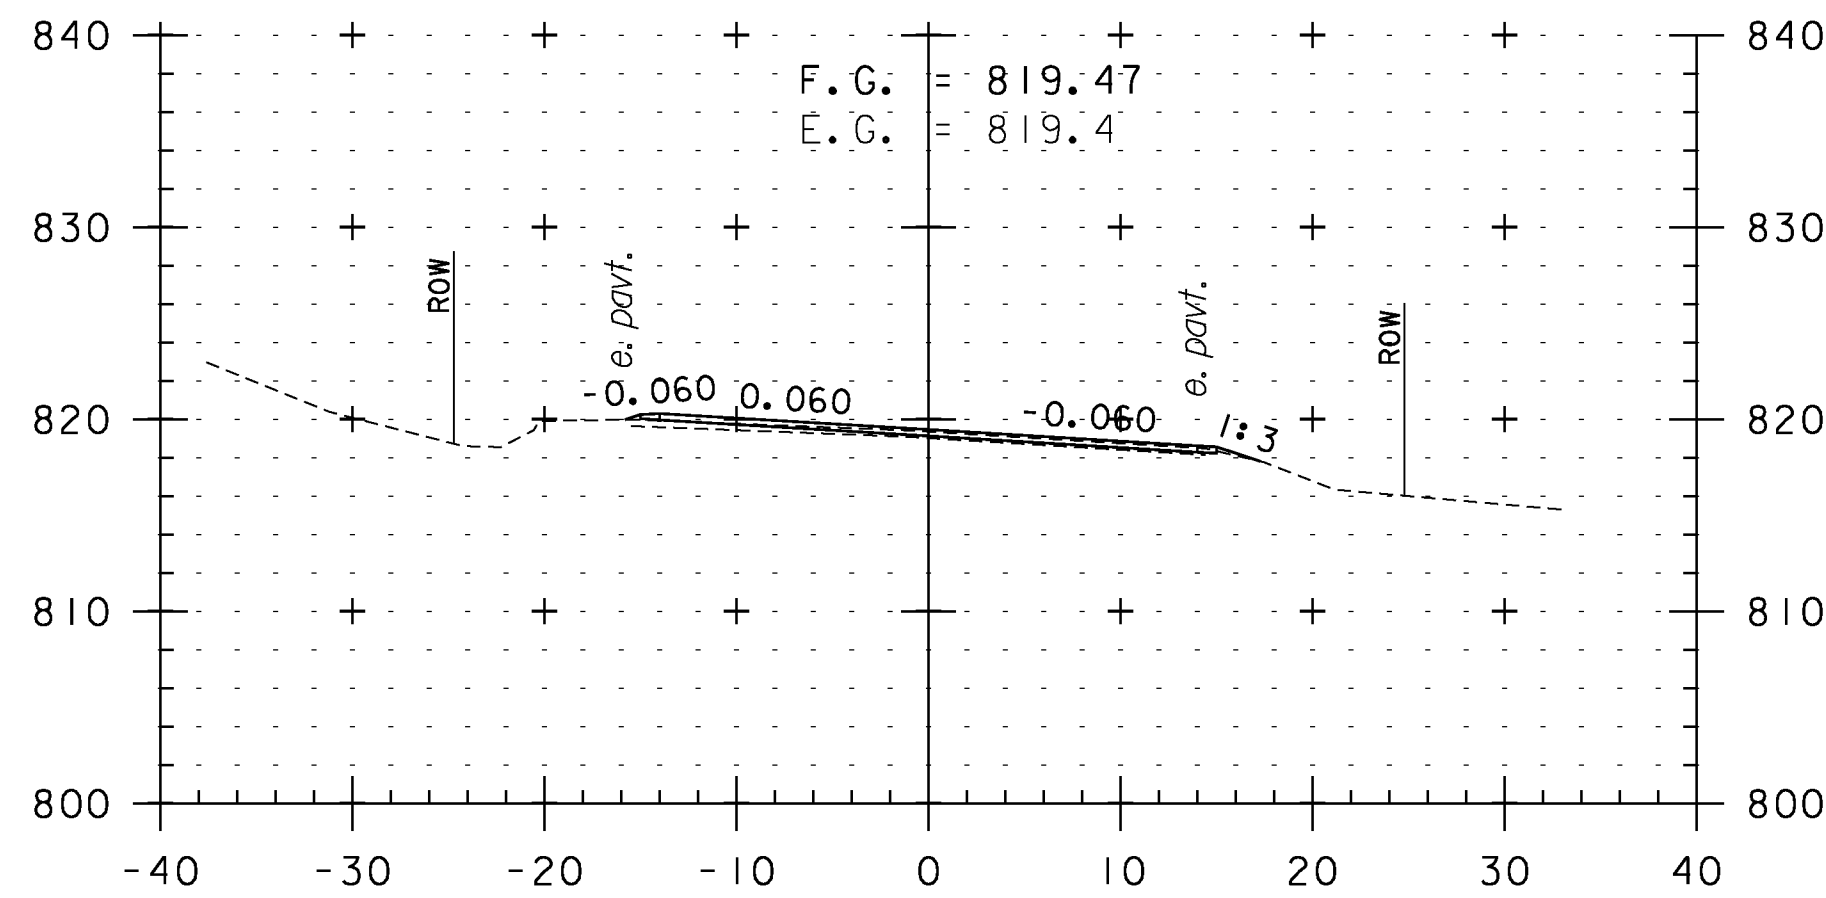


181+00

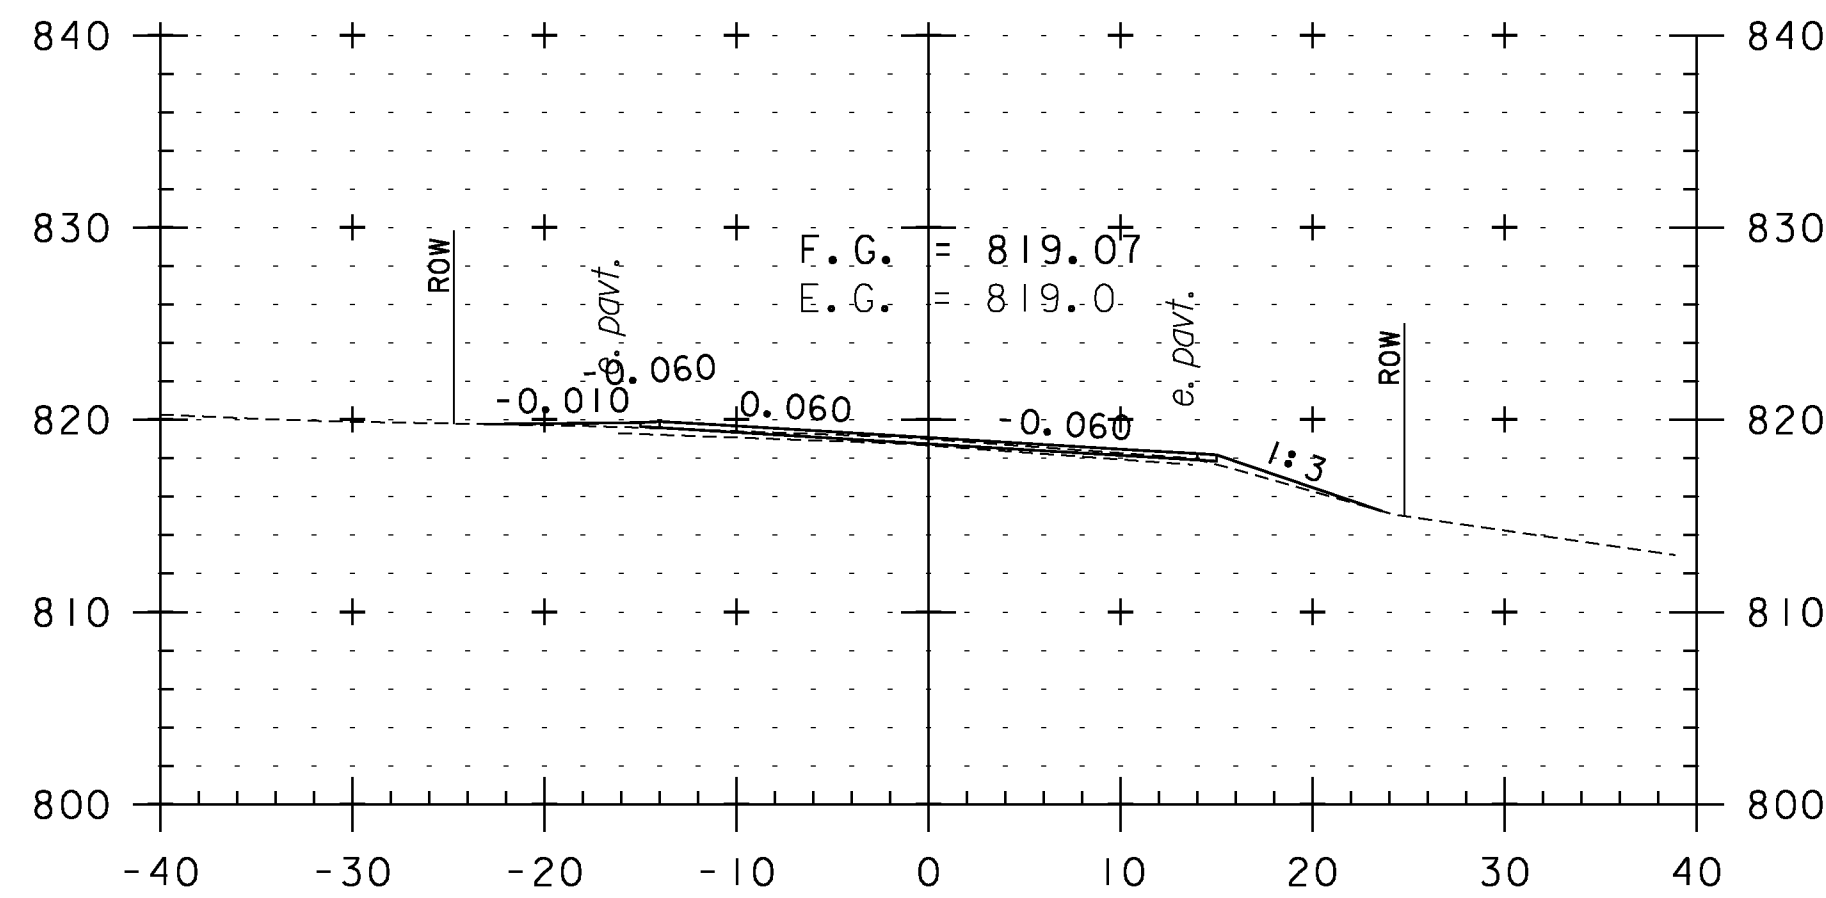


180+50

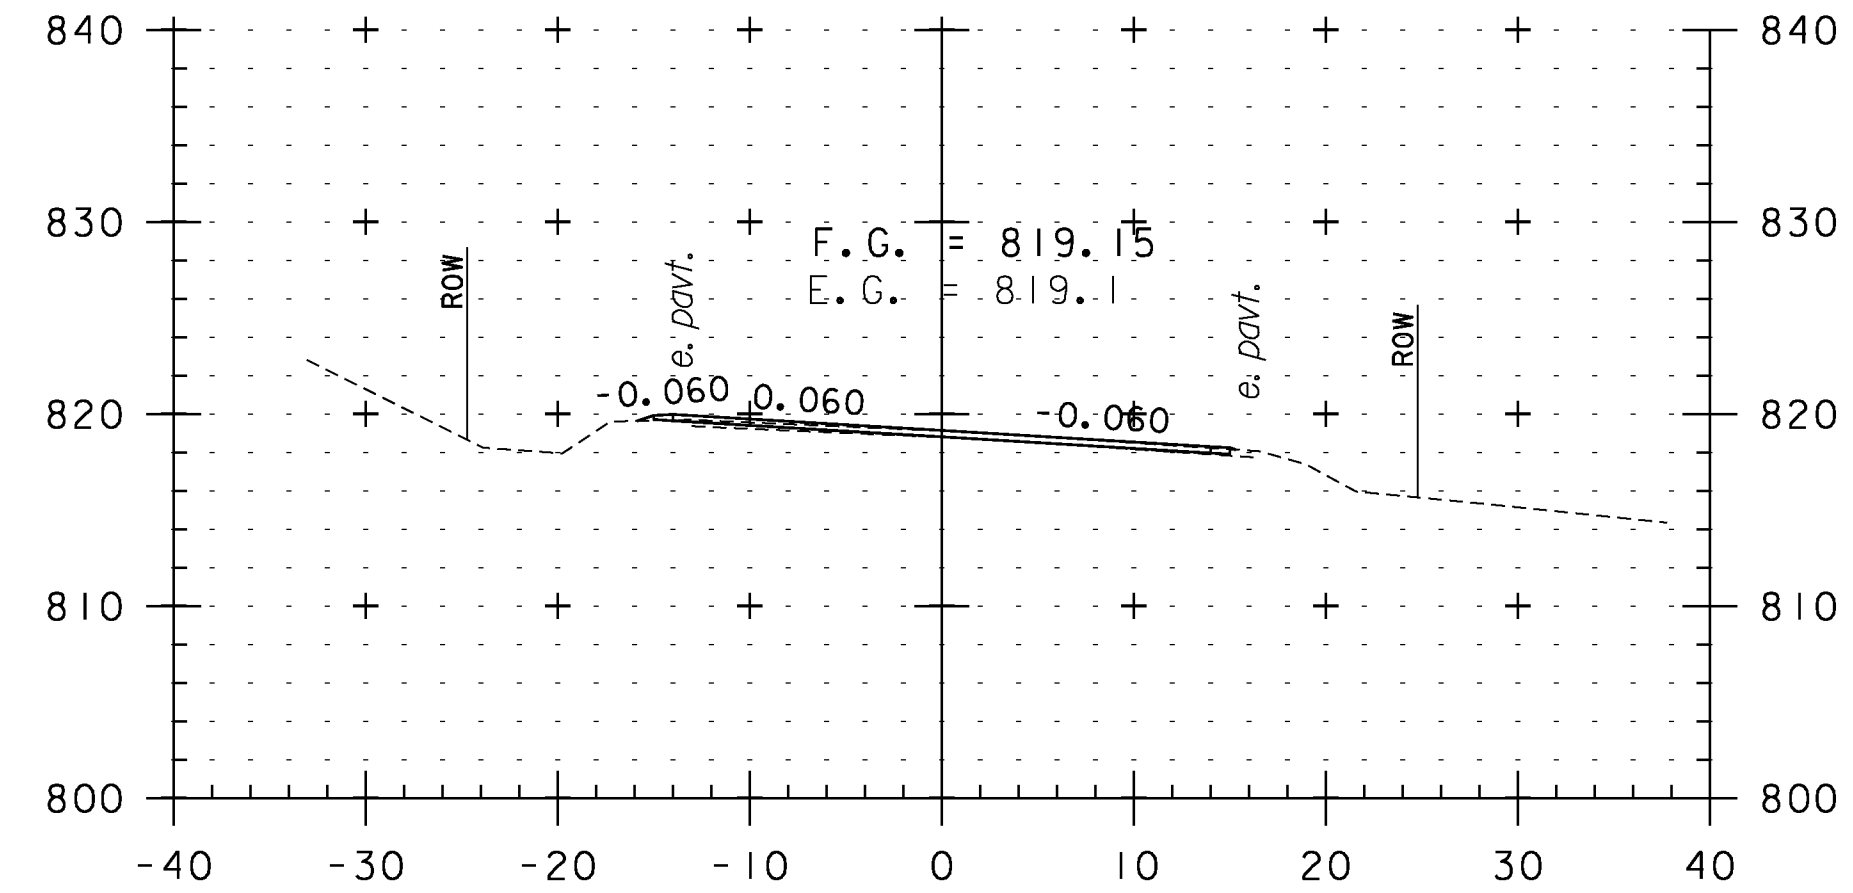

183+00

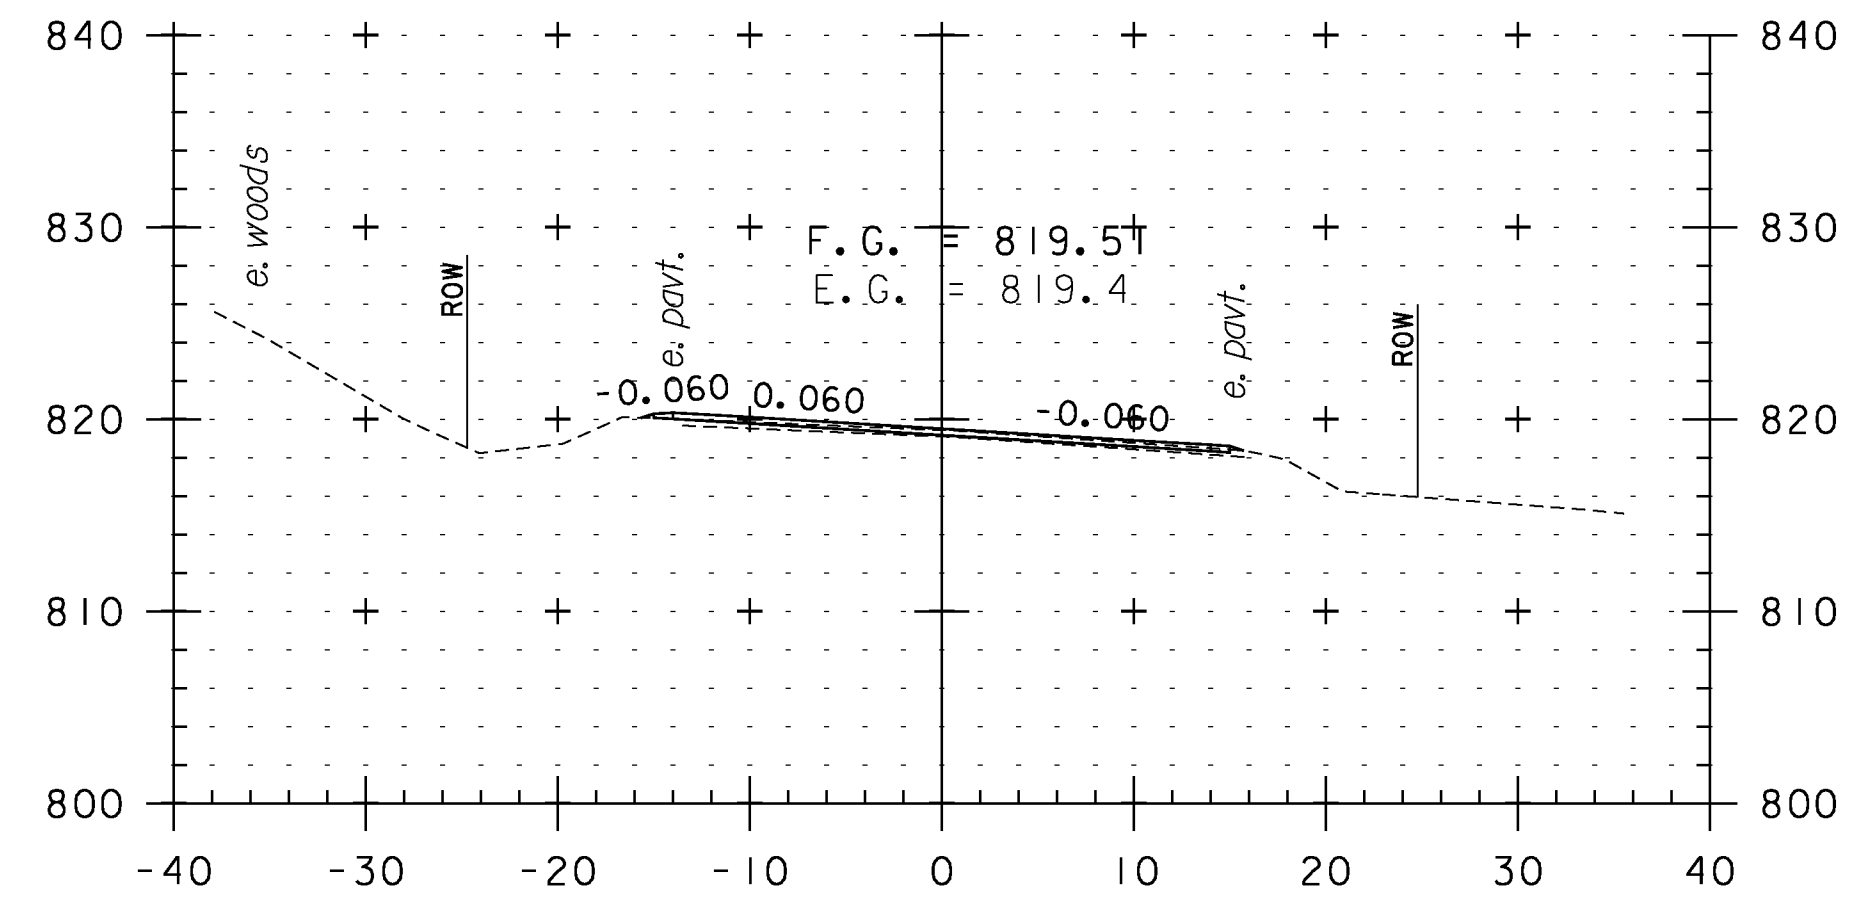

182+50

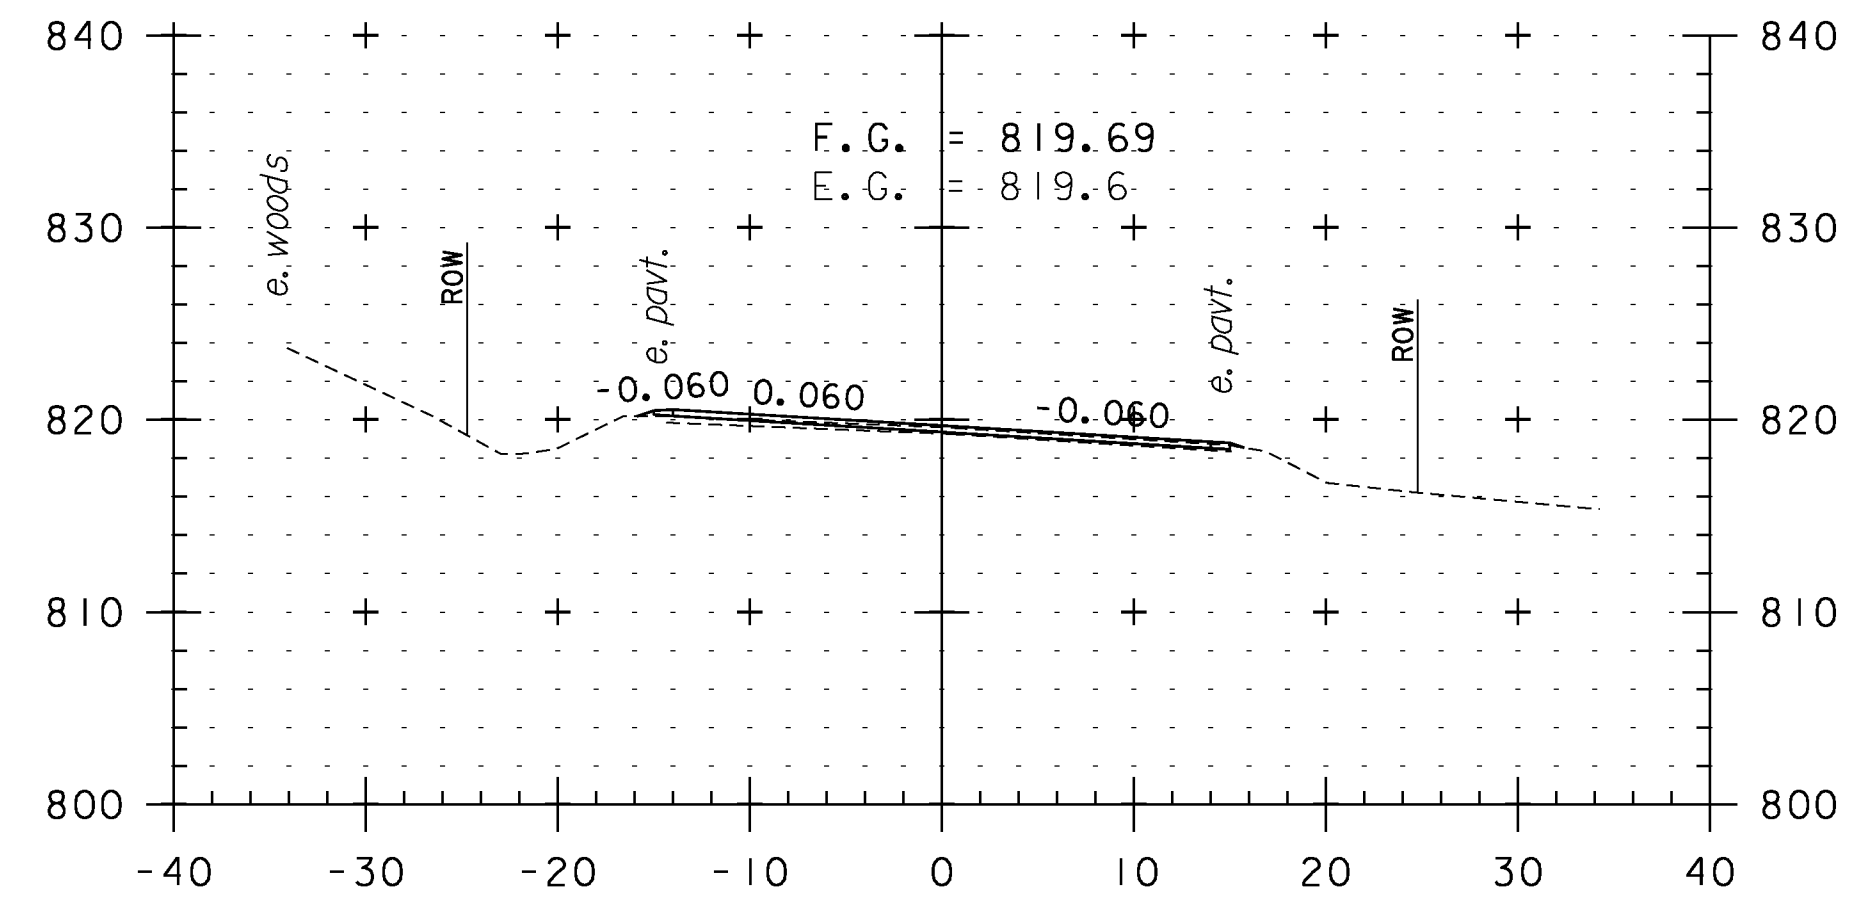

182+00

CROSS SECTION SHEET 27

PROJECT NAME: WEATHERSFIELD

PROJECT NUMBER: STP 2913(I)

FILE NAME: I0c228

PROJECT LEADER: PTS

DESIGNED BY: NLL


IPARM FILE NAME: pI0C228_I17

PLOT DATE: 2/7/2013

DRAWN BY: WWG

CHECKED BY: PTS

SHEET I17 OF 234

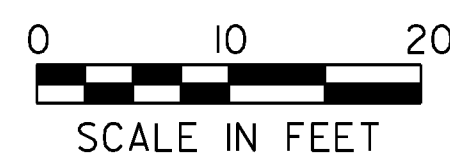

STA. 179+50 TO STA. 183+00