




188+50

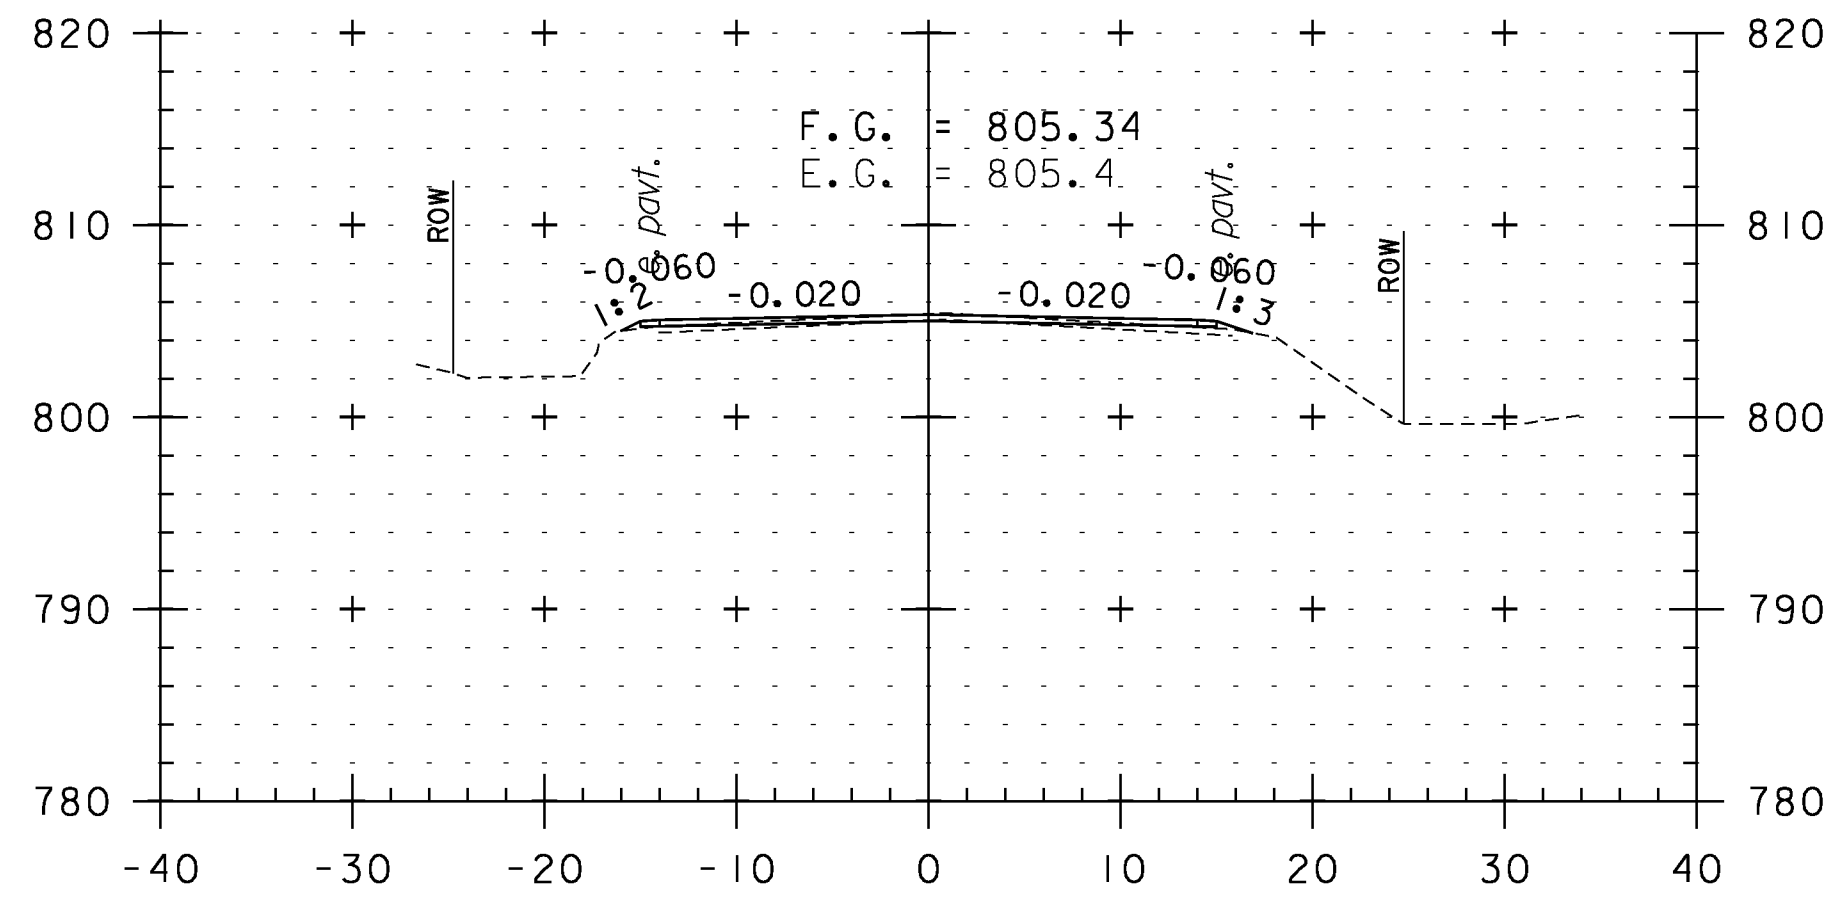


190+00

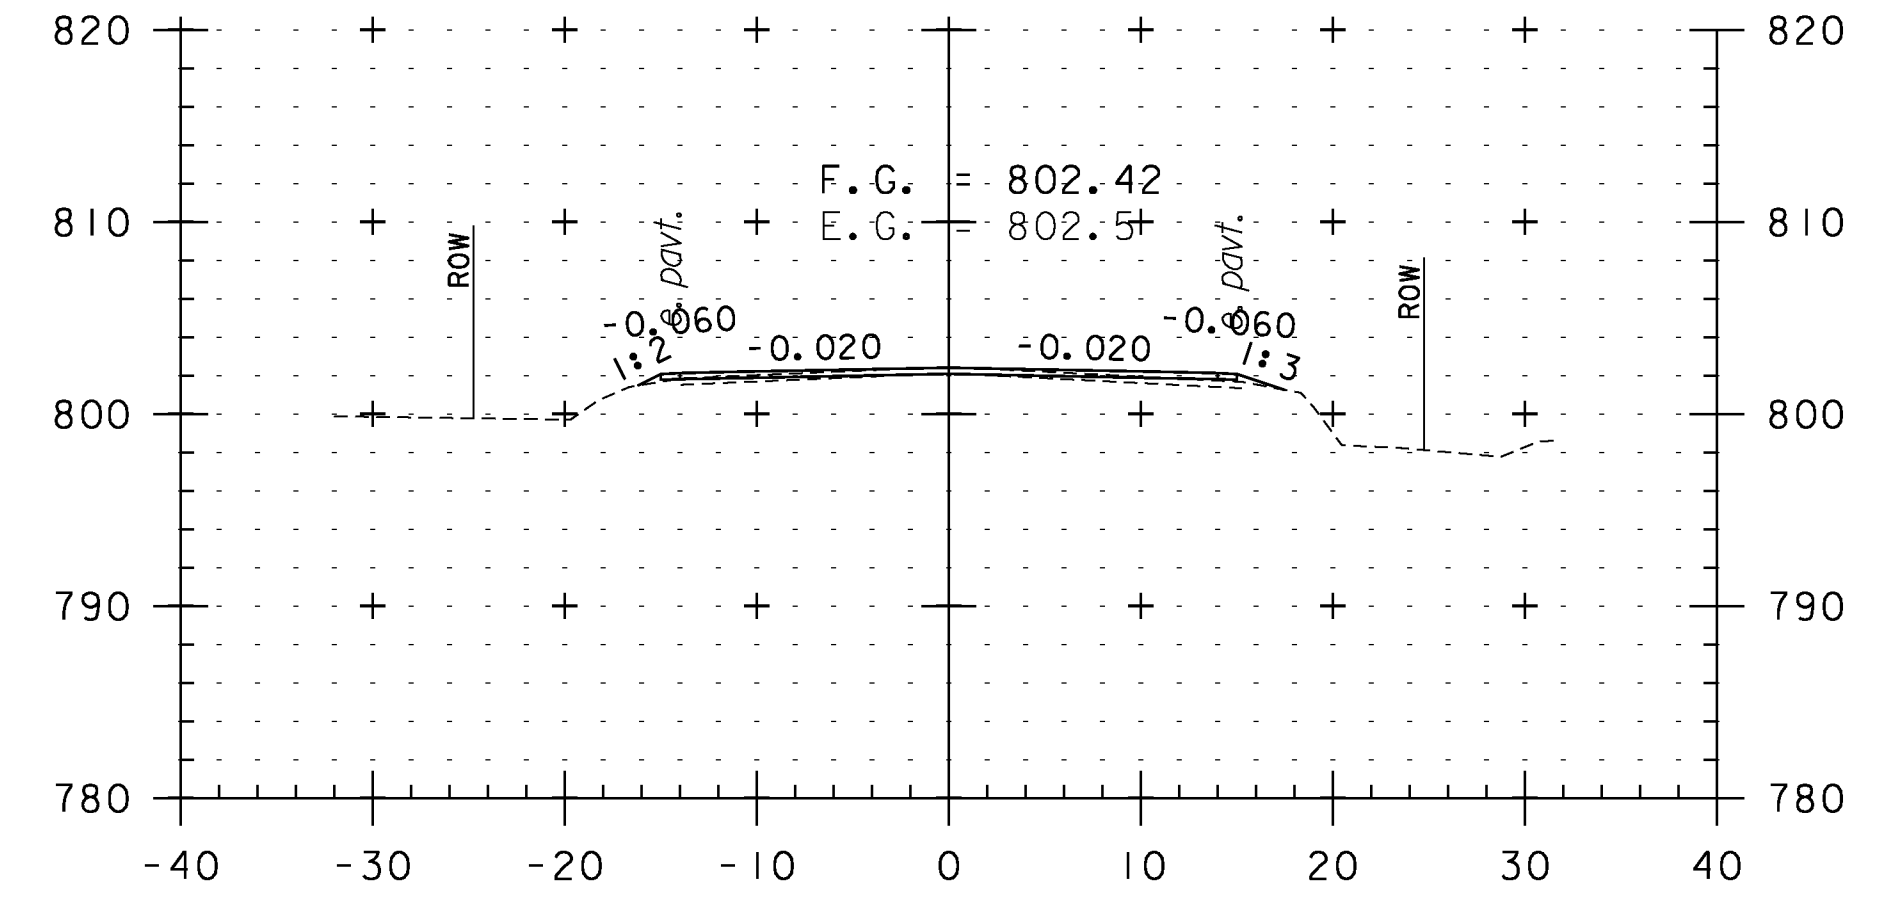


191+50

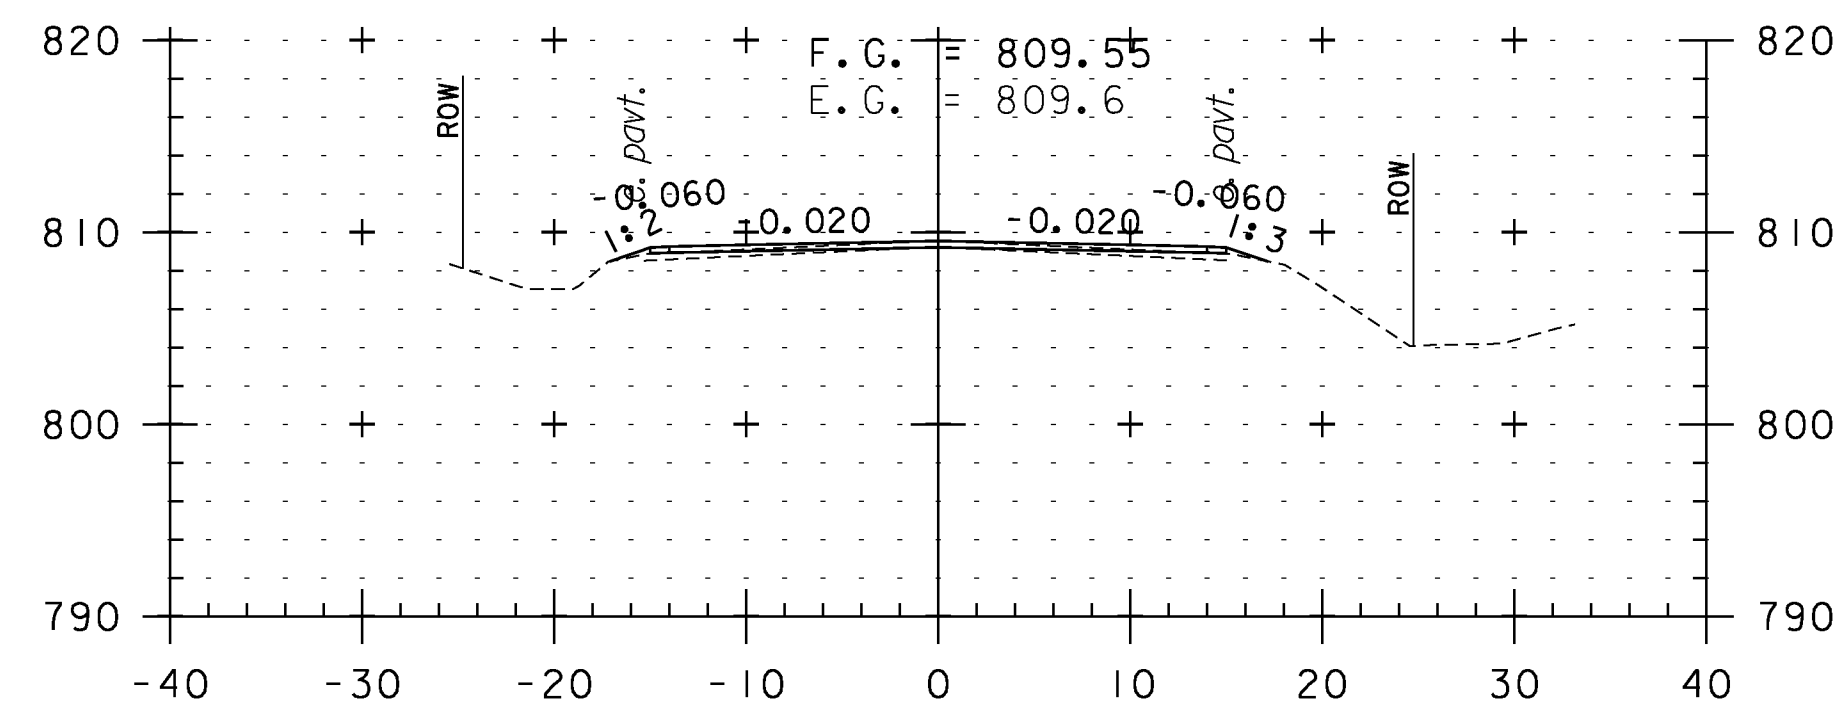


188+00

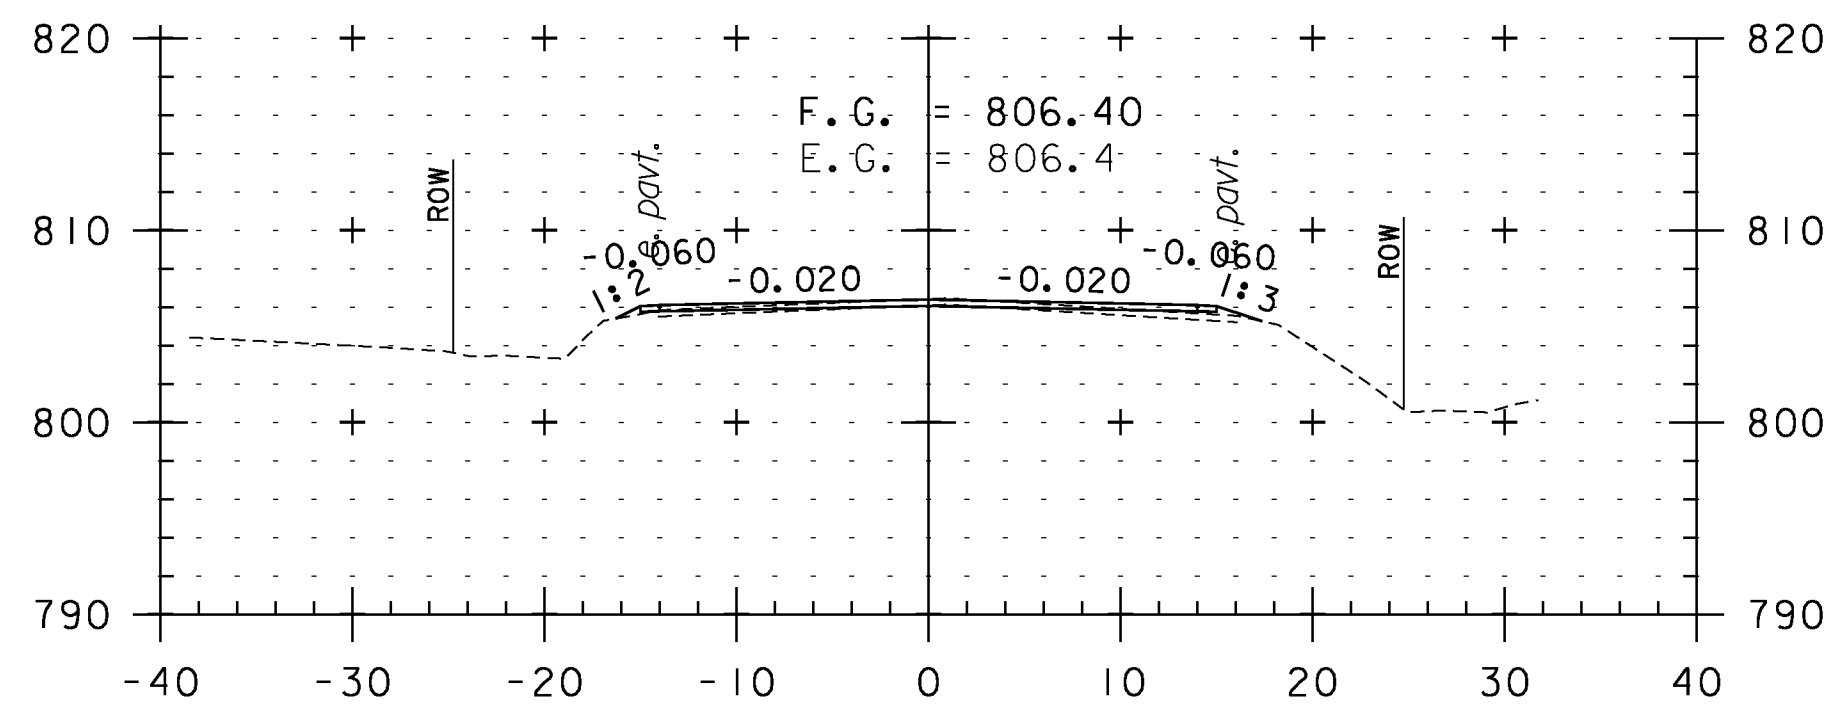


189+50

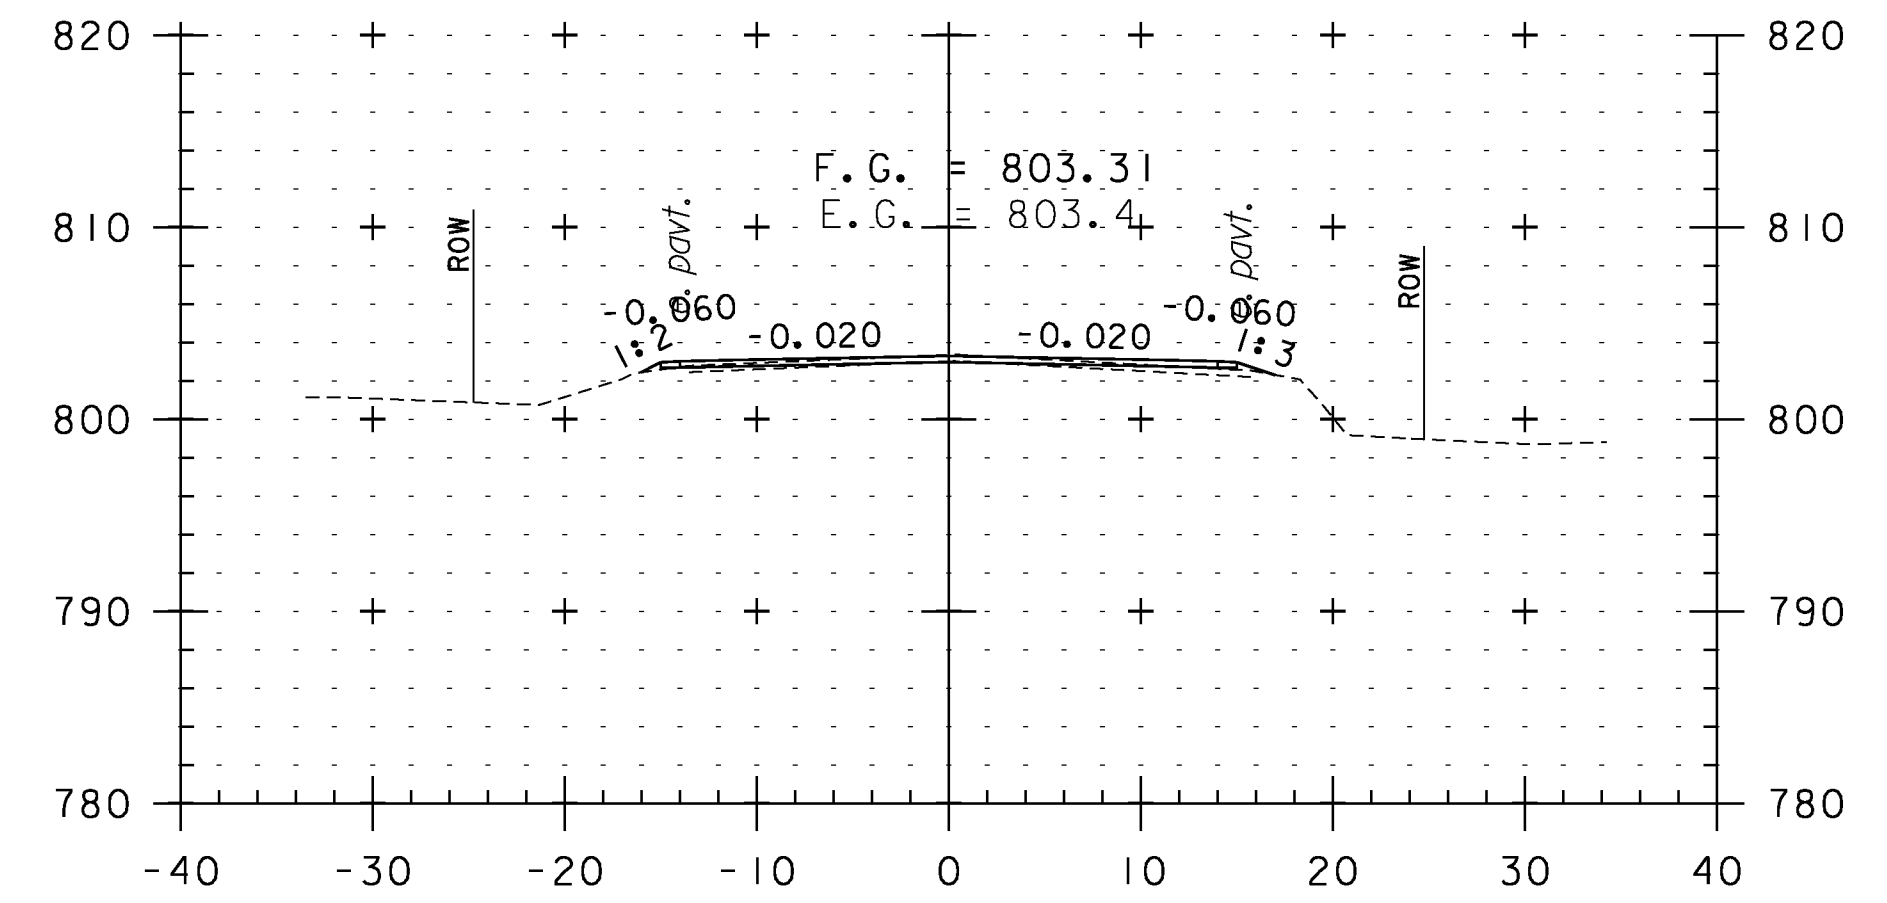


191+00

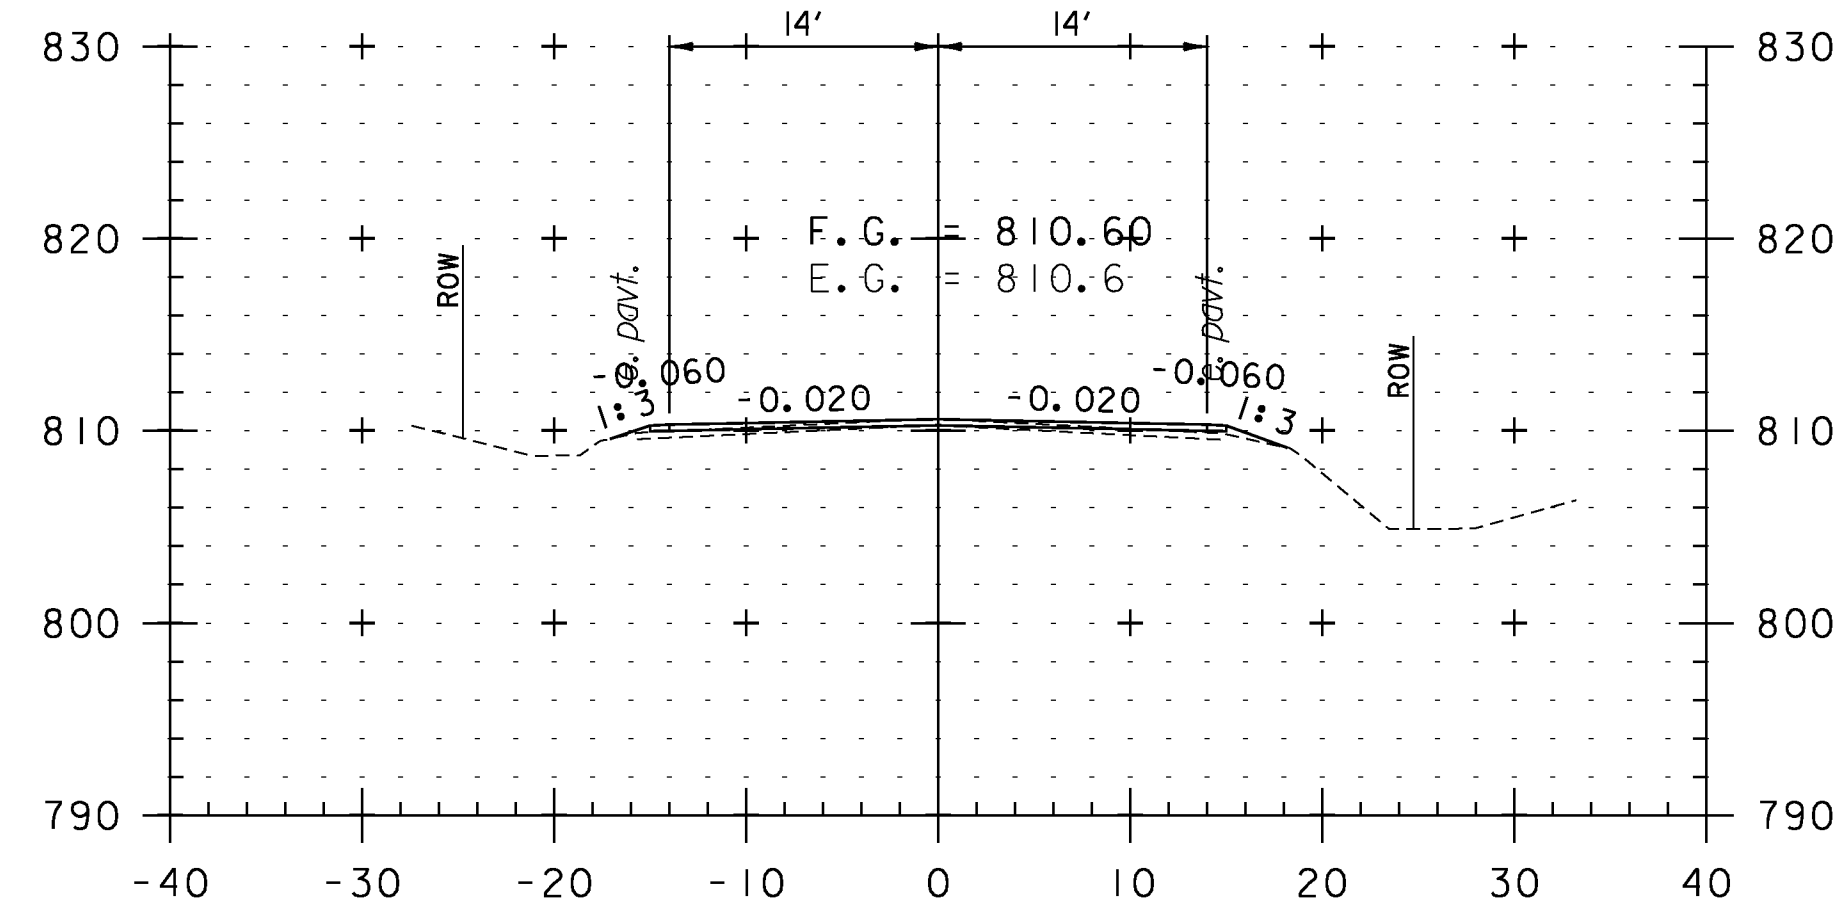

187+50

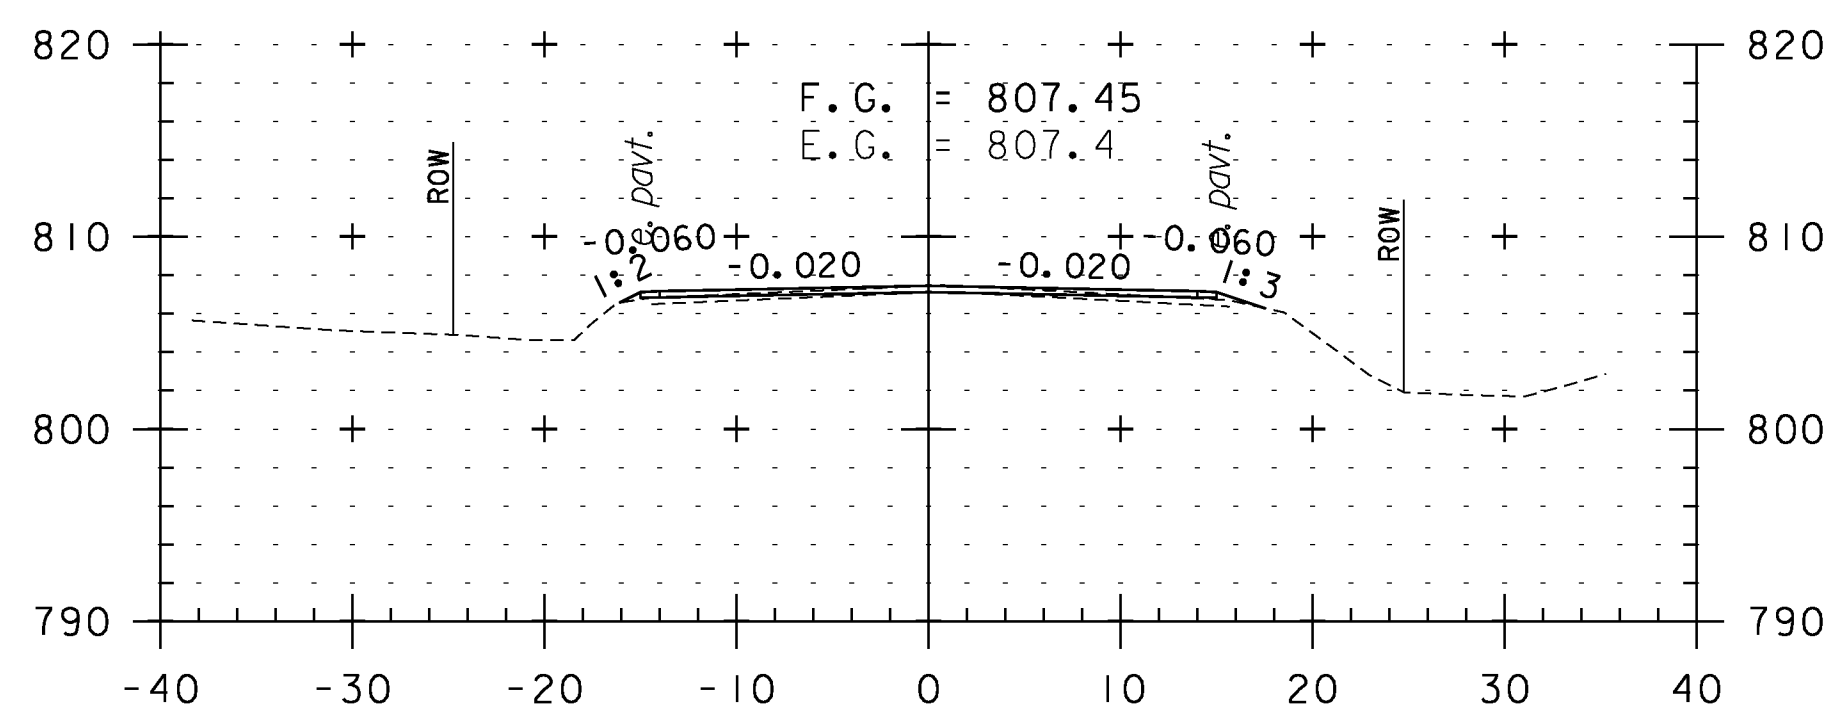

189+00

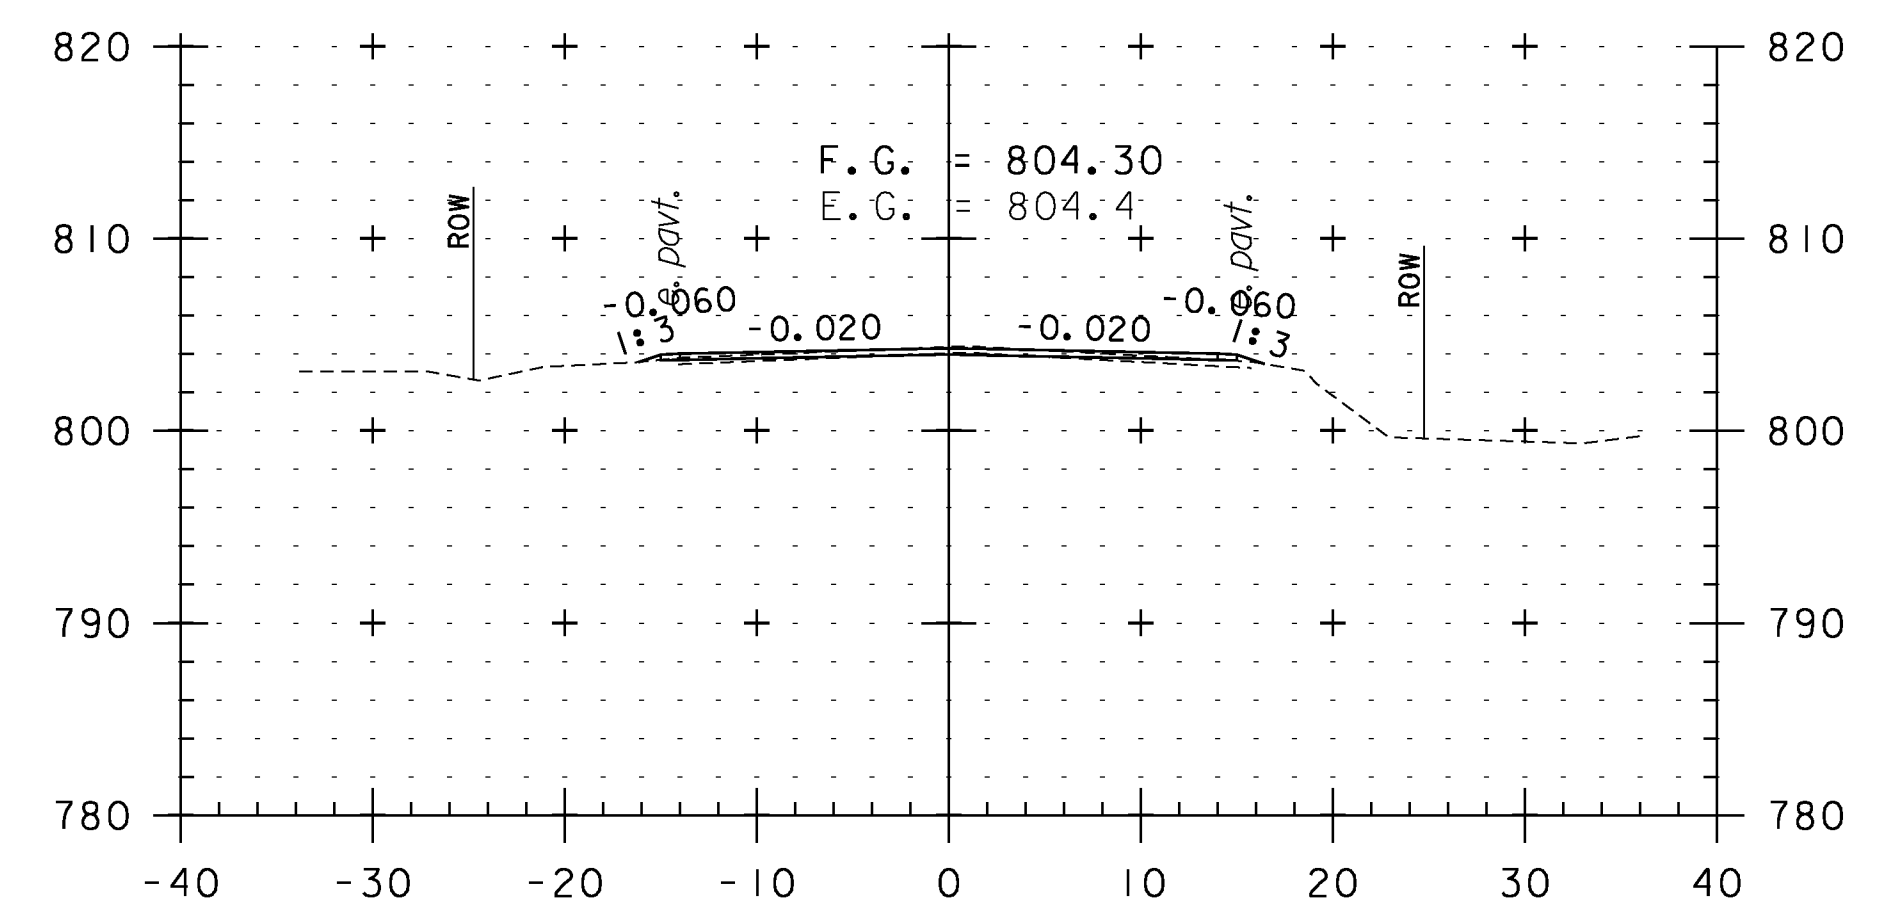

190+50

CROSS SECTION SHEET 29

PROJECT NAME: WEATHERSFIELD

PROJECT NUMBER: STP 2913(I)

FILE NAME: I0c228

PROJECT LEADER: PTS

DESIGNED BY: NLL


IPARM FILE NAME: pI0C228.I19

PLOT DATE: 2/7/2013

DRAWN BY: WWG

CHECKED BY: PTS

SHEET I19 OF 234

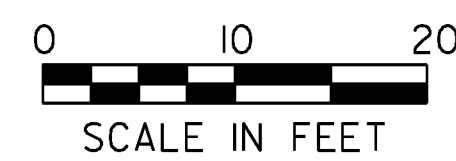

STA. 187+50 TO STA. 191+50