




197+50

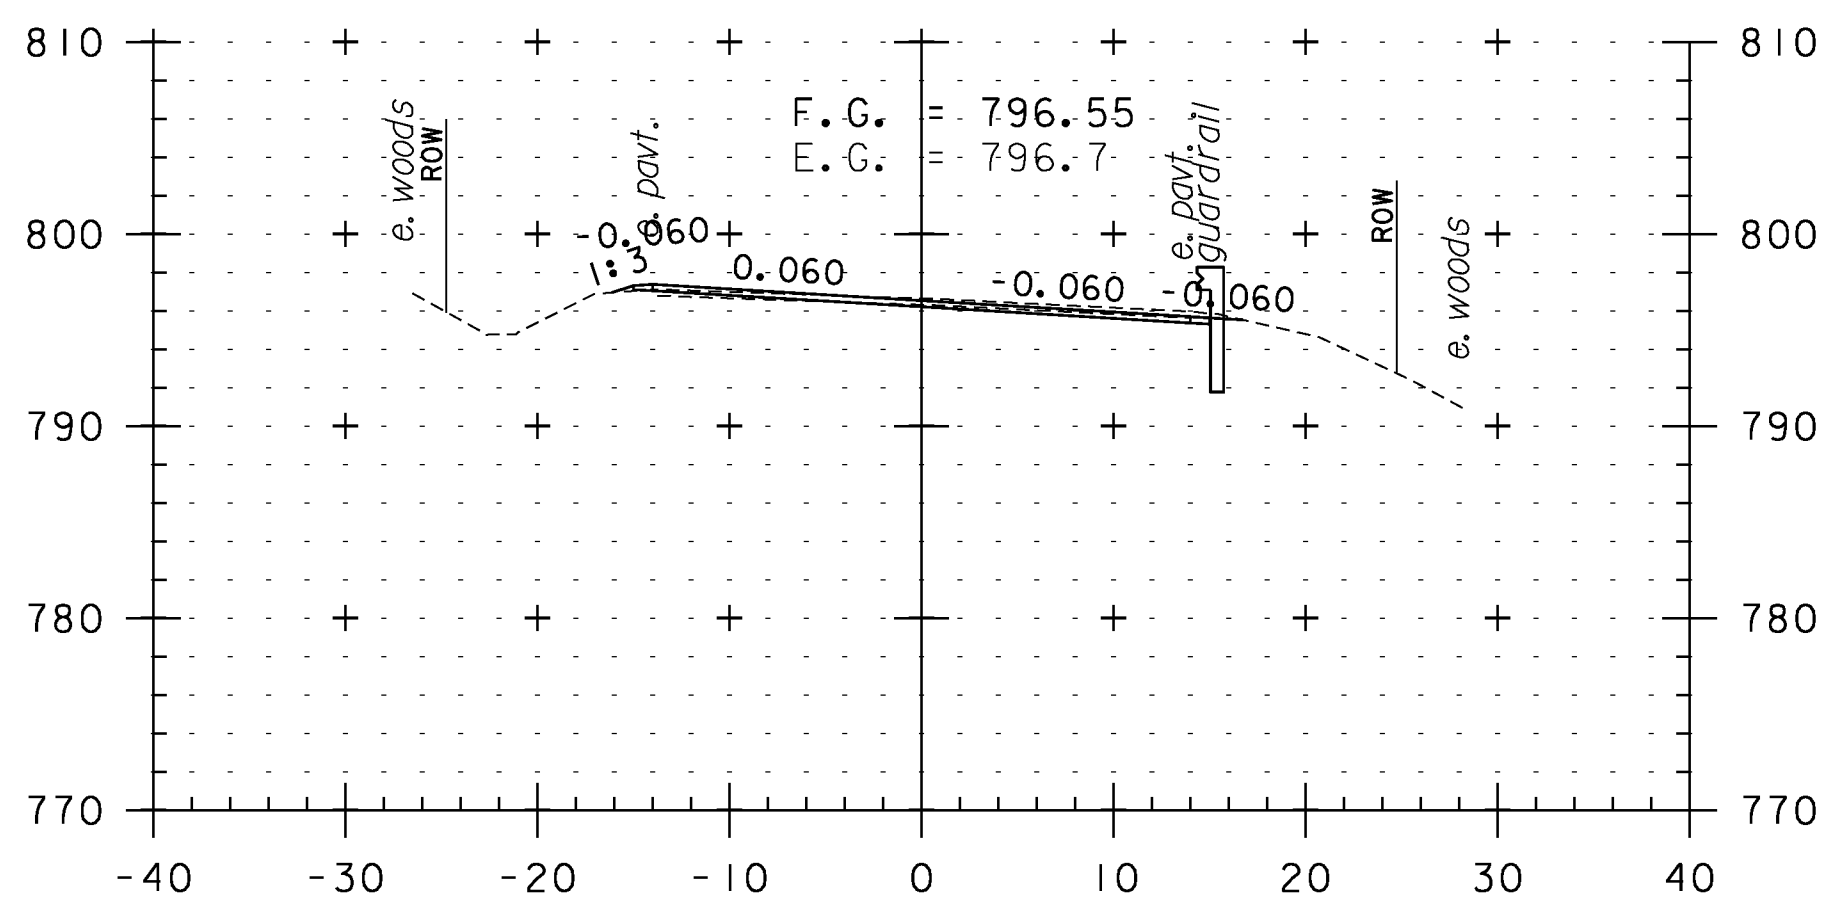


199+00

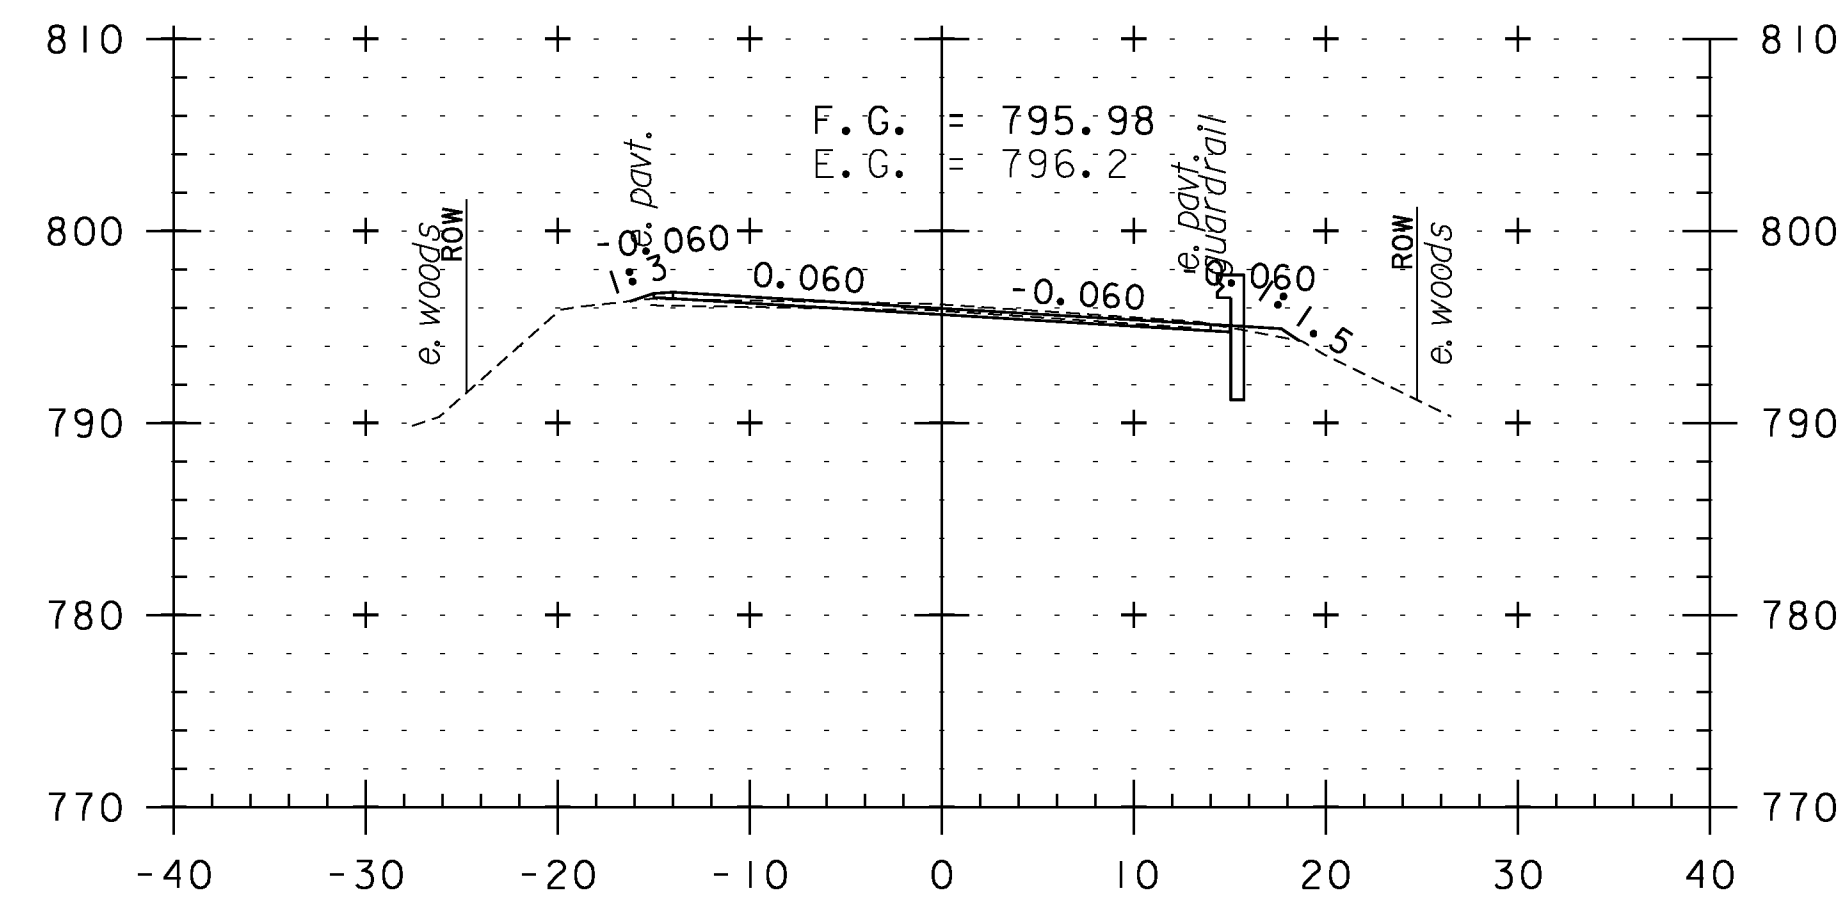


200+00

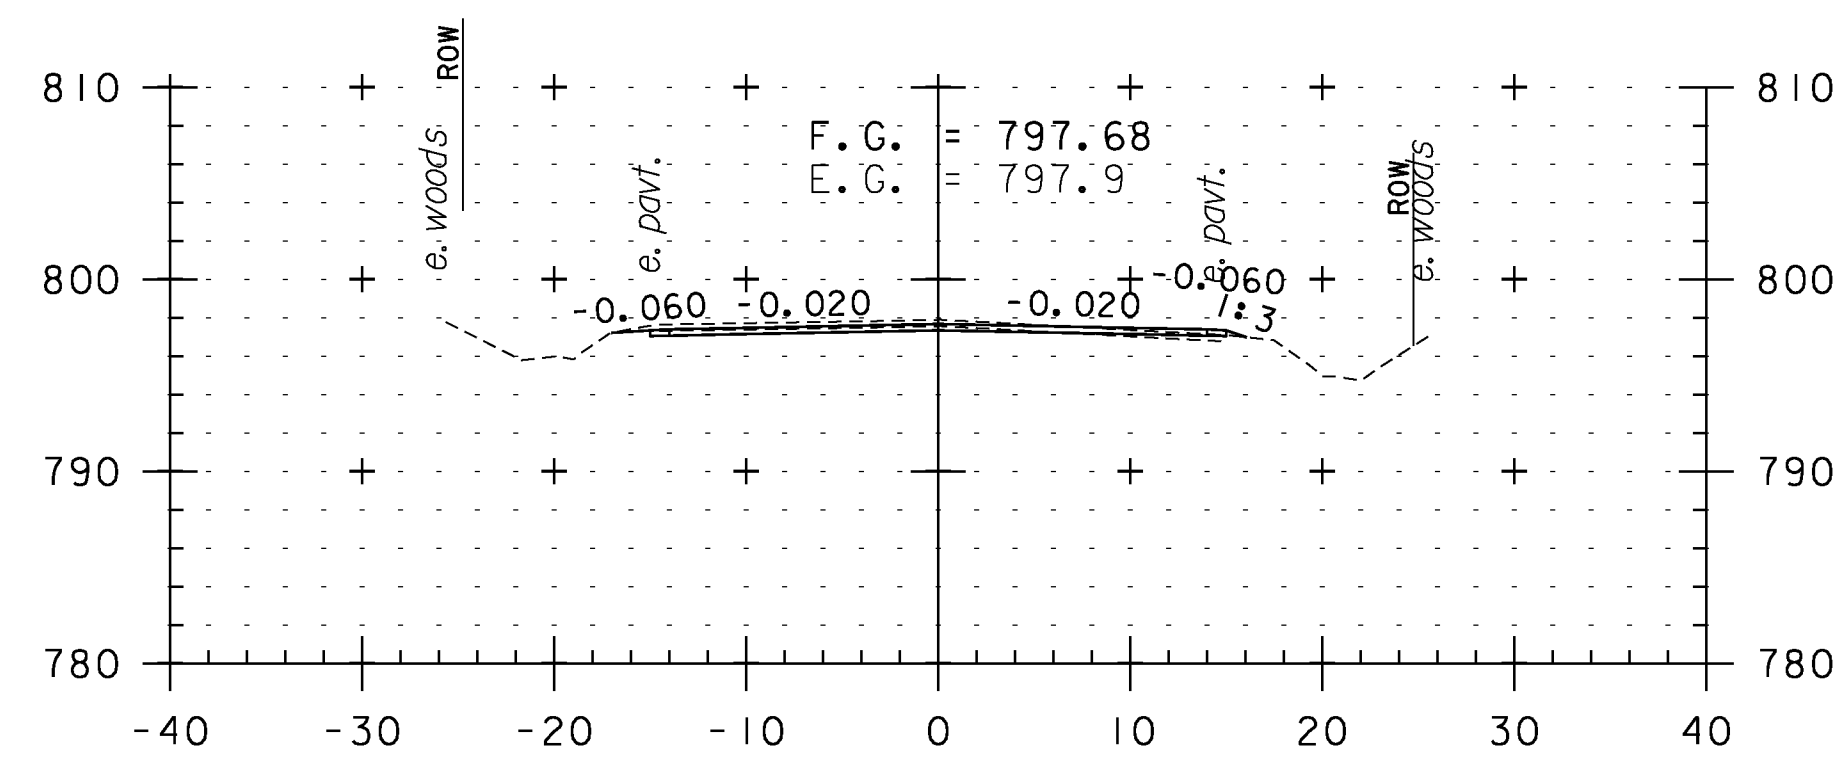


197+00

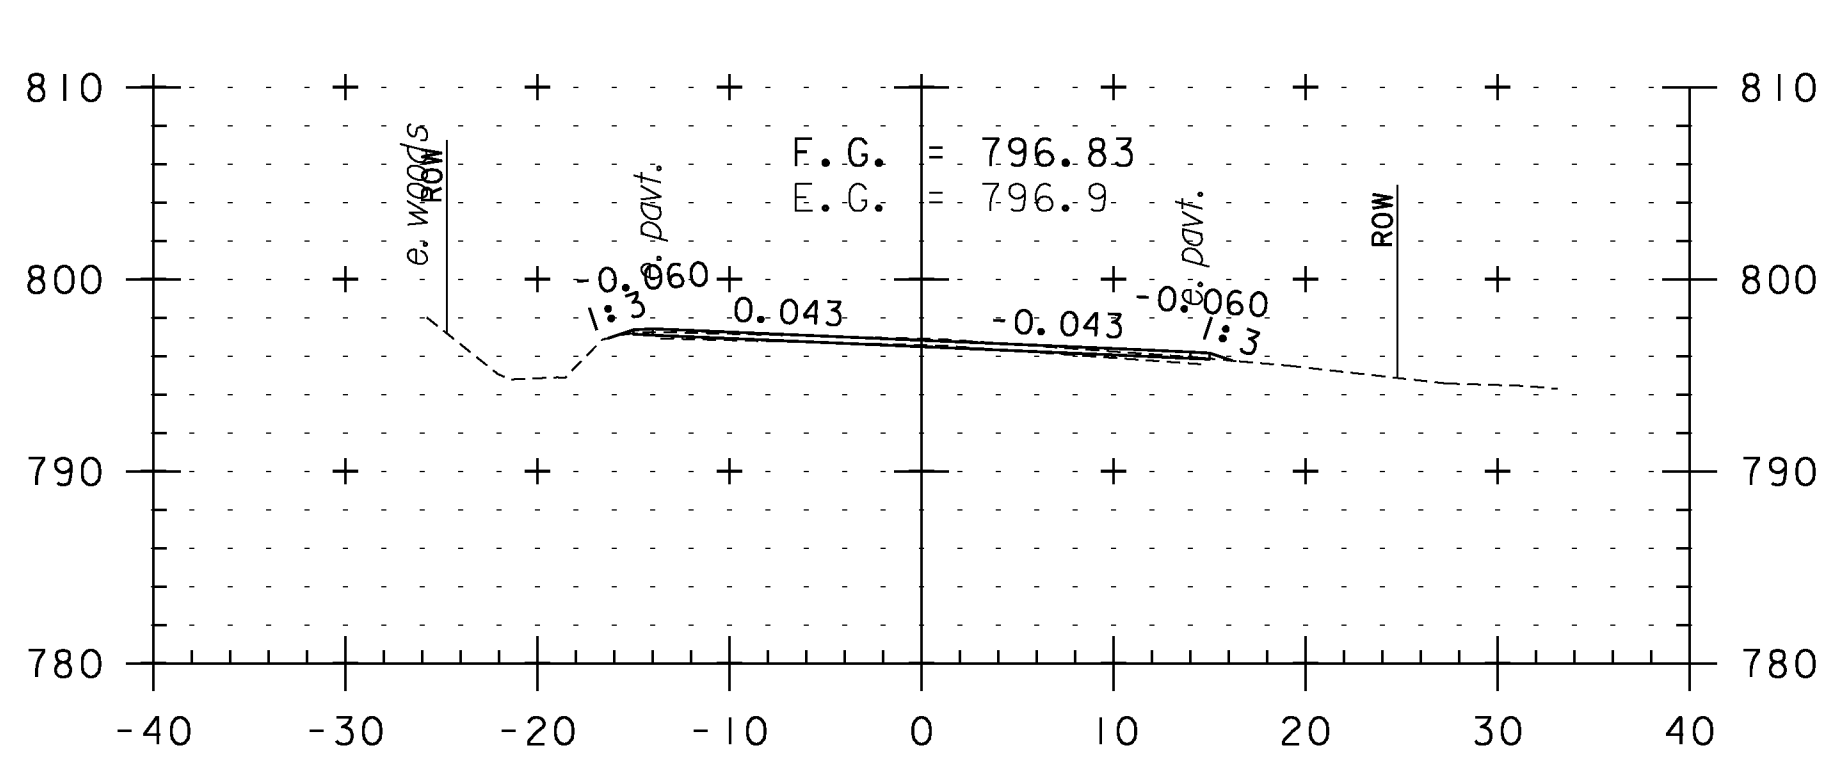


198+50

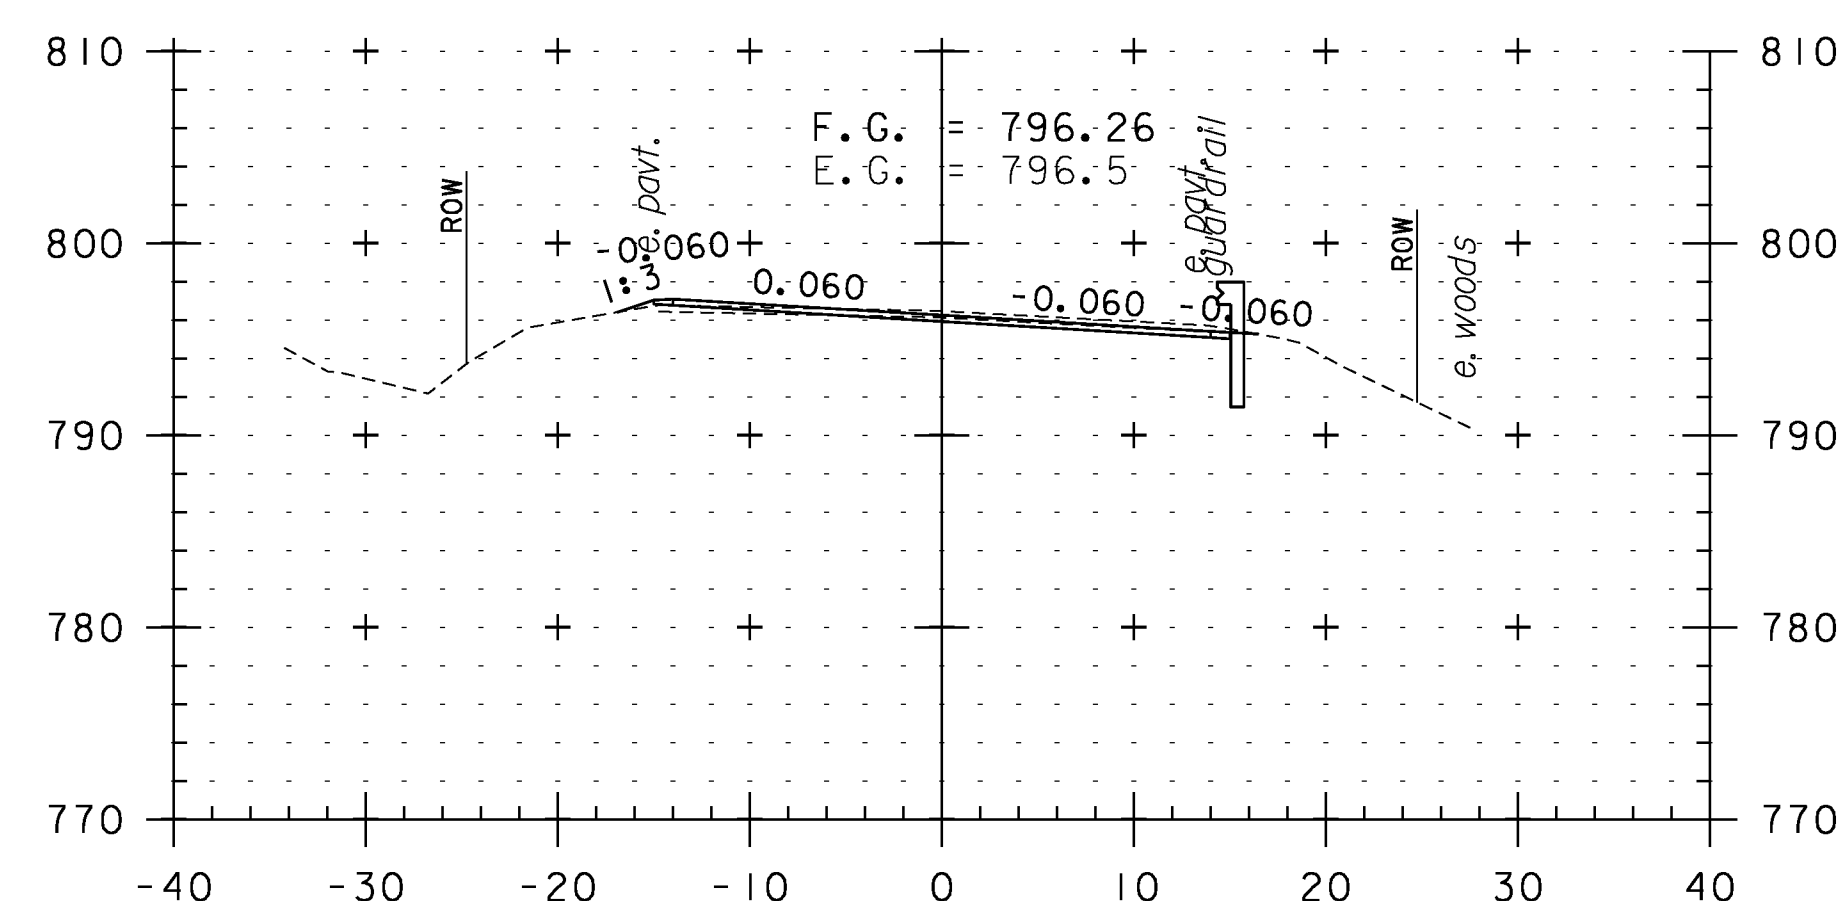


199+50

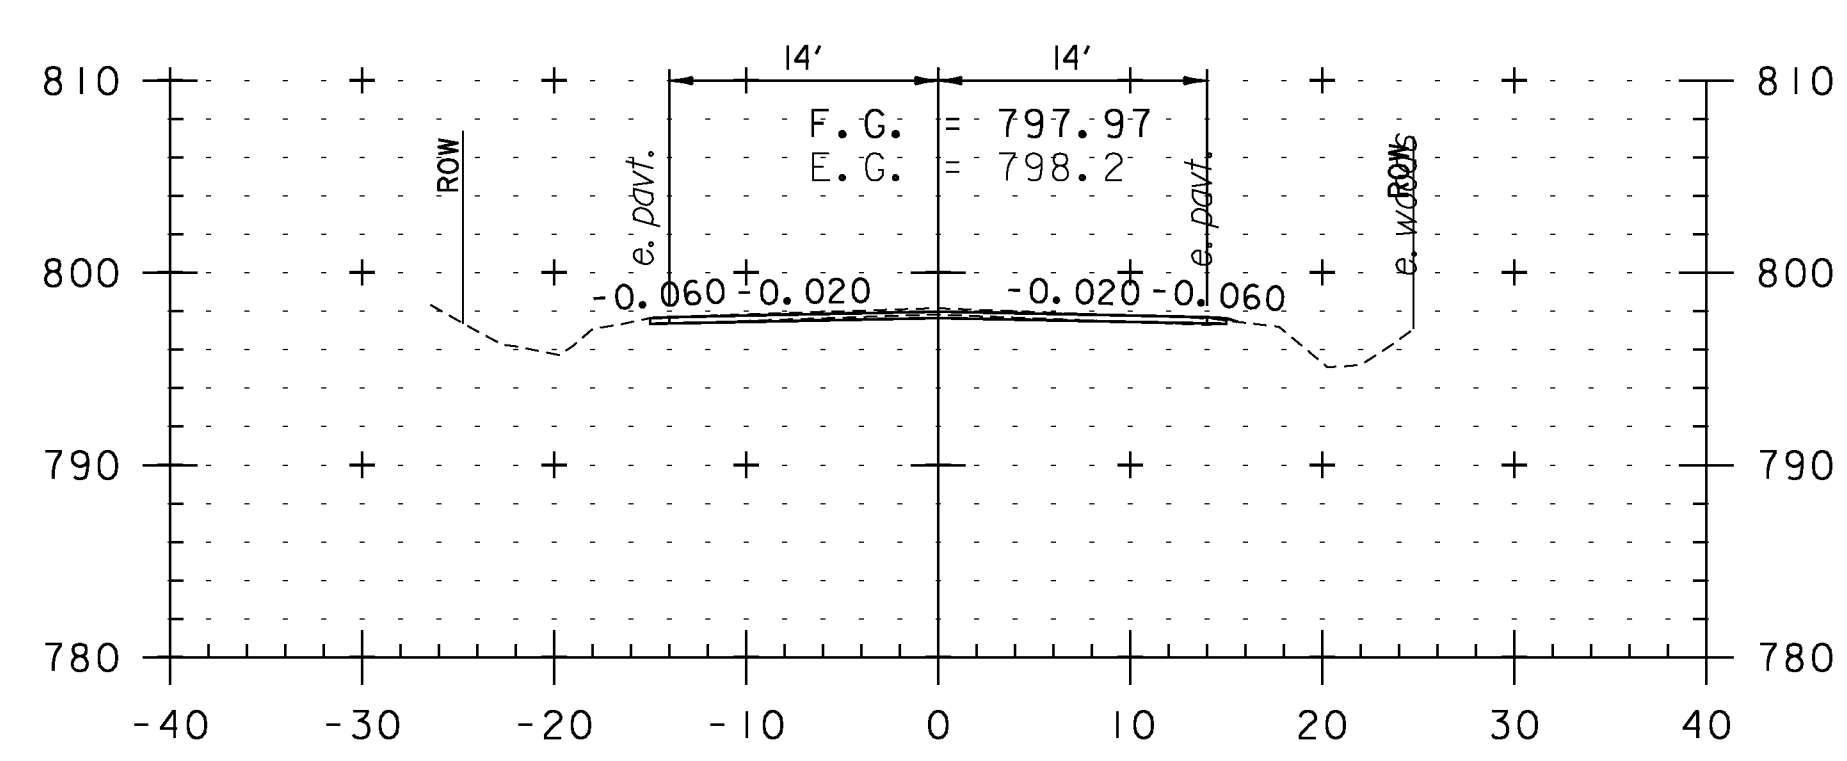

196+50

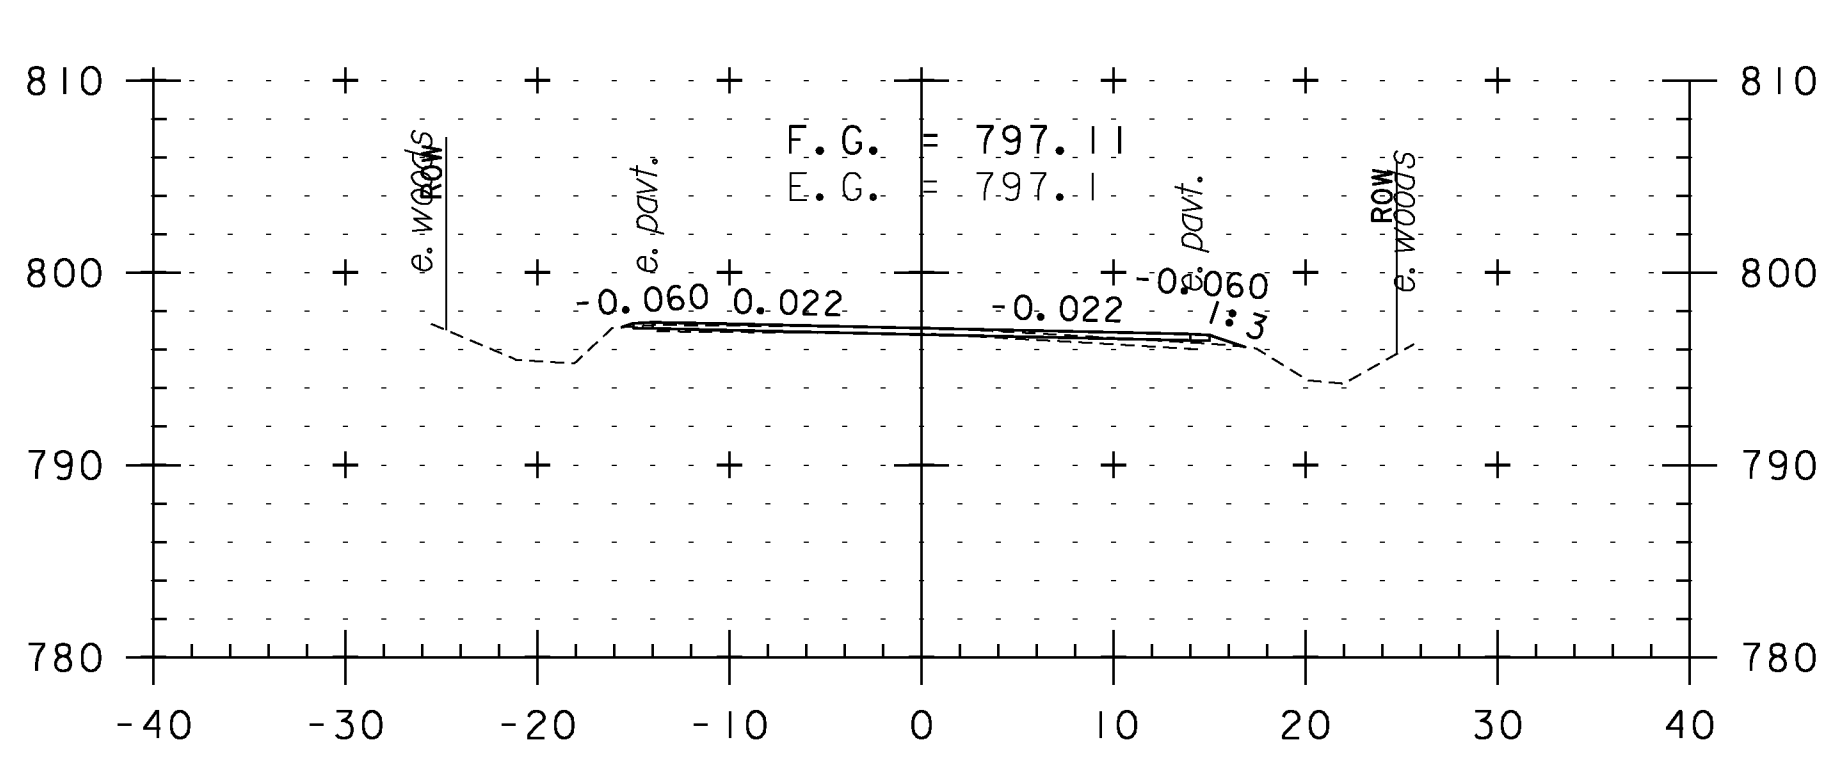

198+00

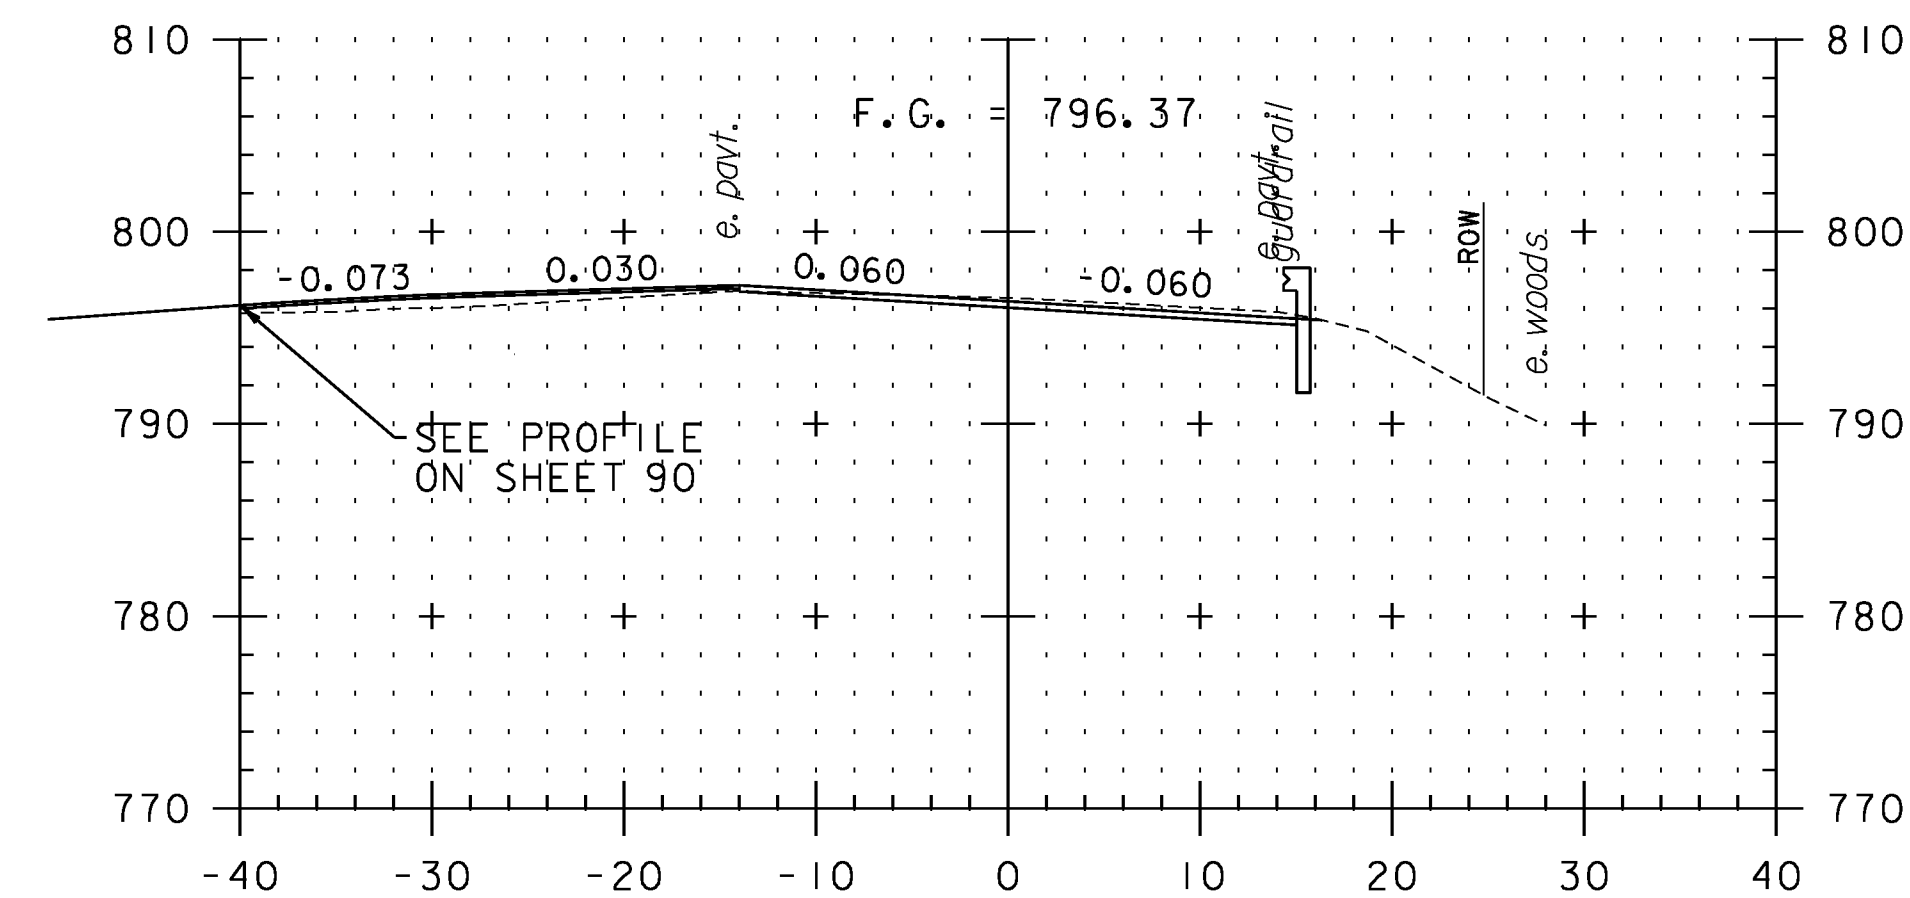

199+31

TH 65
CROSS SECTION SHEET 31

PROJECT NAME: WEATHERSFIELD	
PROJECT NUMBER: STP 2913(I)	
FILE NAME: I0c228	PLOT DATE: 2/7/2013
PROJECT LEADER: PTS	DRAWN BY: WWG
DESIGNED BY: NULL	CHECKED BY: PTS
IPARM FILE NAME: pI0c228_I21	SHEET I21 OF 234



STA. 196+50 TO STA. 200+00