




231+00

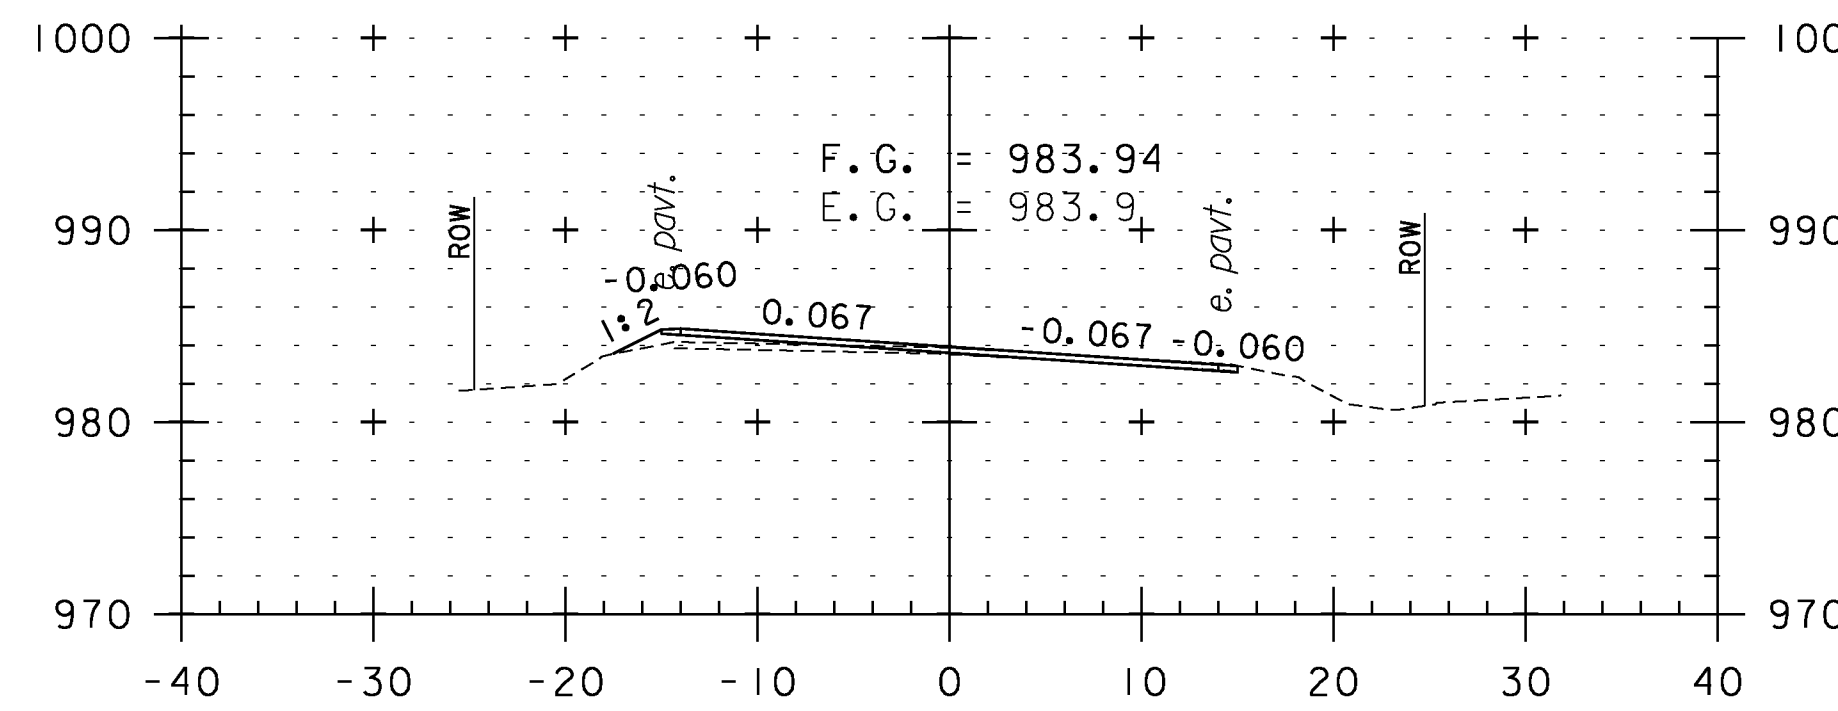


232+50

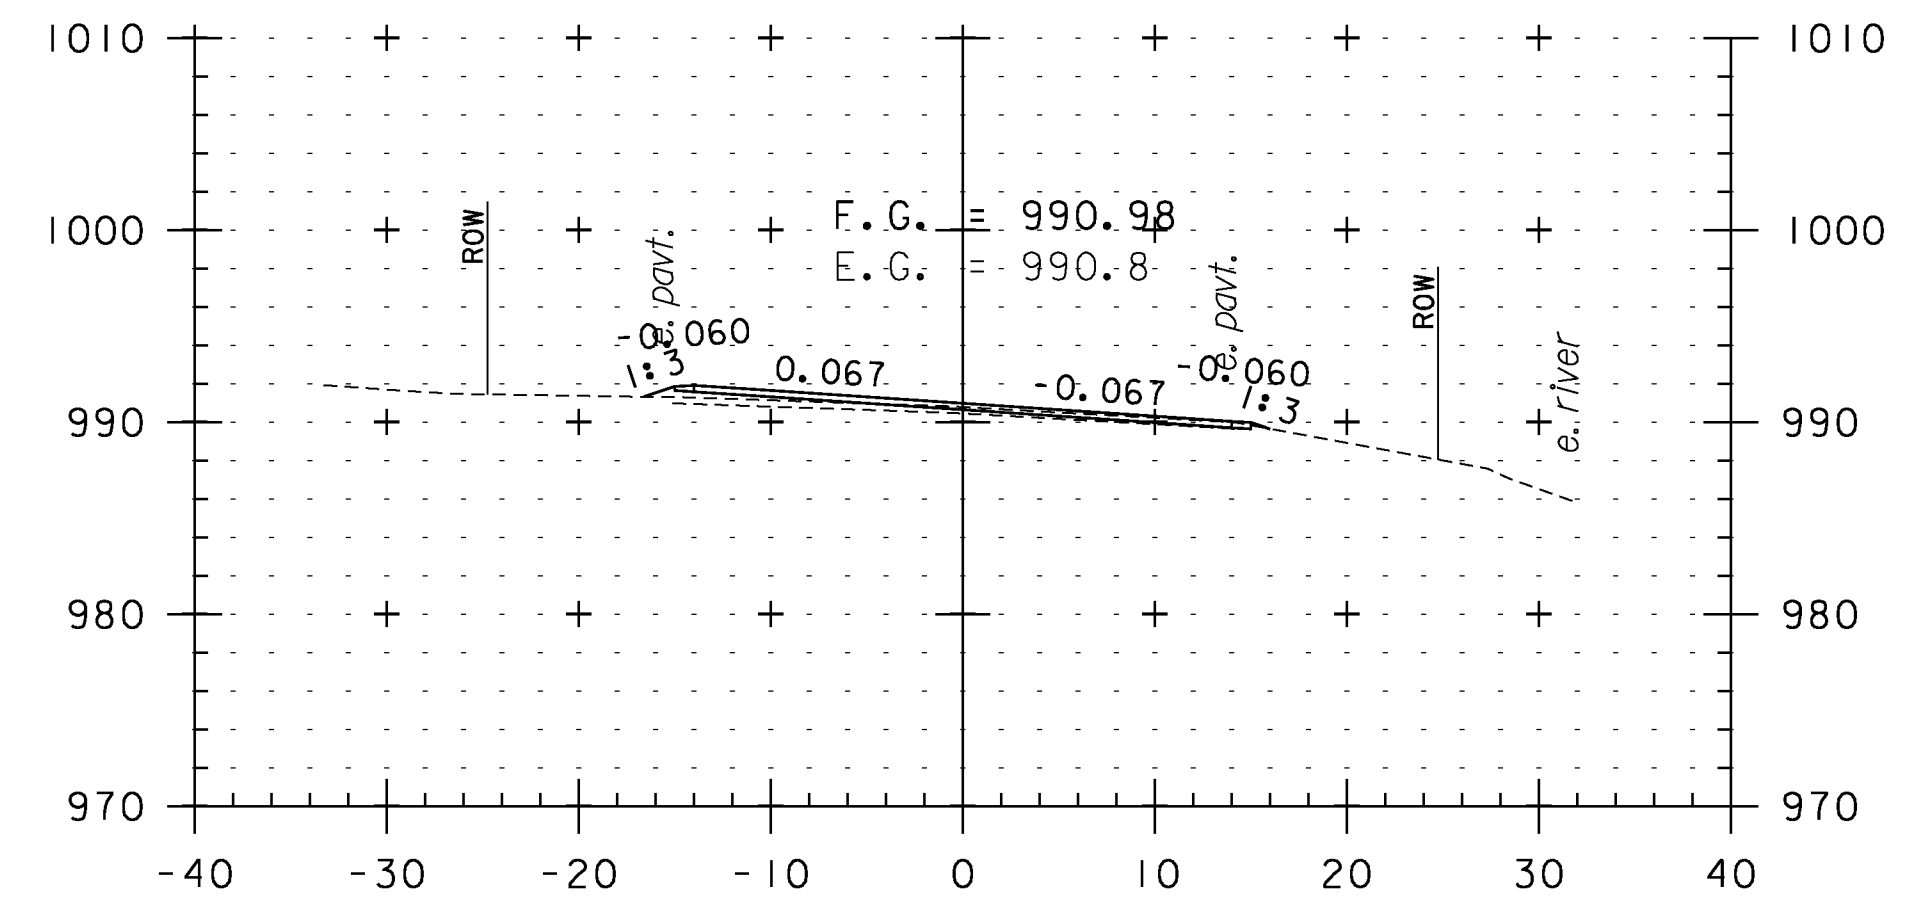


234+00

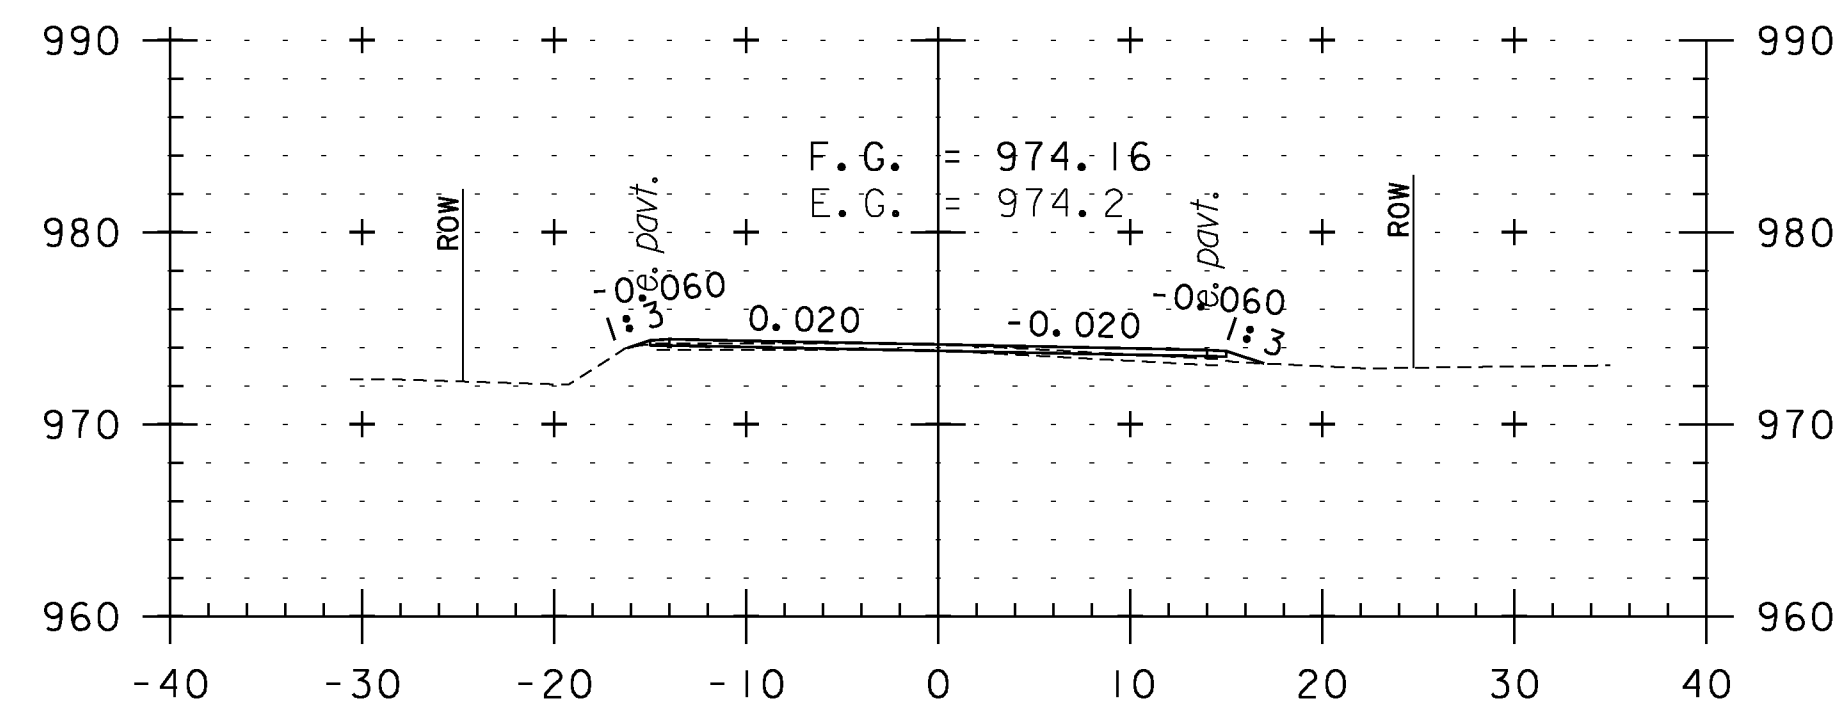


230+50

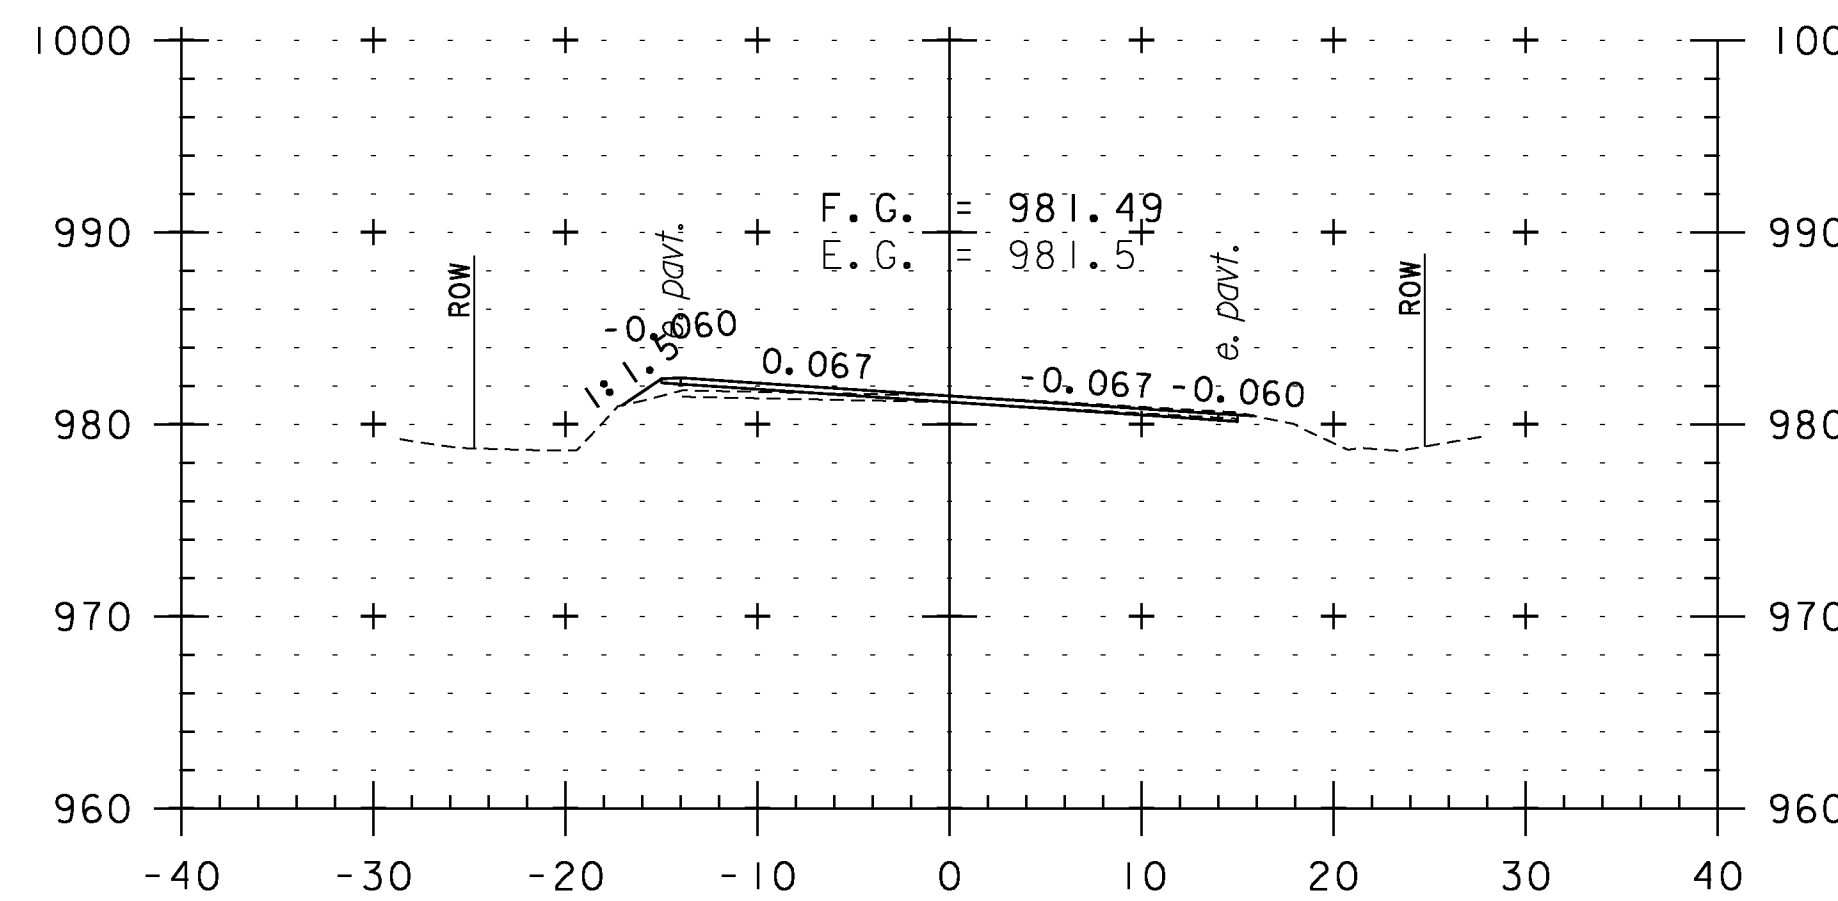


232+00

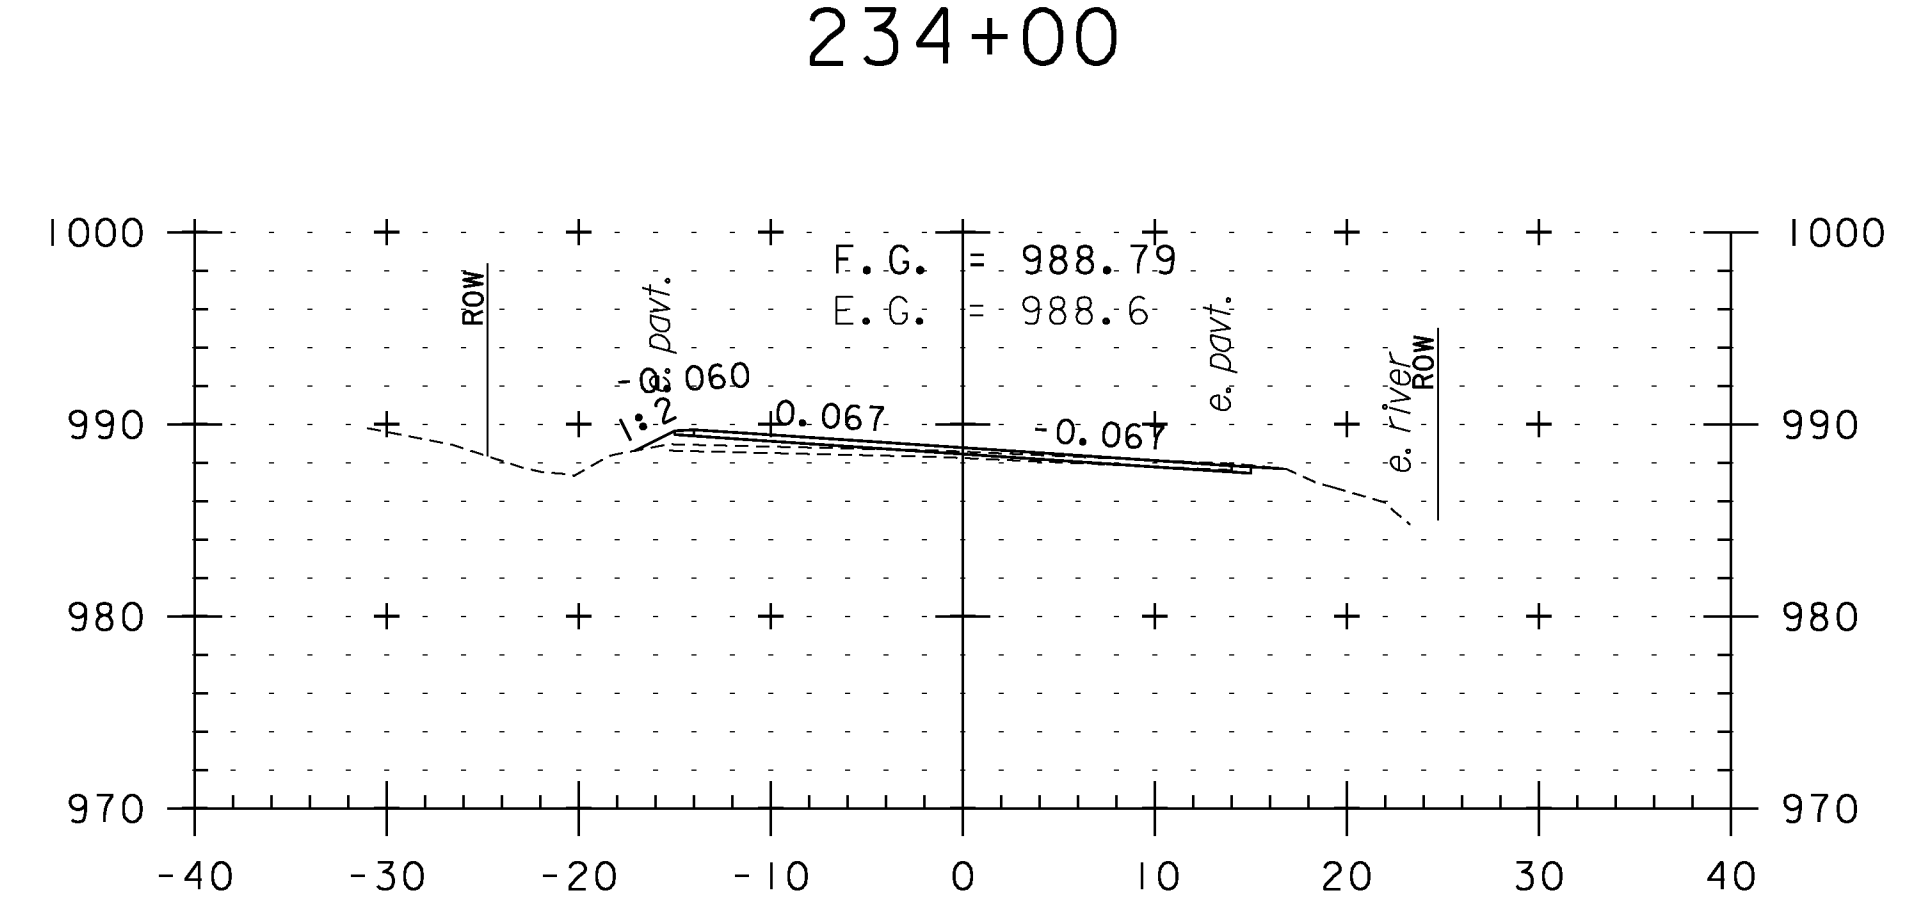


233+50

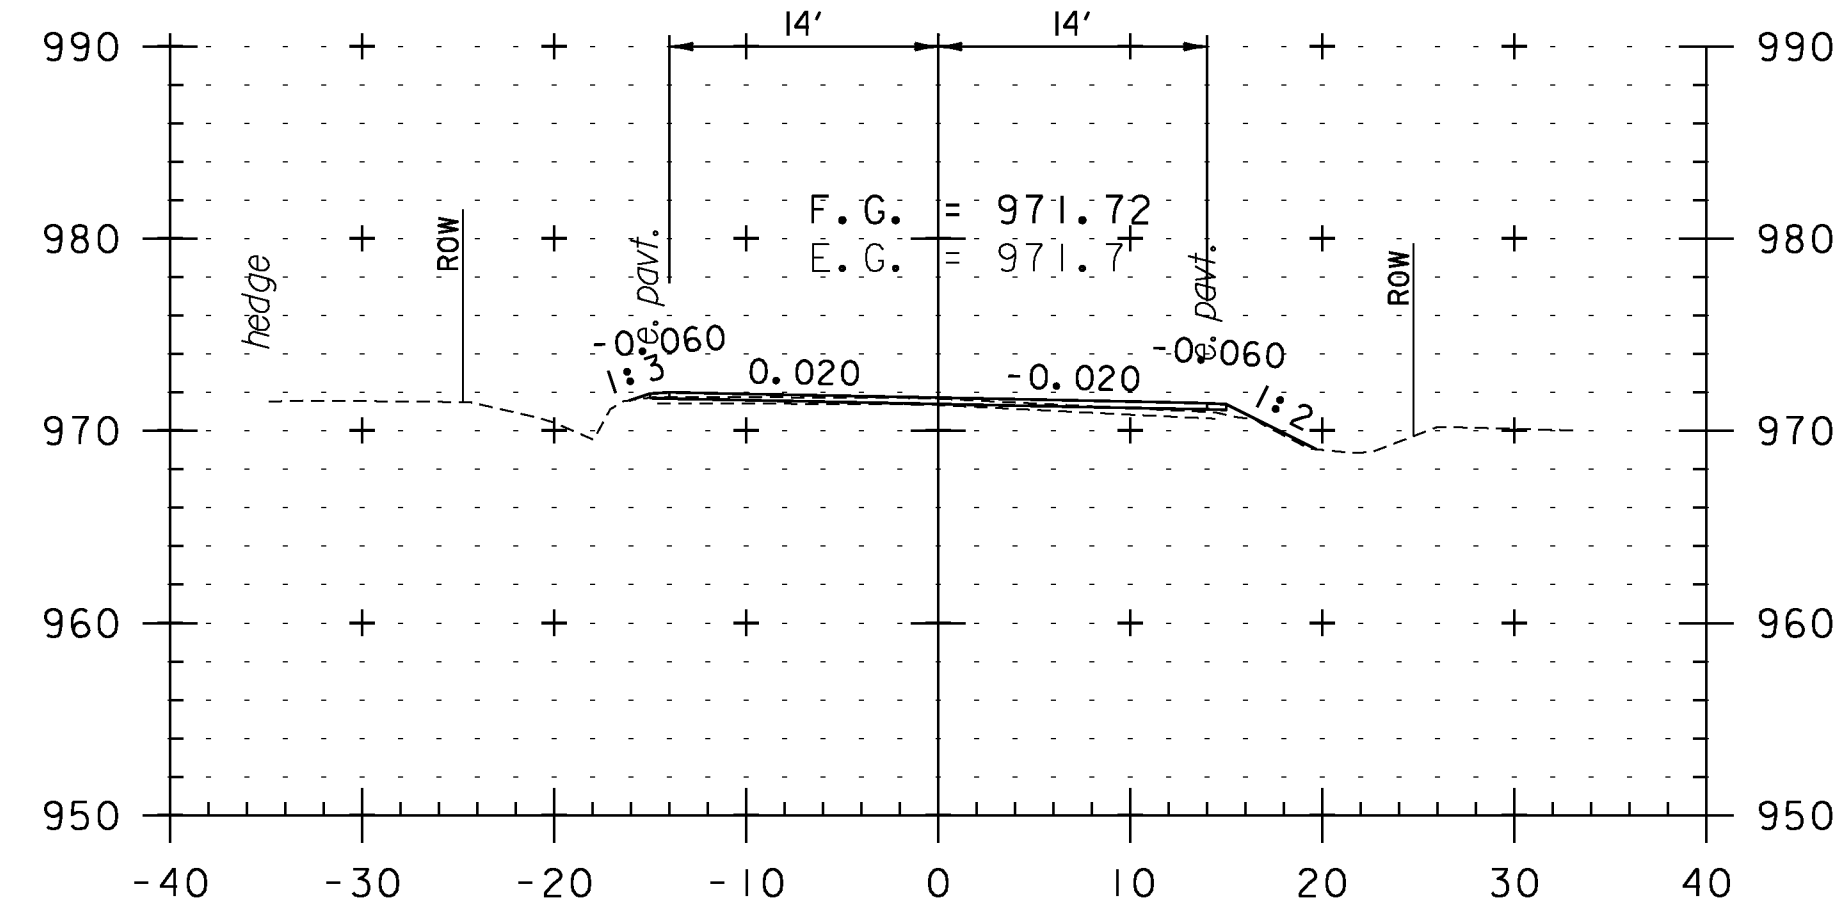

230+00

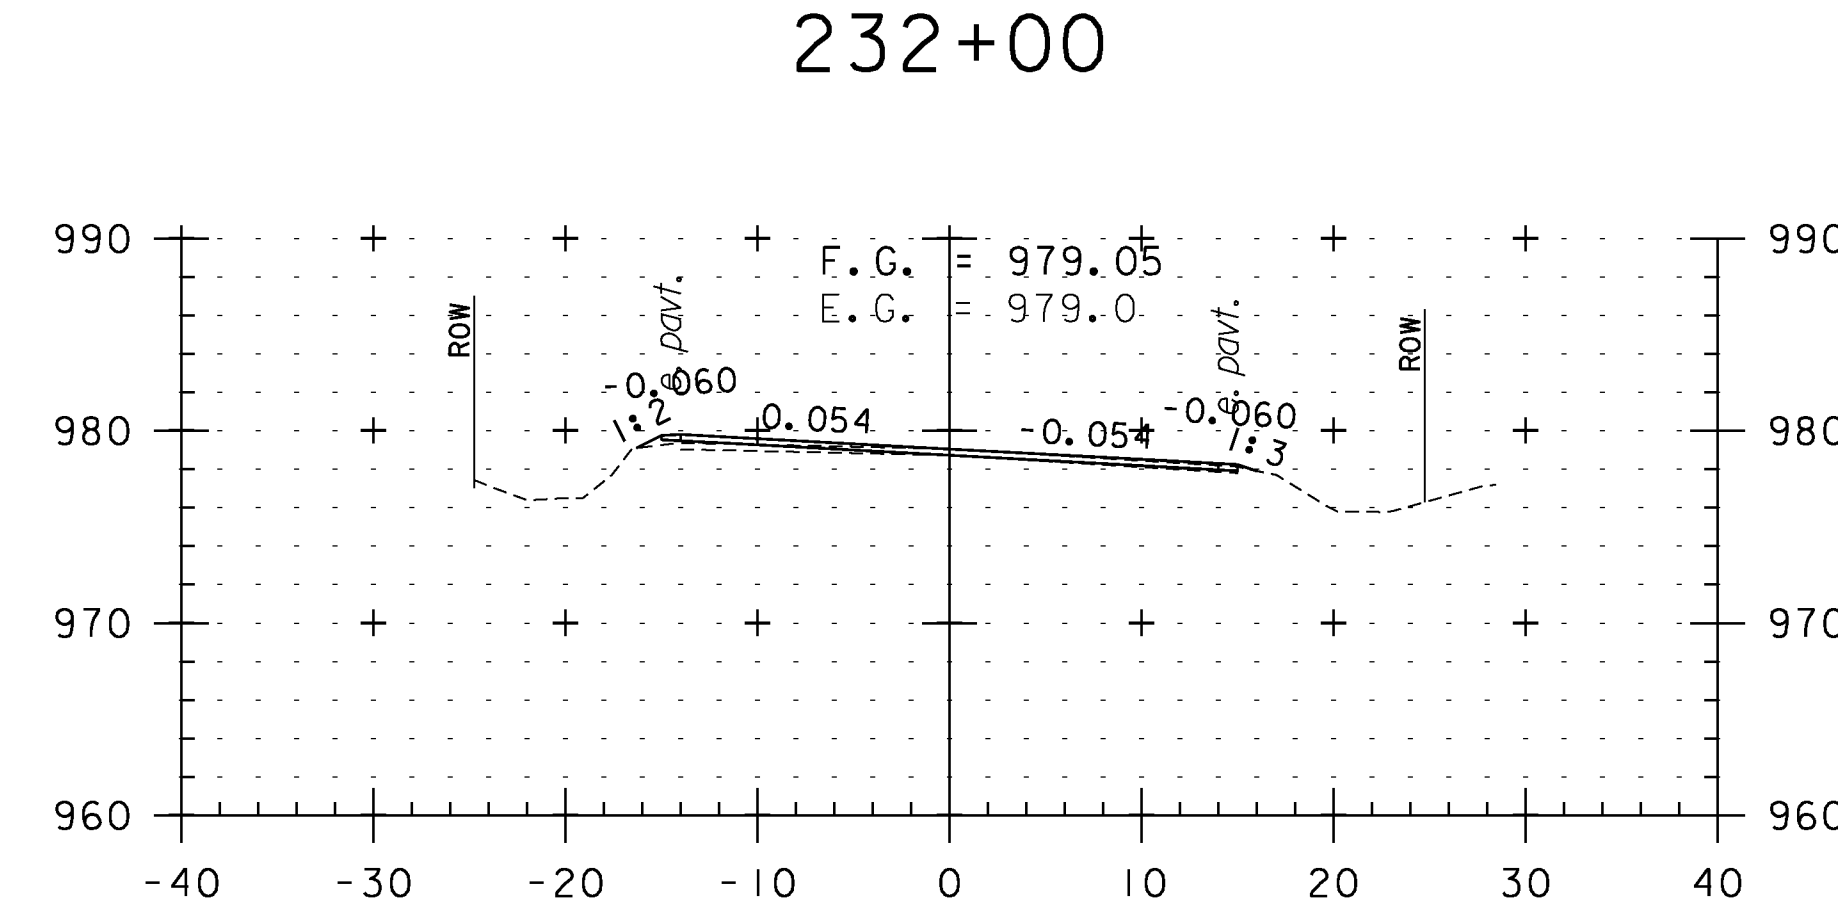


231+50

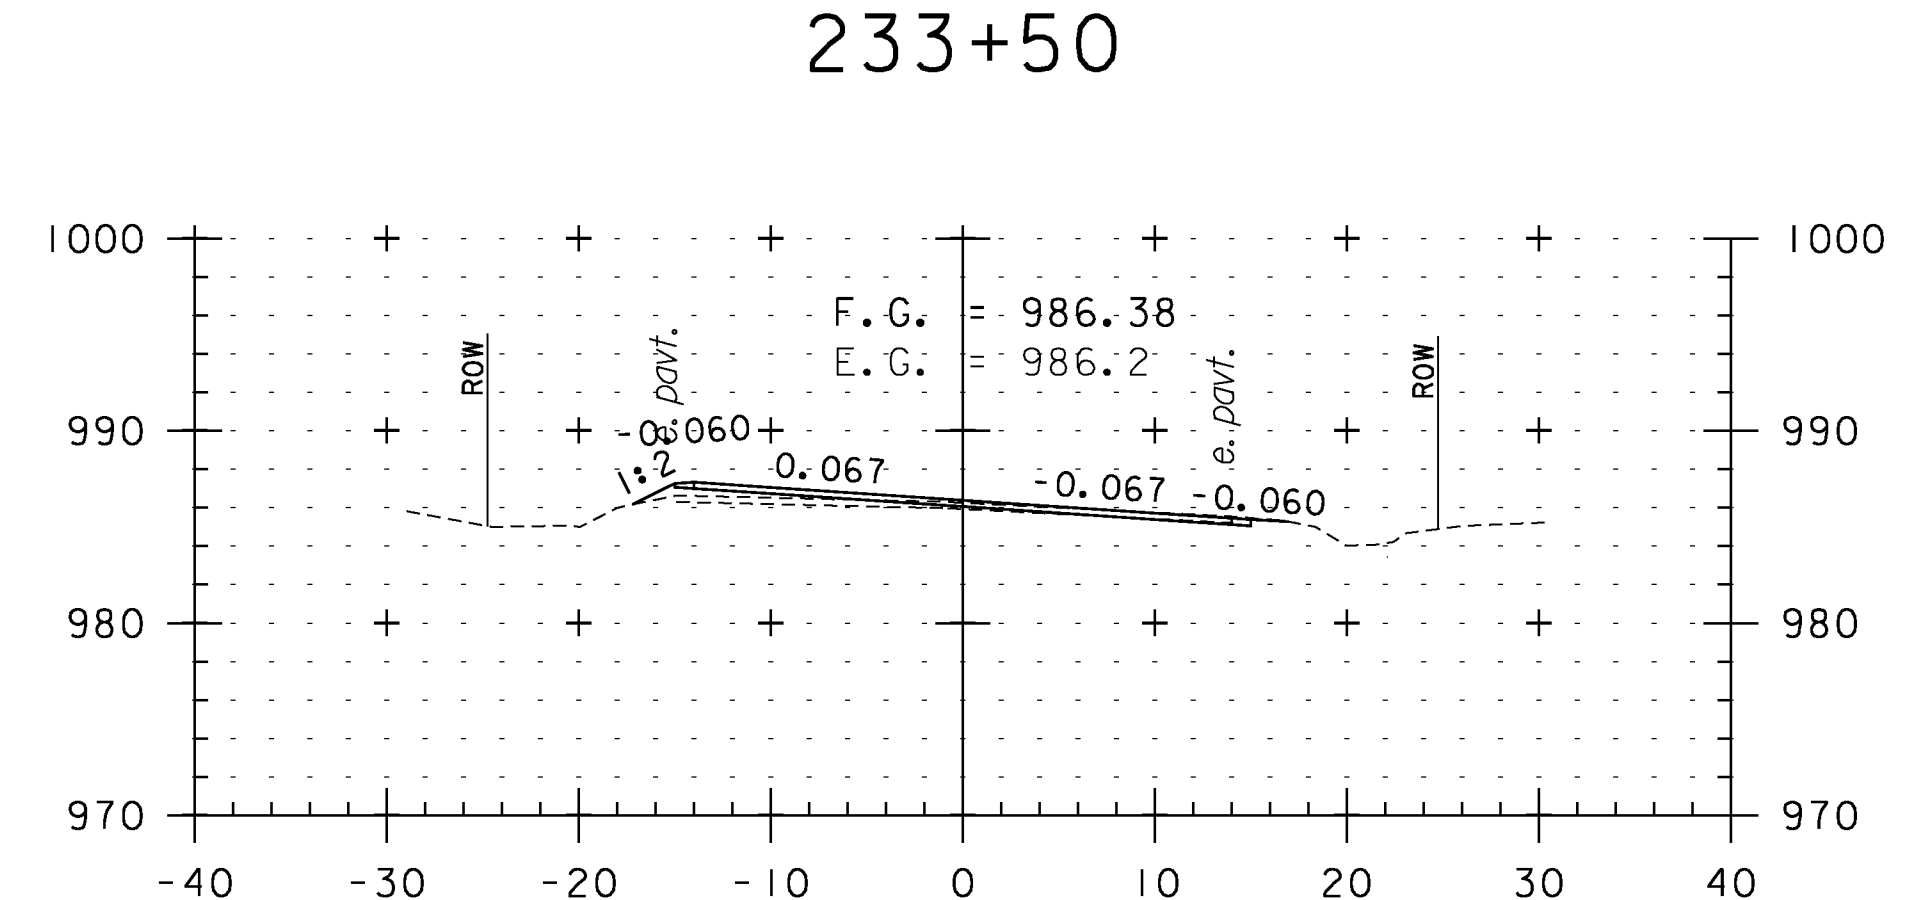

233+00

CROSS SECTION SHEET 39

| | |
|------------------------------|---------------------|
| PROJECT NAME: WEATHERSFIELD | PLOT DATE: 2/7/2013 |
| PROJECT NUMBER: STP 2913(I) | DRAWN BY: WWG |
| FILE NAME: I0c228 | CHECKED BY: PTS |
| PROJECT LEADER: PTS | SHEET I29 OF 234 |
| DESIGNED BY: NLL | |
| IPARM FILE NAME: pI0c228_I29 | |

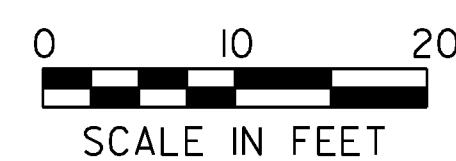

STA. 230+00 TO STA. 234+00