




262+00

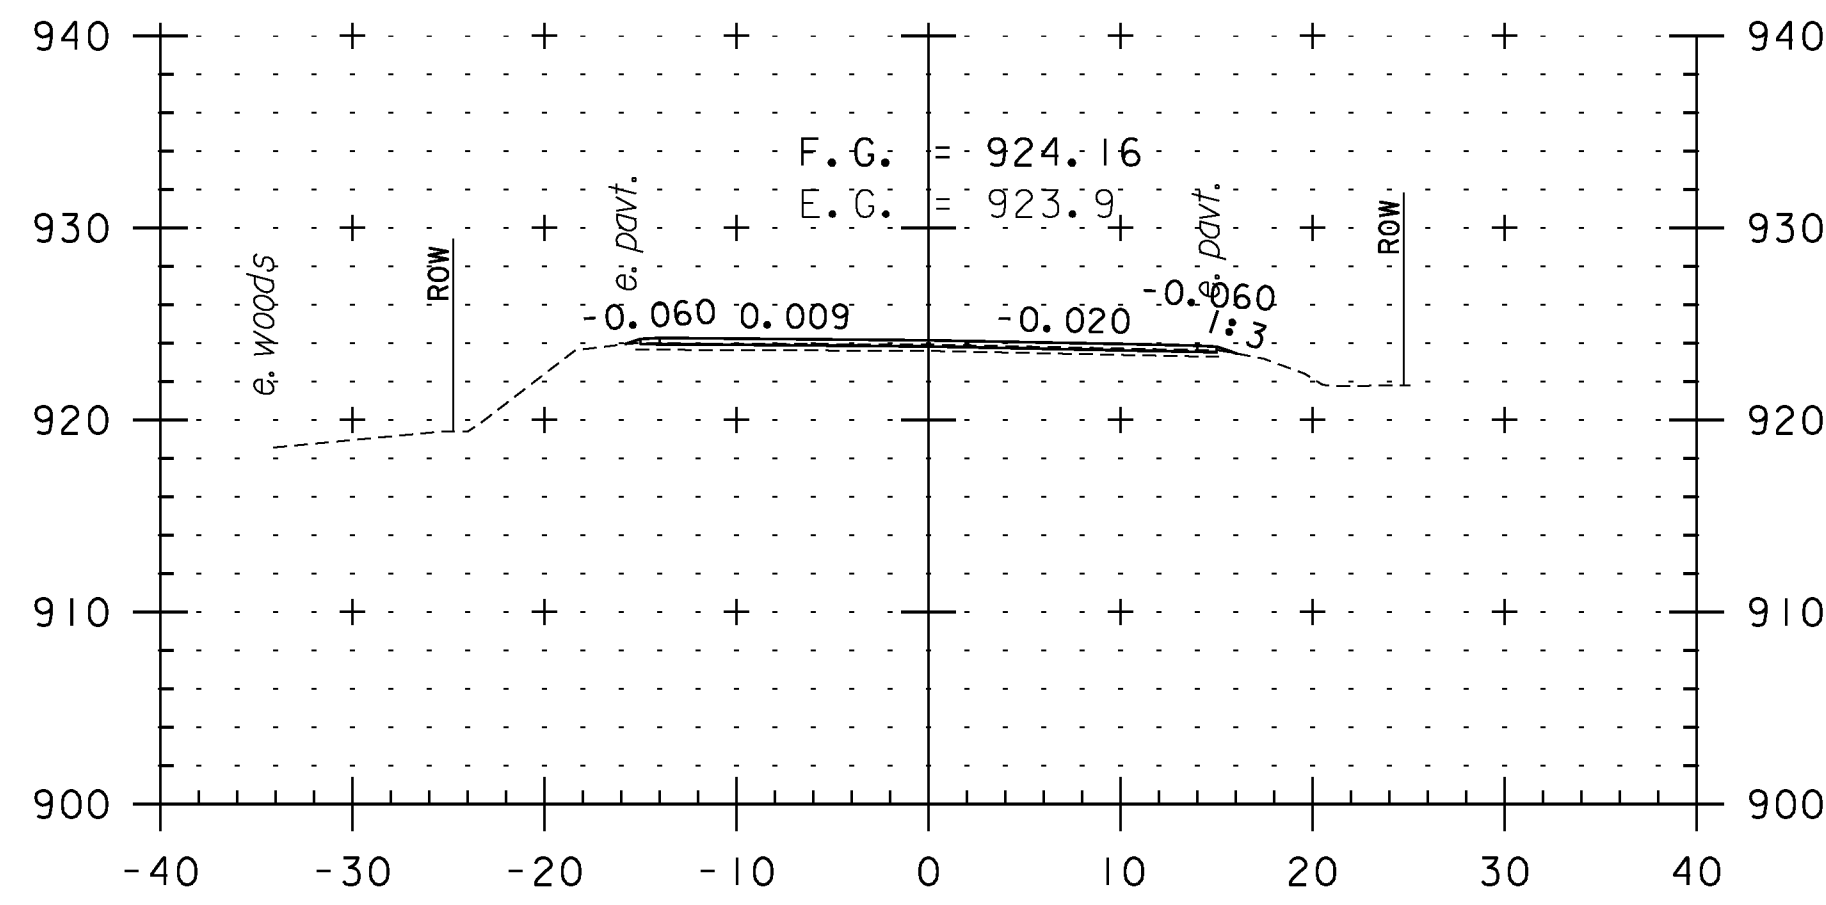


263+50

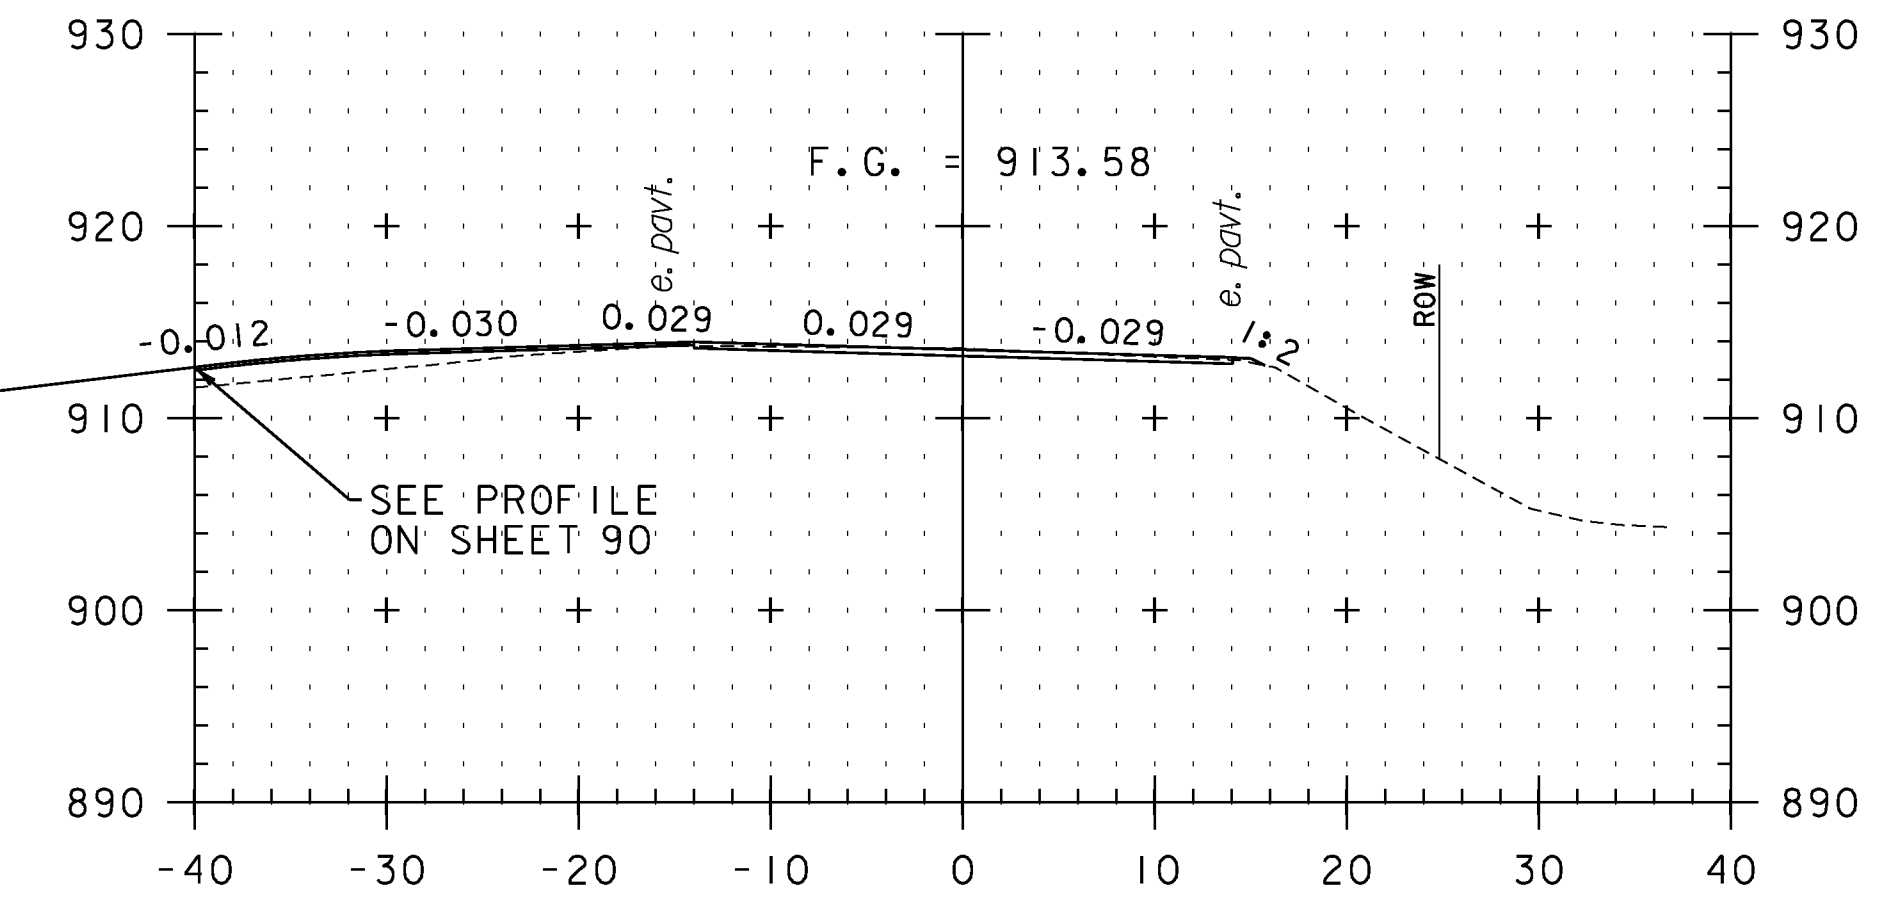


264+94
TH 79

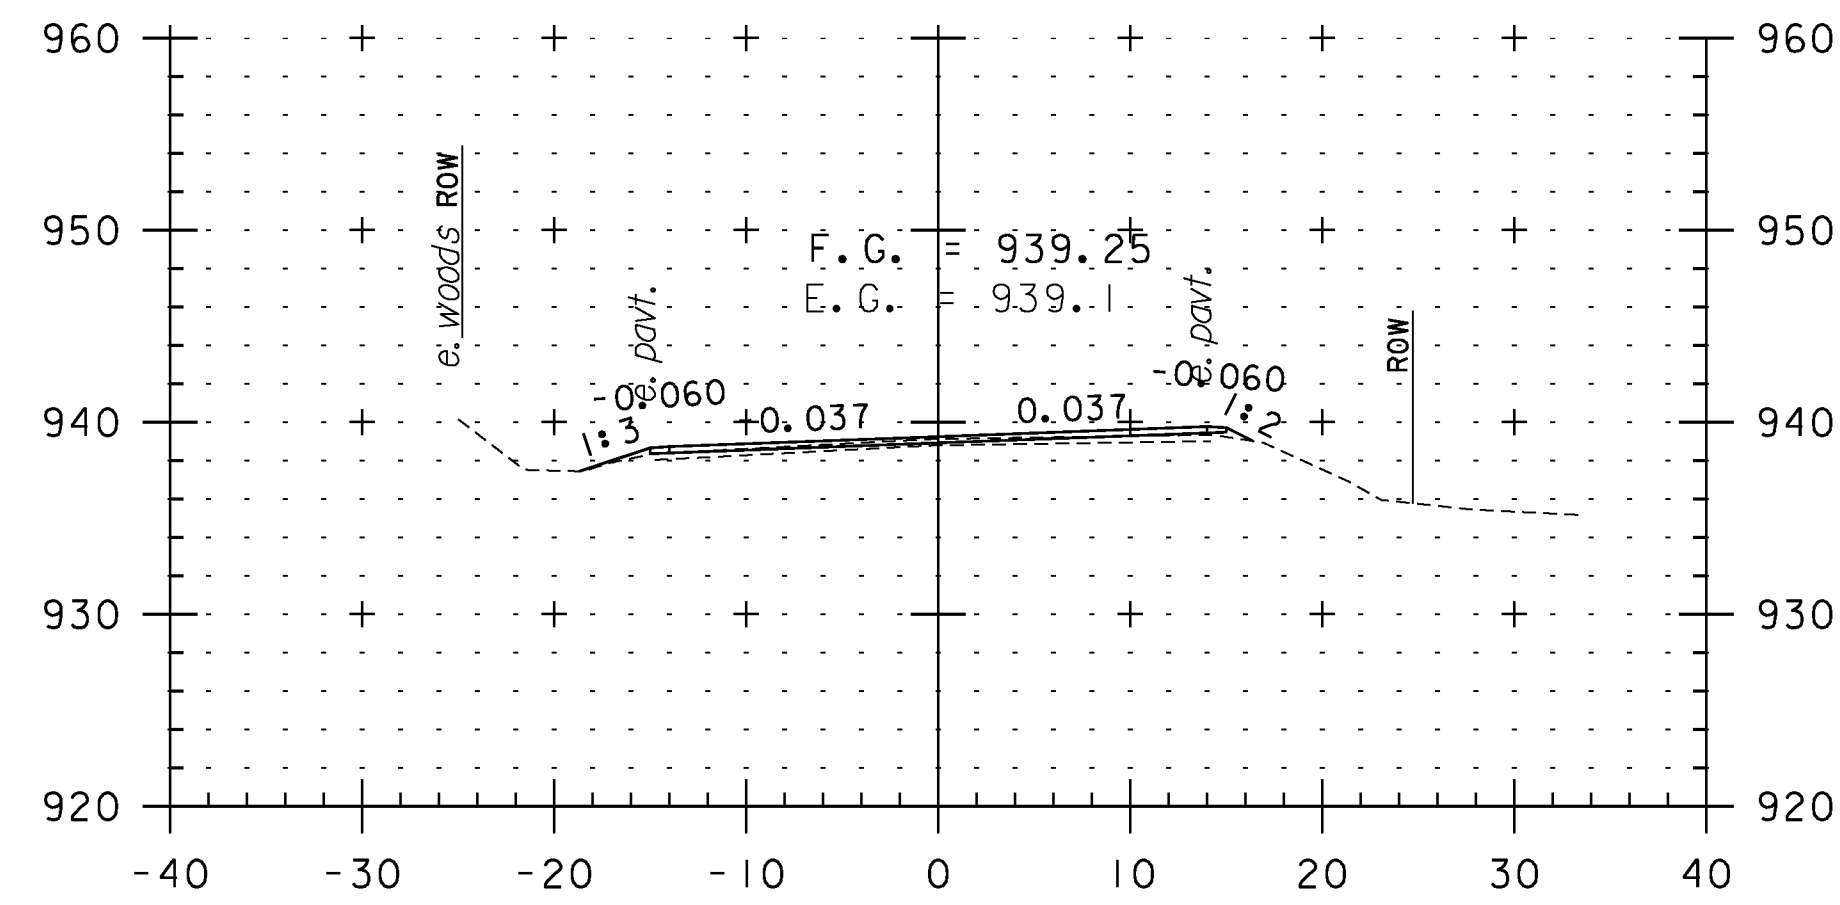


261+50

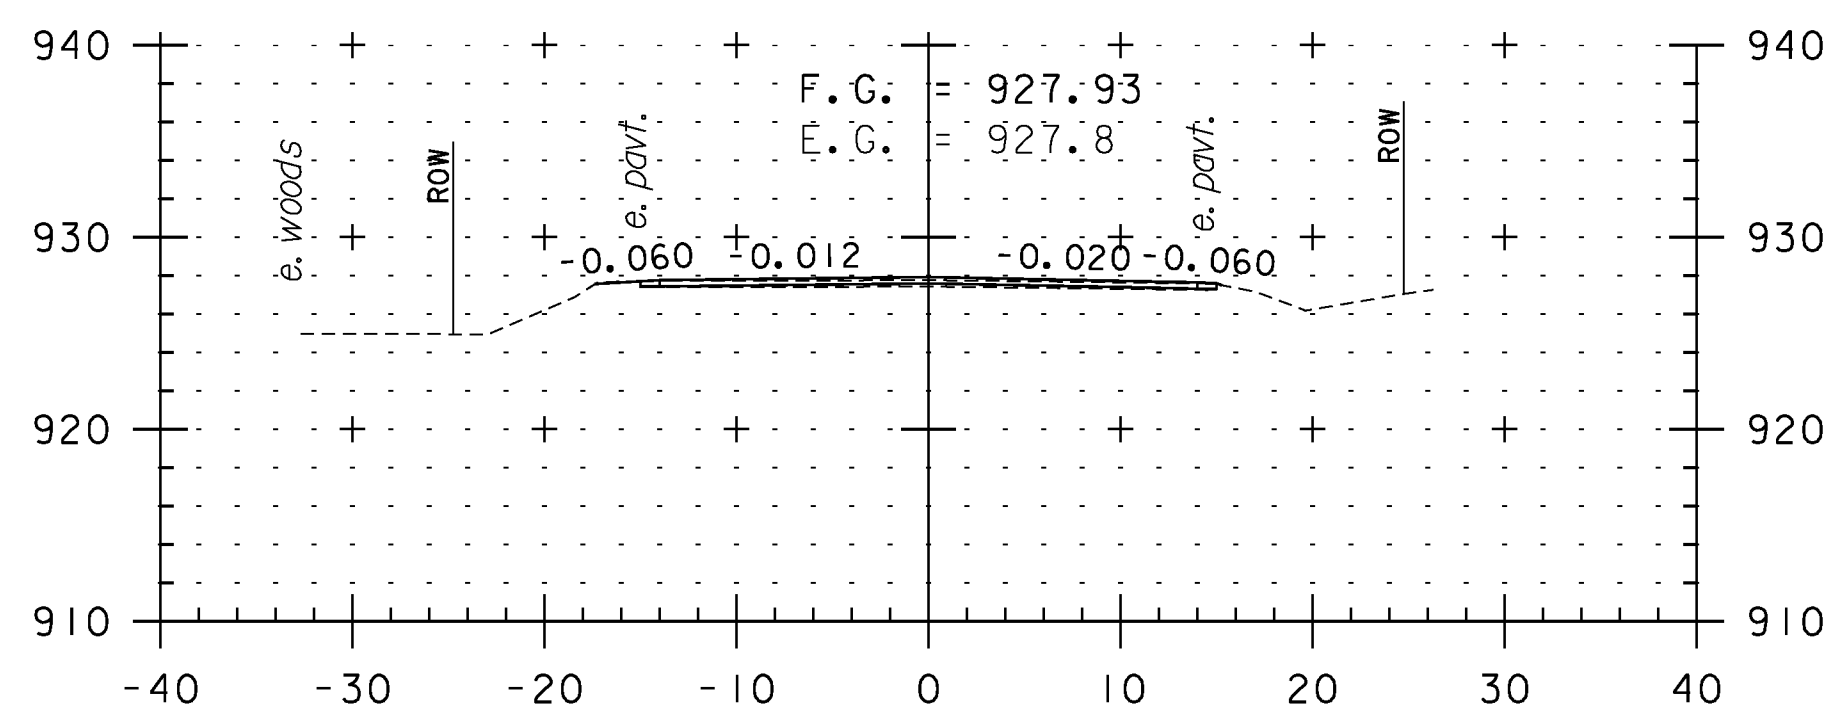


263+00

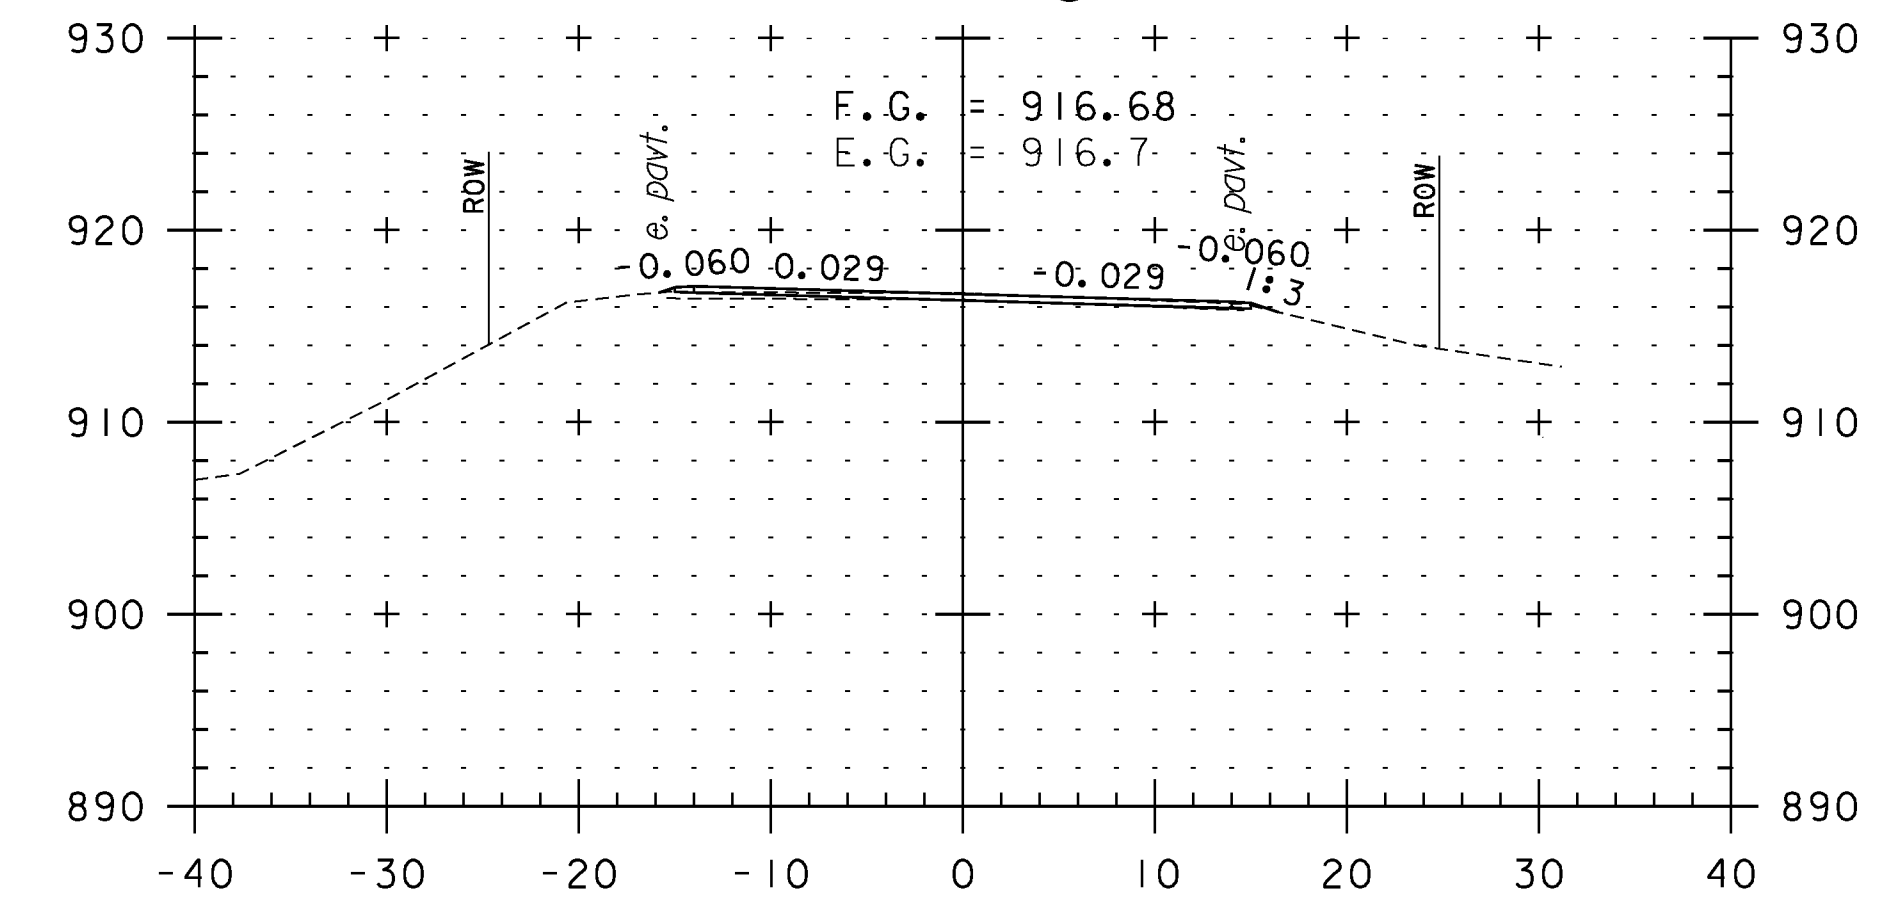


264+50

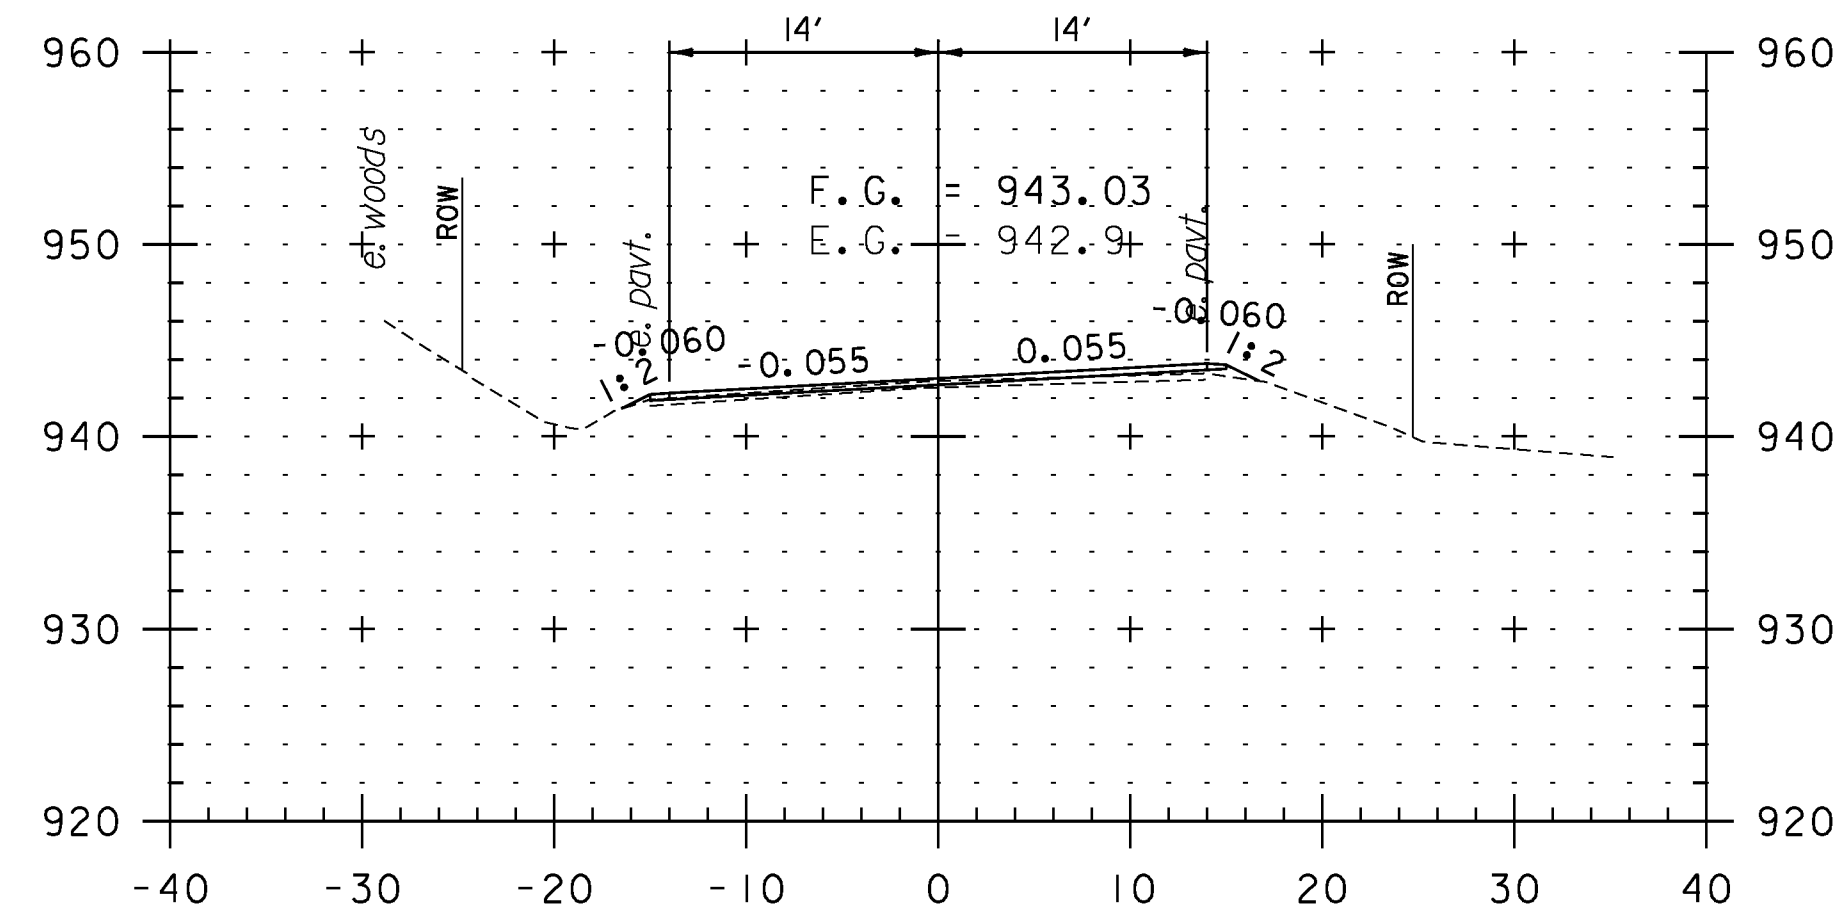

261+00

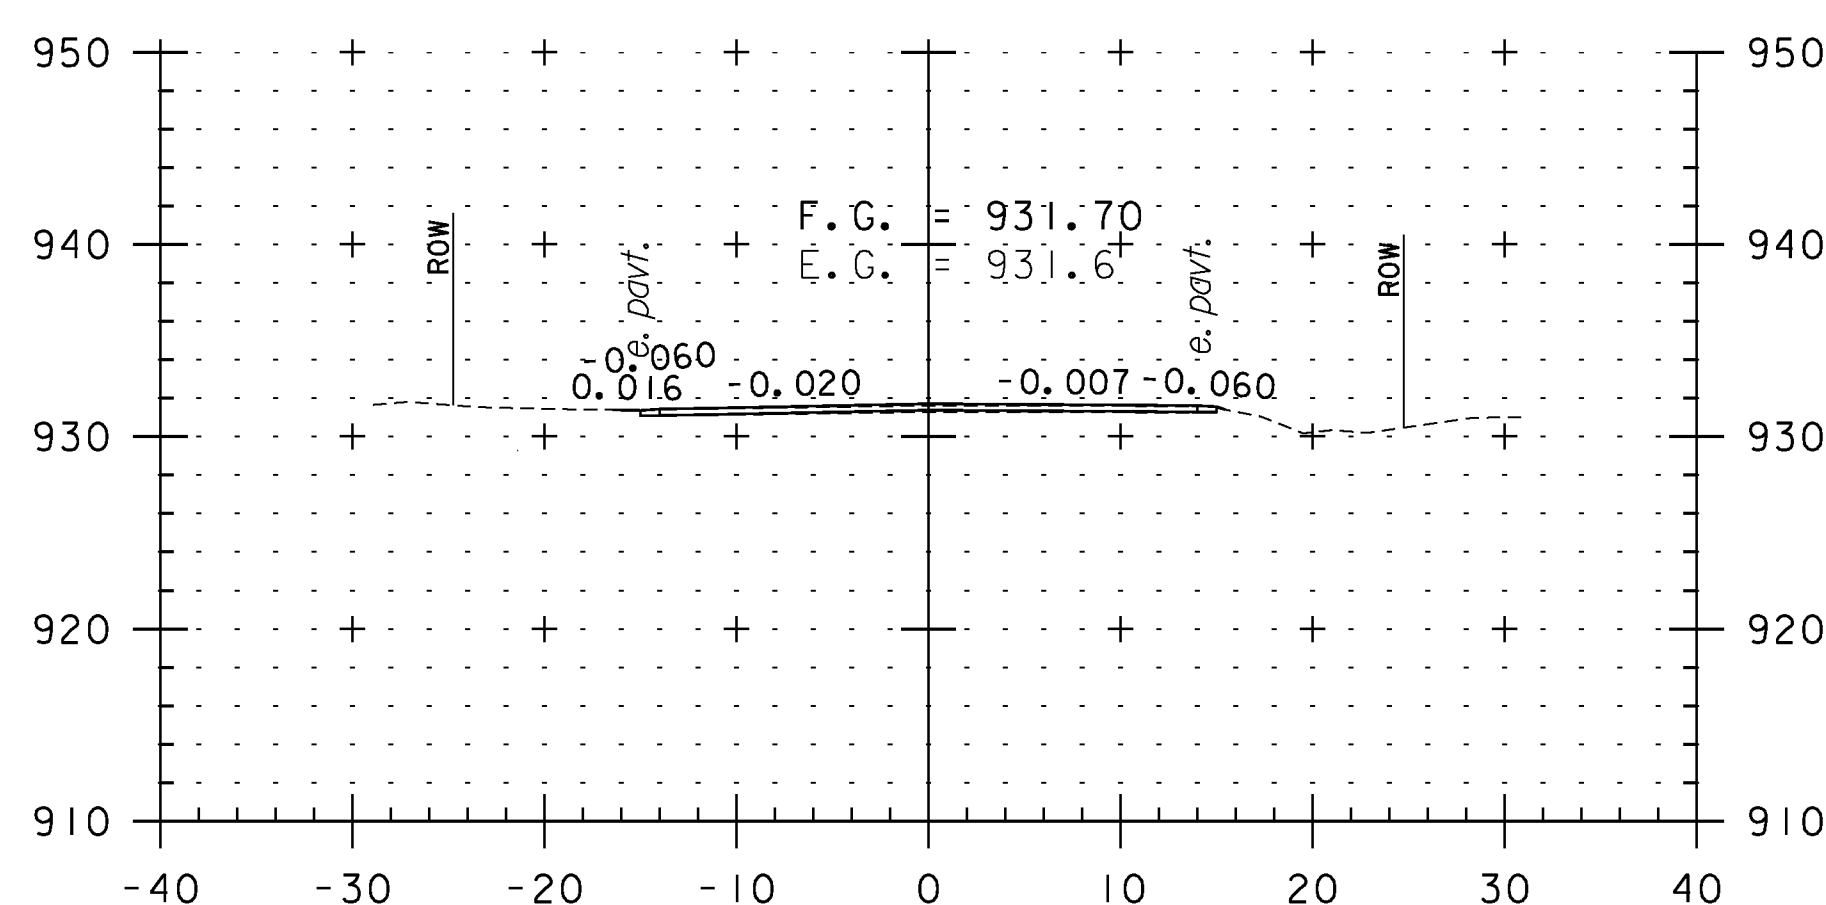

262+50

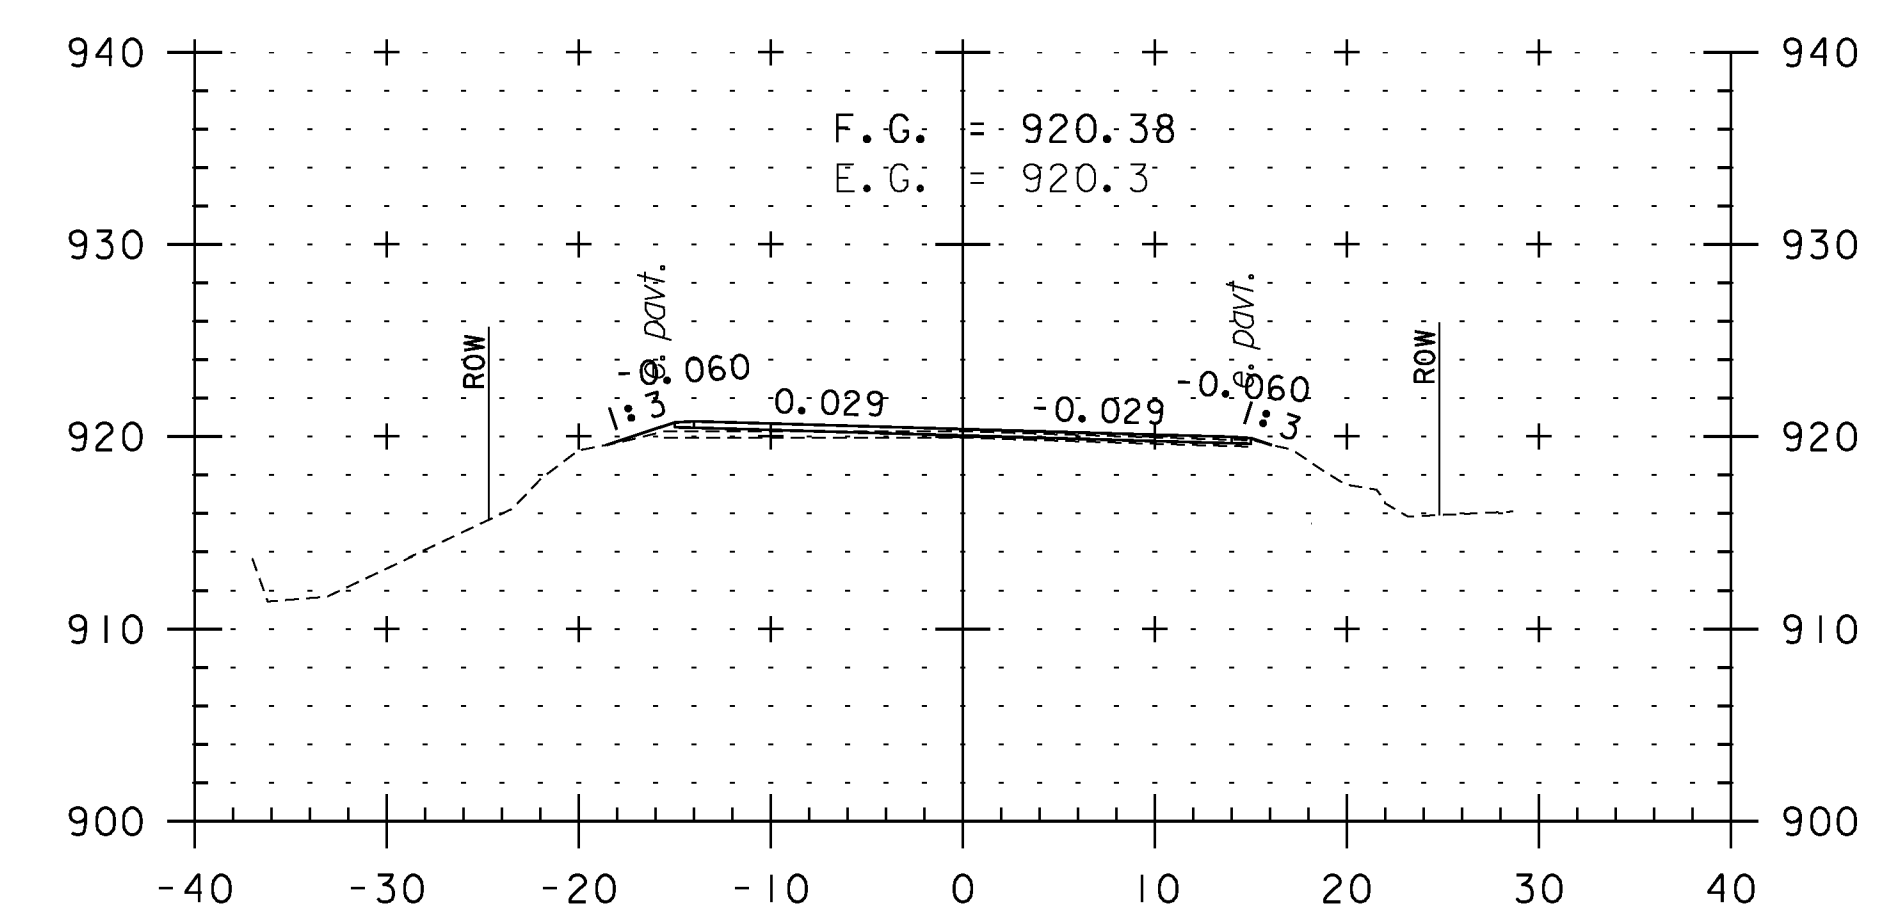

264+00

CROSS SECTION SHEET 46

PROJECT NAME: WEATHERSFIELD

PROJECT NUMBER: STP 2913(I)

FILE NAME: I0c228

PROJECT LEADER: PTS

DESIGNED BY: NLL


IPARM FILE NAME: pI0c228.I36

PLOT DATE: 2/7/2013

DRAWN BY: WWG

CHECKED BY: PTS

SHEET 136 OF 234

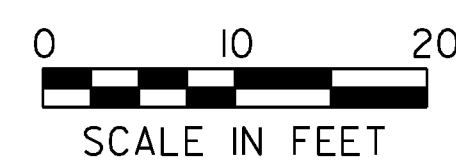

STA. 261+00 TO STA. 264+94