




270+50

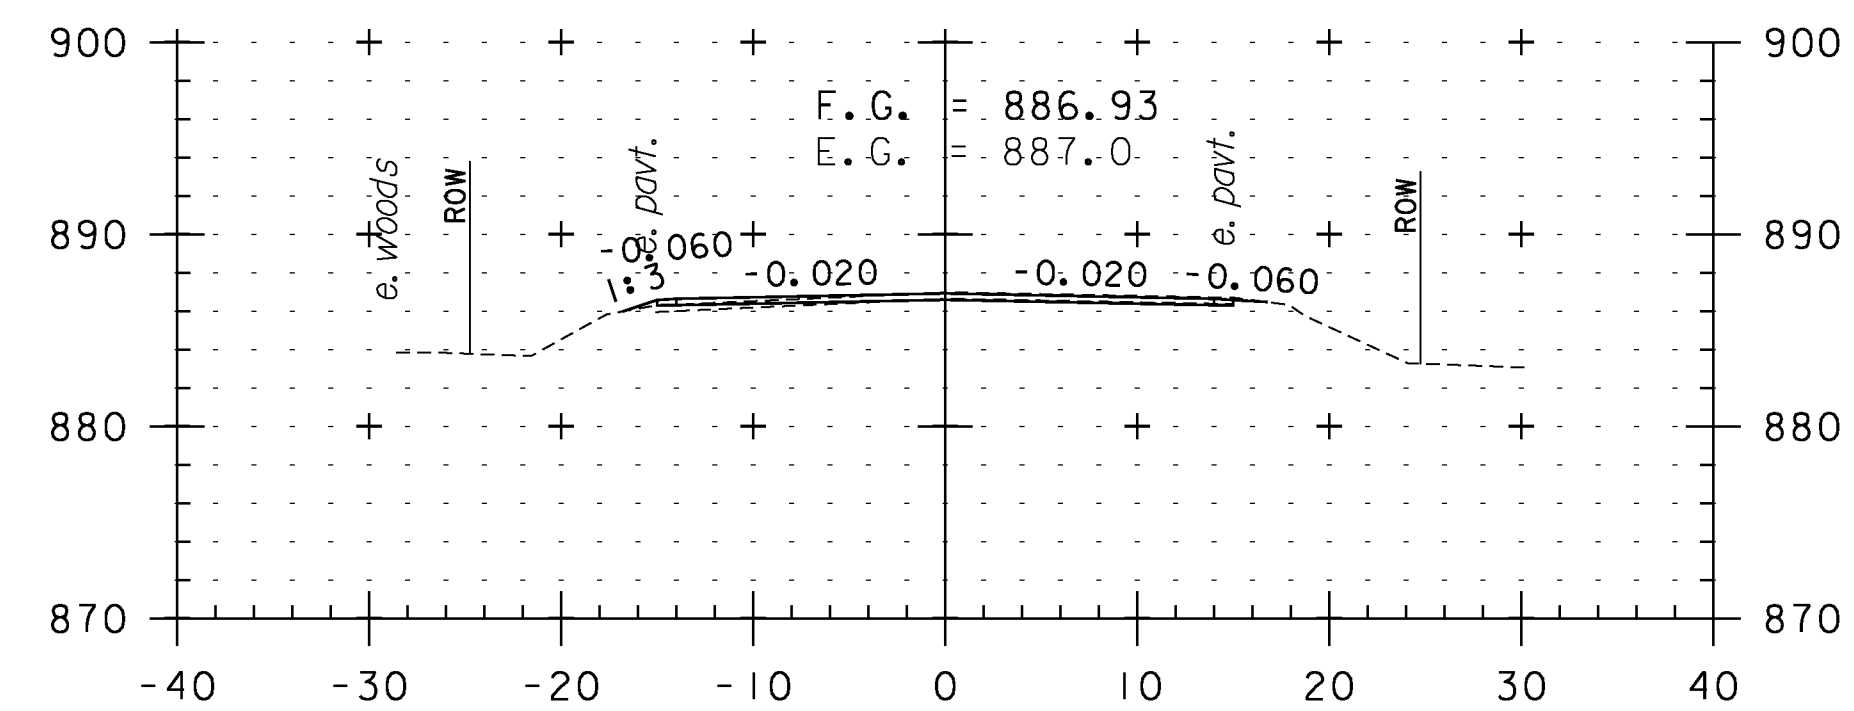


270+00

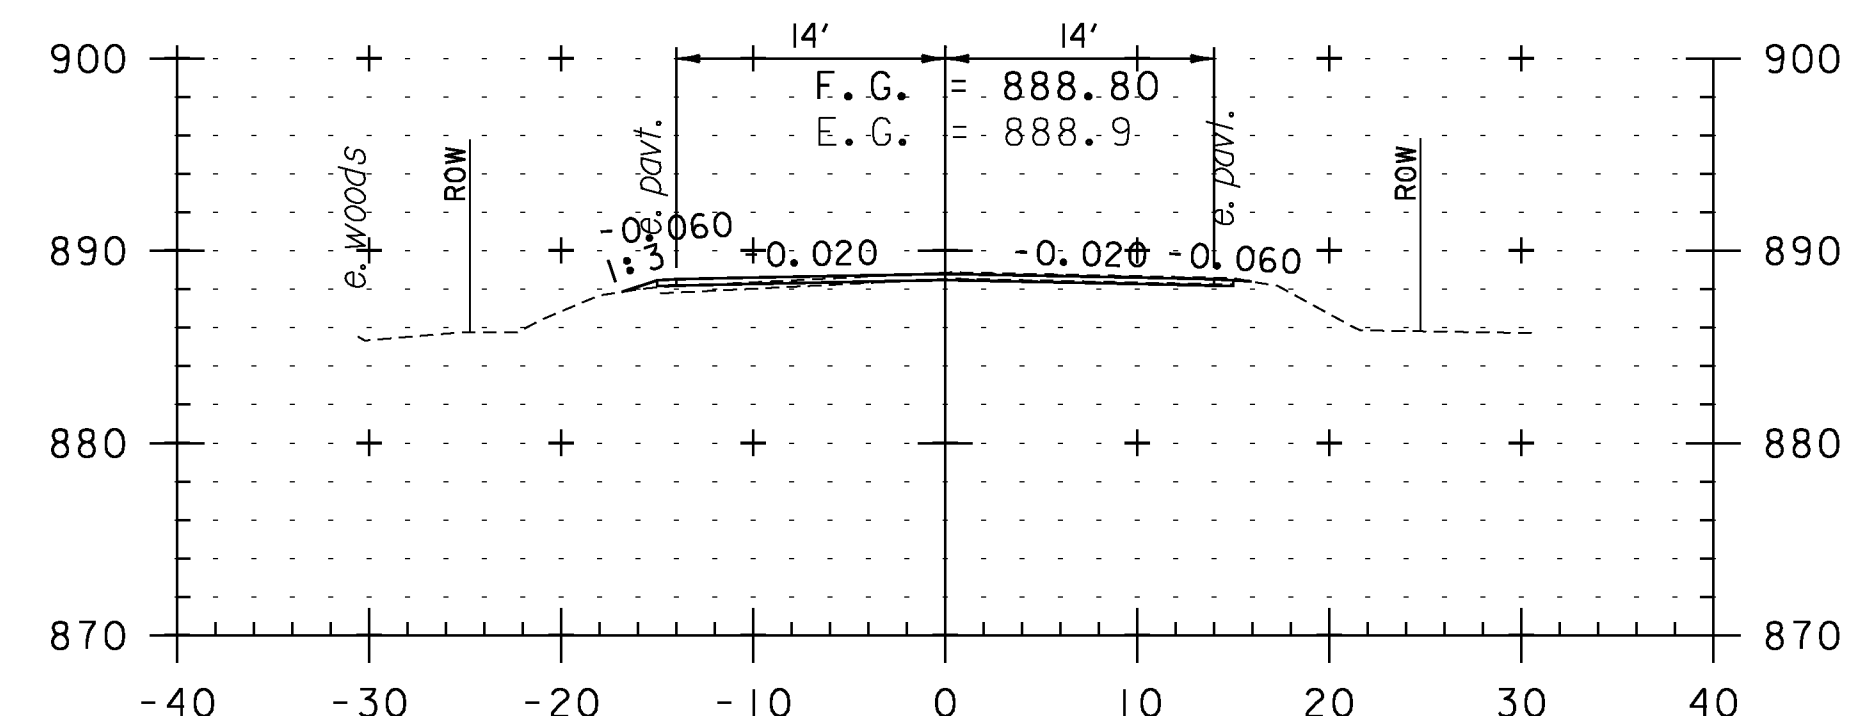


269+50

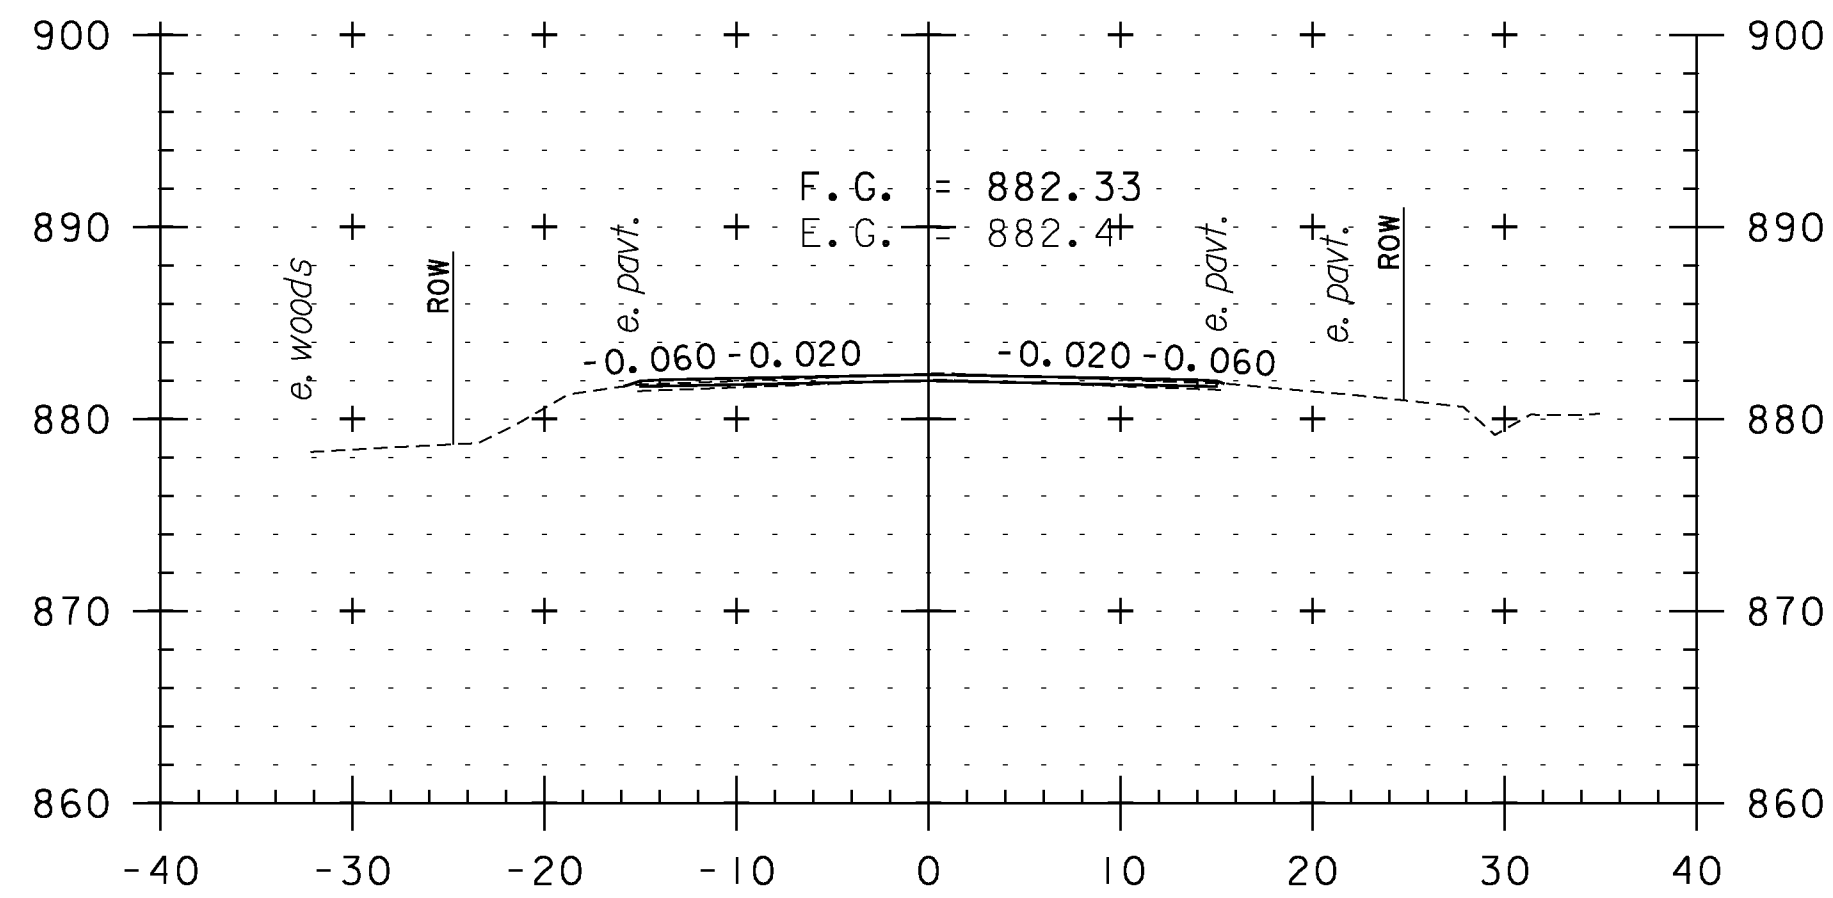


271+50

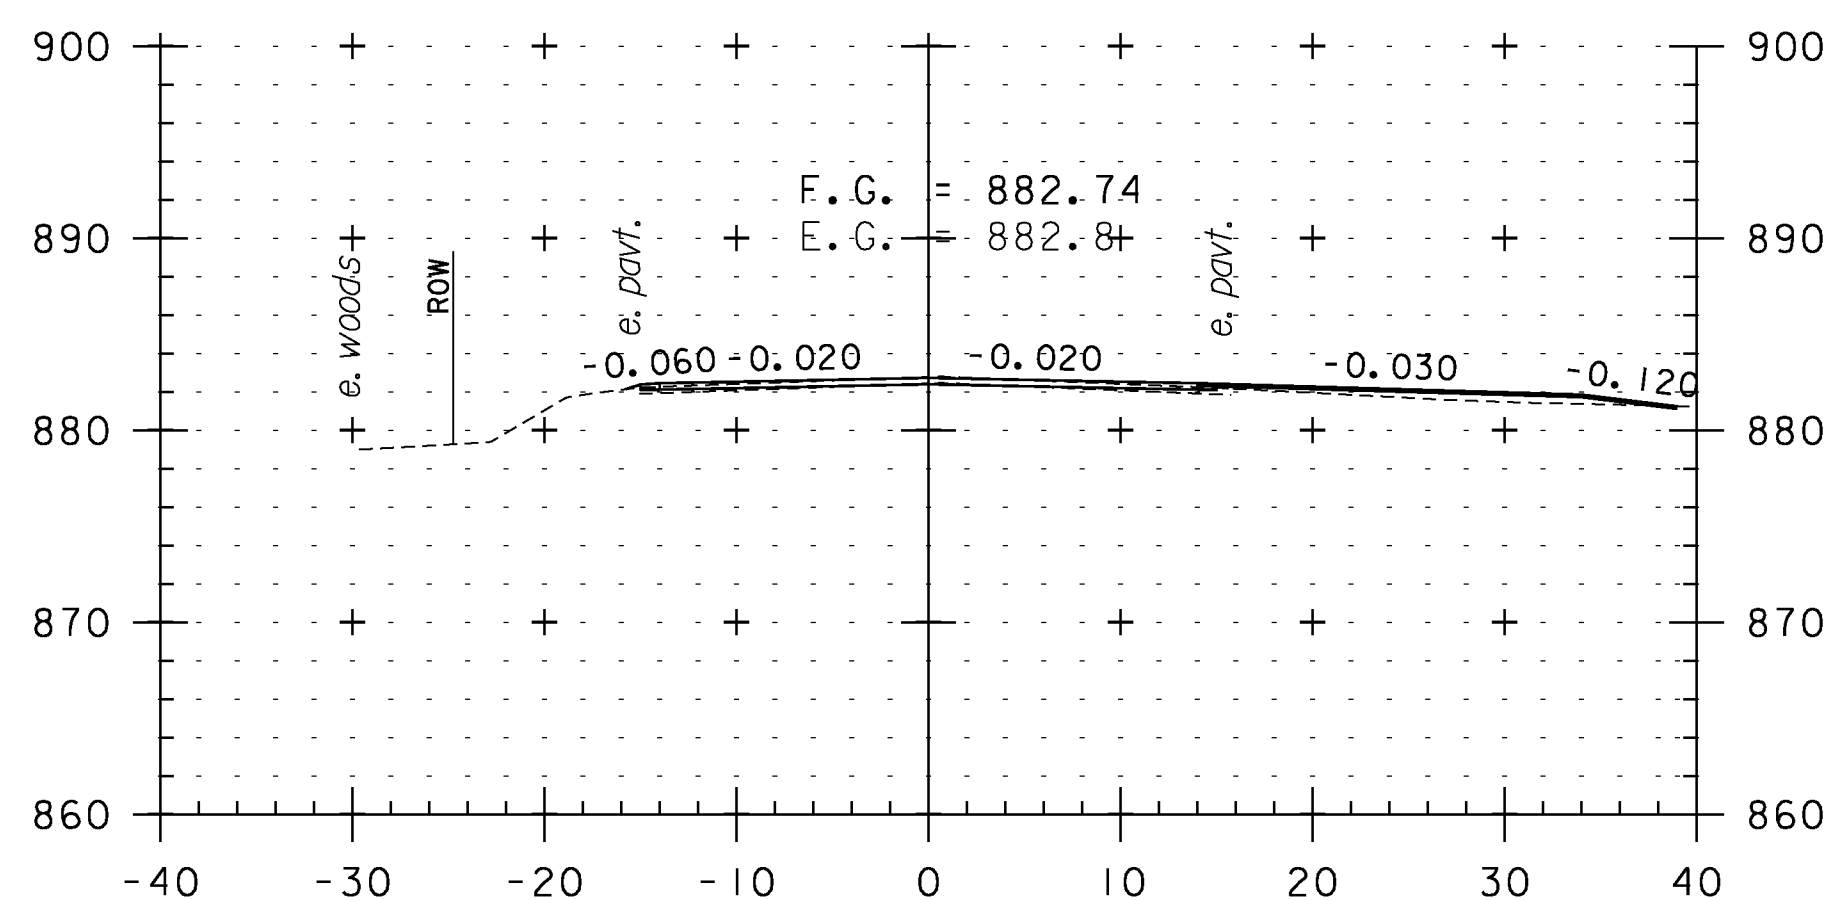


271+30  
TH 8

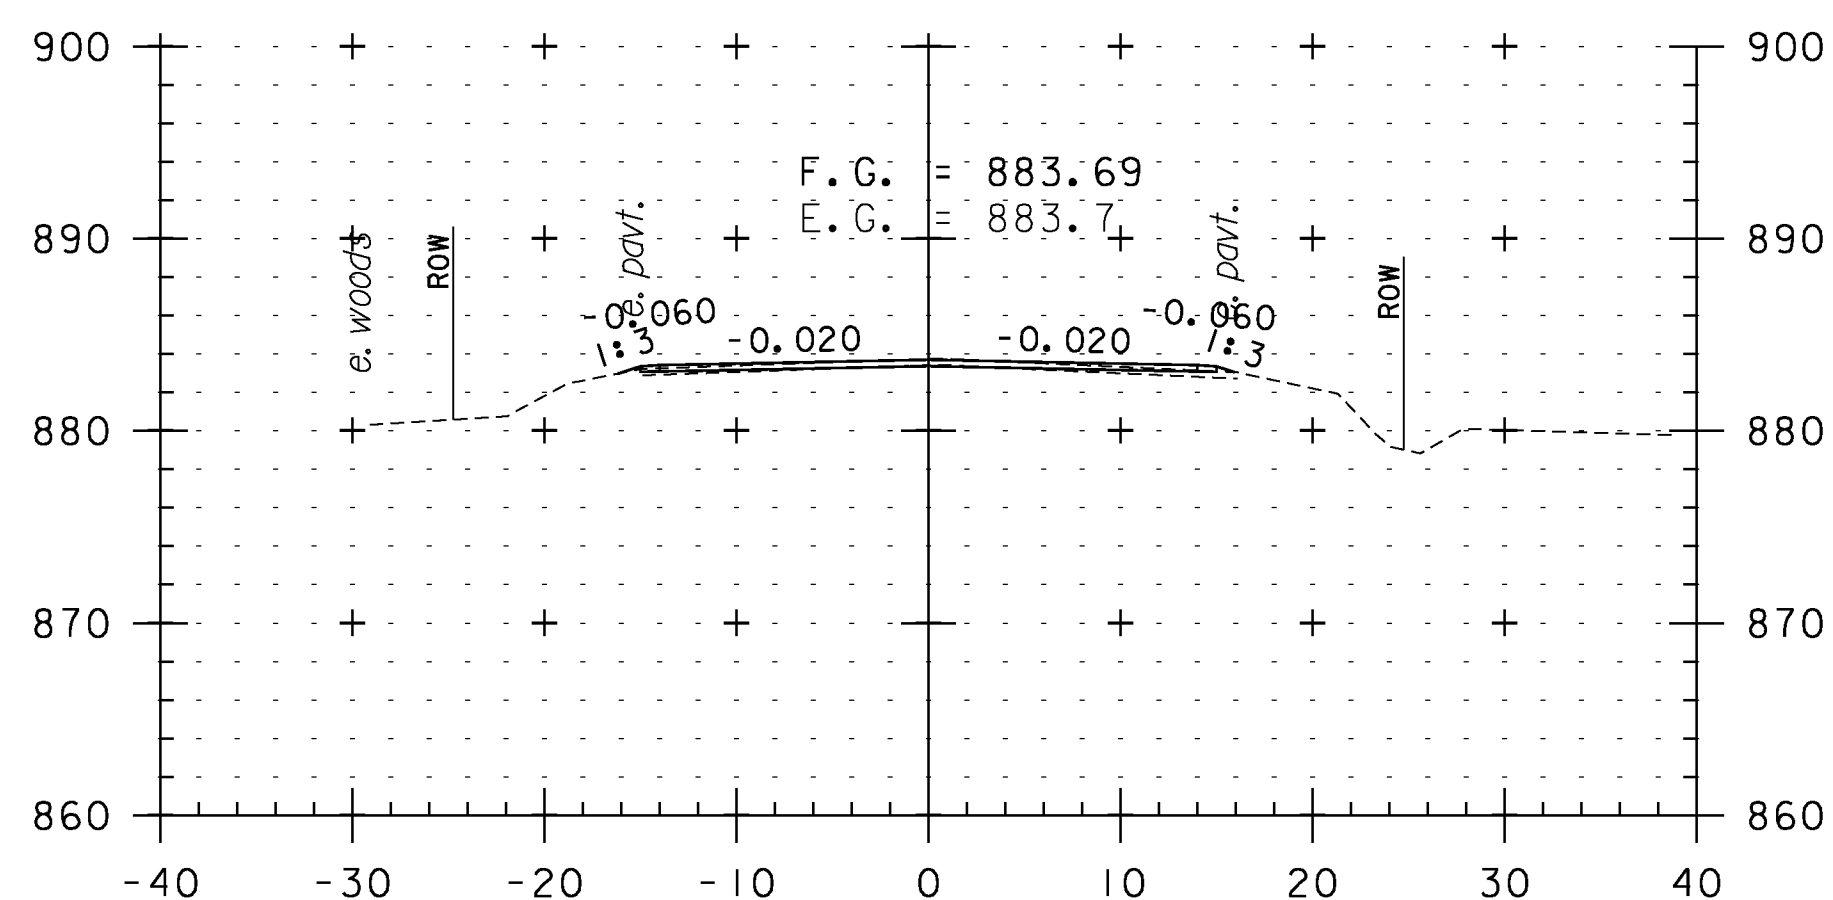


271+00

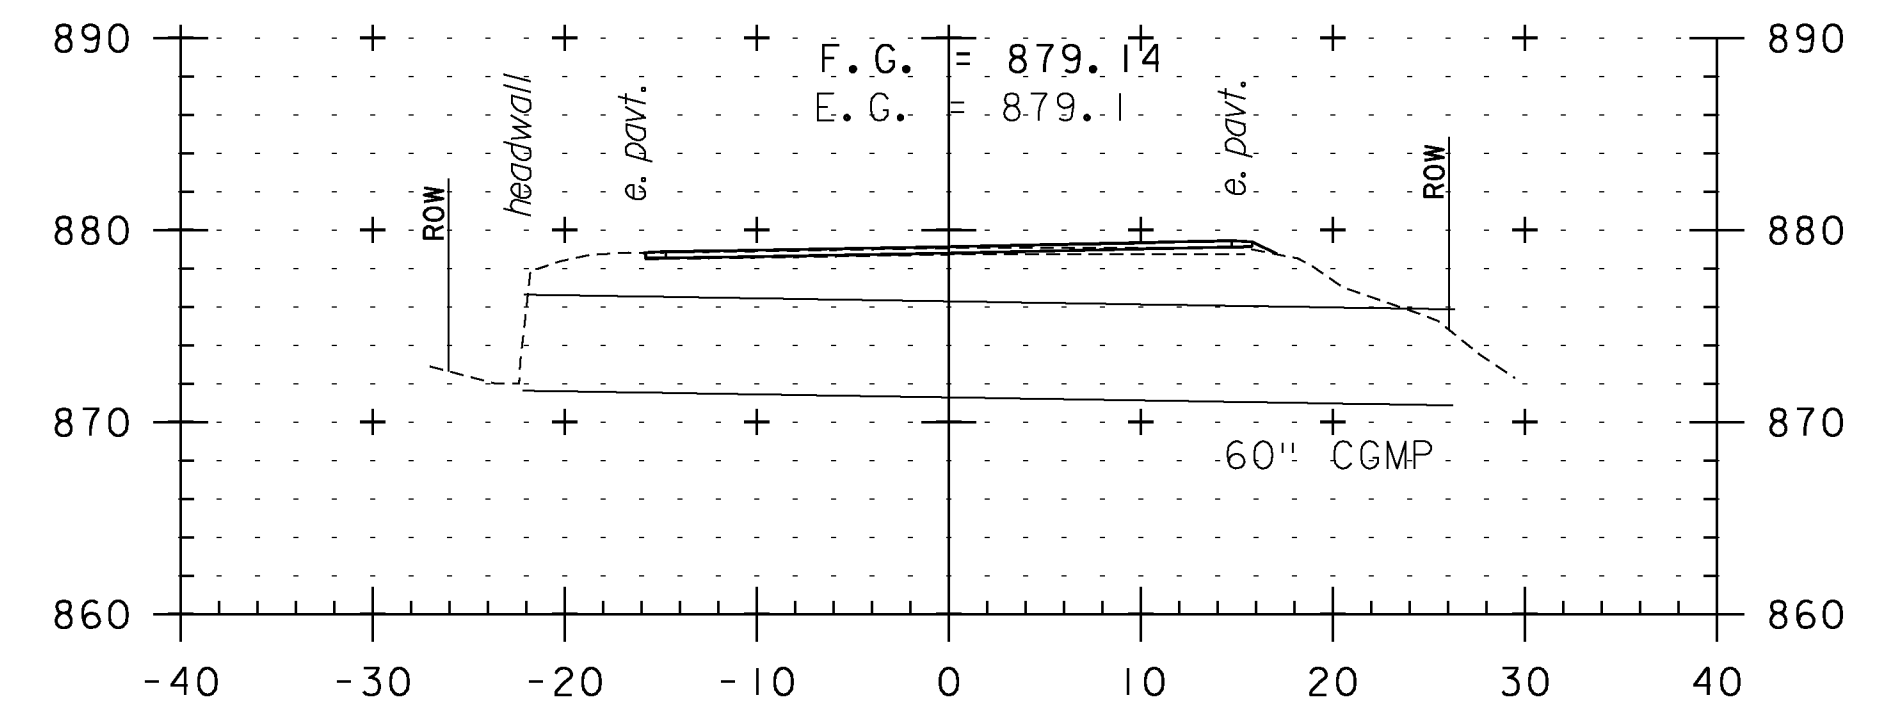

272+76  
BRIDGE 13

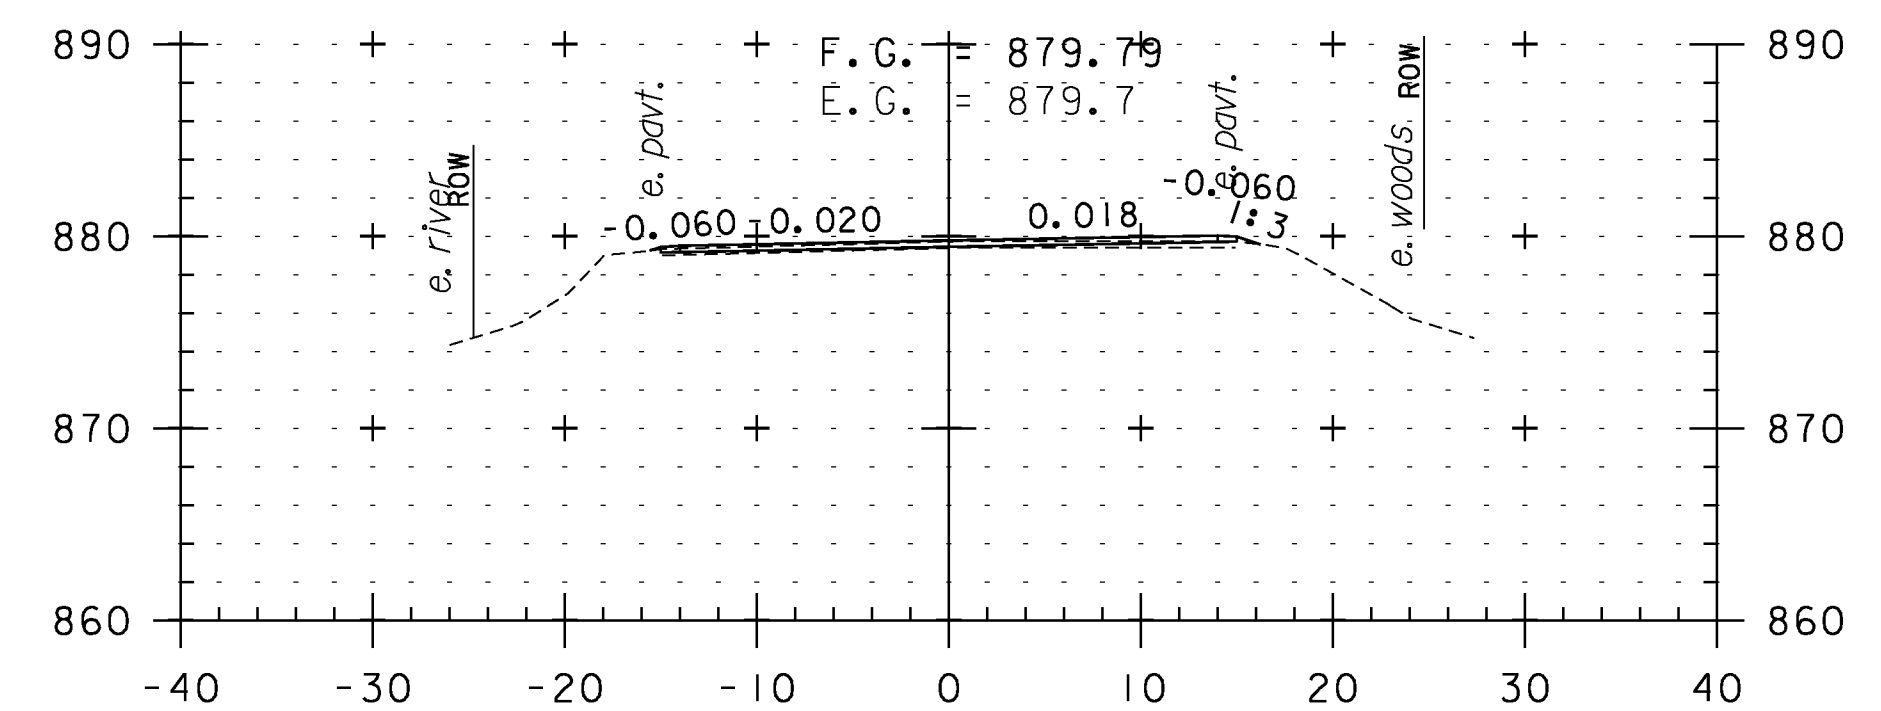

272+50

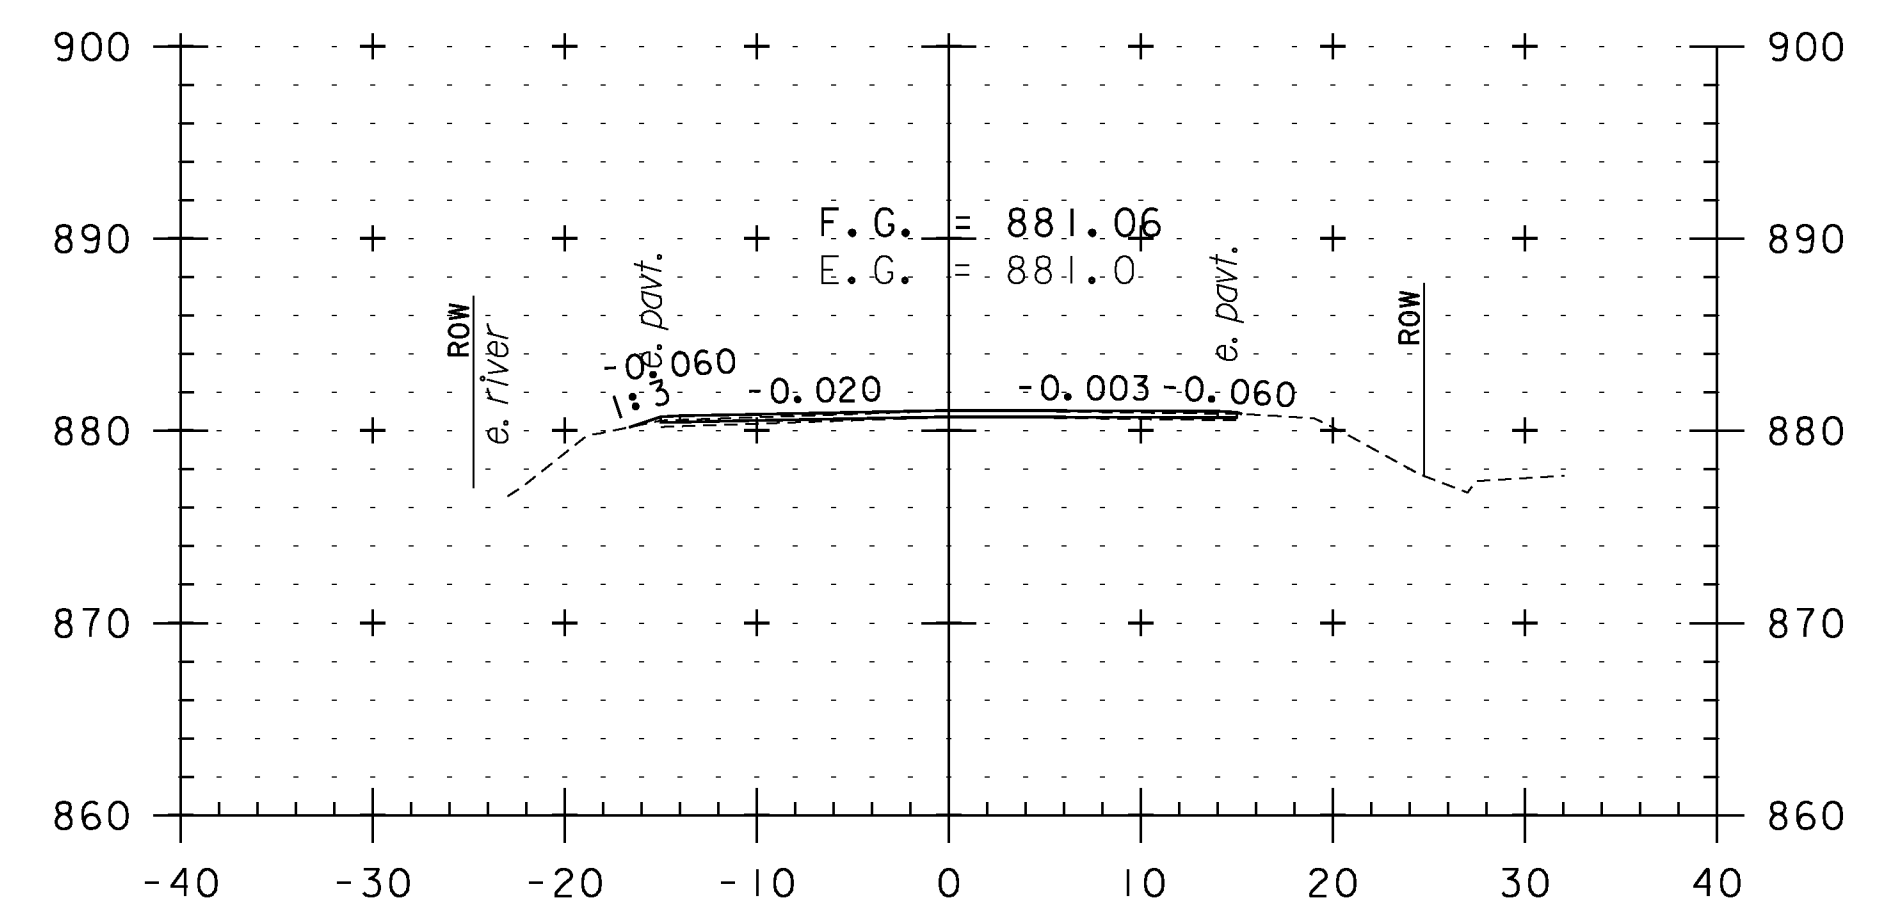

272+00

**CROSS SECTION SHEET 48**

PROJECT NAME: WEATHERSFIELD

PROJECT NUMBER: STP 2913(I)

FILE NAME: I0c228

PROJECT LEADER: PTS

DESIGNED BY: NLL


IPARM FILE NAME: pI0c228.I38

PLOT DATE: 2/7/2013

DRAWN BY: WWG

CHECKED BY: PTS

SHEET 138 OF 234

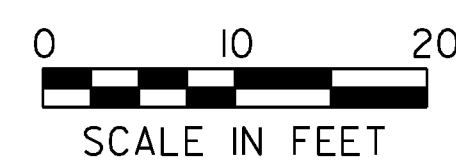

STA. 269+50 TO STA. 272+76