




307+94
BRIDGE 15

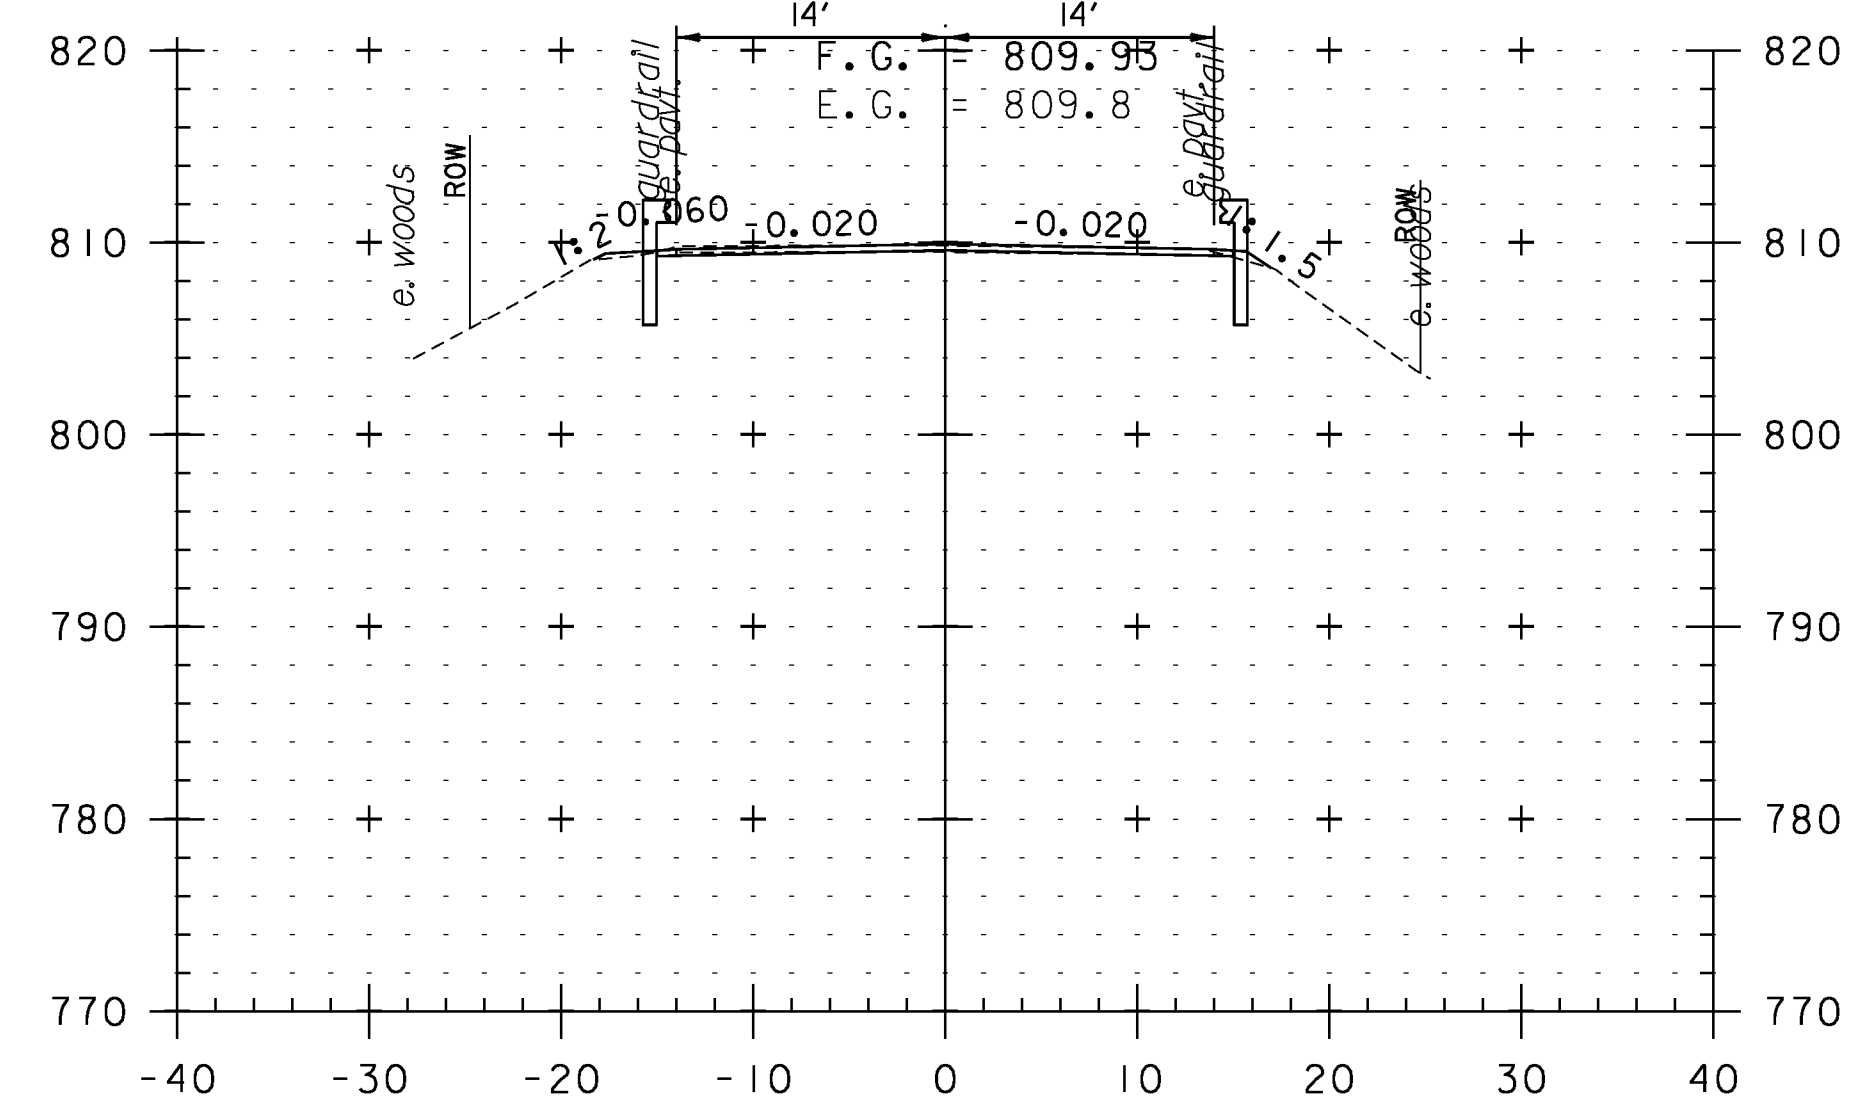


307+50

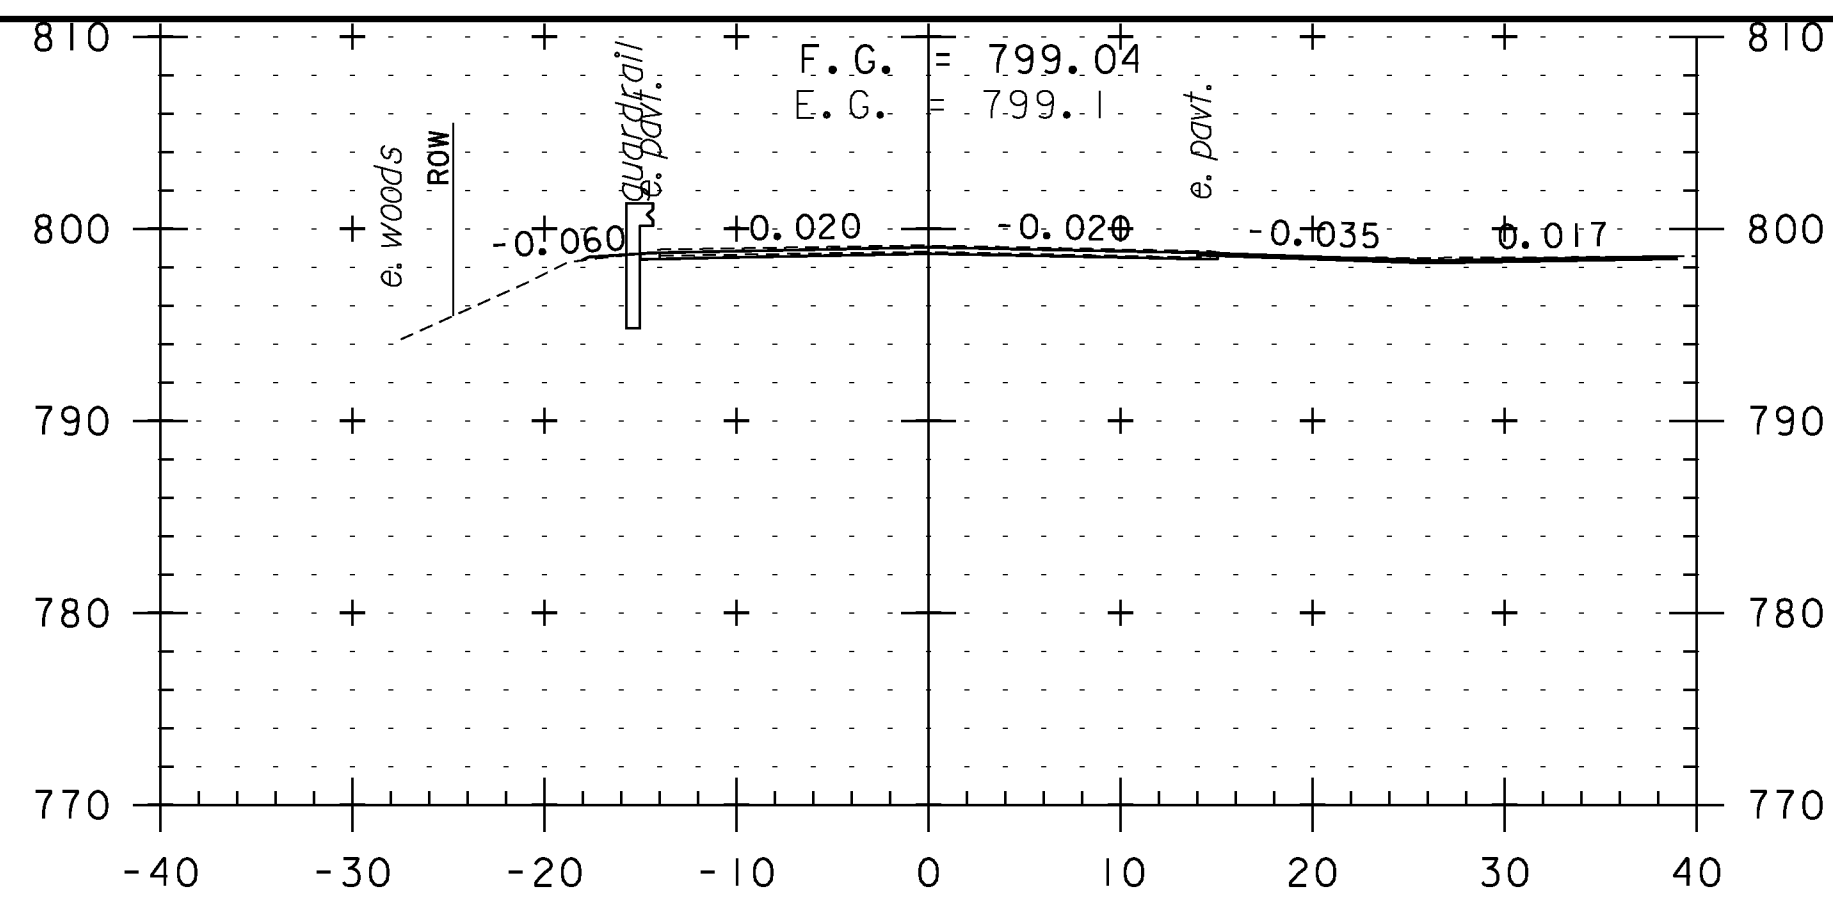


308+85
TH 14

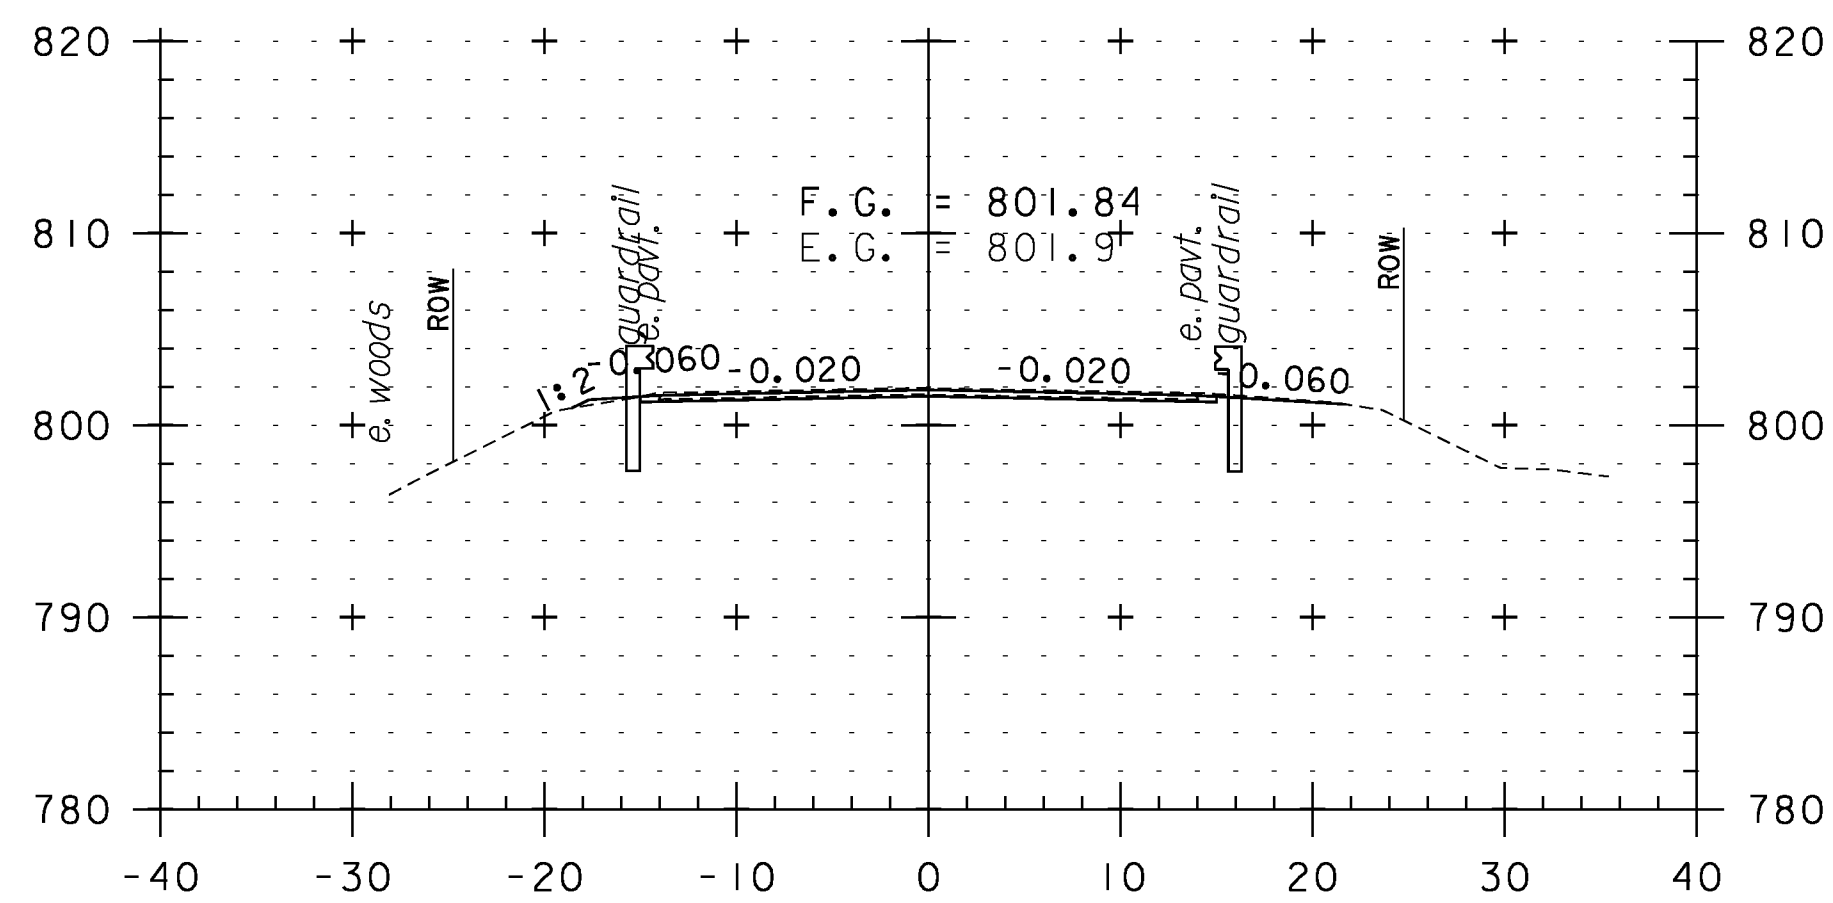


308+50

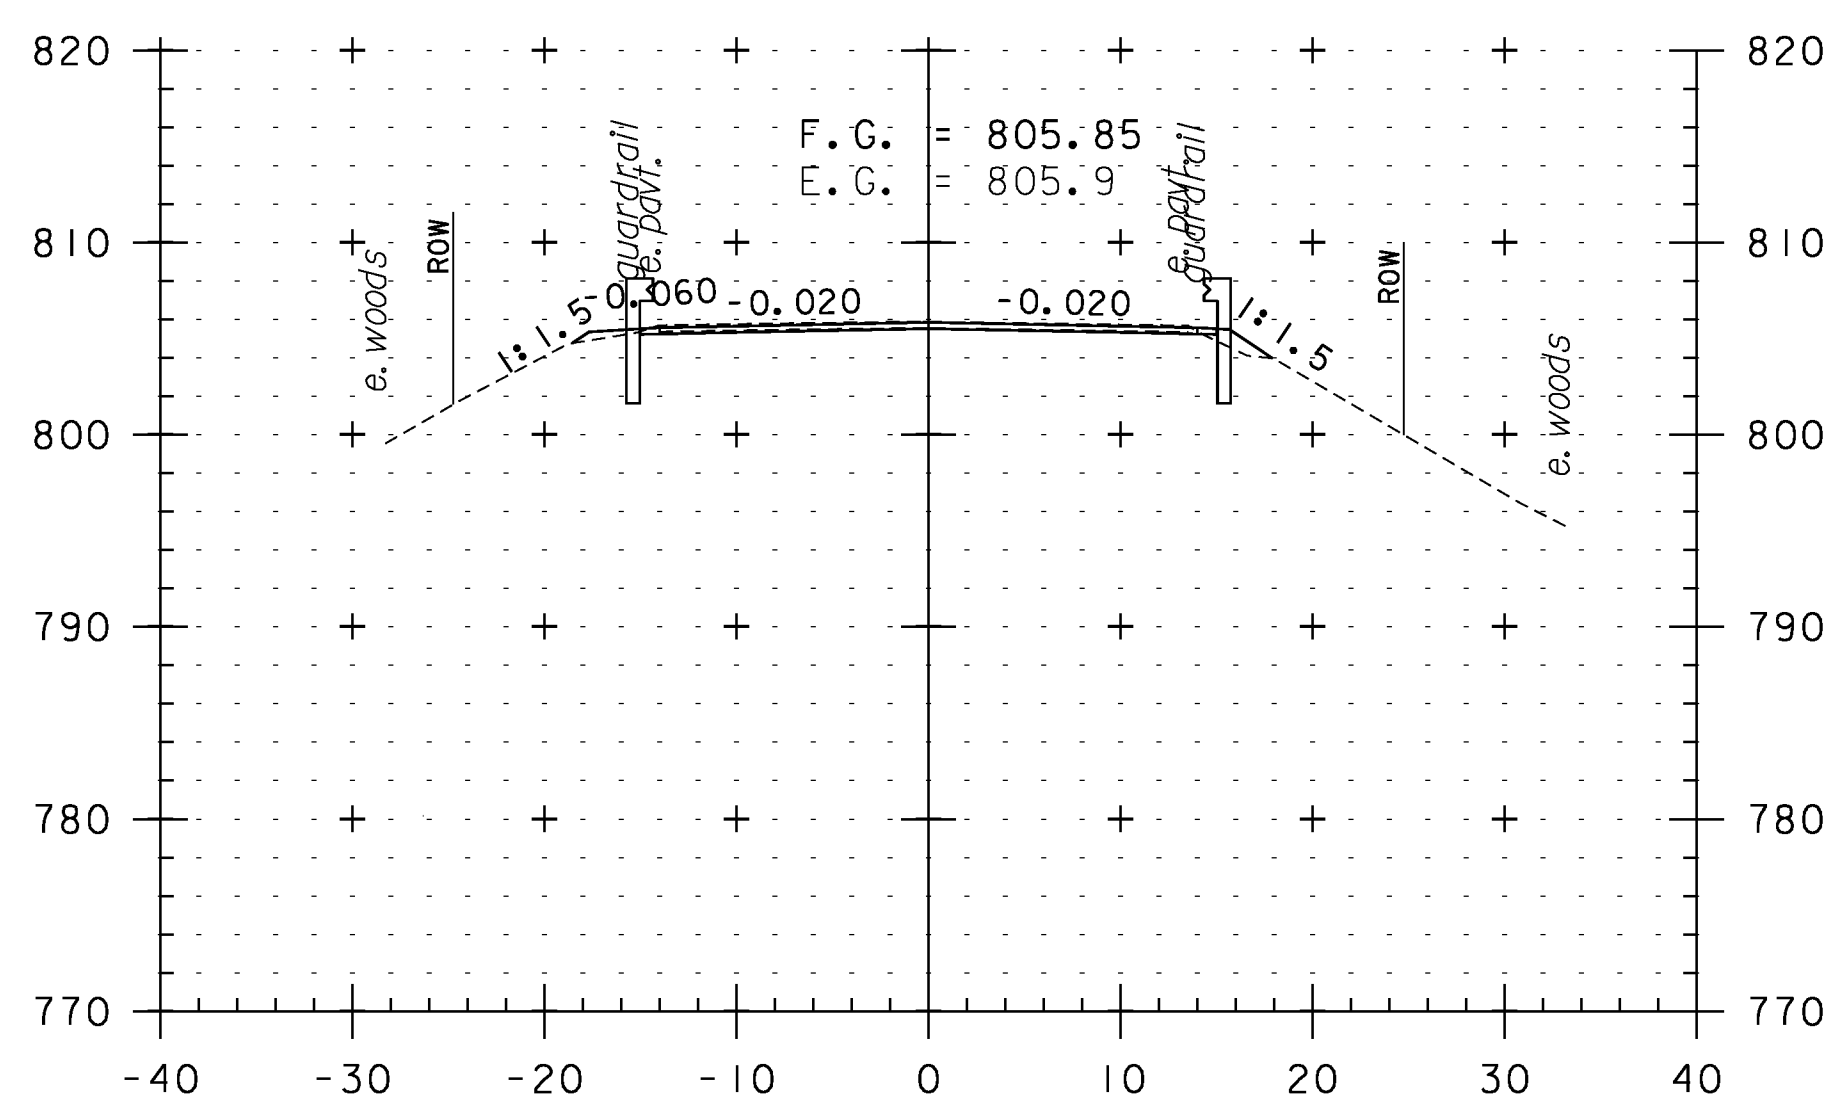


308+00

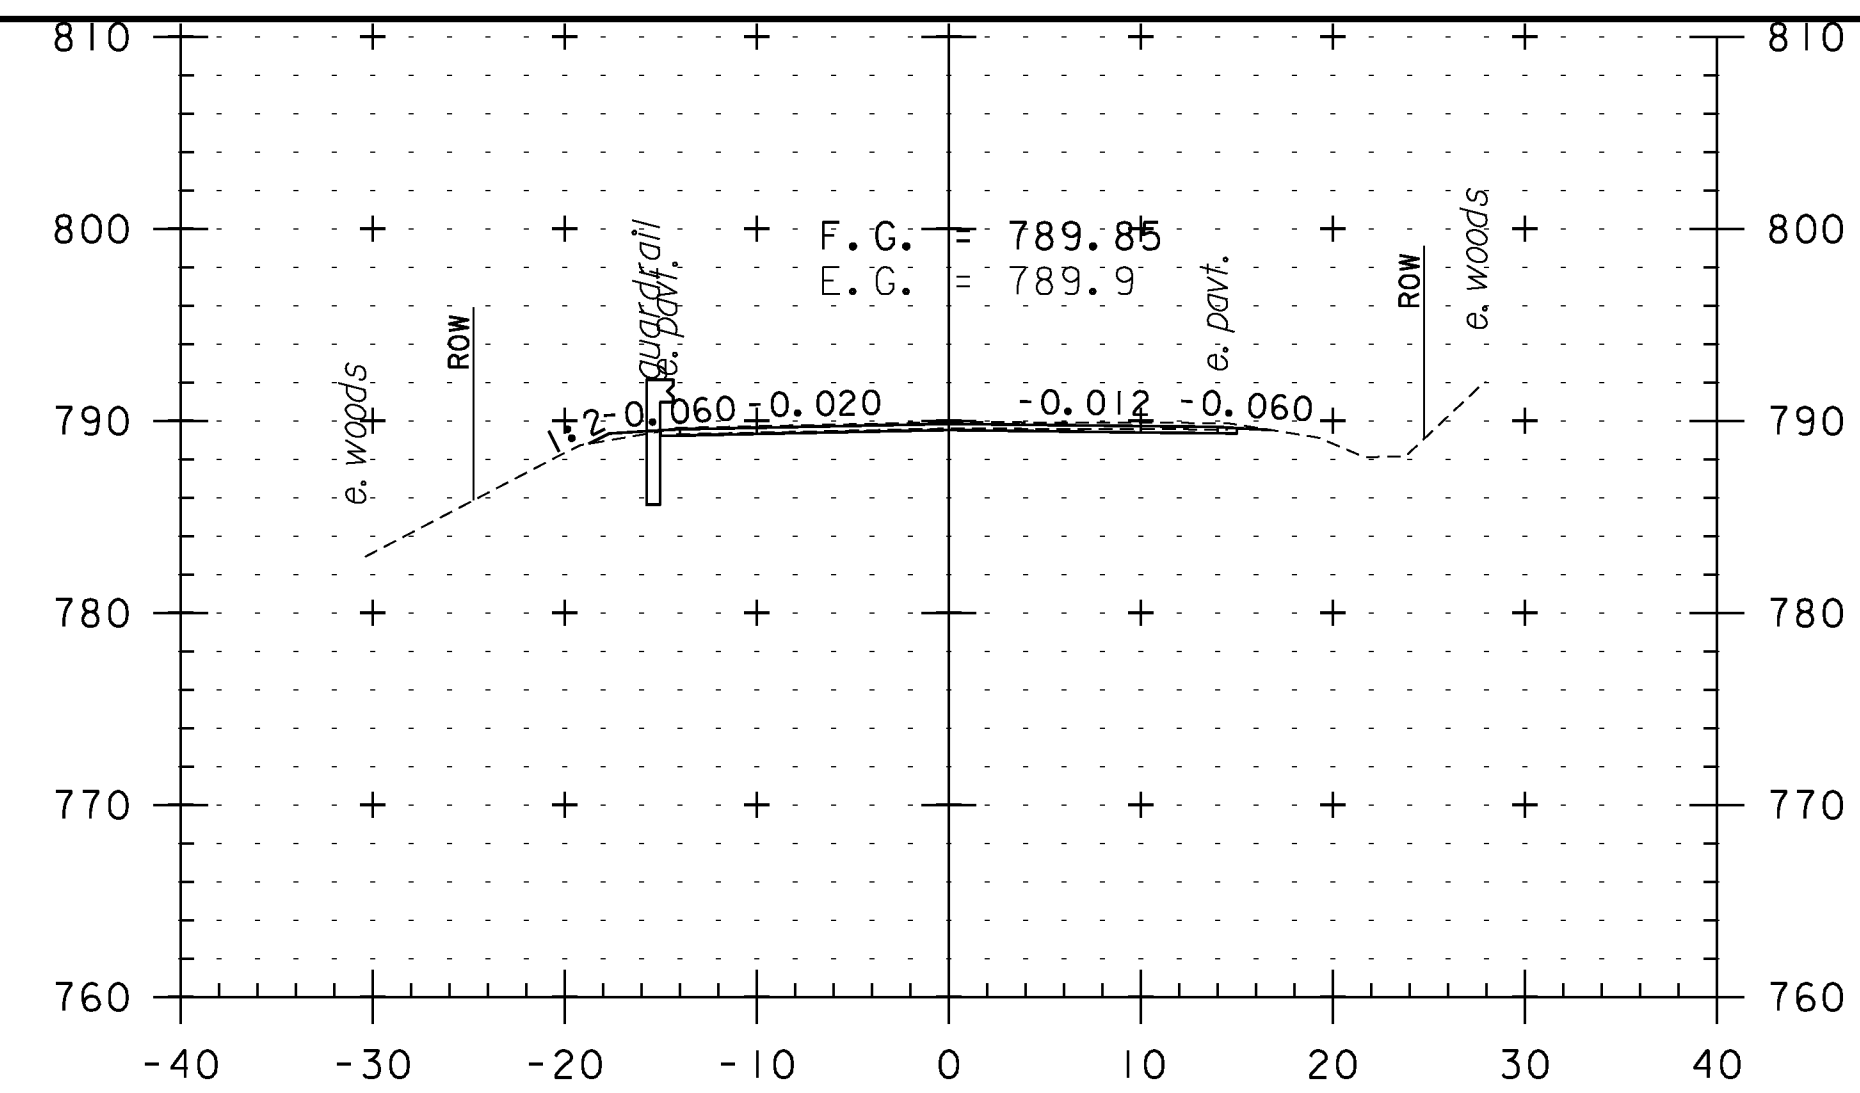

310+00

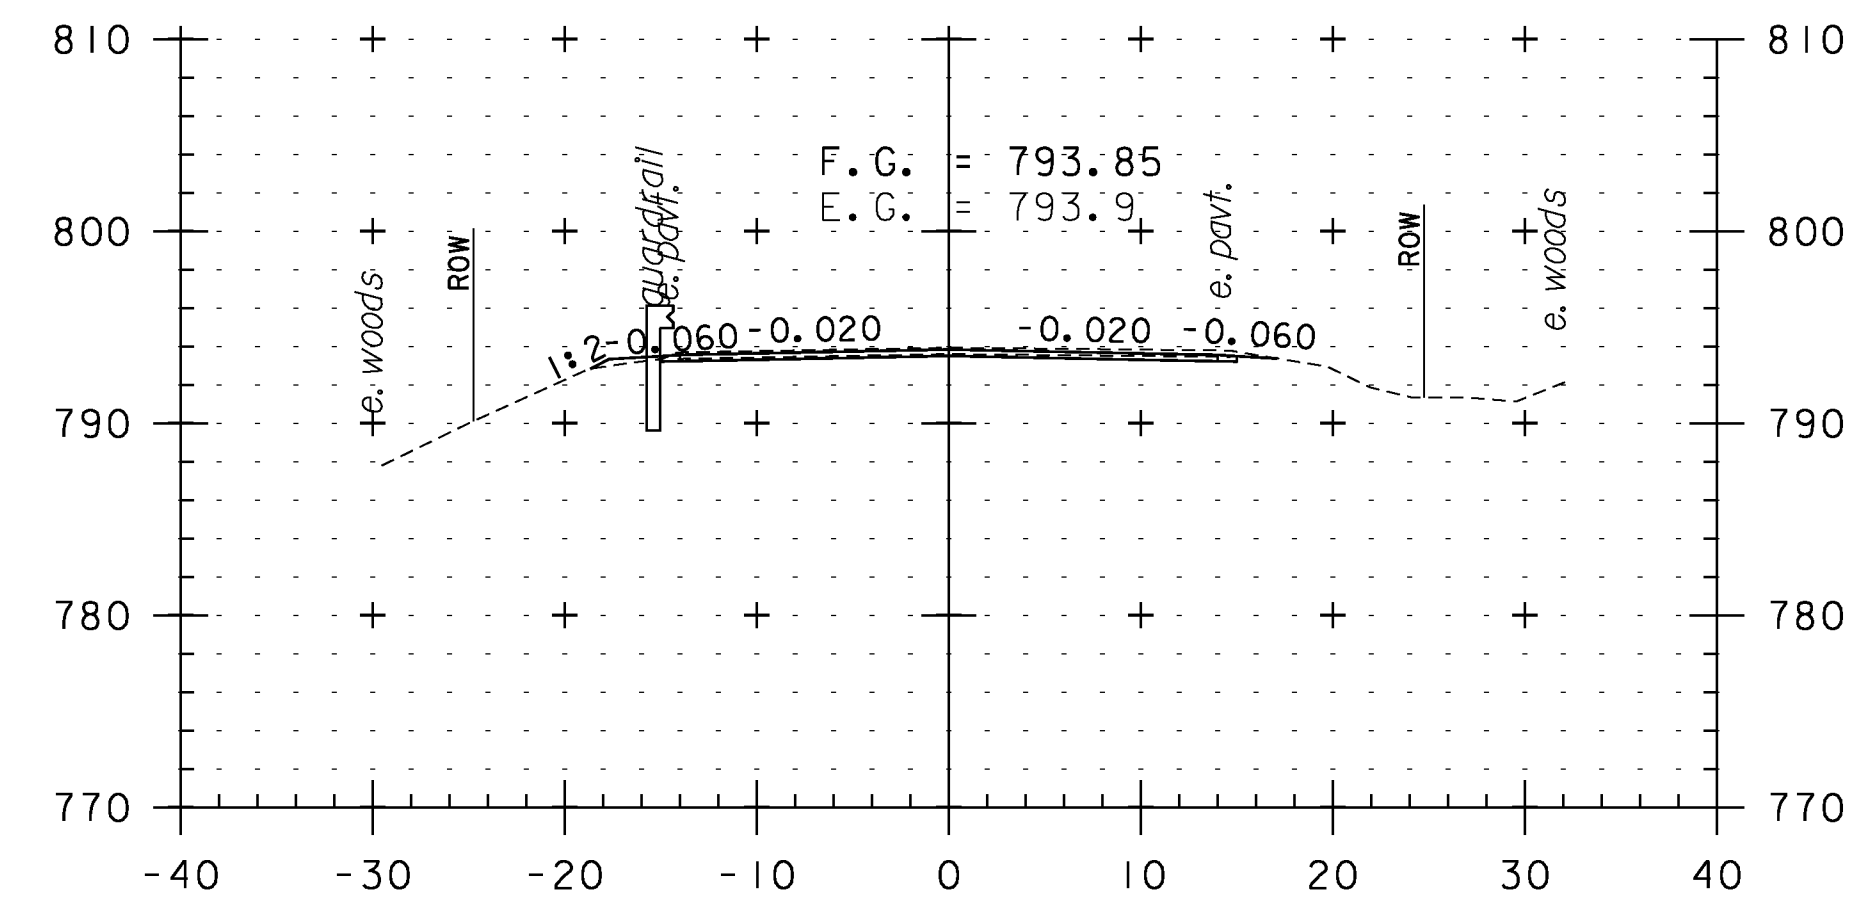

309+50

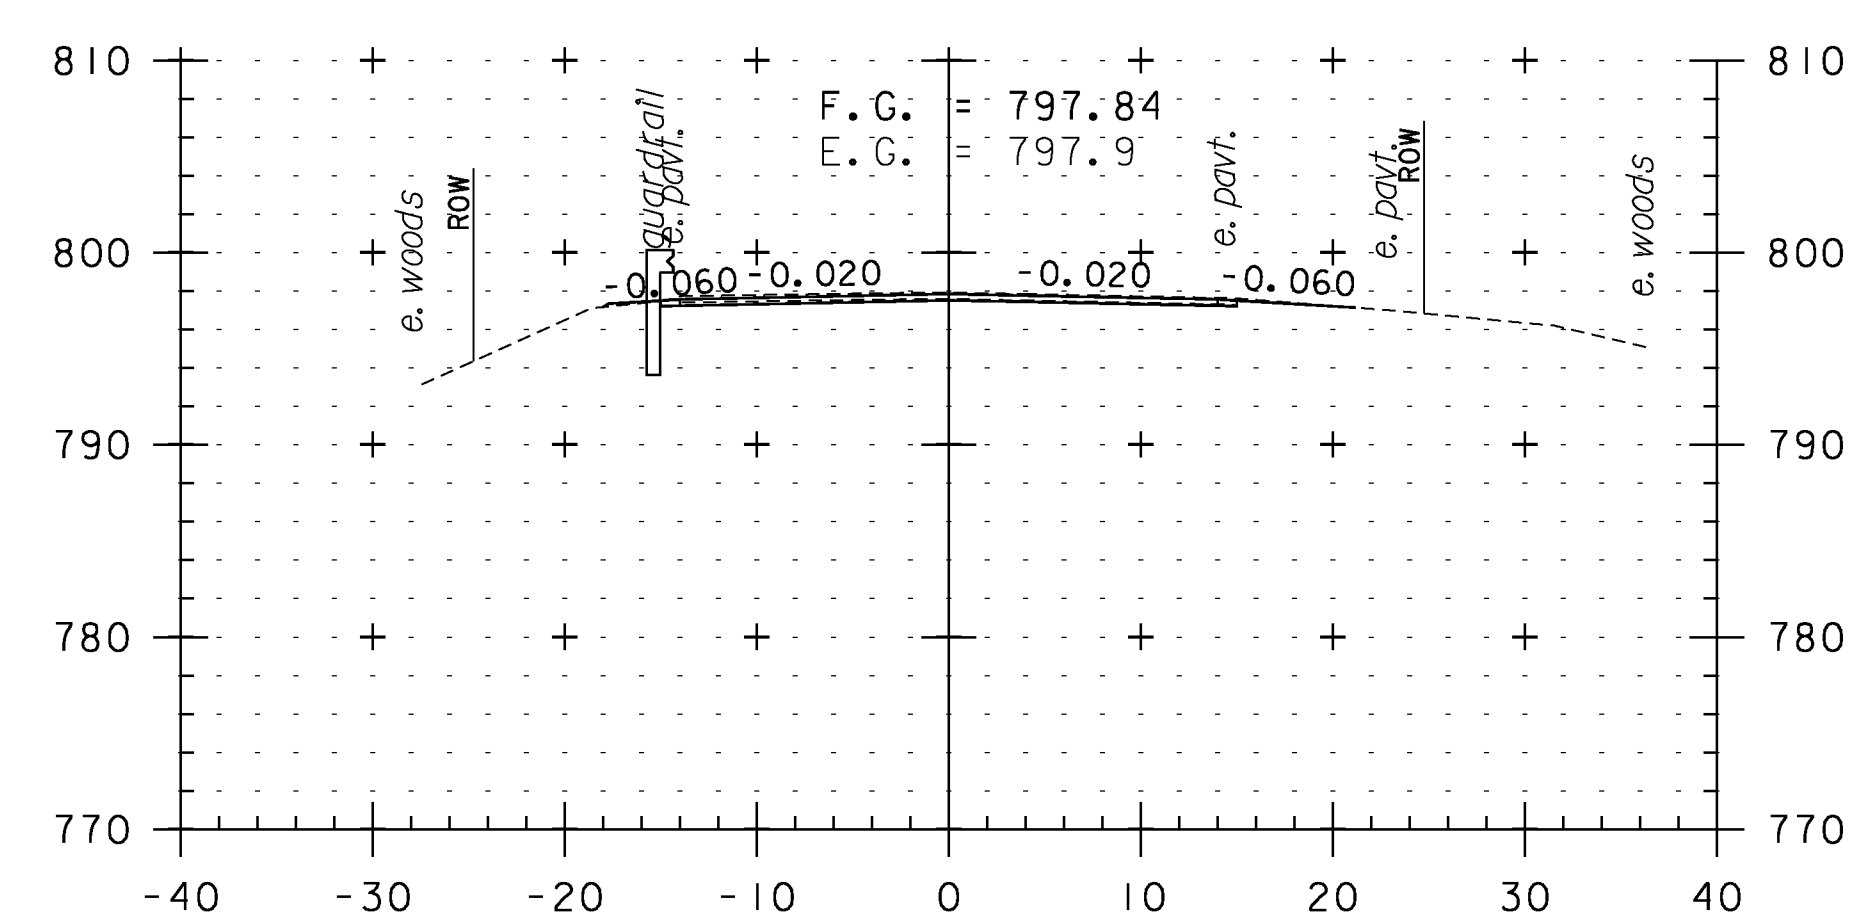

309+00

CROSS SECTION SHEET 57

PROJECT NAME: WEATHERSFIELD

PROJECT NUMBER: STP 2913(1)

FILE NAME: I0c228

PROJECT LEADER: PTS

DESIGNED BY: NLL


IPARM FILE NAME: pI0c228_147

PLOT DATE: 2/7/2013

DRAWN BY: WWG

CHECKED BY: PTS

SHEET 147 OF 234

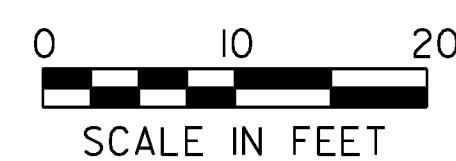

STA. 307+50 TO STA. 310+00