




311+50

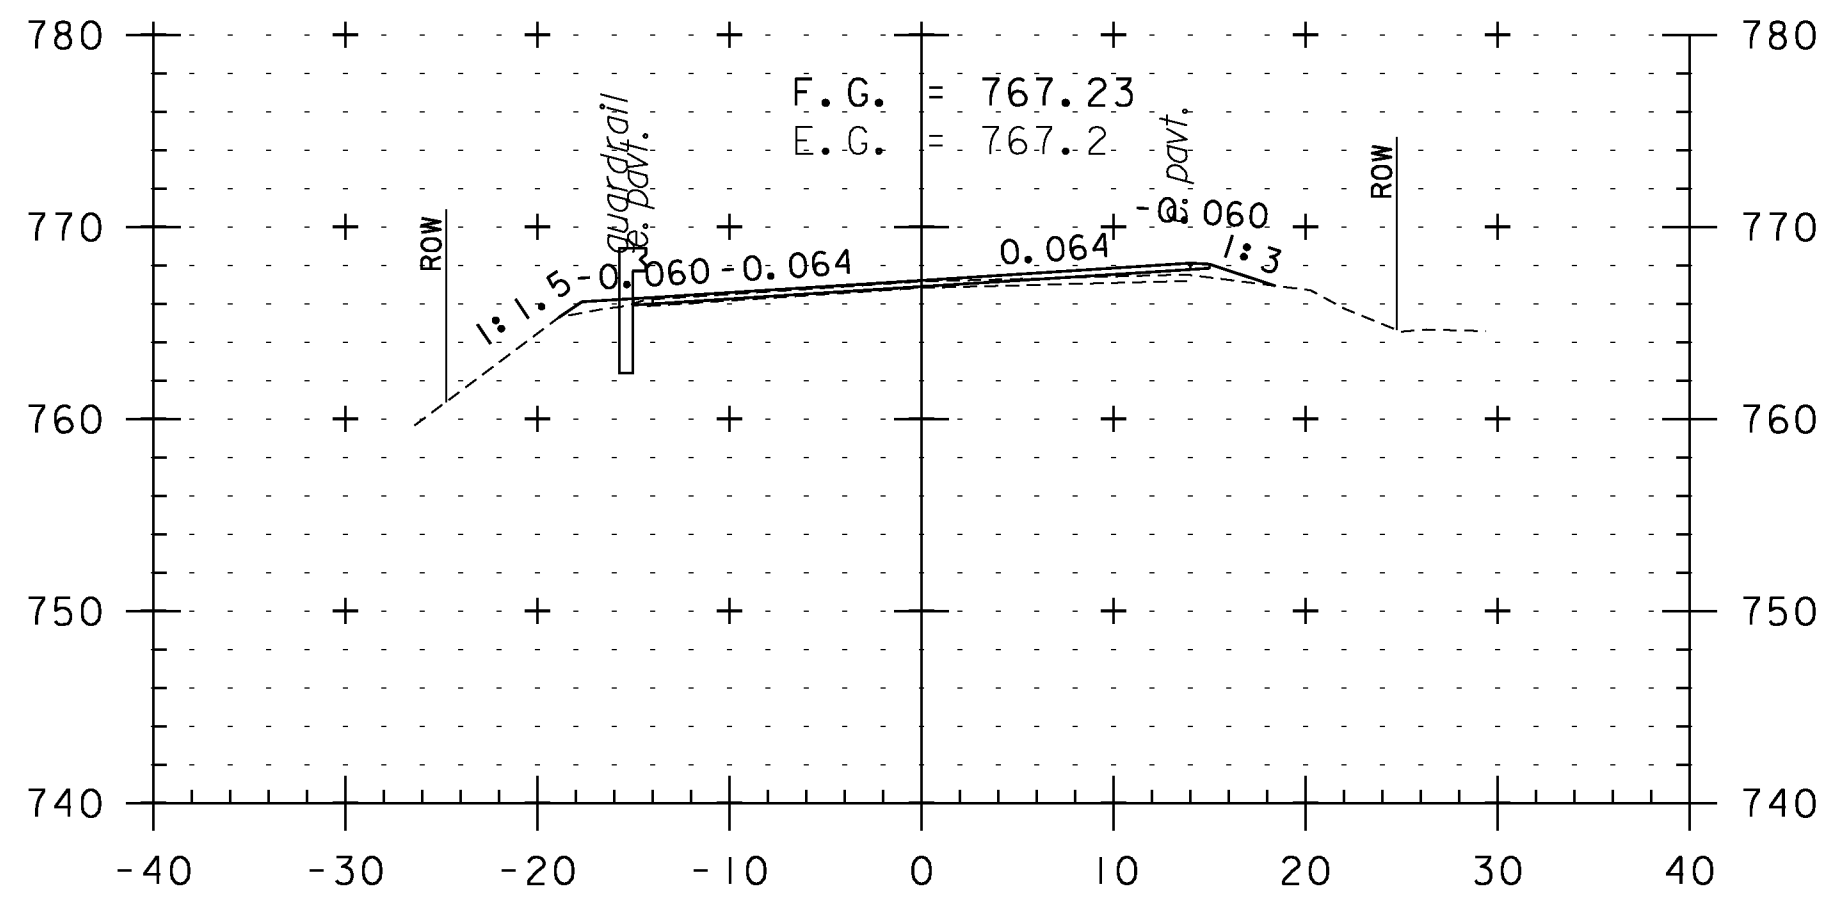


313+00

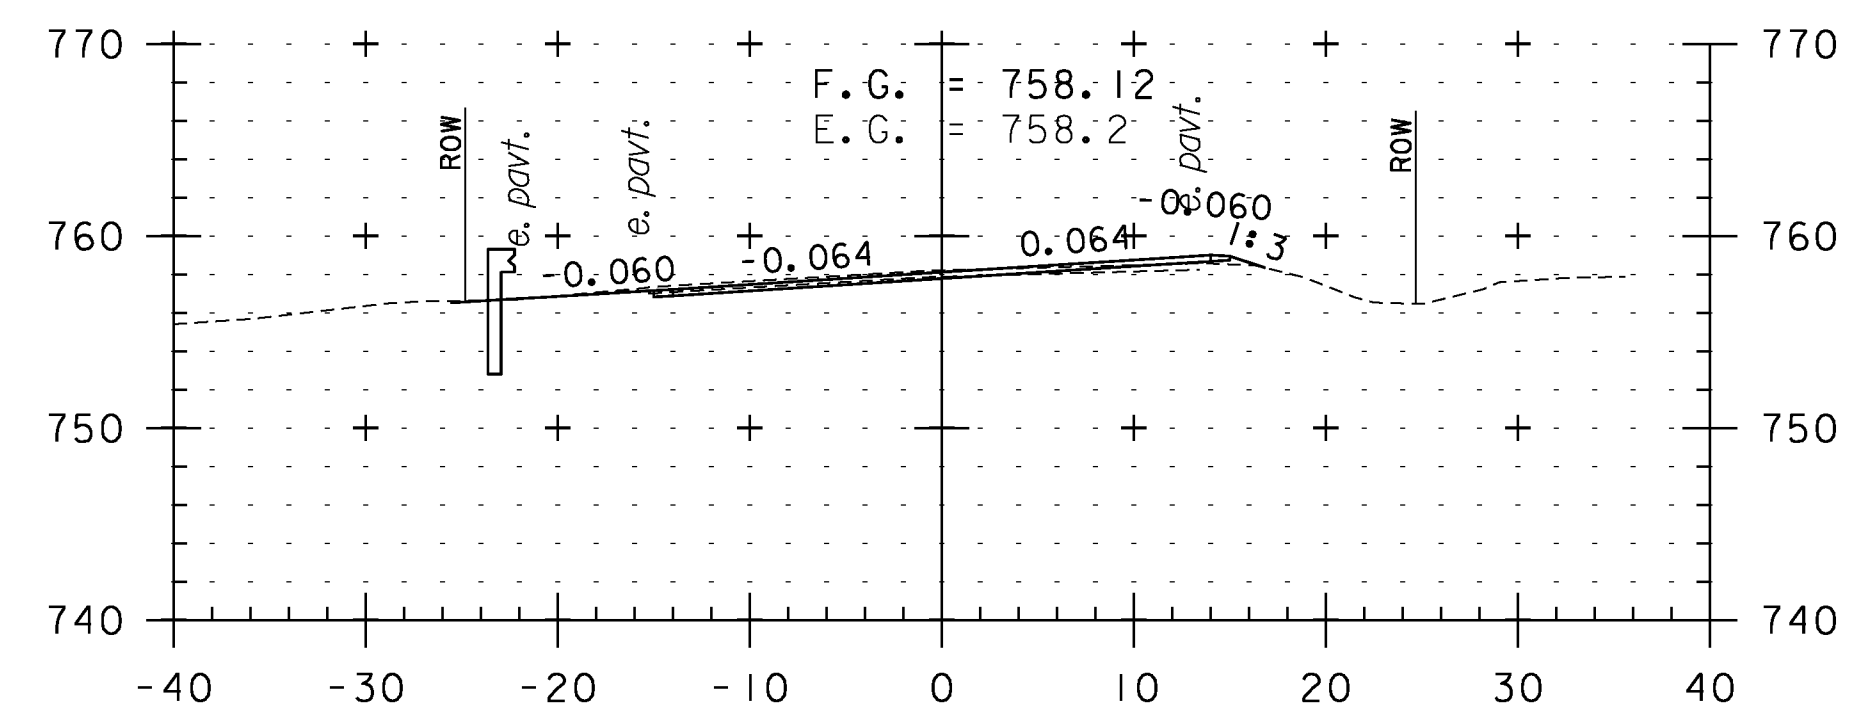


314+50

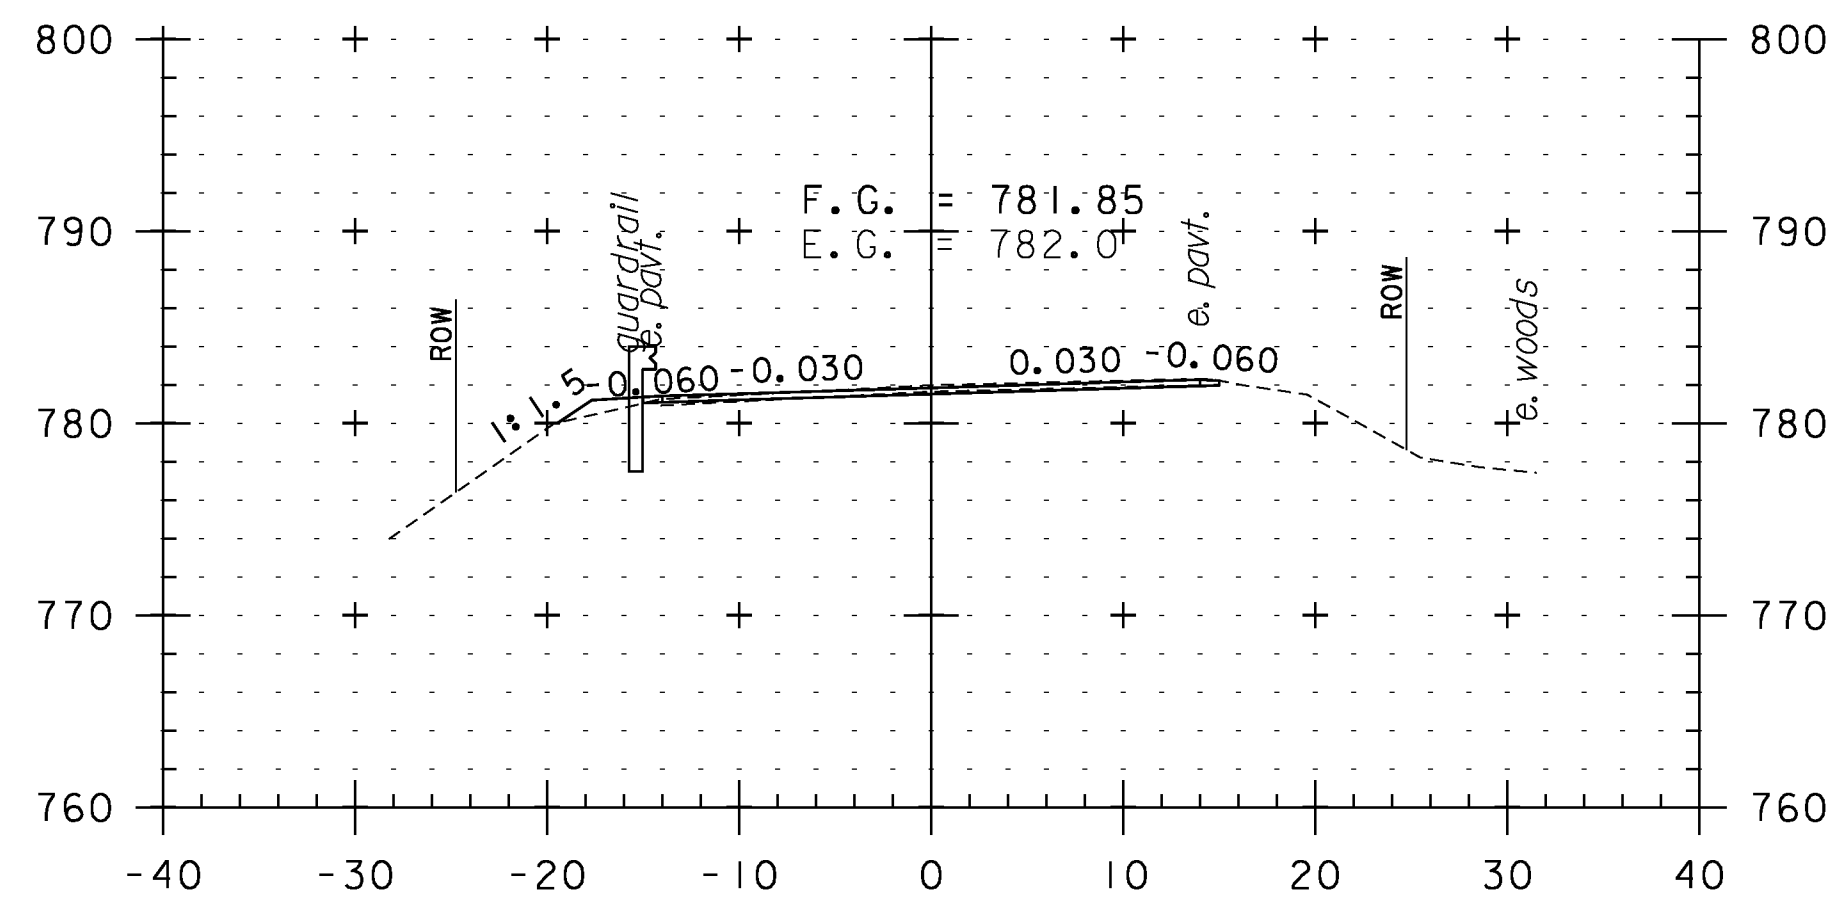


311+00

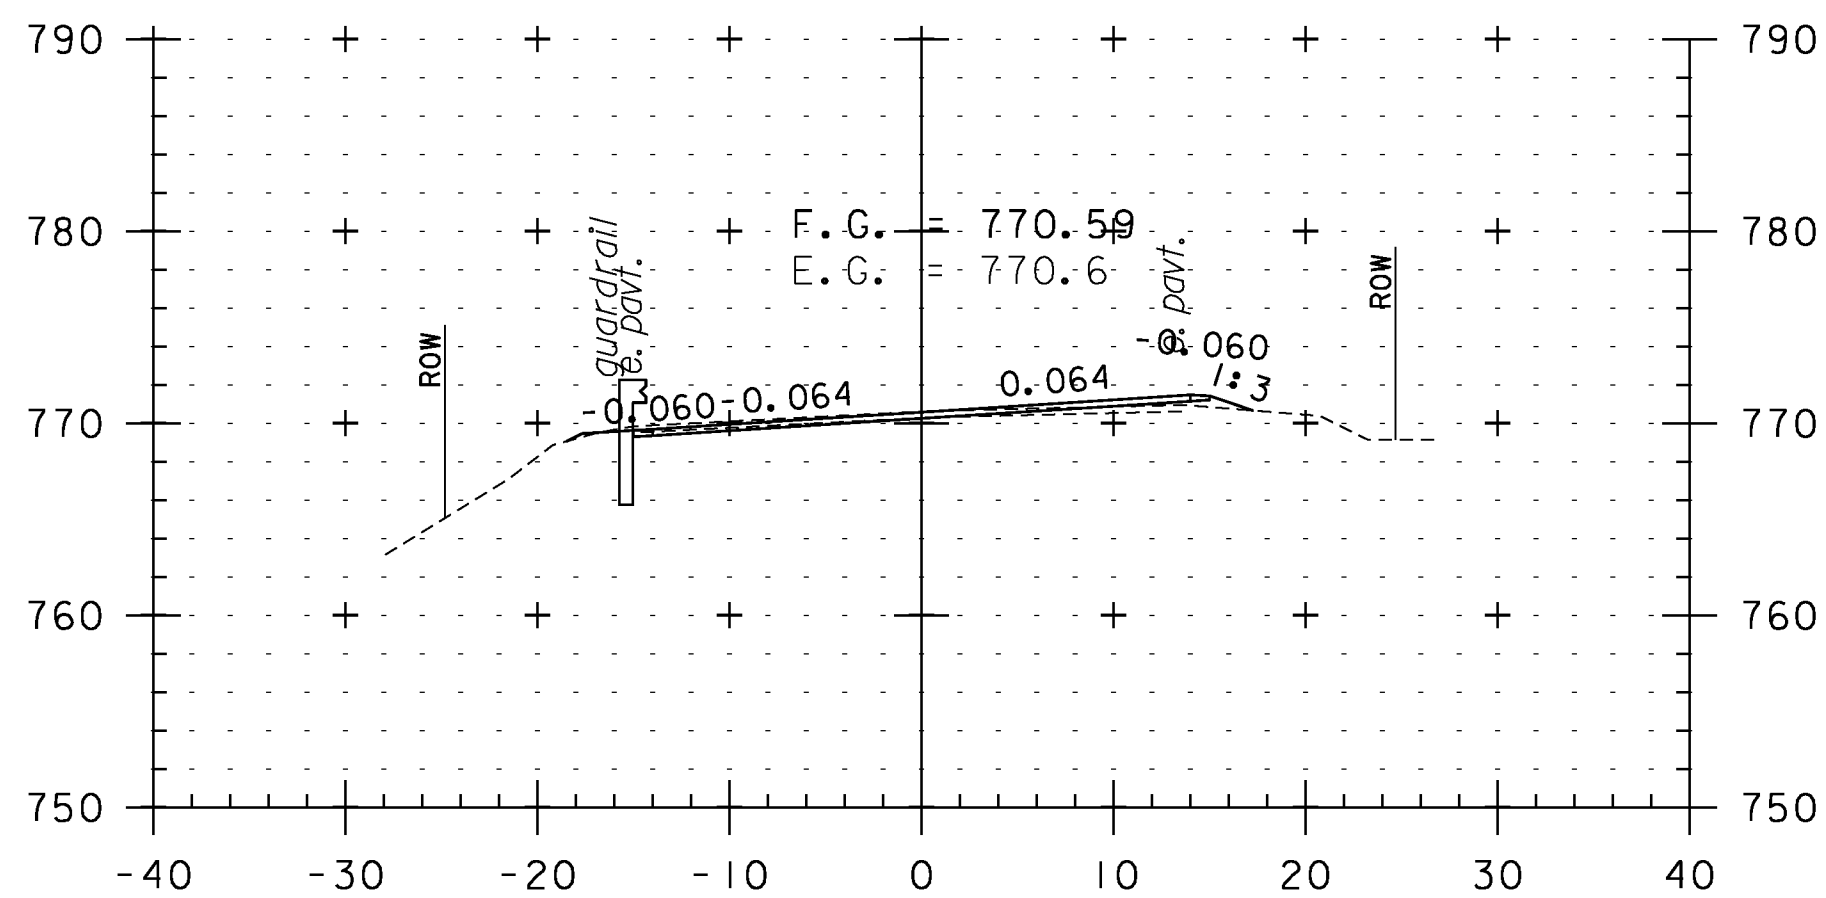


312+50

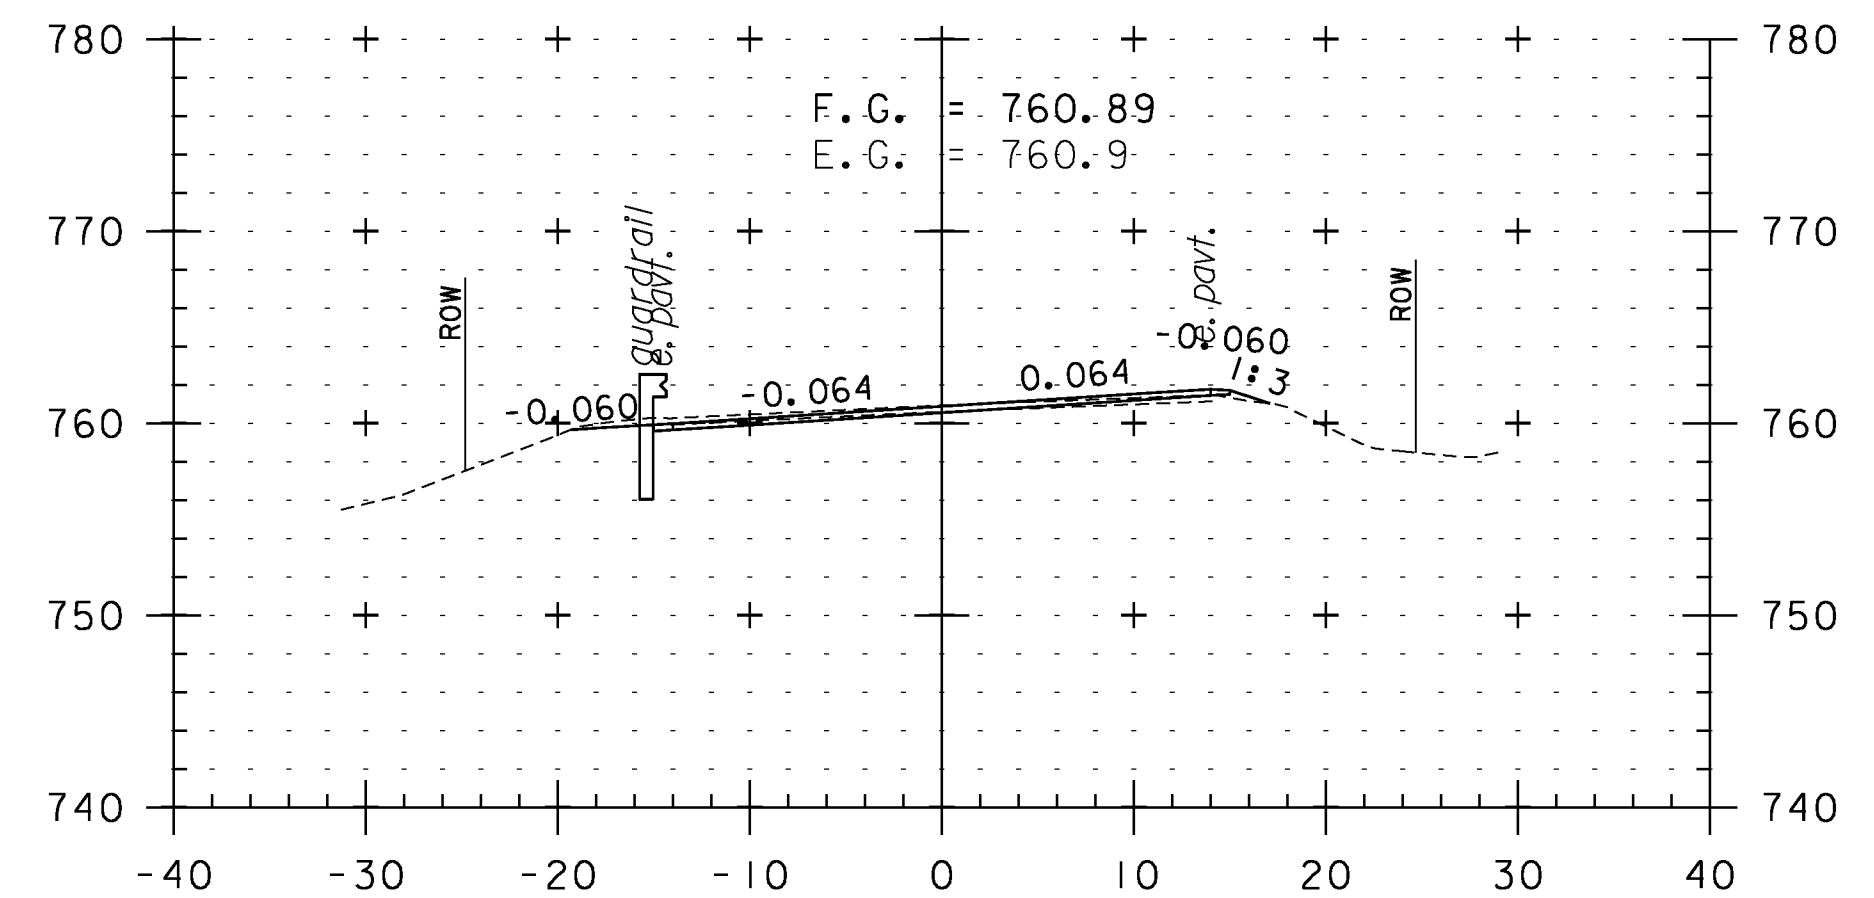


314+00

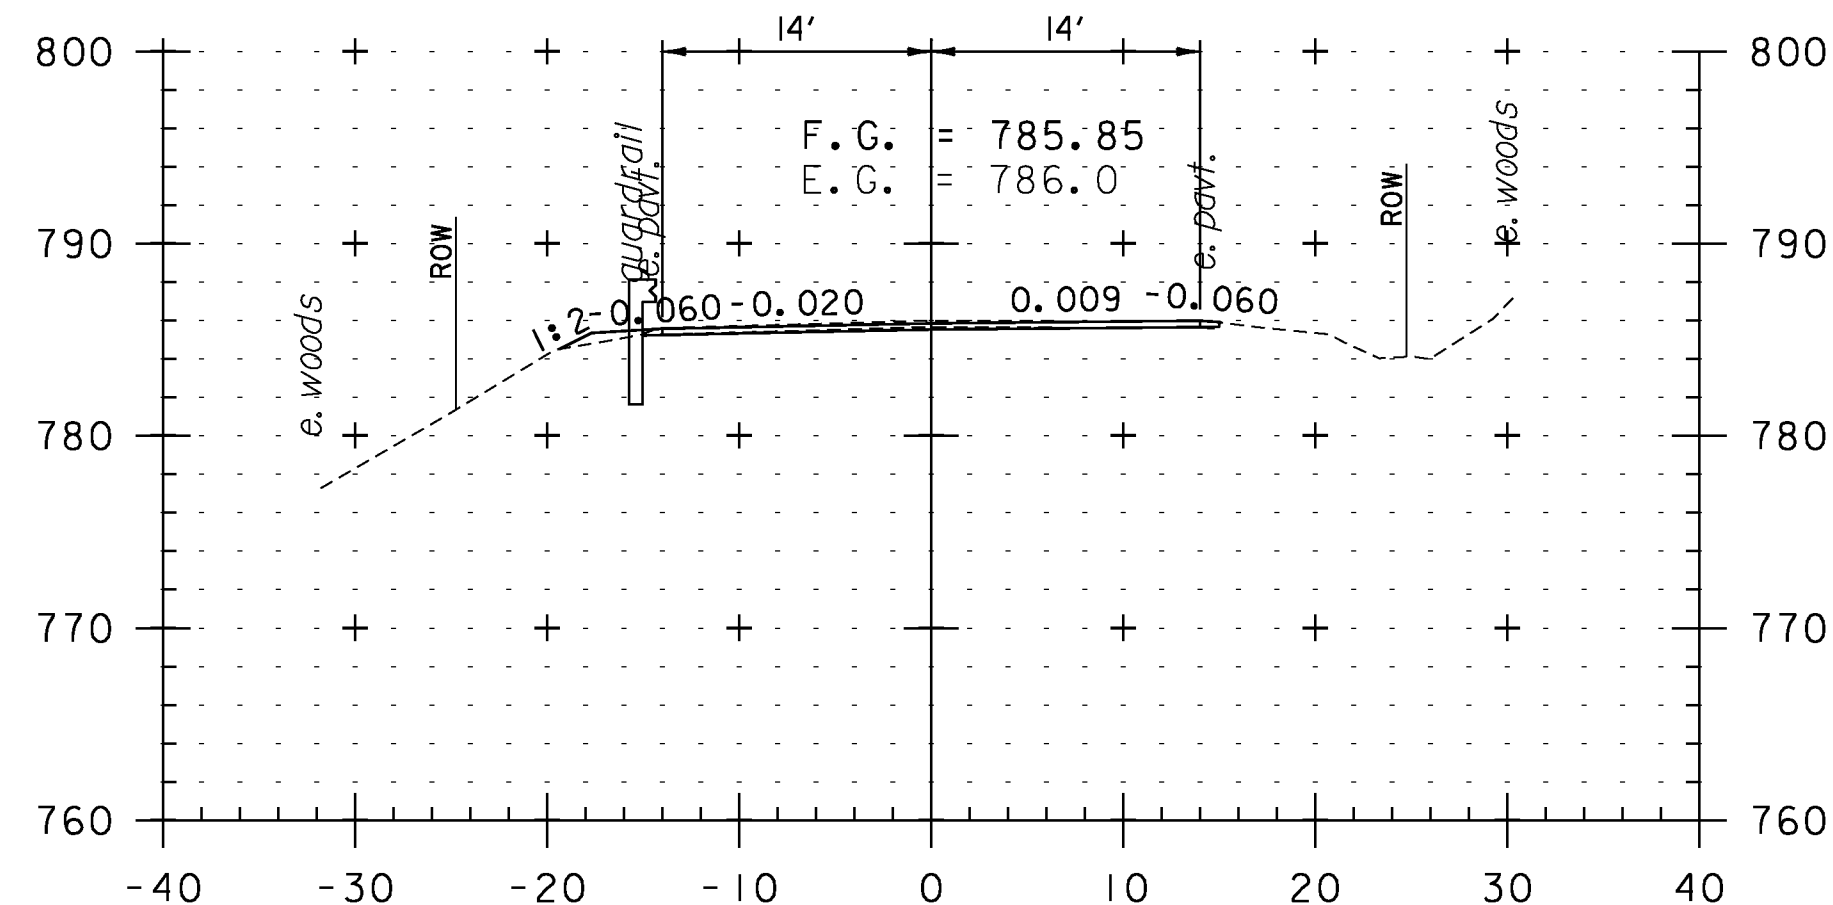

310+50

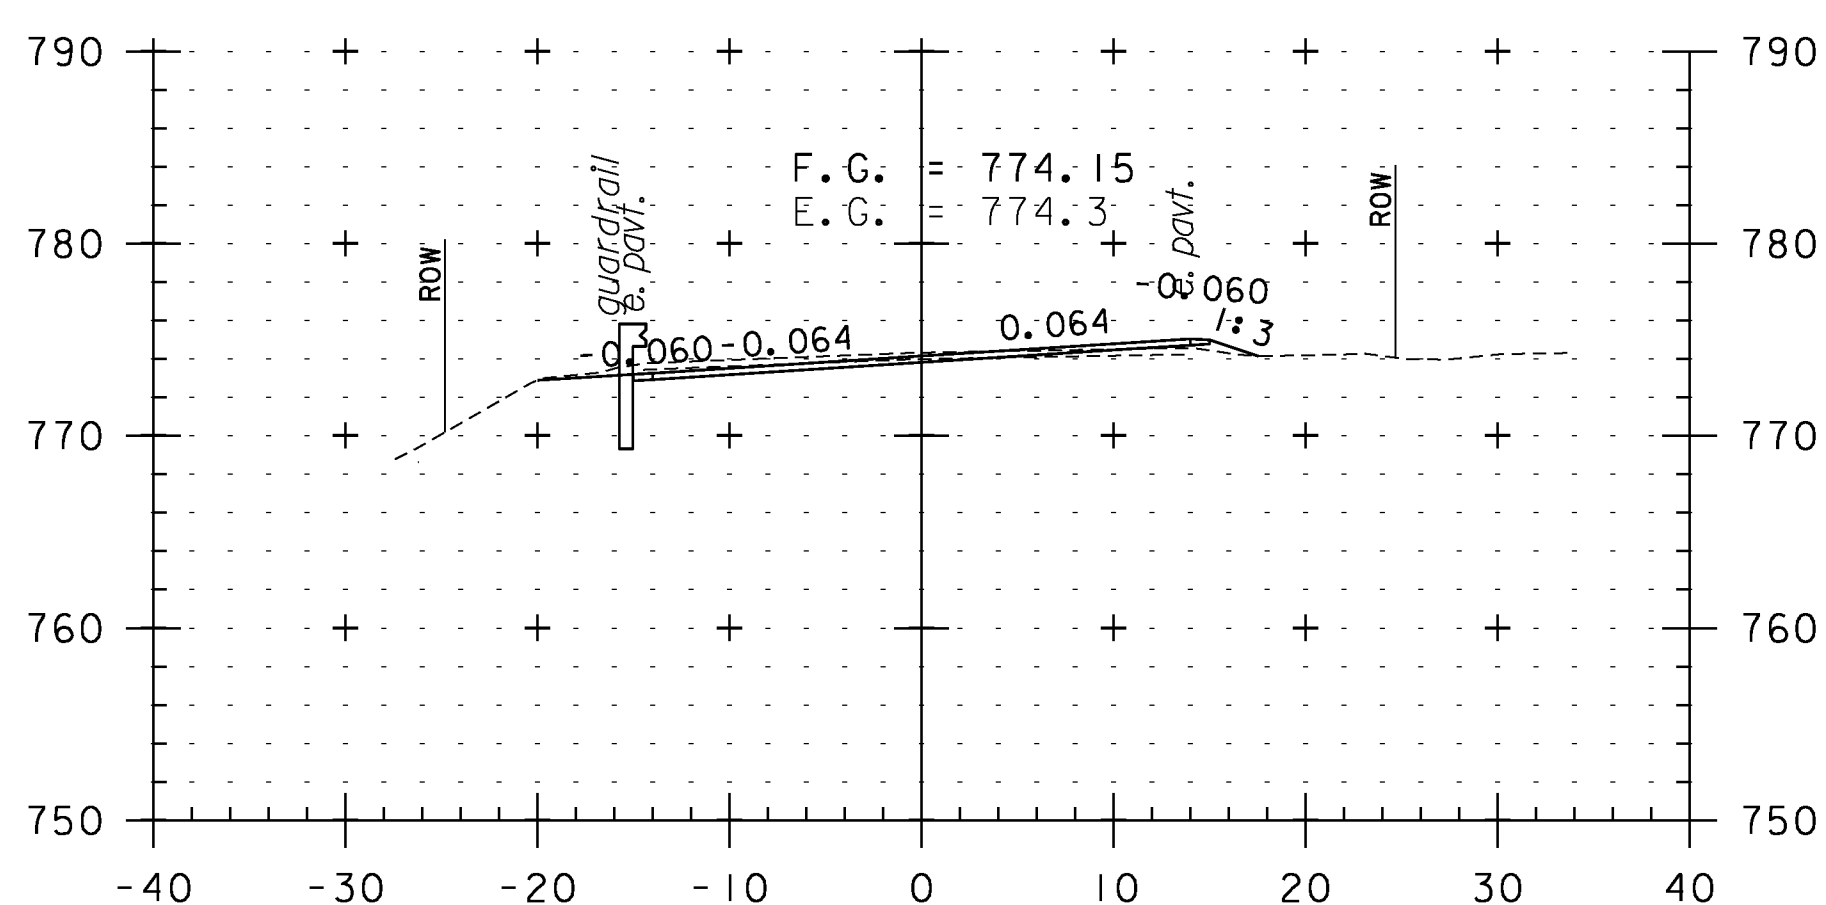

312+00

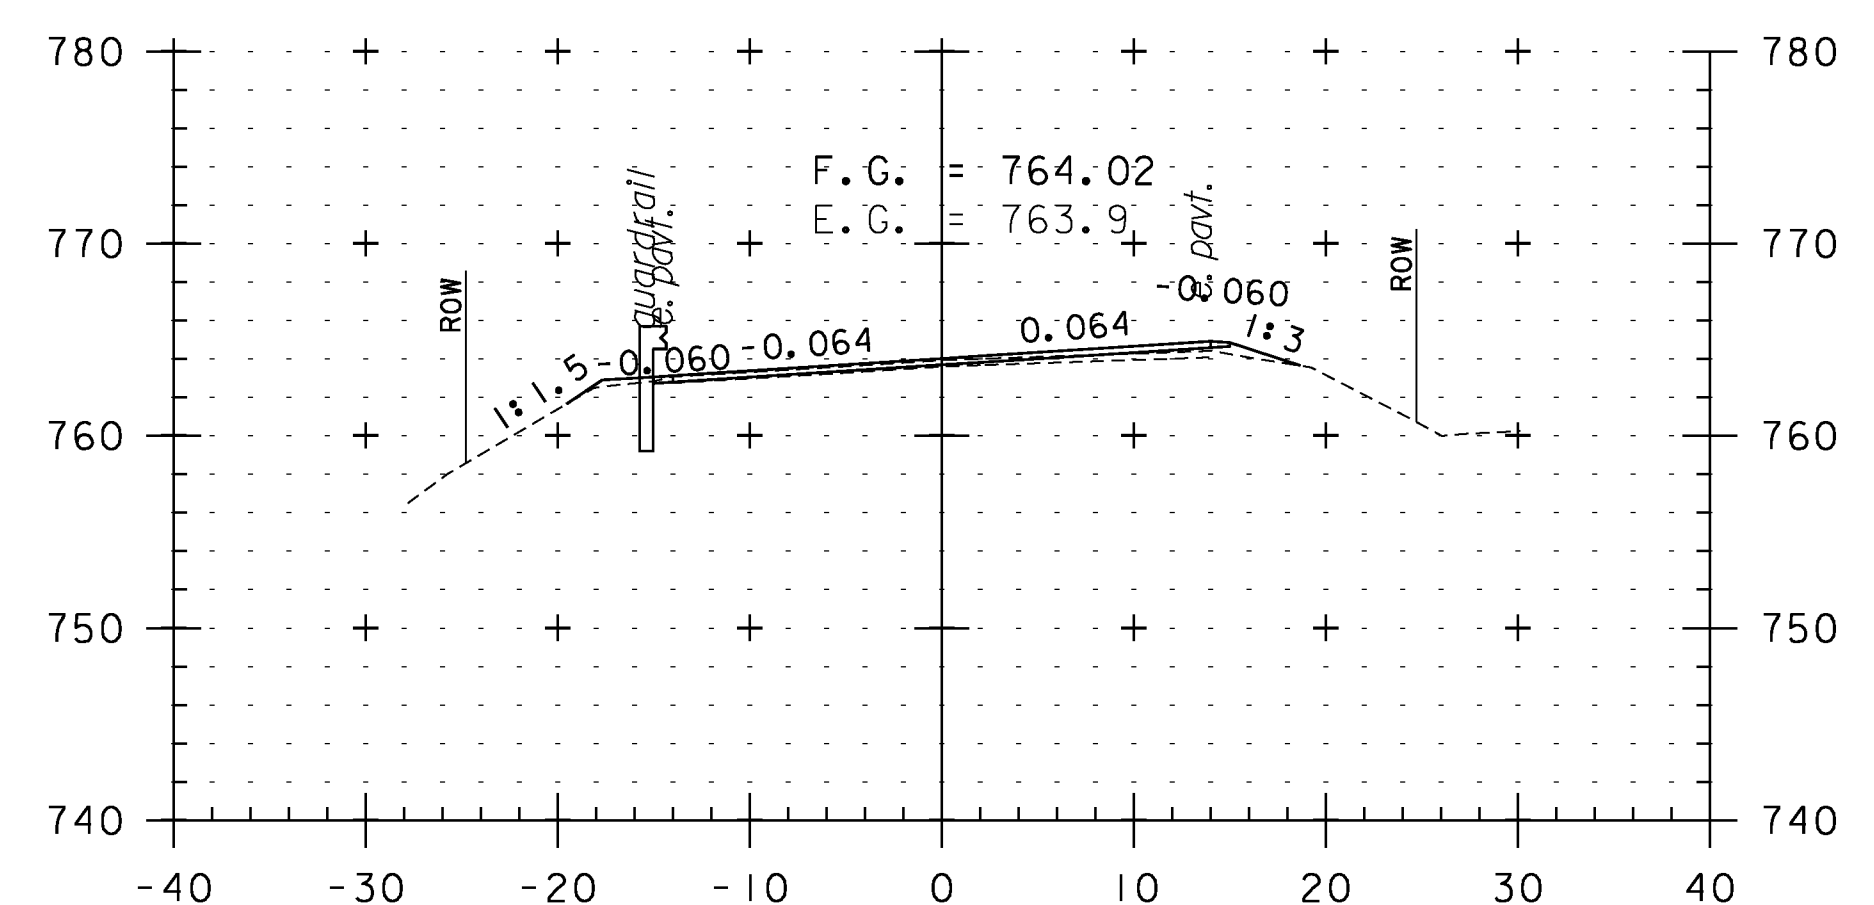

313+50

CROSS SECTION SHEET 58

PROJECT NAME: WEATHERSFIELD

PROJECT NUMBER: STP 2913(I)

FILE NAME: I0c228

PROJECT LEADER: PTS

DESIGNED BY: NLL


IPARM FILE NAME: pI0c228_148

PLOT DATE: 2/7/2013

DRAWN BY: WWG

CHECKED BY: PTS

SHEET 148 OF 234

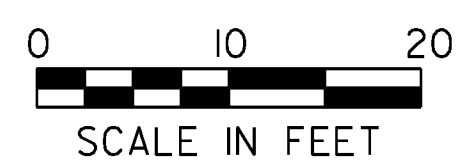

STA. 310+50 TO STA. 314+50