




328+00

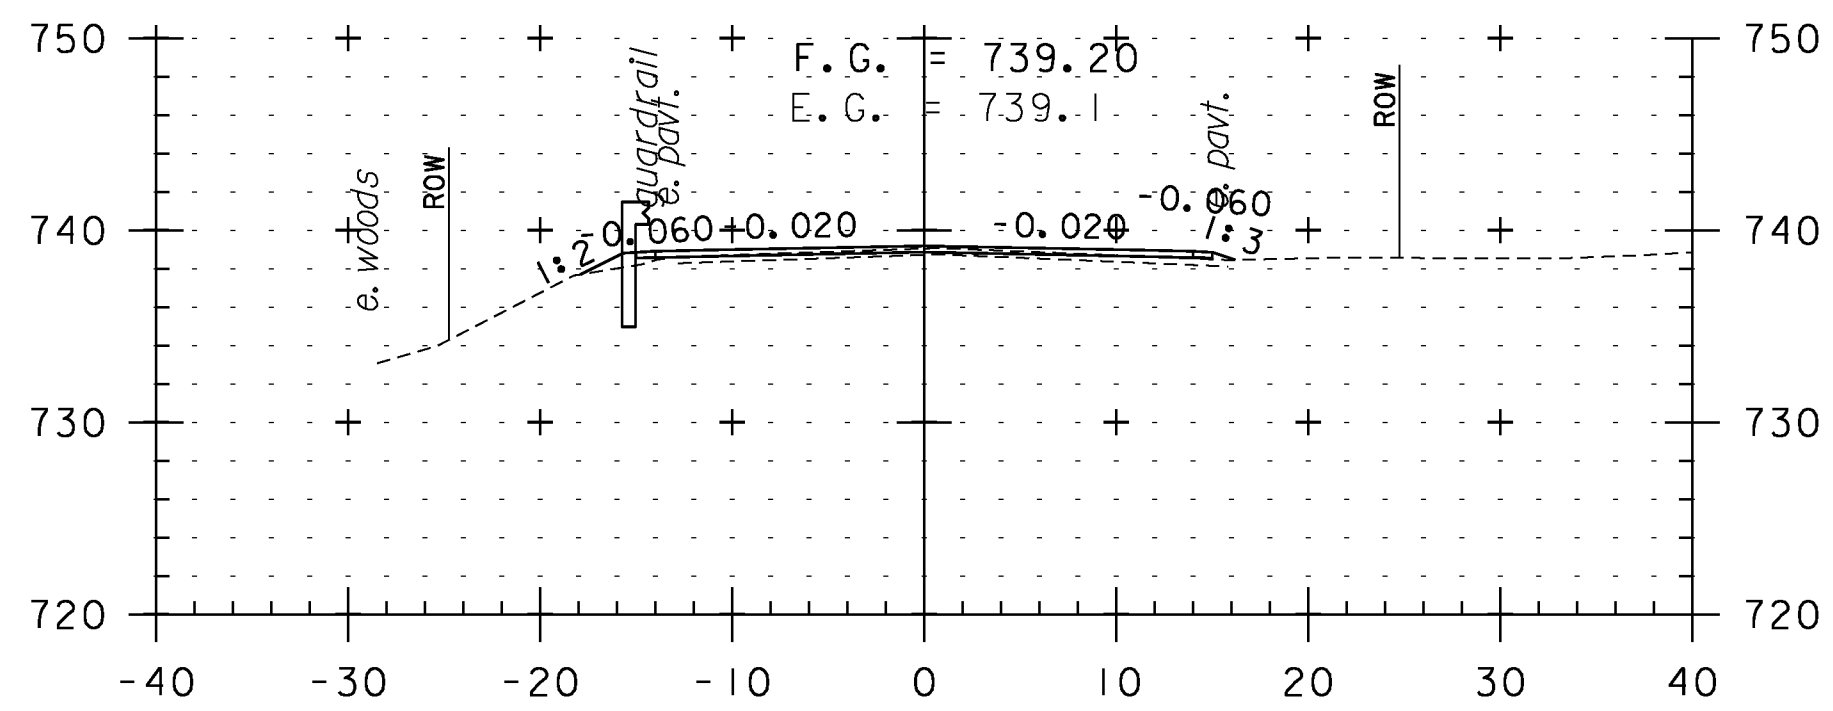


327+50

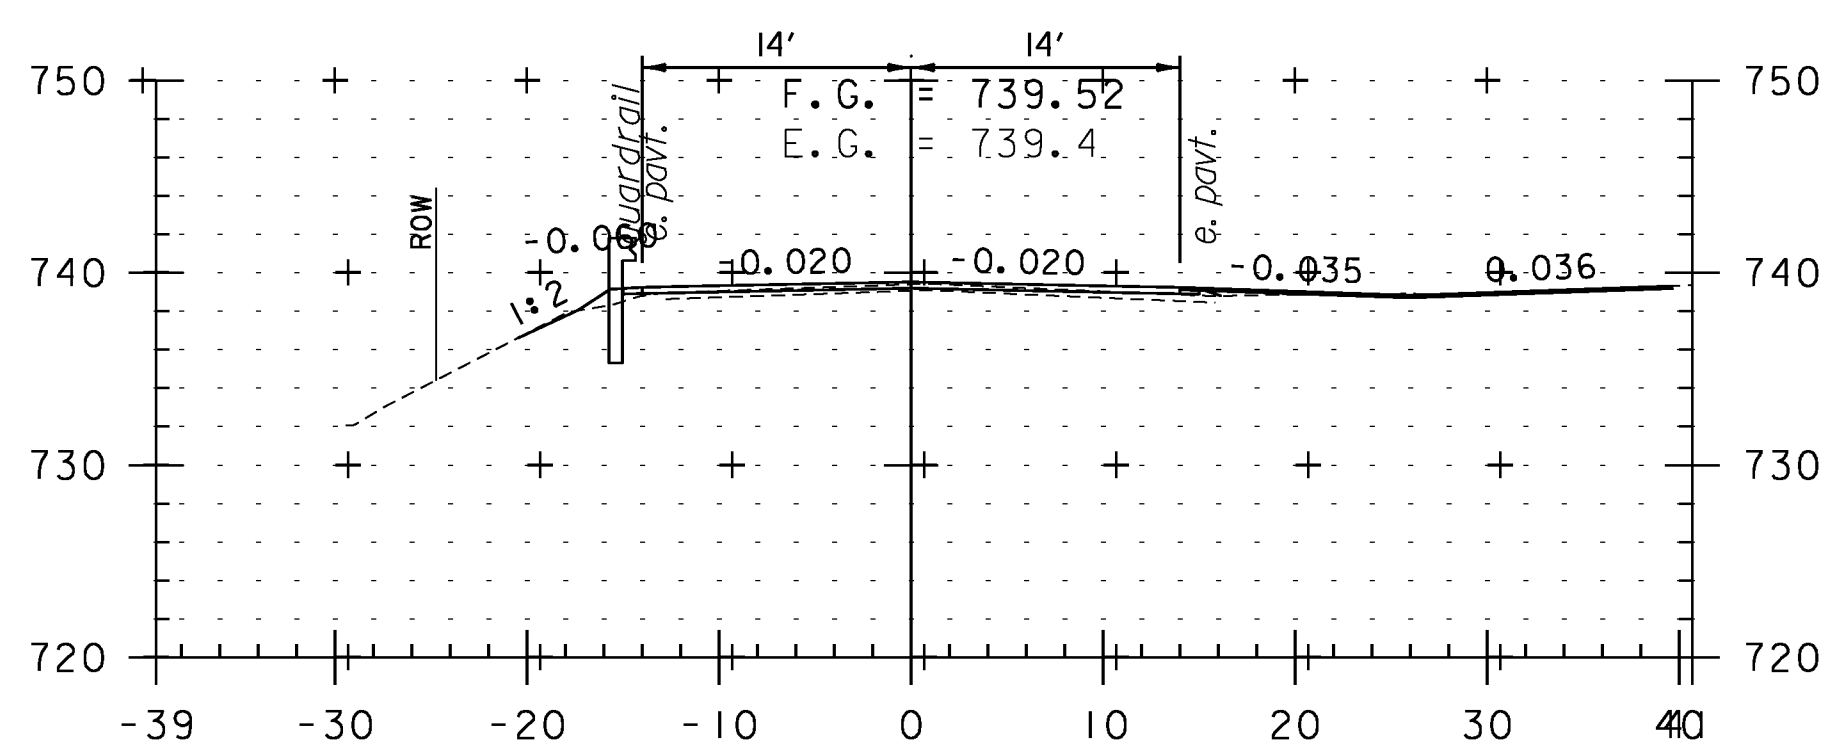


327+40
TH 1

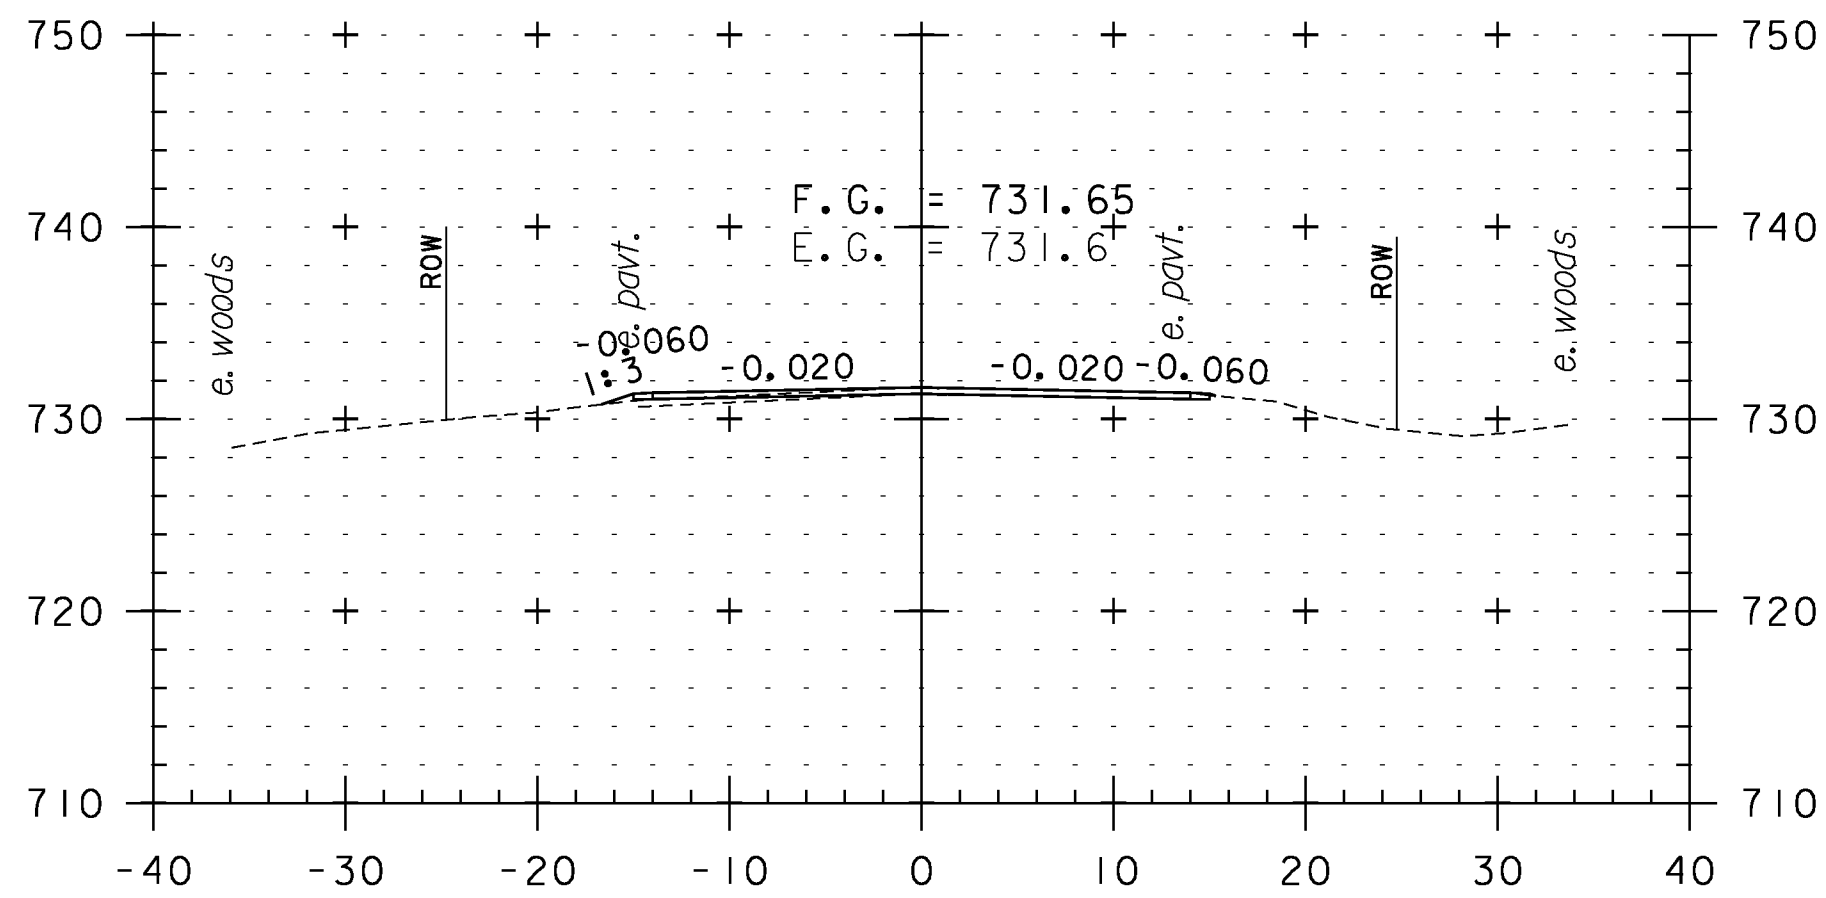


329+00

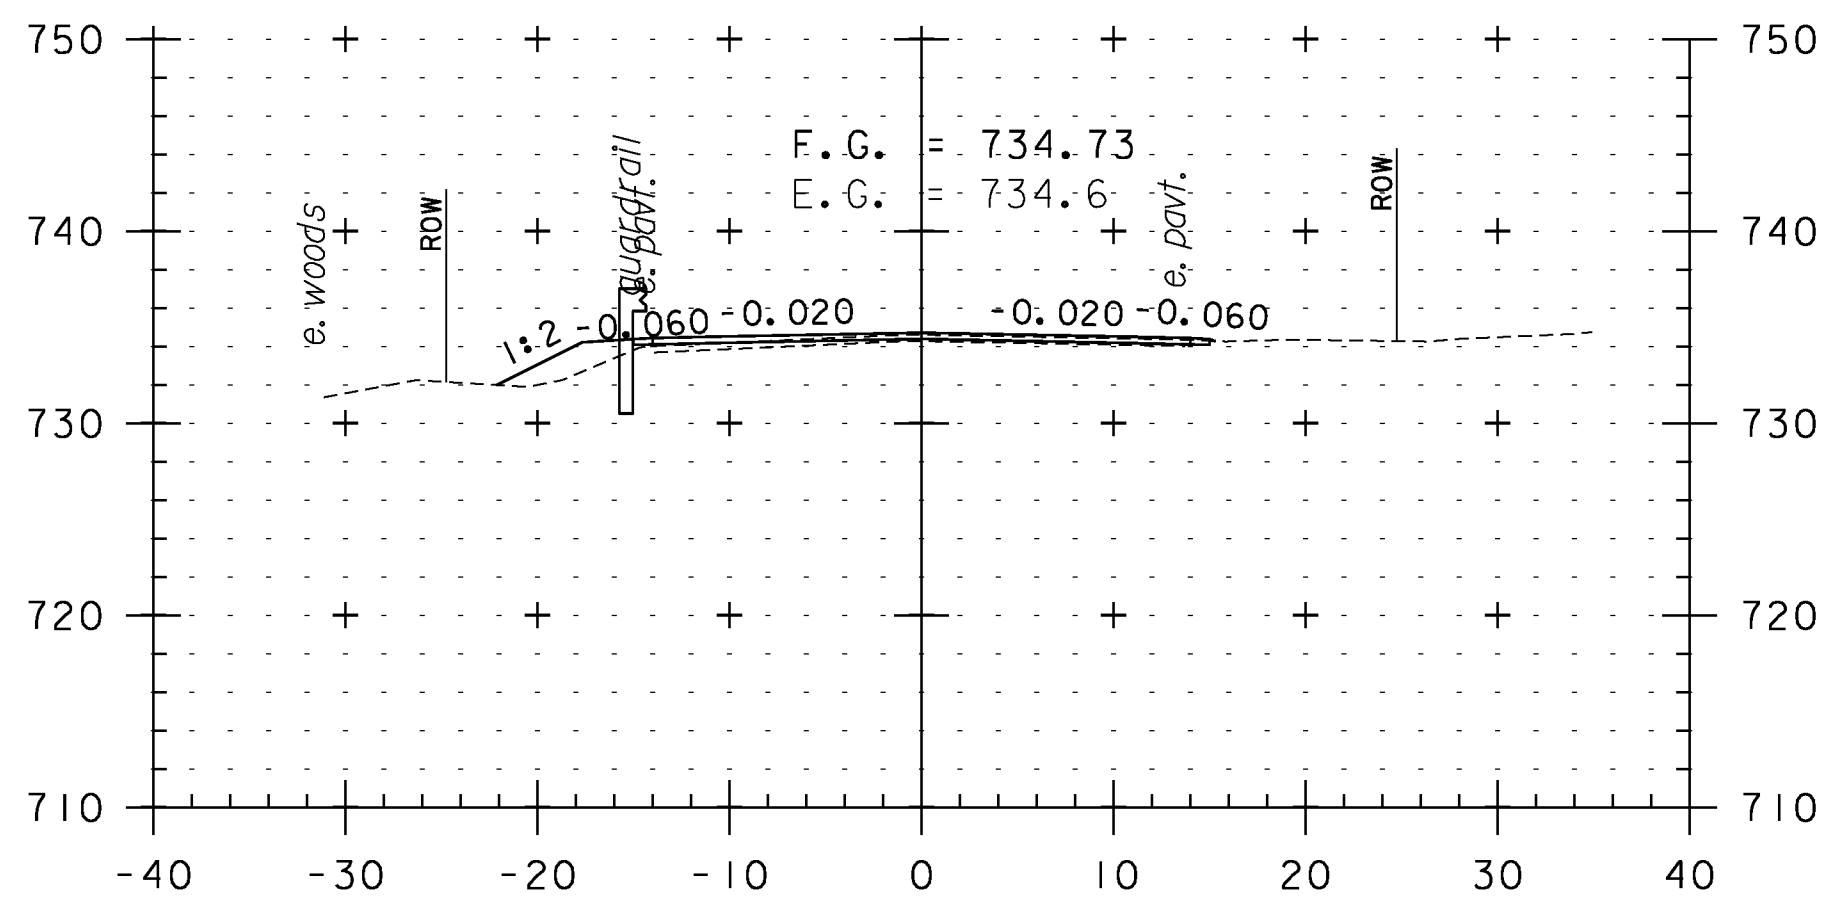


328+50

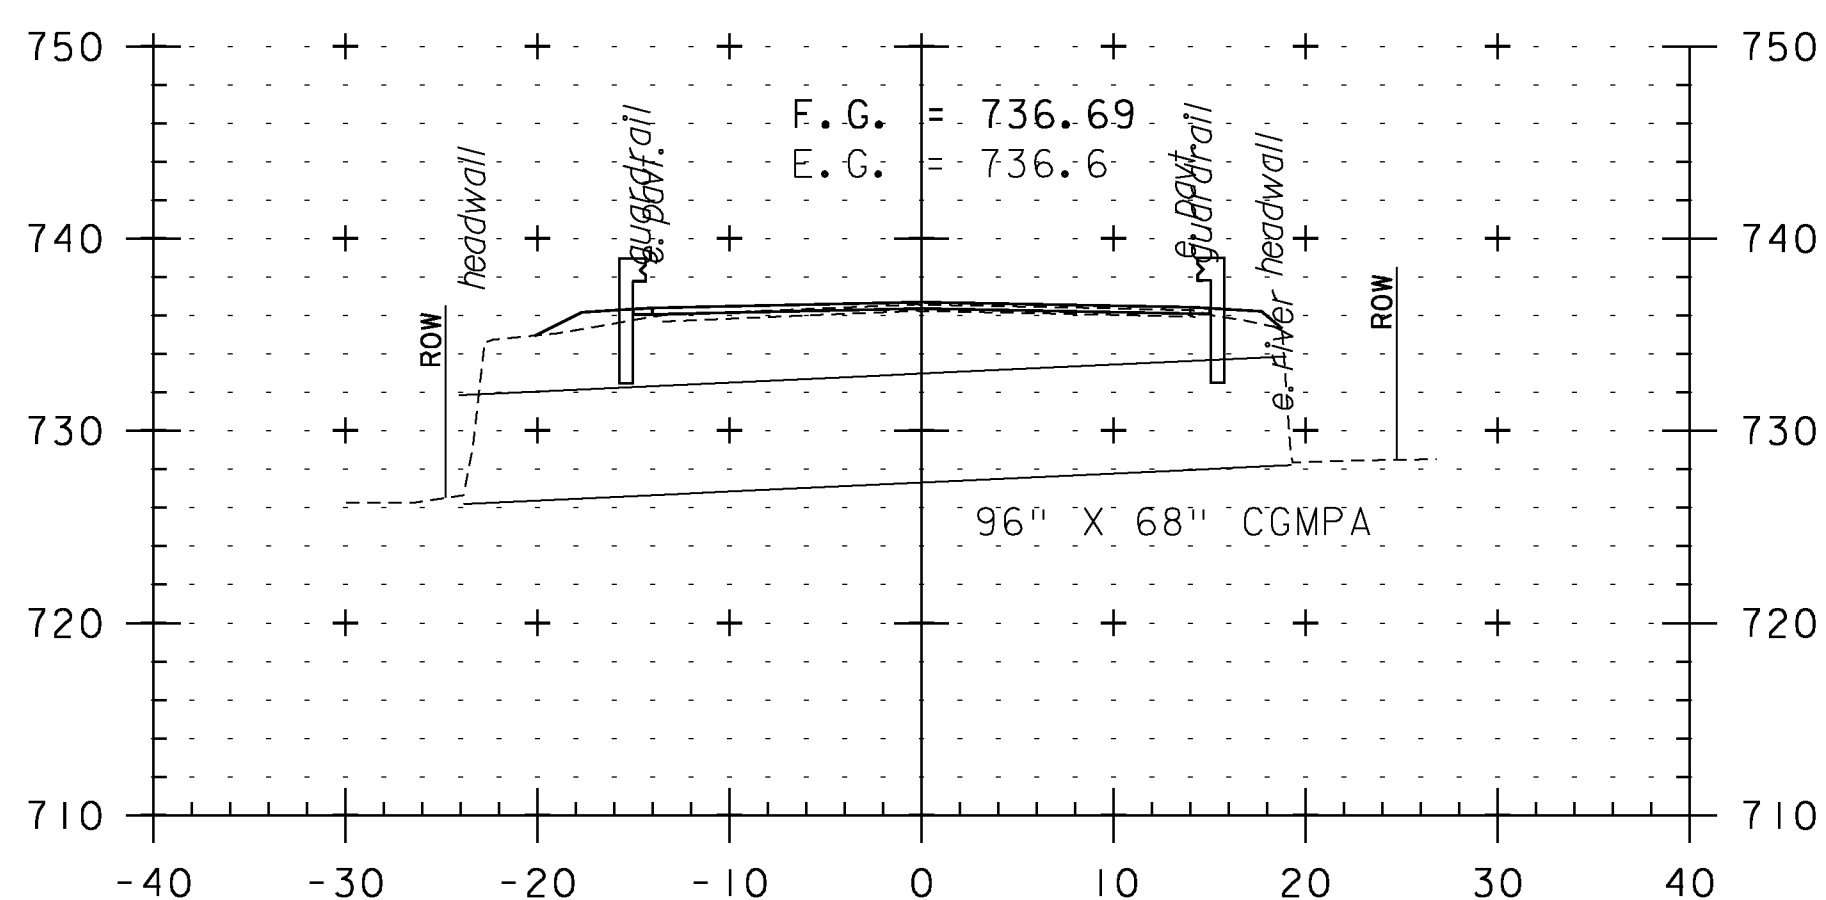


328+12
BRIDGE 16

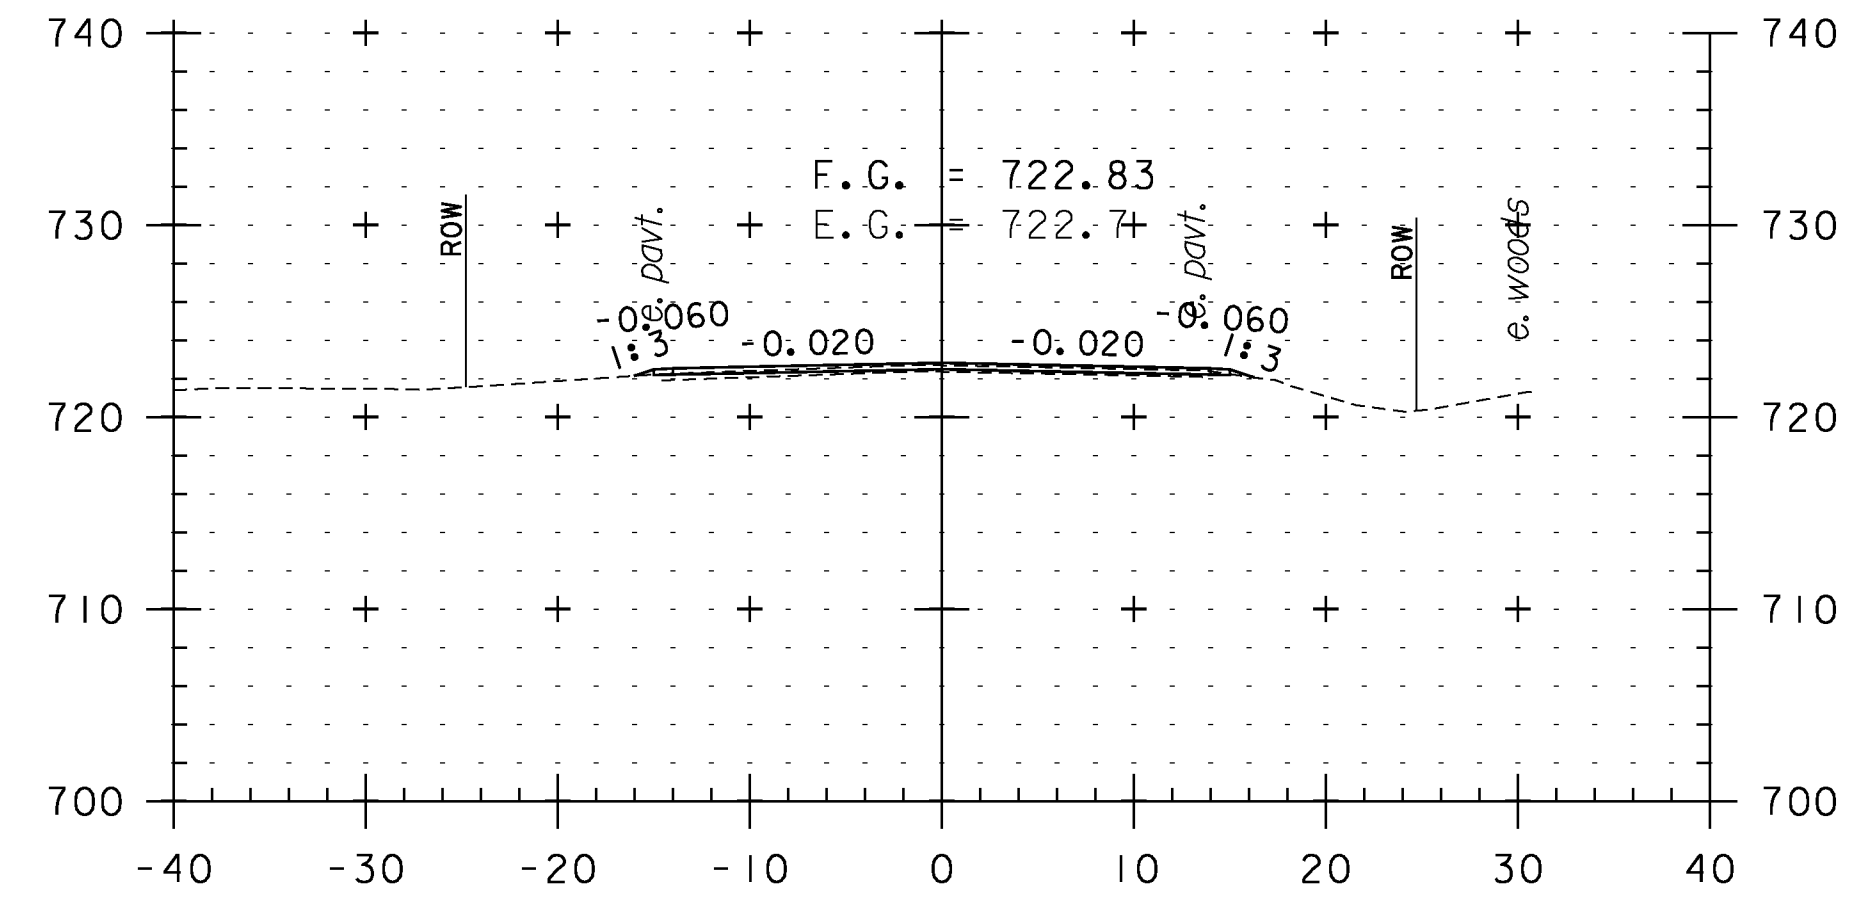

330+50

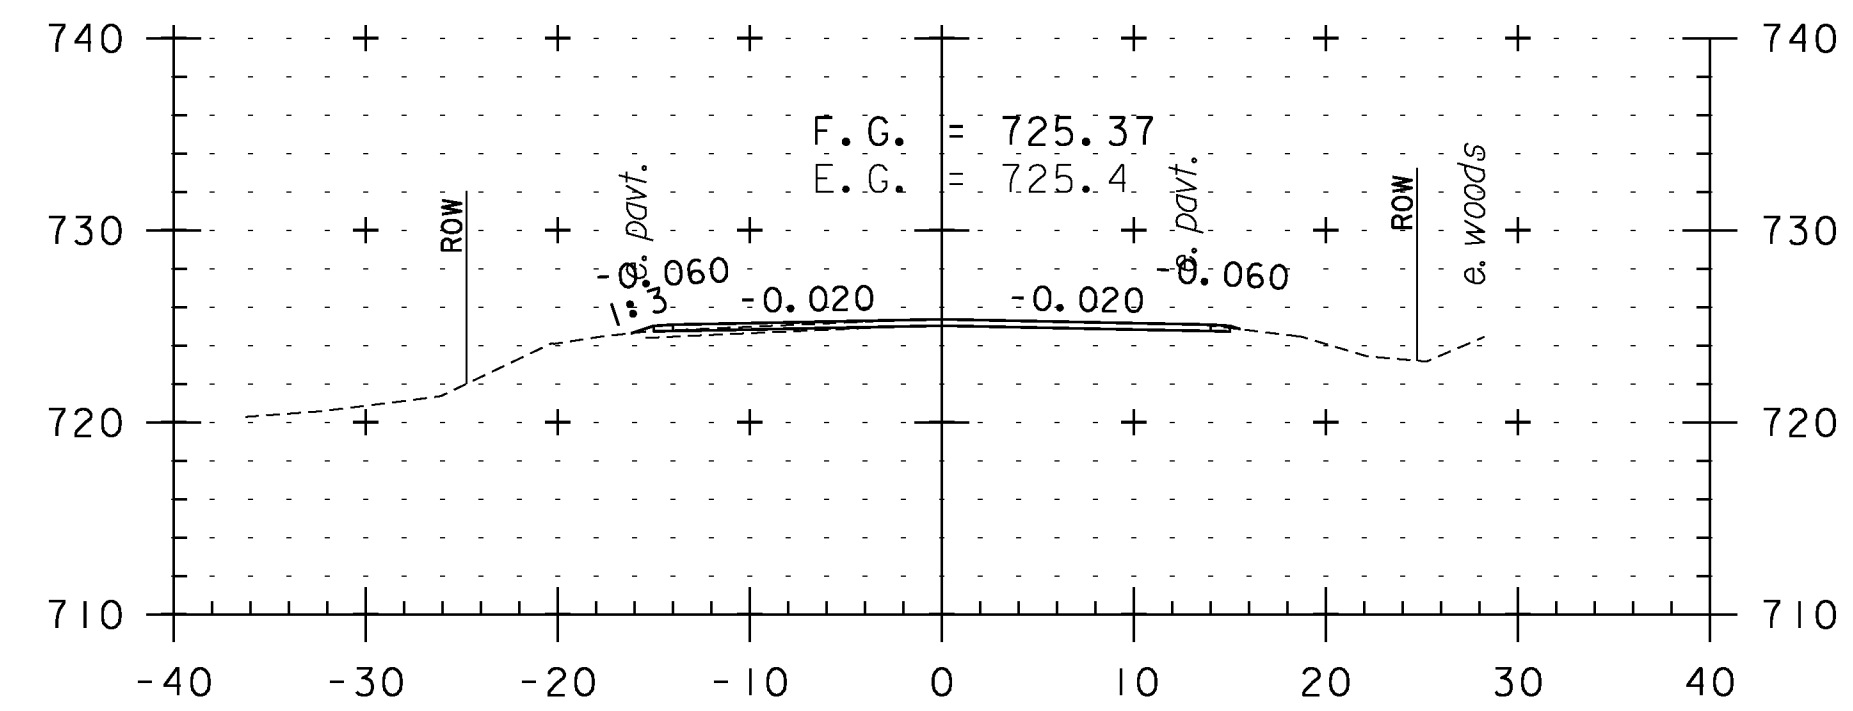

330+00

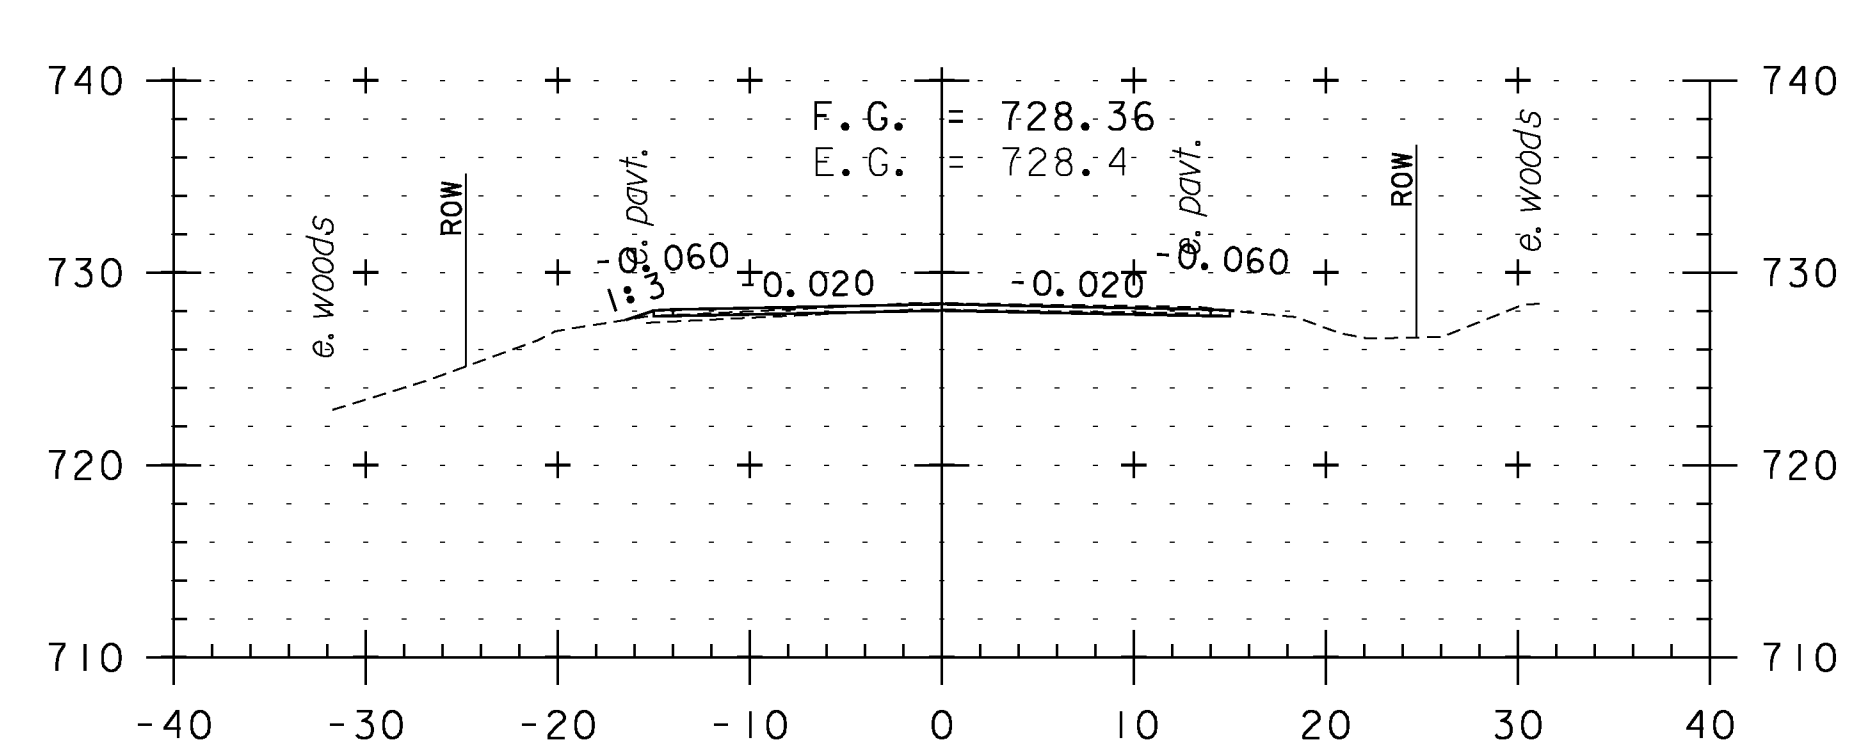

329+50

CROSS SECTION SHEET 62

PROJECT NAME: WEATHERSFIELD

PROJECT NUMBER: STP 2913(I)

FILE NAME: I0c228

PROJECT LEADER: PTS

DESIGNED BY: NLL


IPARM FILE NAME: pI0c228_I52

PLOT DATE: 2/7/2013

DRAWN BY: WWG

CHECKED BY: PTS

SHEET 152 OF 234

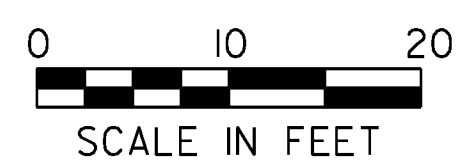

STA. 327+40 TO STA. 330+50