




336+00

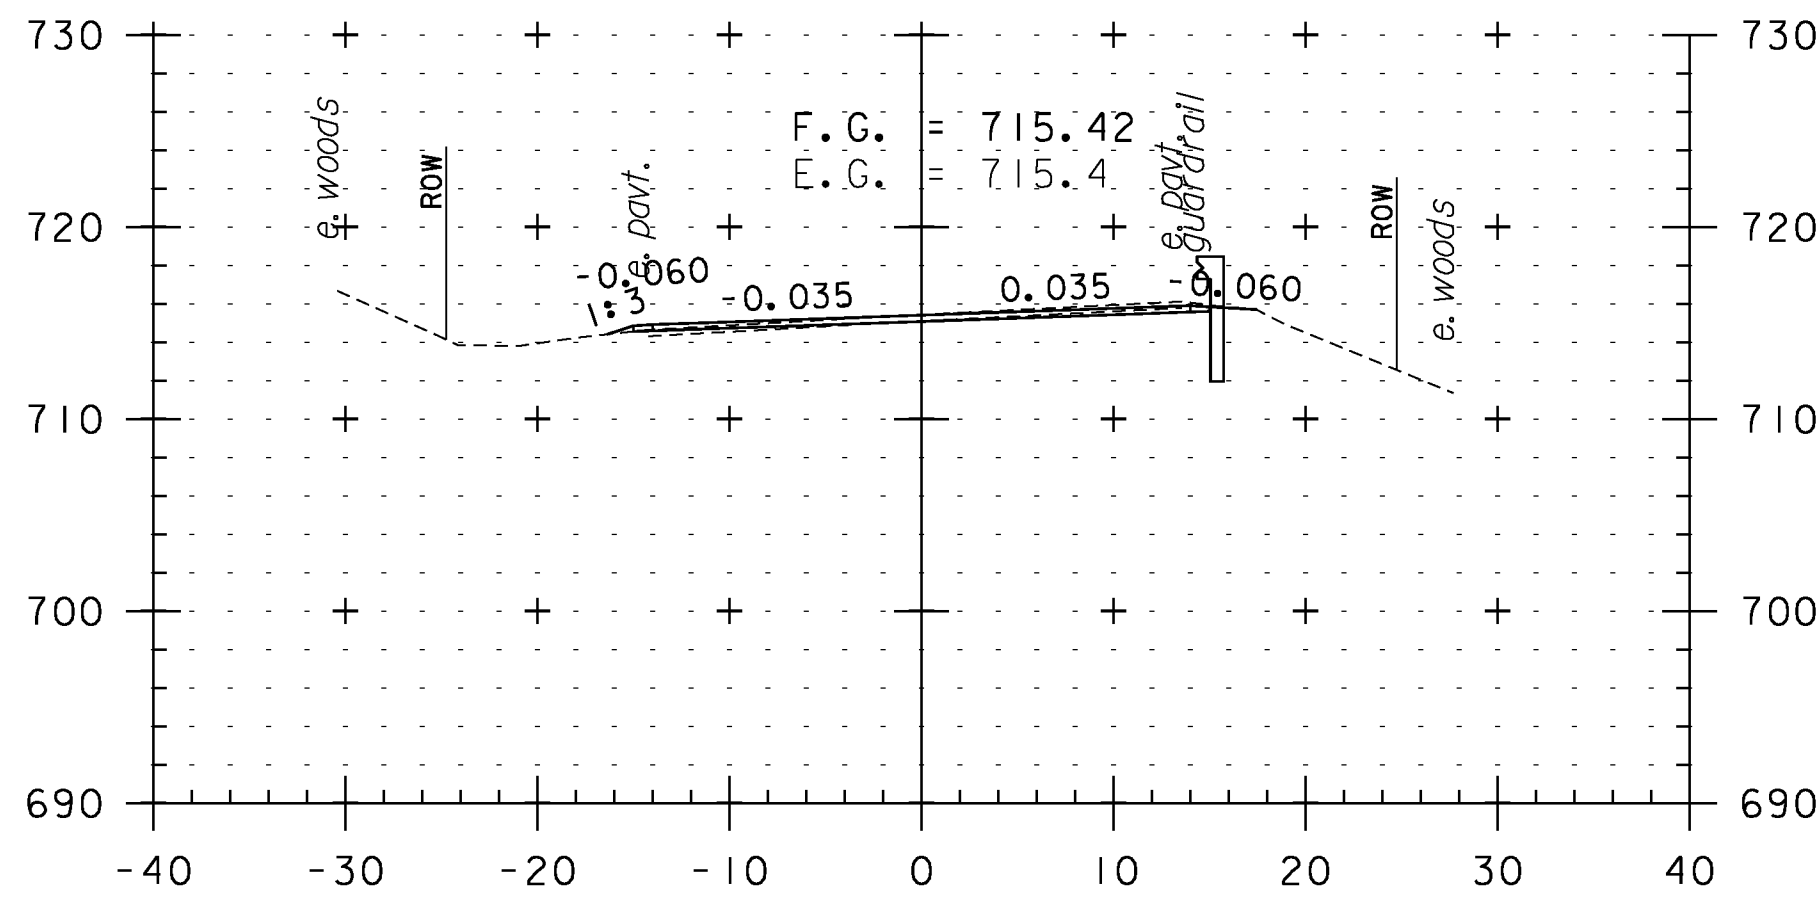


337+50

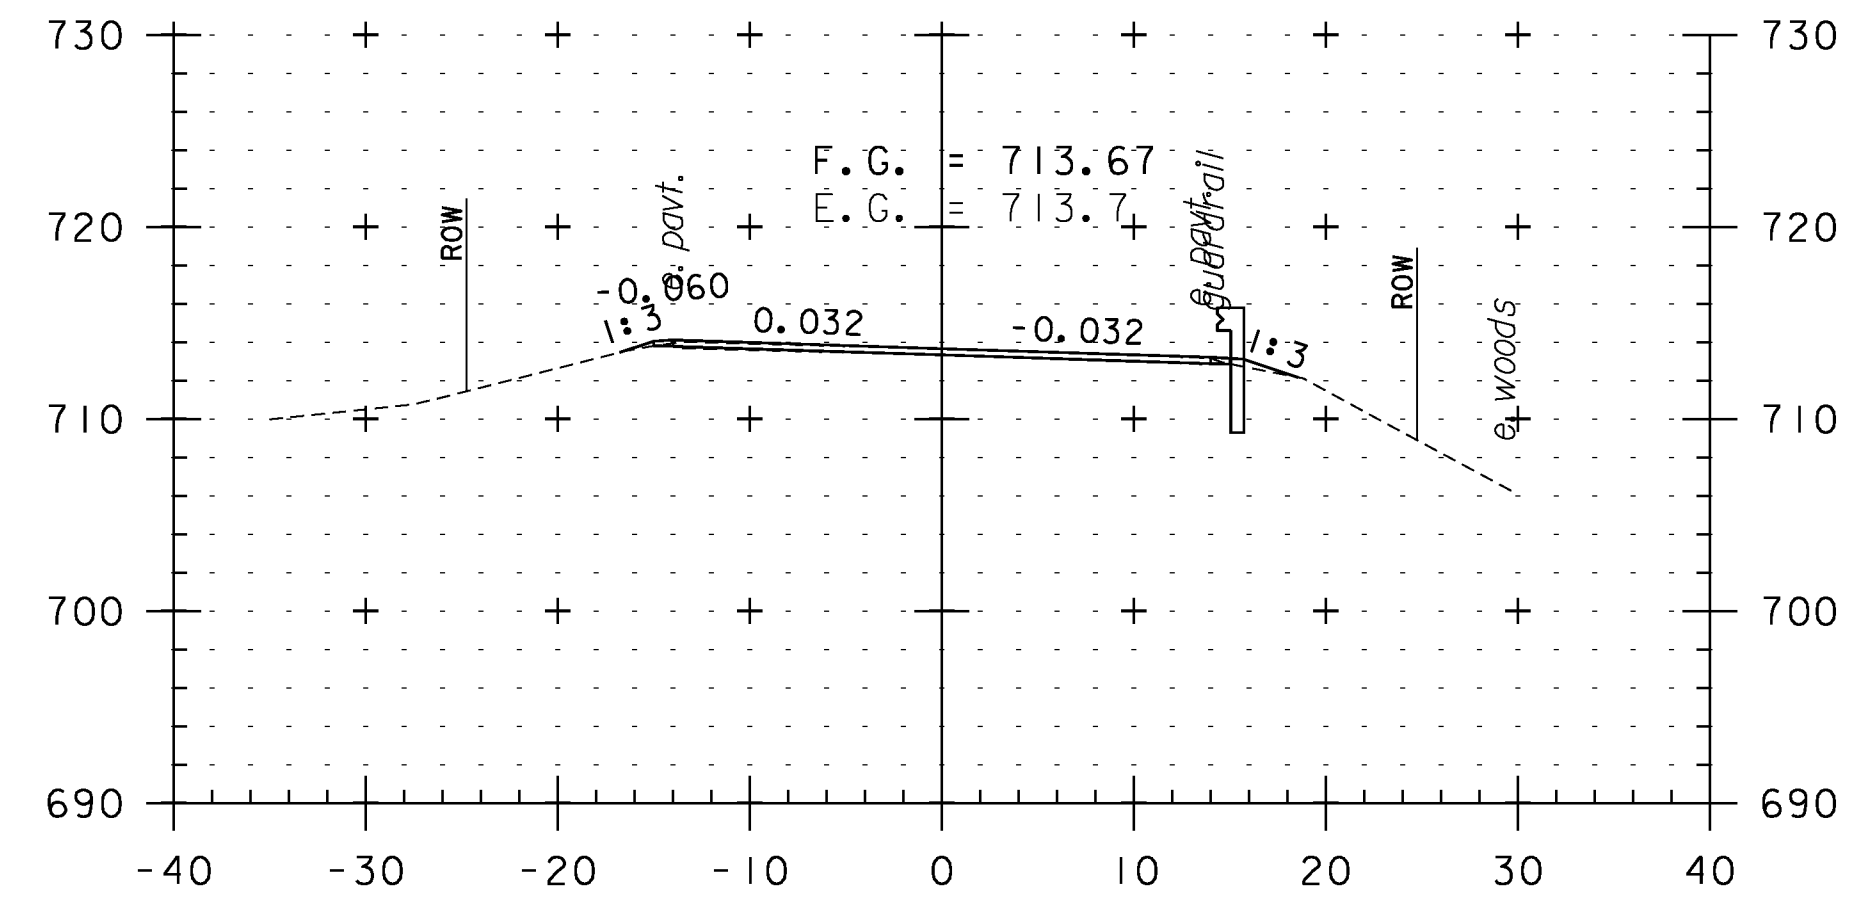


339+00

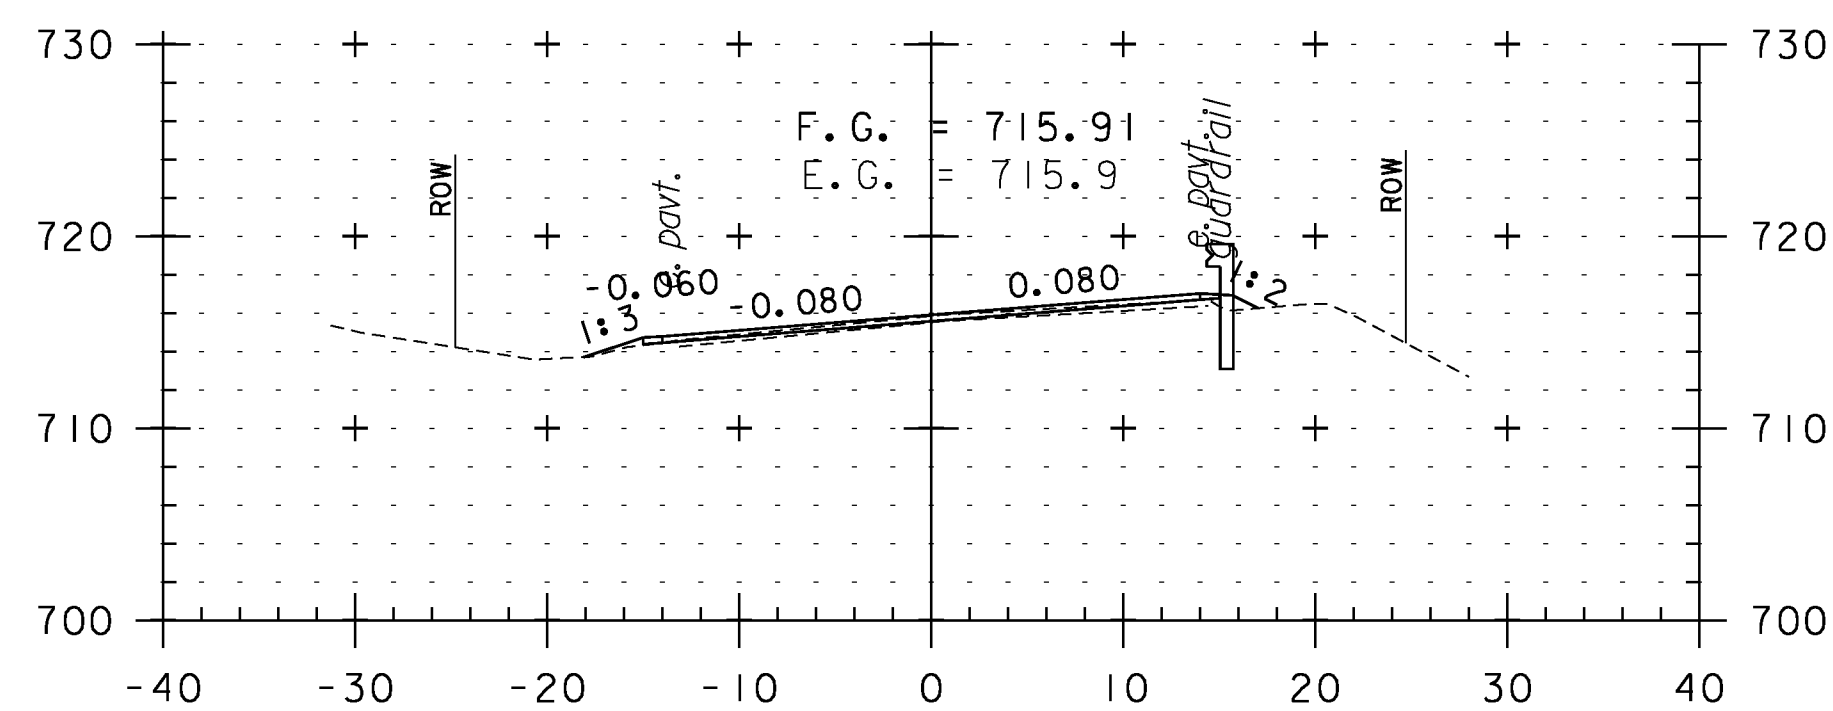


335+50

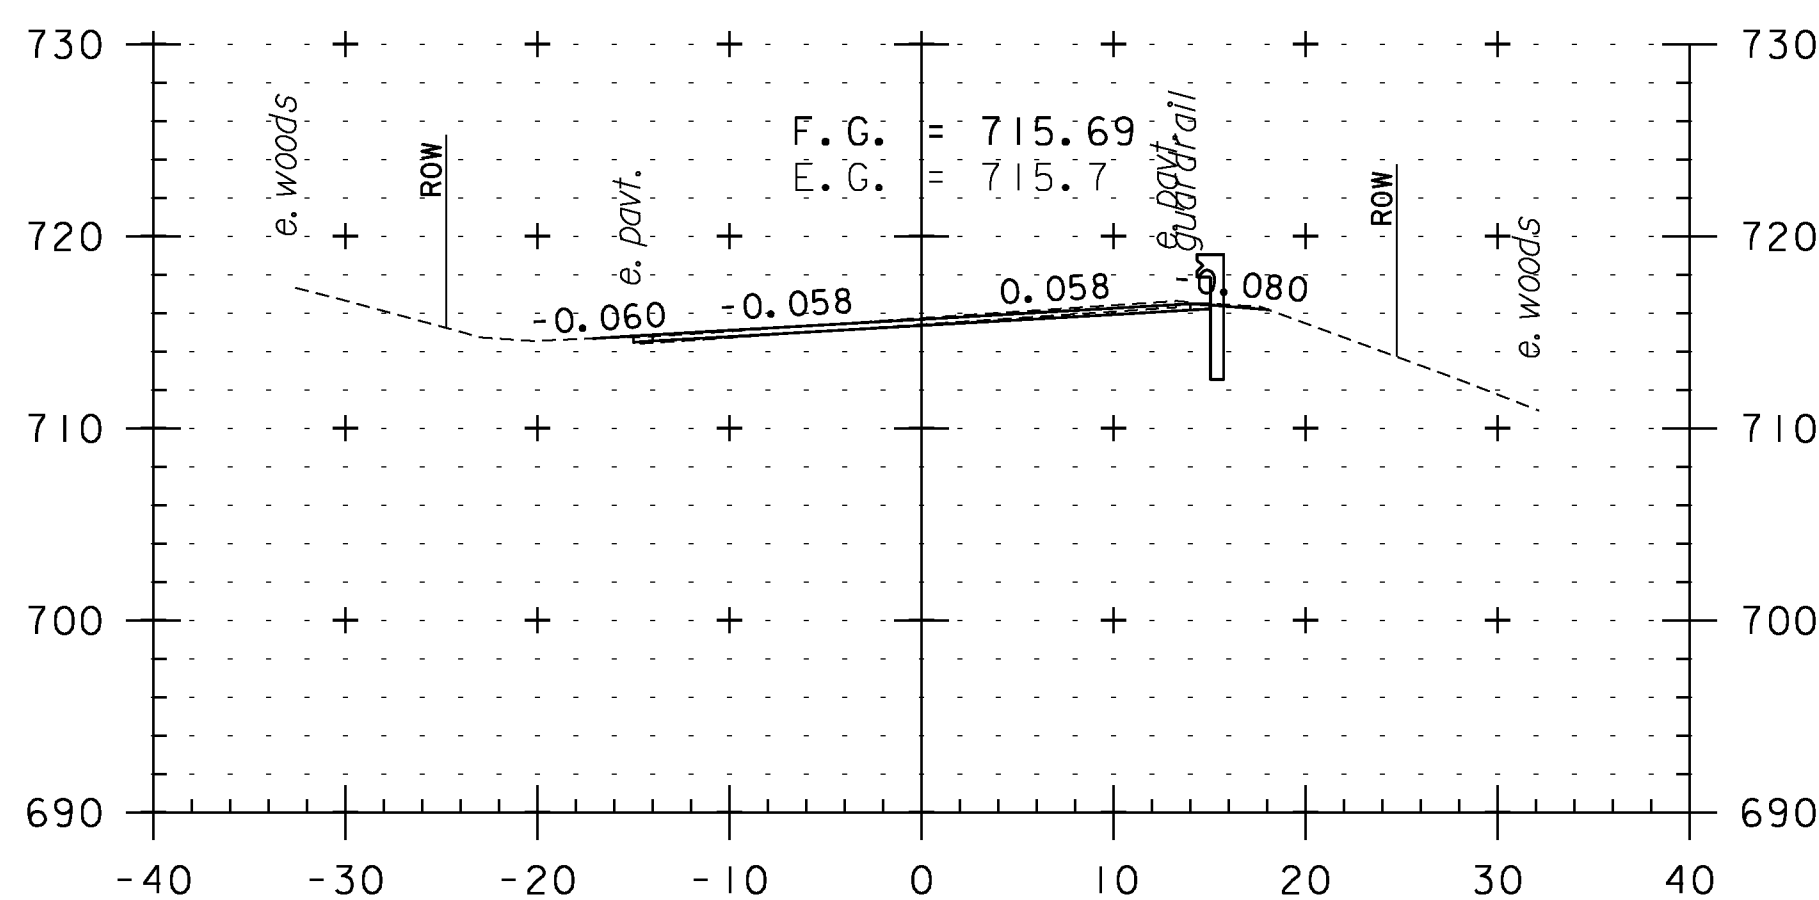


337+00

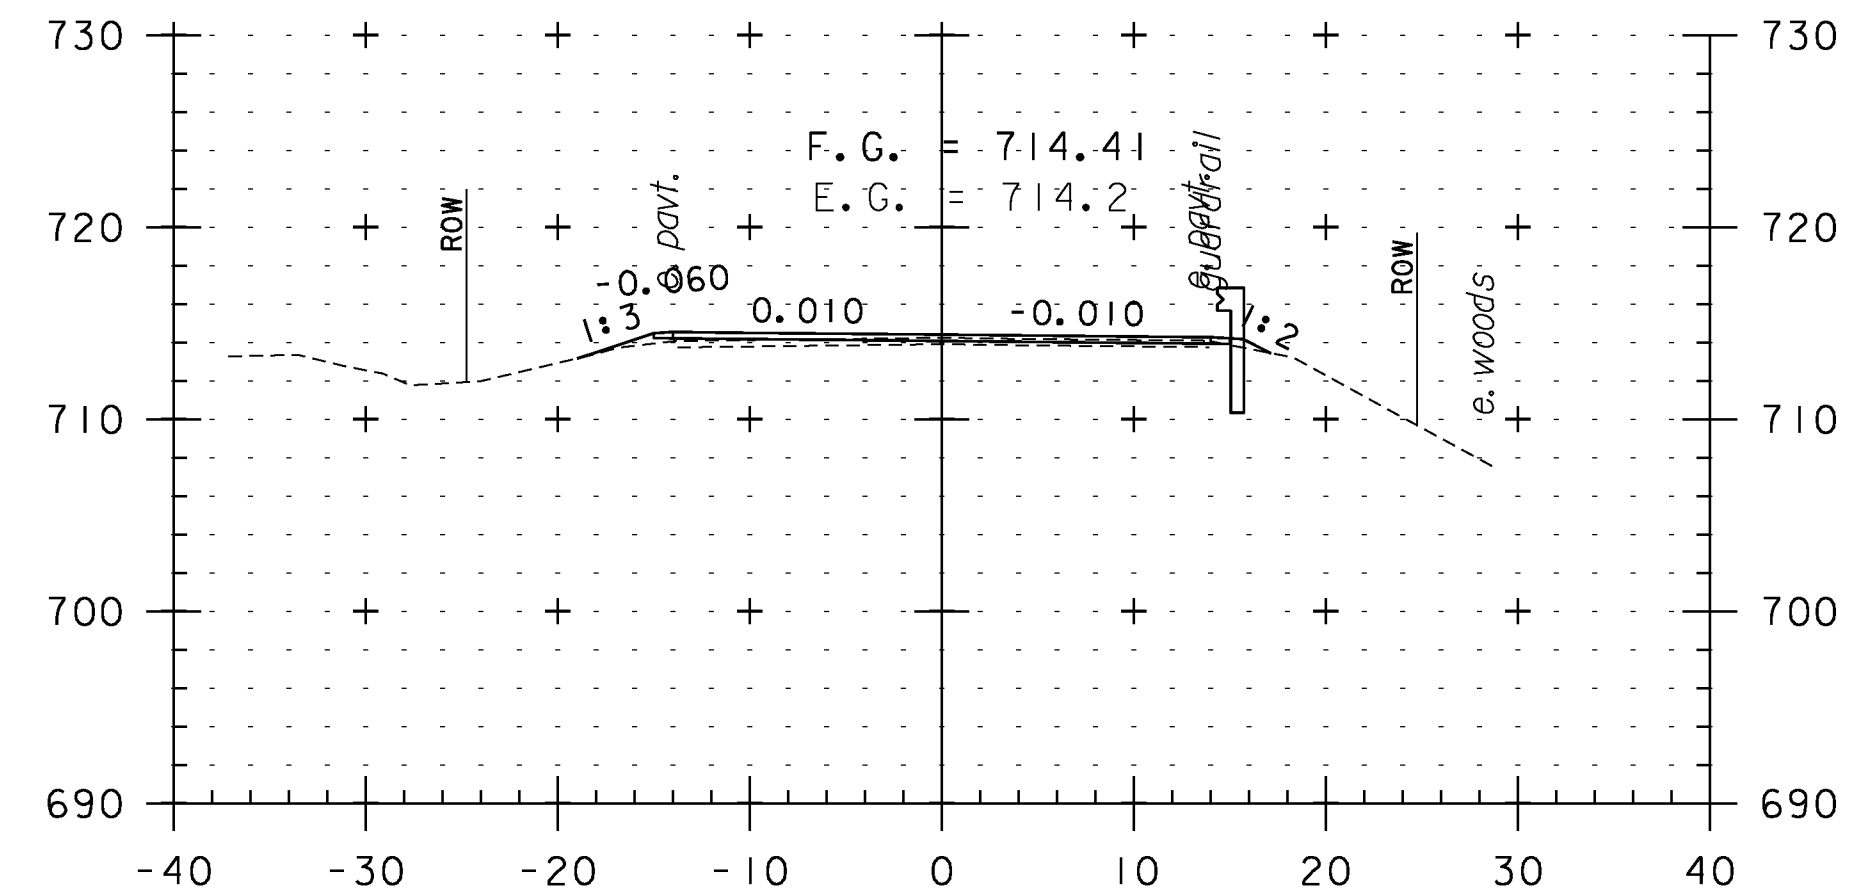


338+50

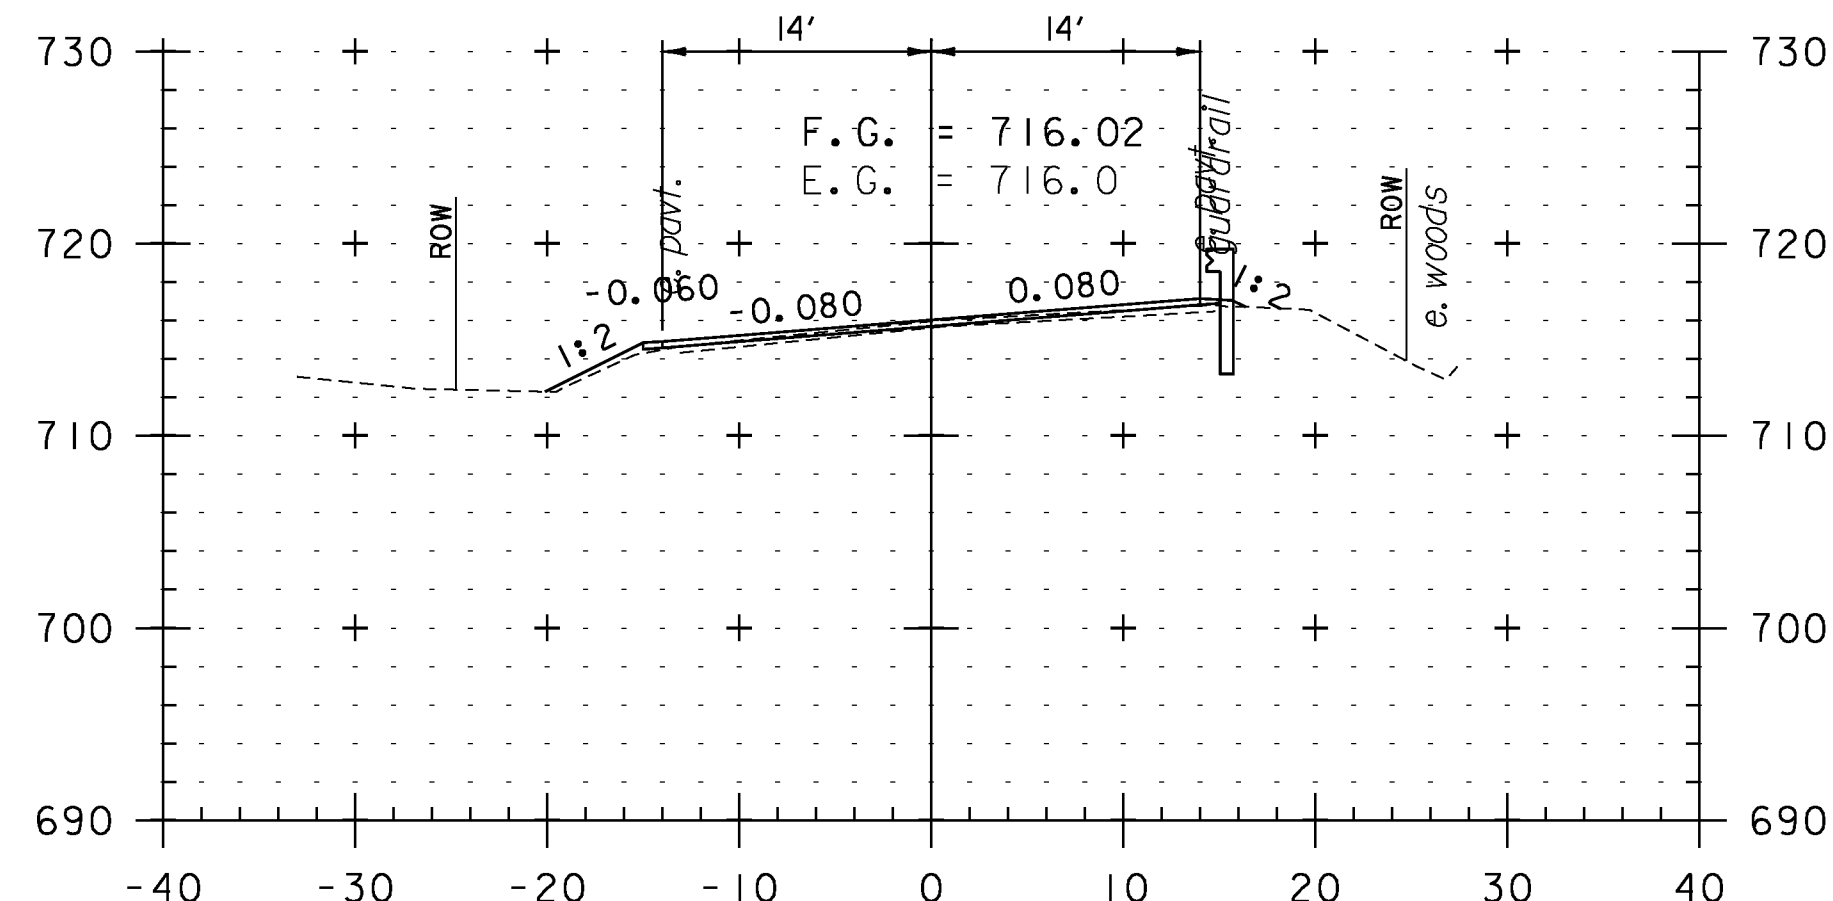

335+00

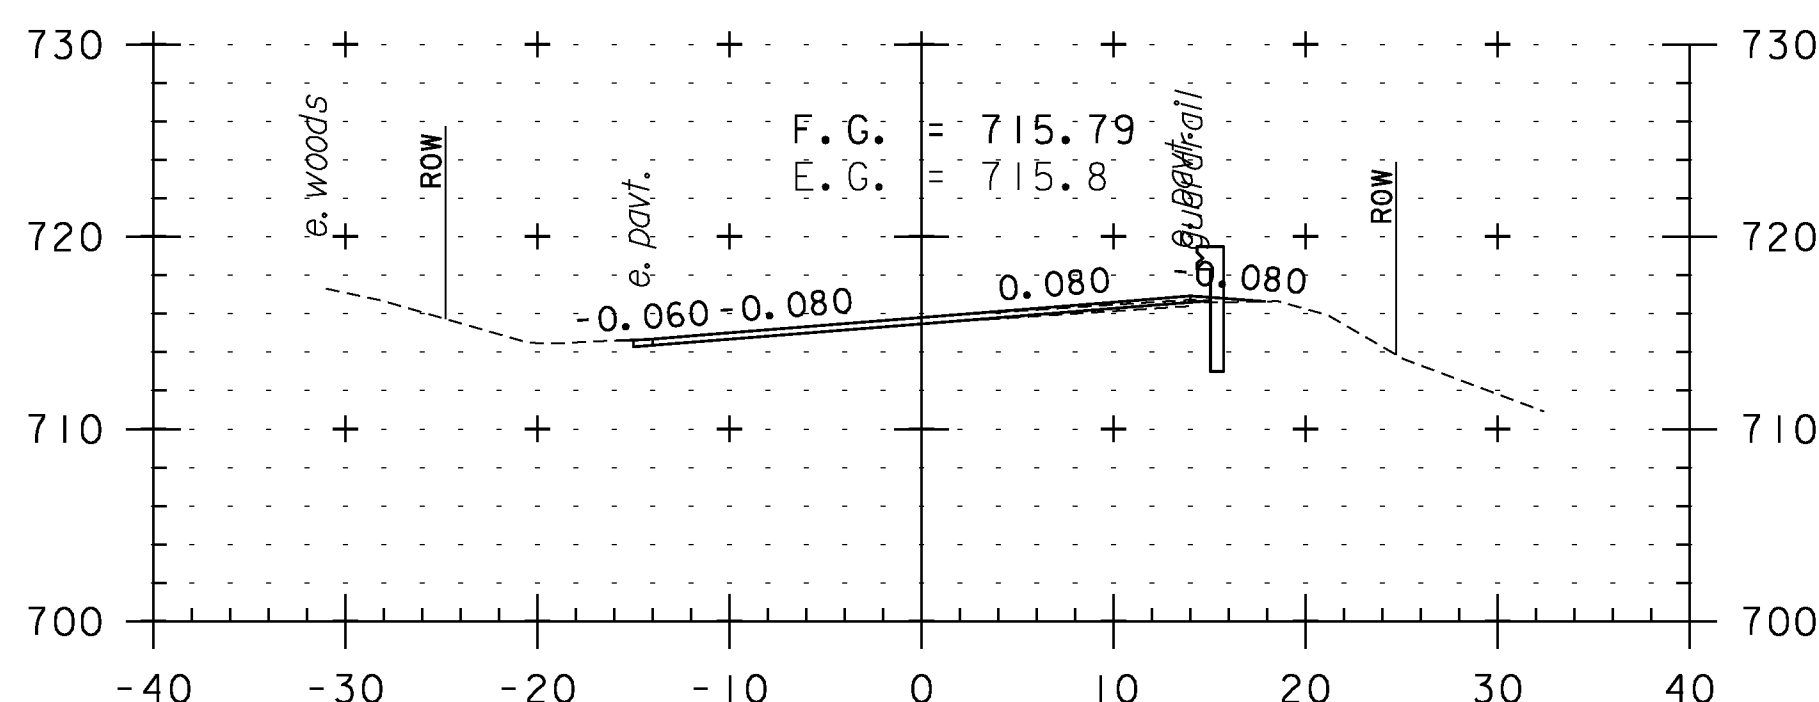

336+50

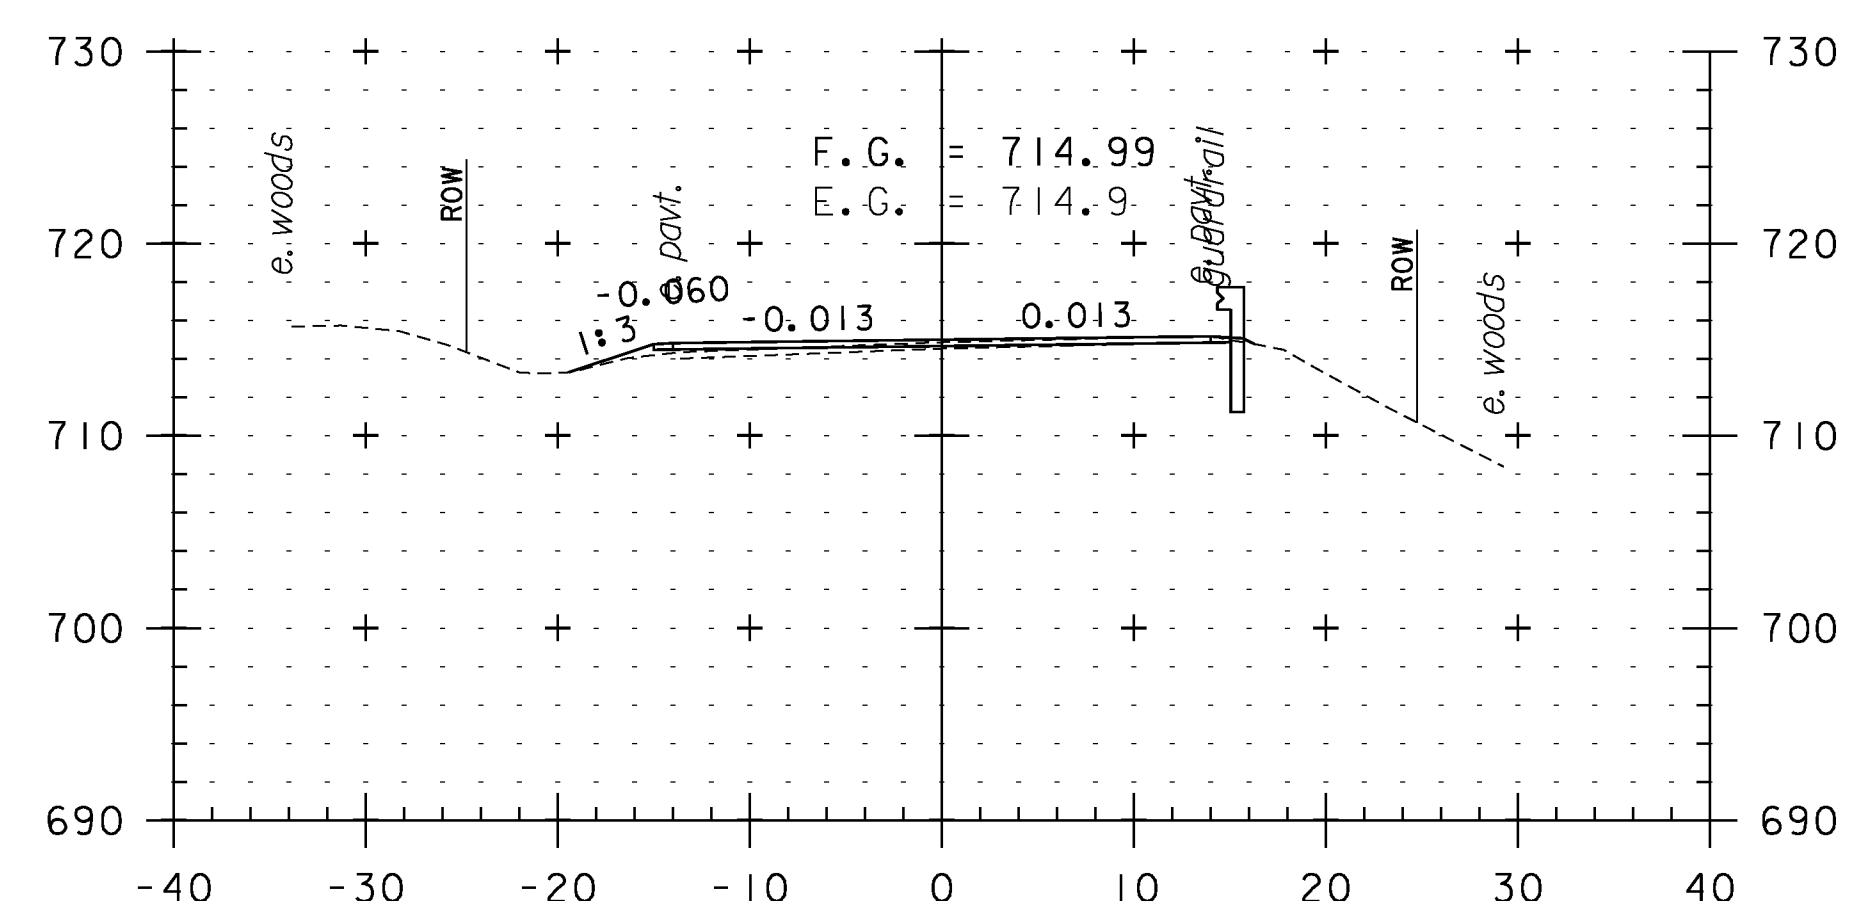

338+00

CROSS SECTION SHEET 64

PROJECT NAME: WEATHERSFIELD

PROJECT NUMBER: STP 2913(I)

FILE NAME: I0c228

PROJECT LEADER: PTS

DESIGNED BY: NLL

IPARM FILE NAME: pI0C228_I54

PLOT DATE: 2/7/2013

DRAWN BY: WWG

CHECKED BY: PTS

SHEET 154 OF 234



STA. 335+00 TO STA. 339+00