




353+00

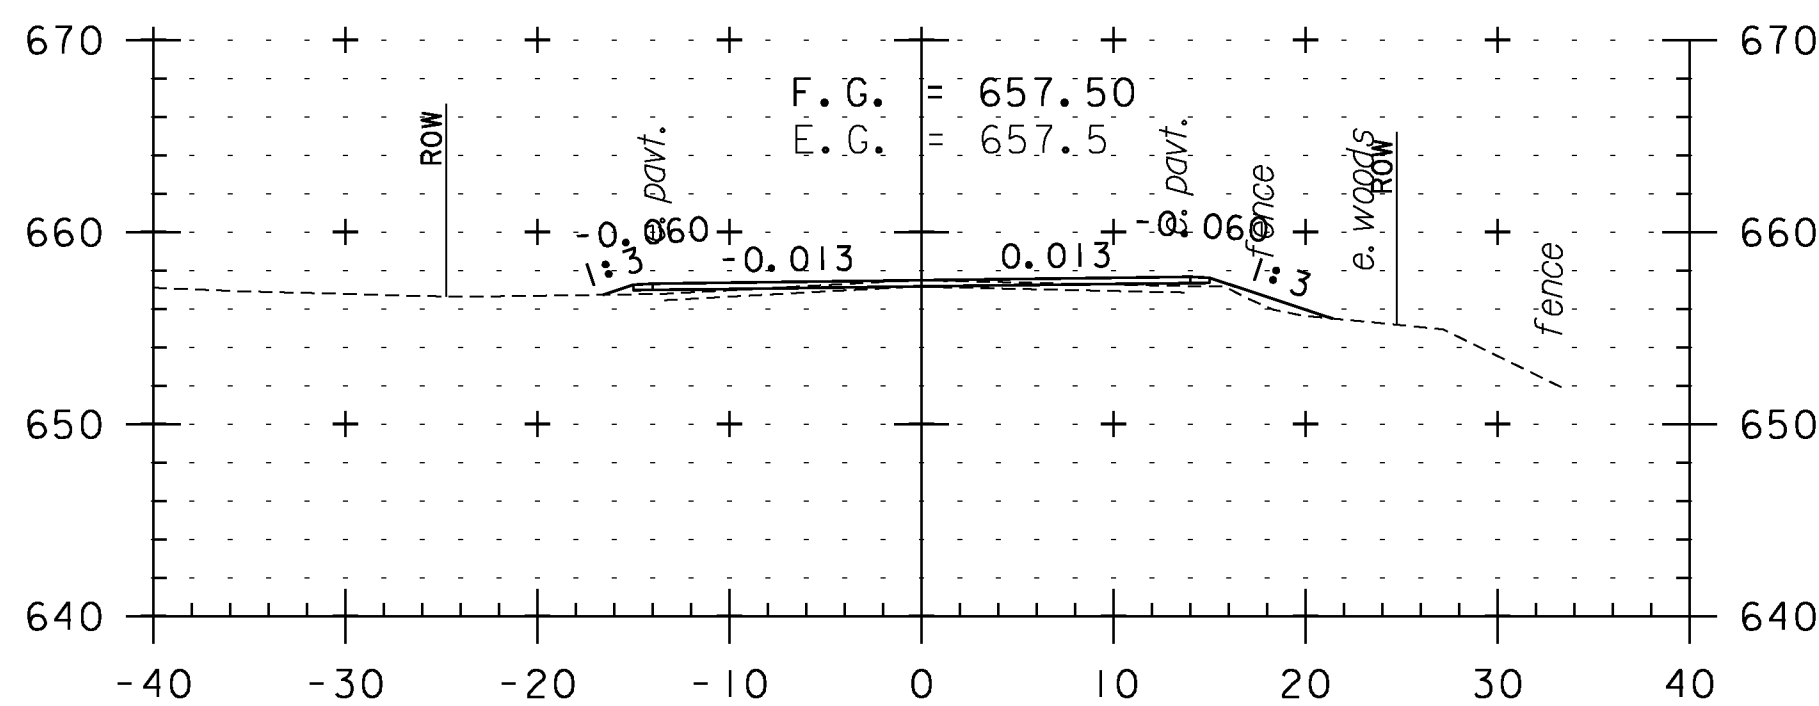


354+50

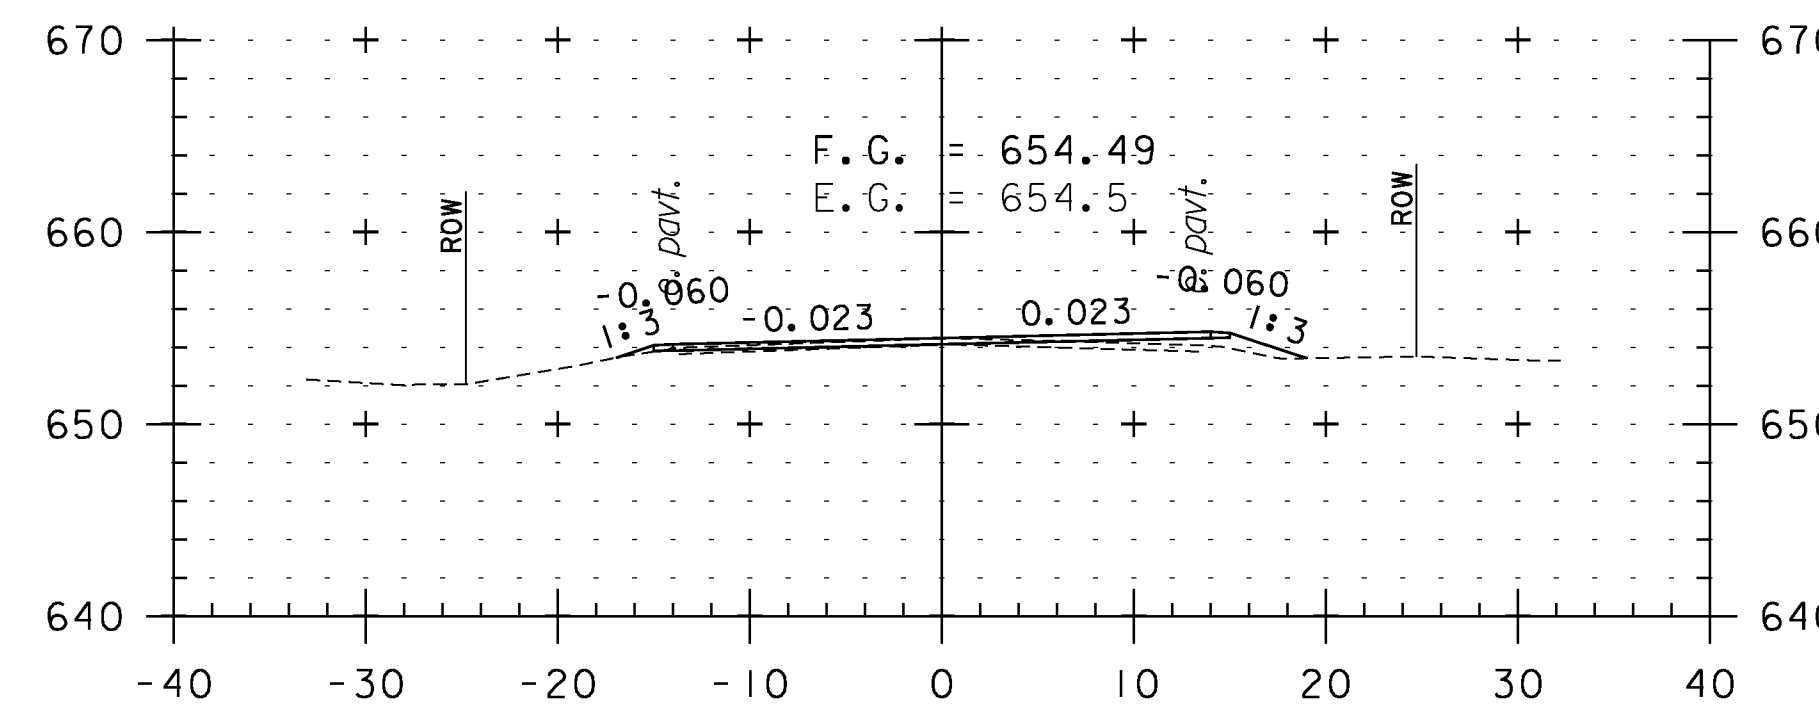


356+00

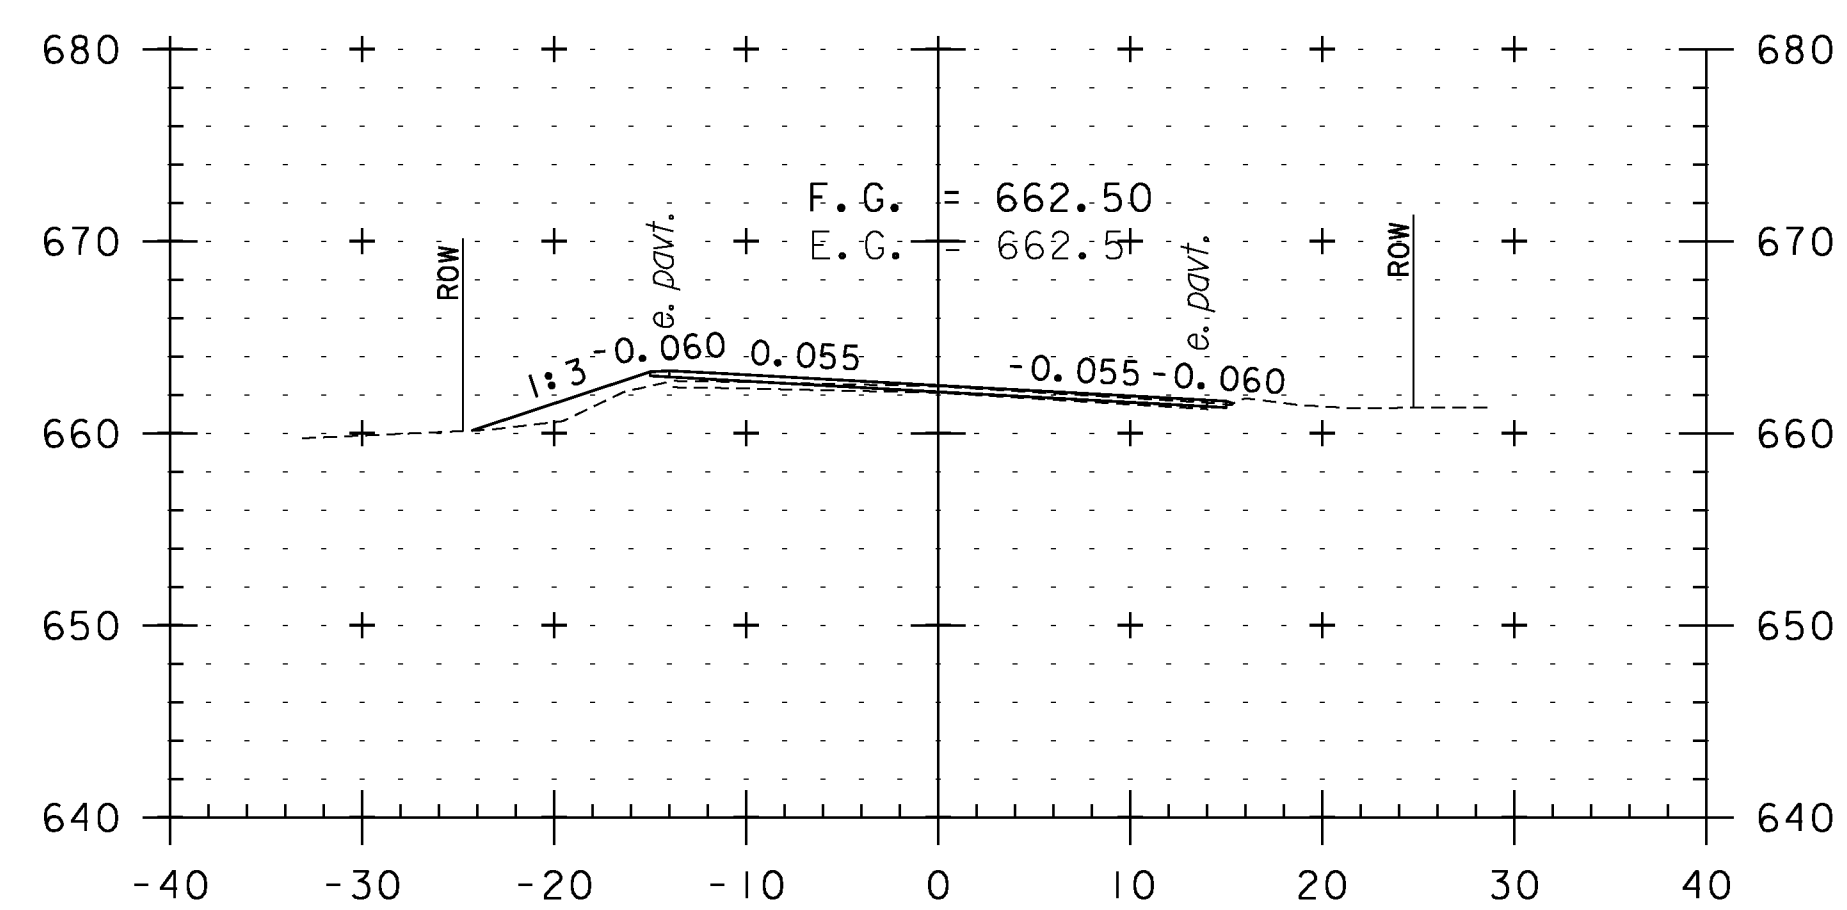


352+50

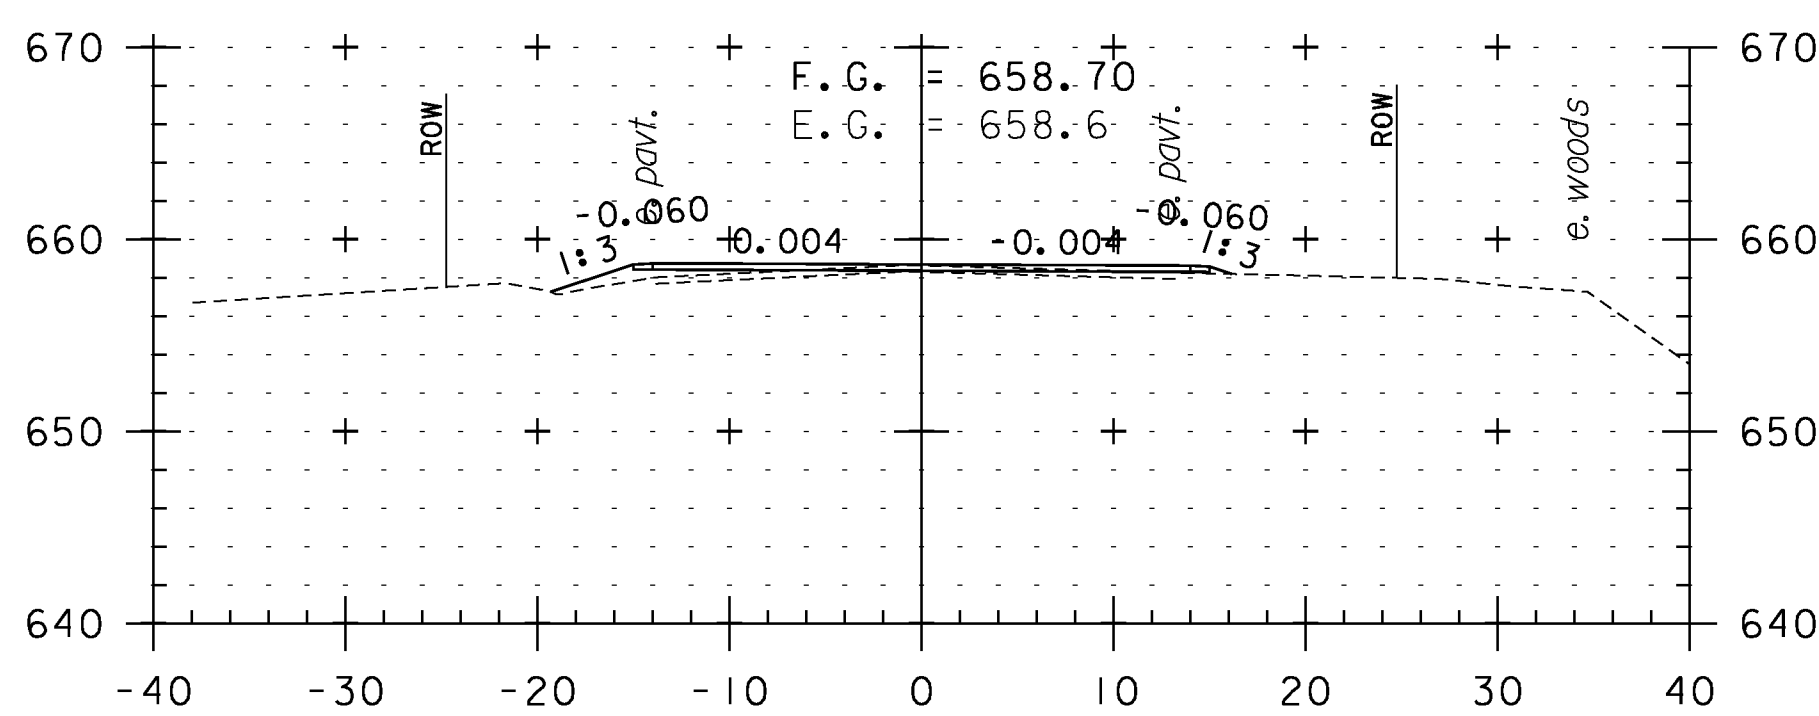


354+00

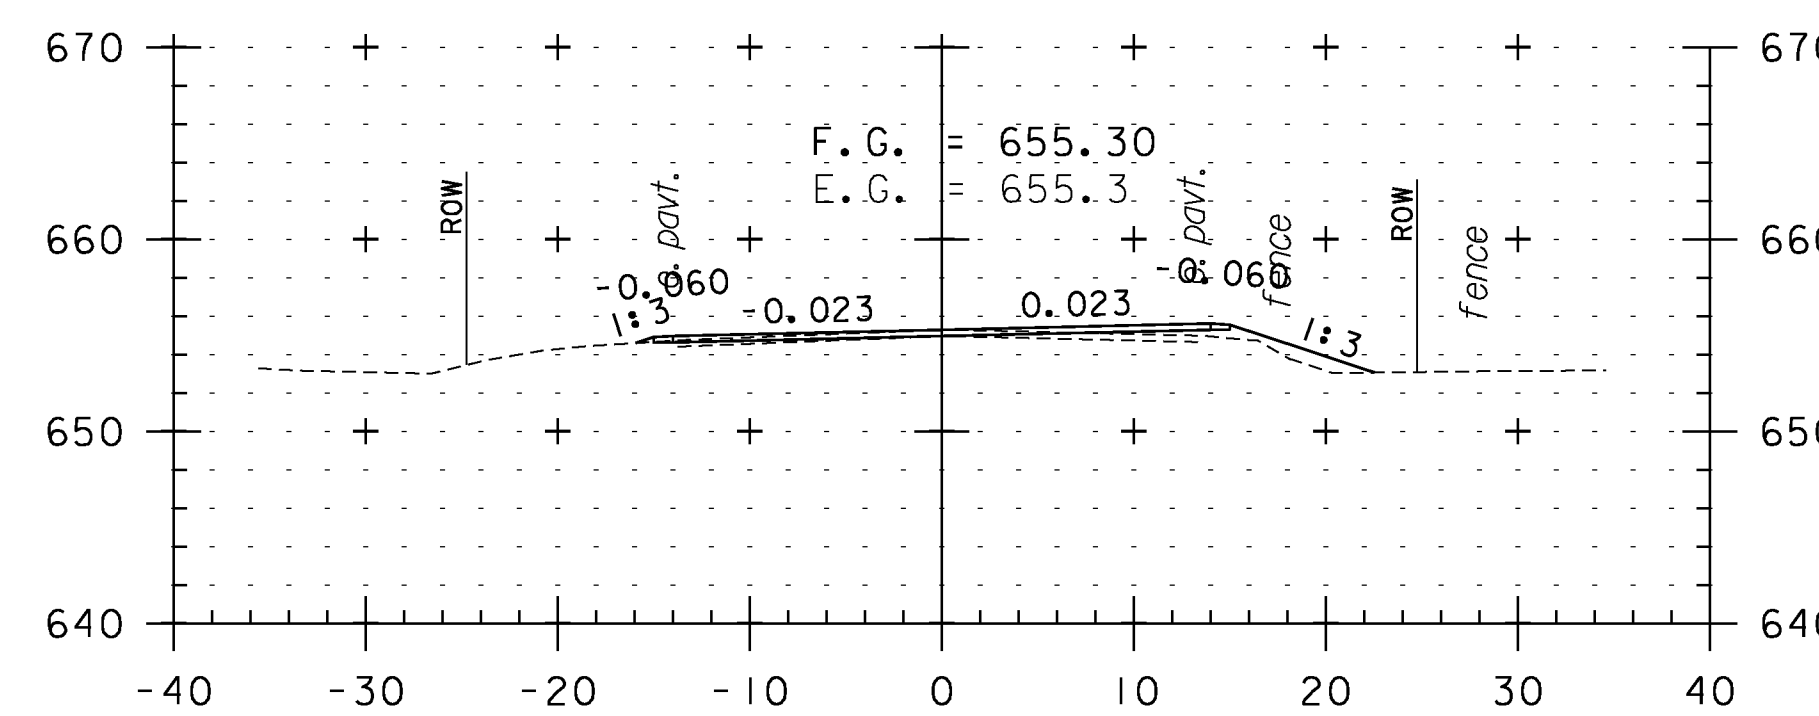


355+50

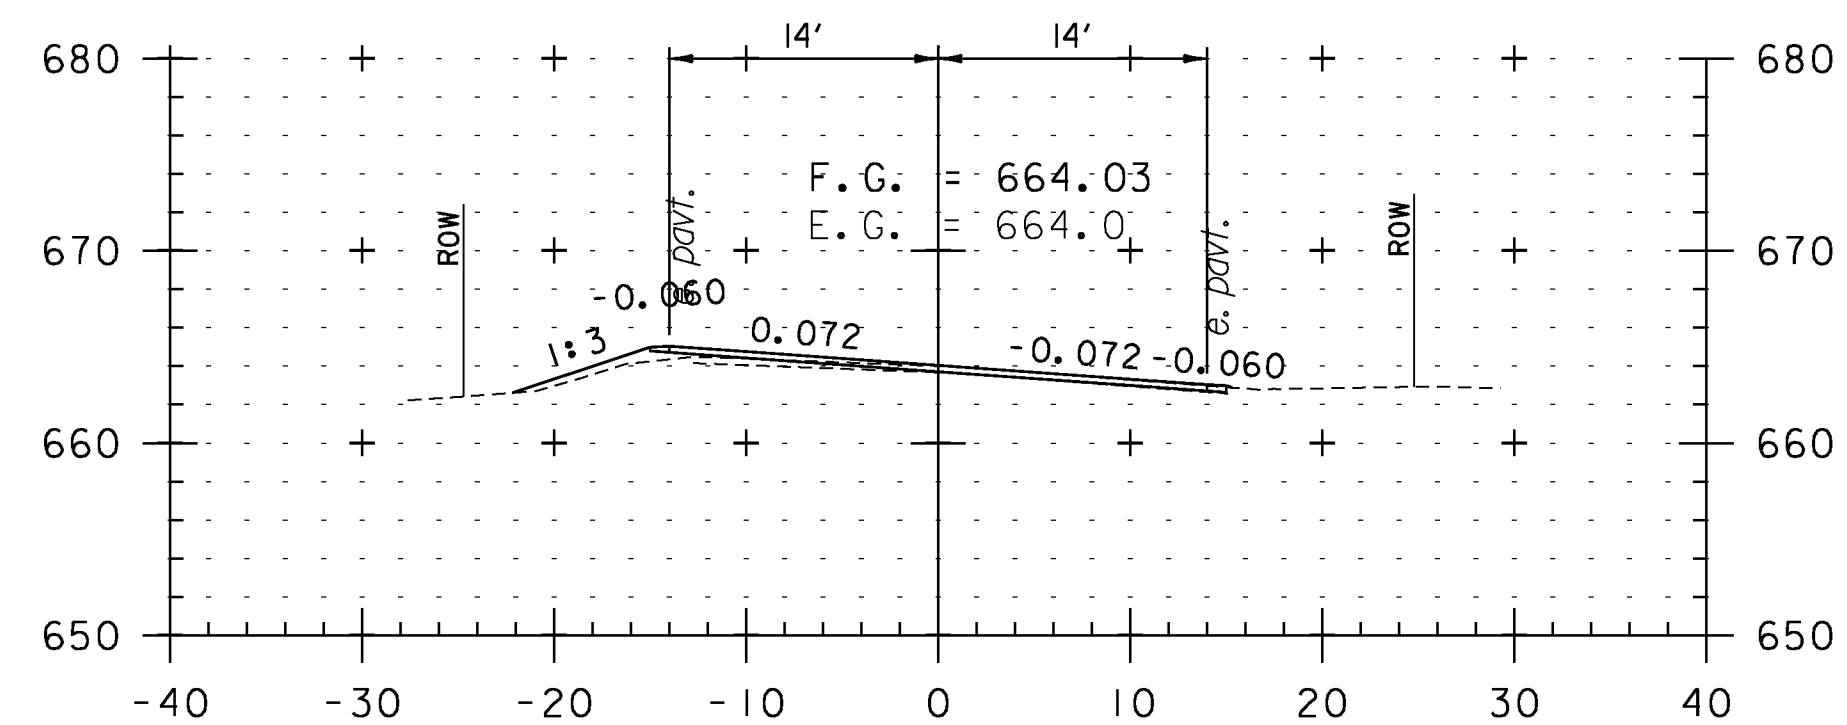

352+00

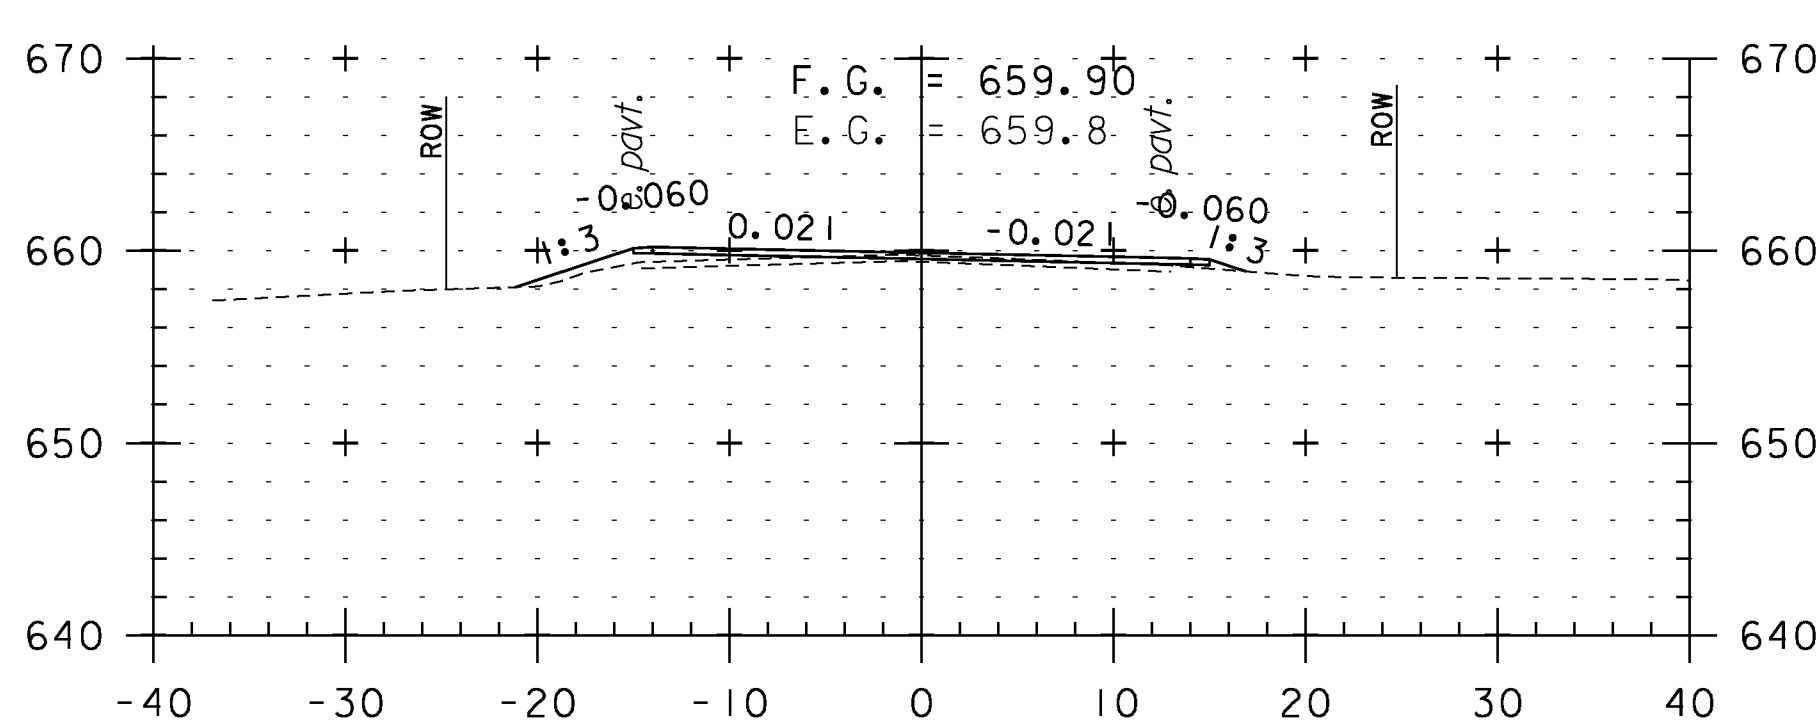


353+50

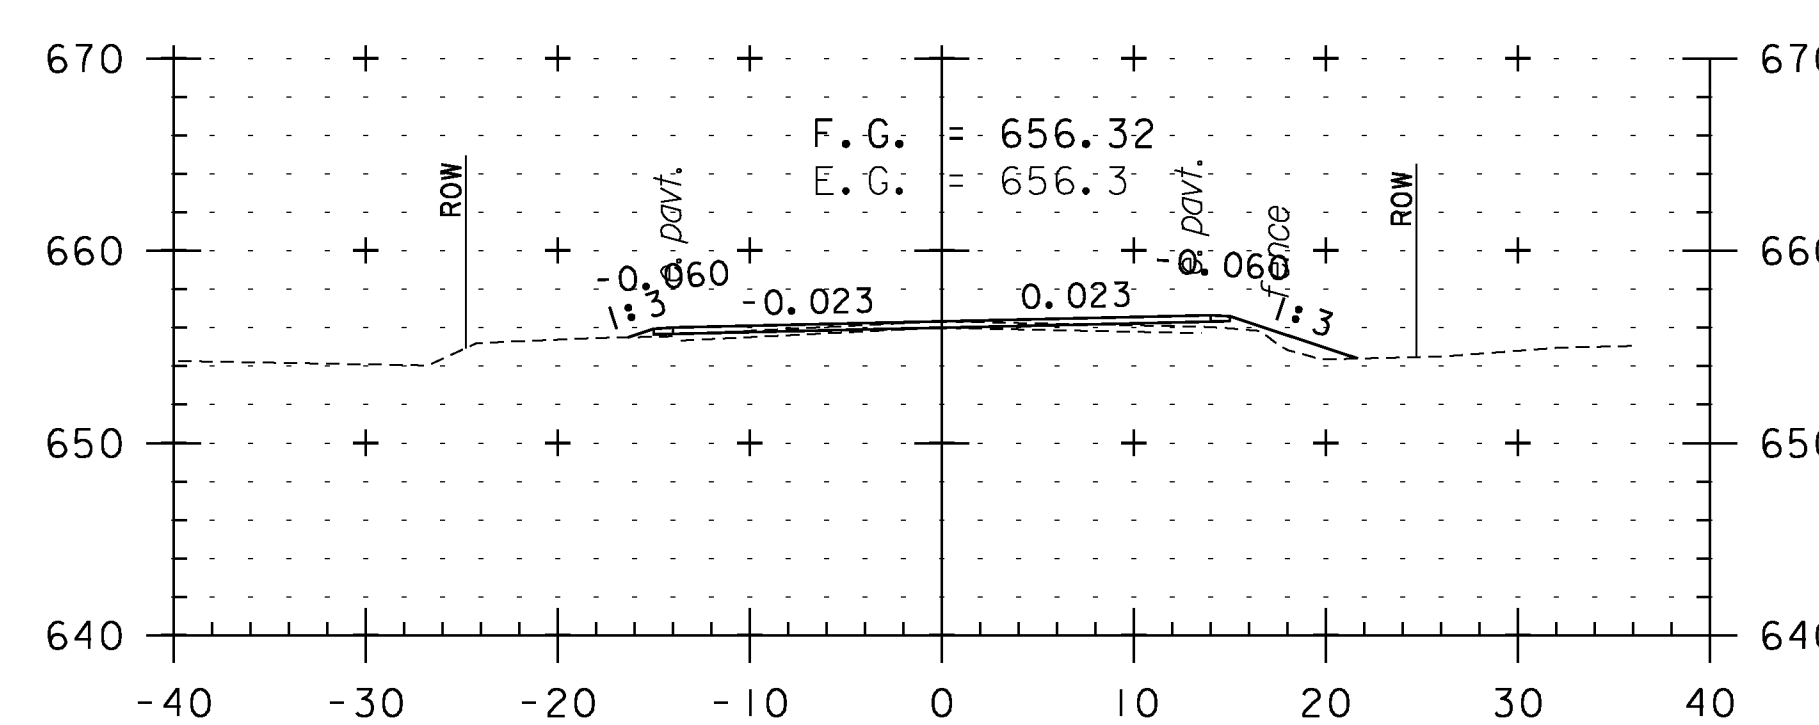

355+00

CROSS SECTION SHEET 68

PROJECT NAME: WEATHERSFIELD	PLOT DATE: 2/7/2013
PROJECT NUMBER: STP 2913(I)	DRAWN BY: WWG
FILE NAME: I0c228	DESIGNED BY: NULL
PROJECT LEADER: PTS	CHECKED BY: PTS
IPARM FILE NAME: pI0c228_I58	SHEET 158 OF 234

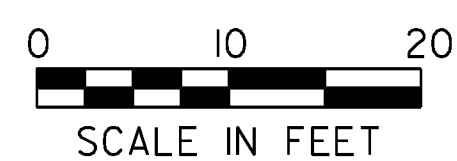

STA. 352+00 TO STA. 356+00