




357+50

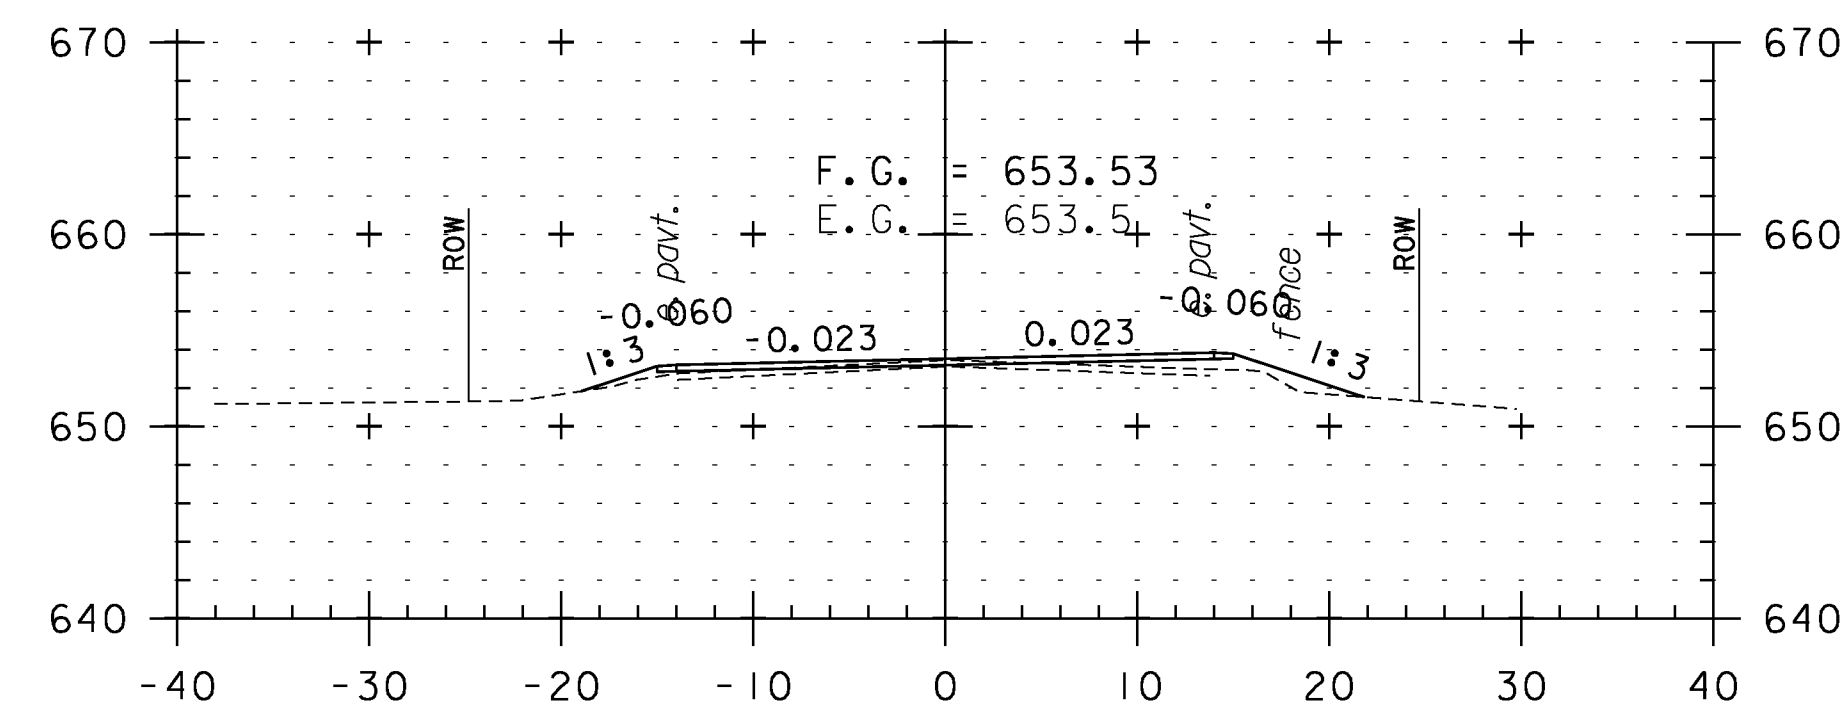


357+00

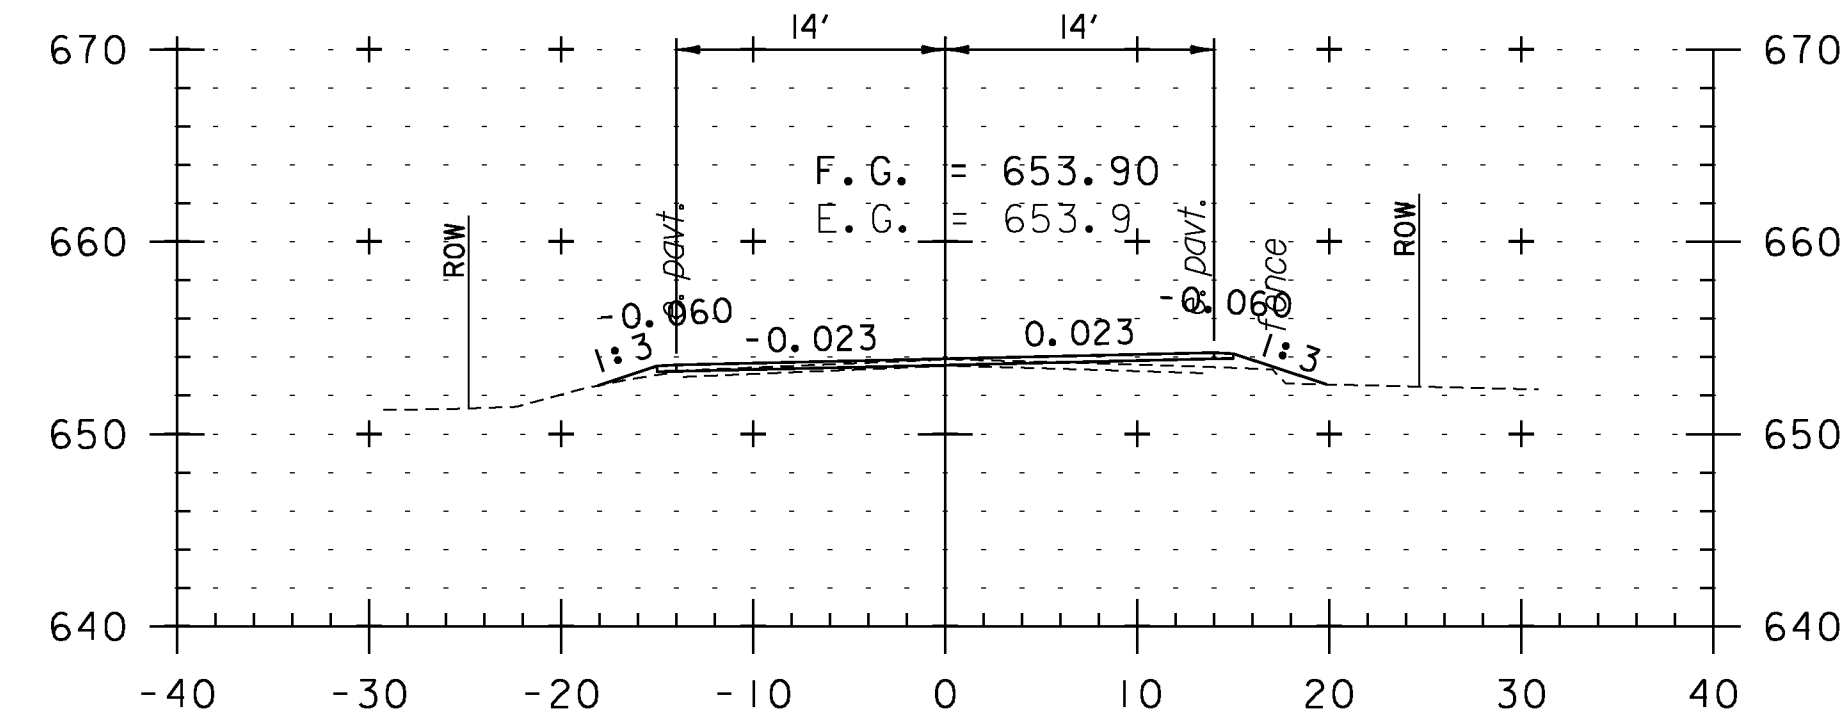


356+50

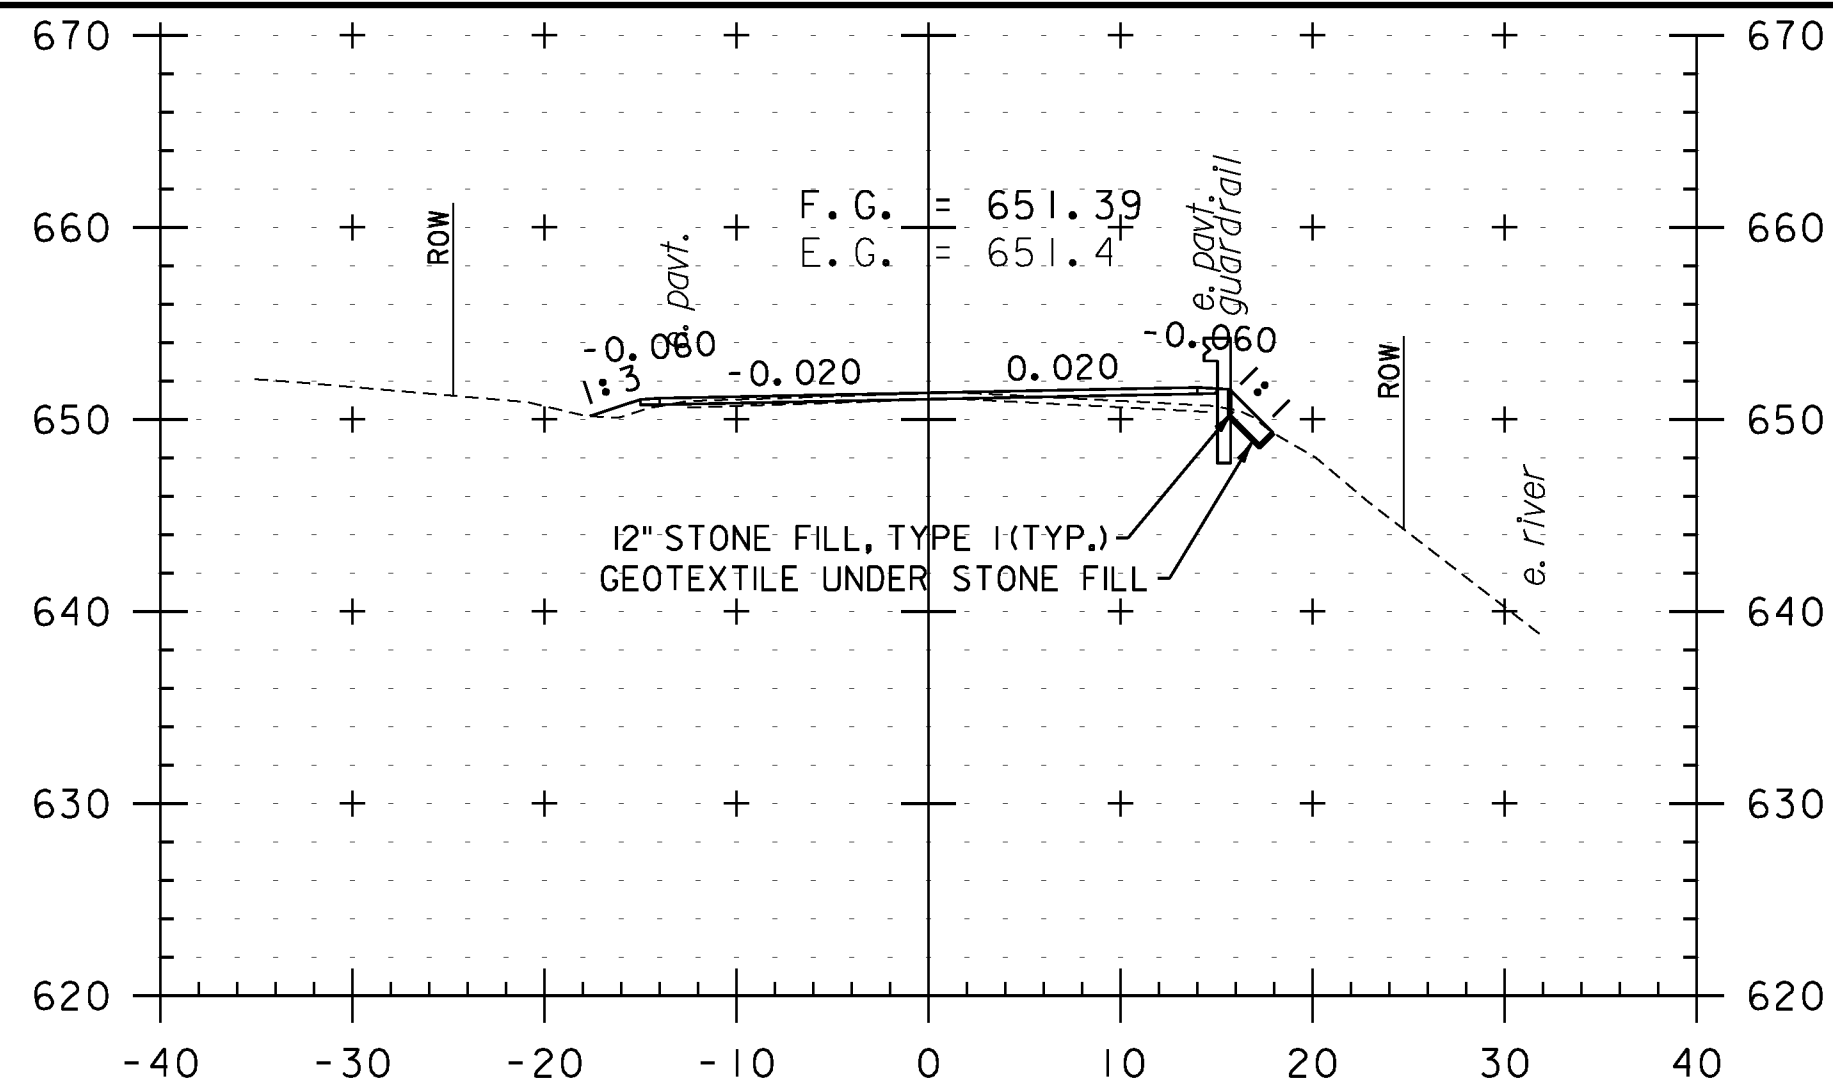


359+00

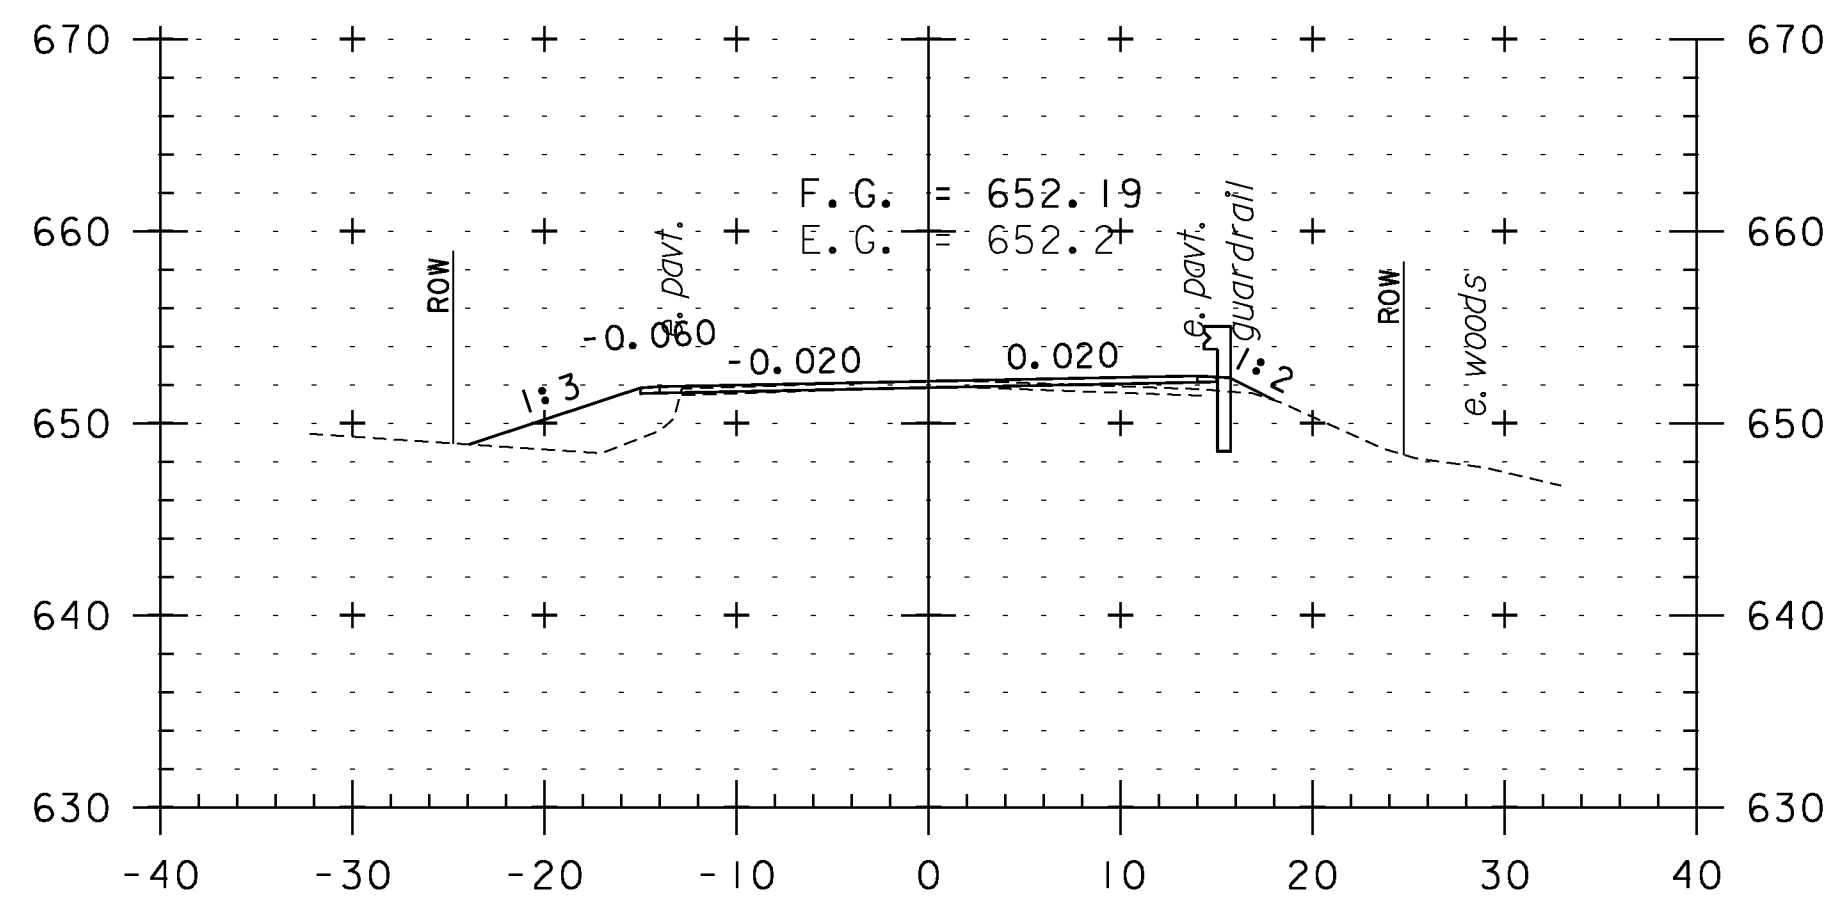


358+50

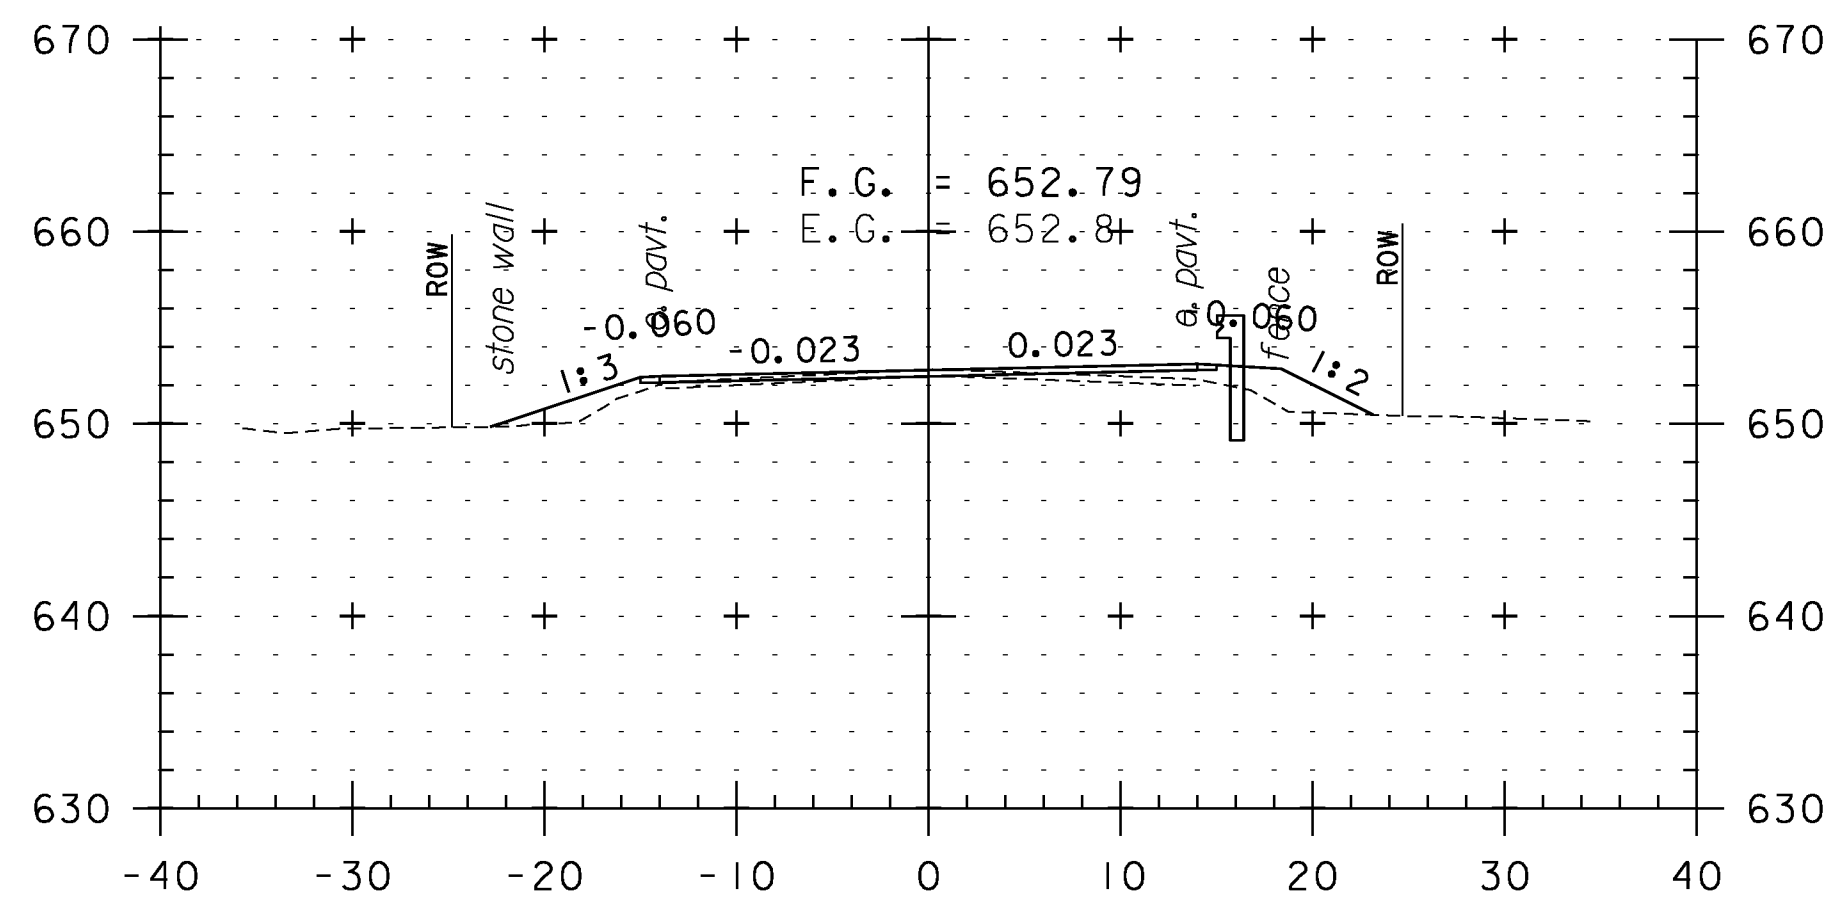

358+00

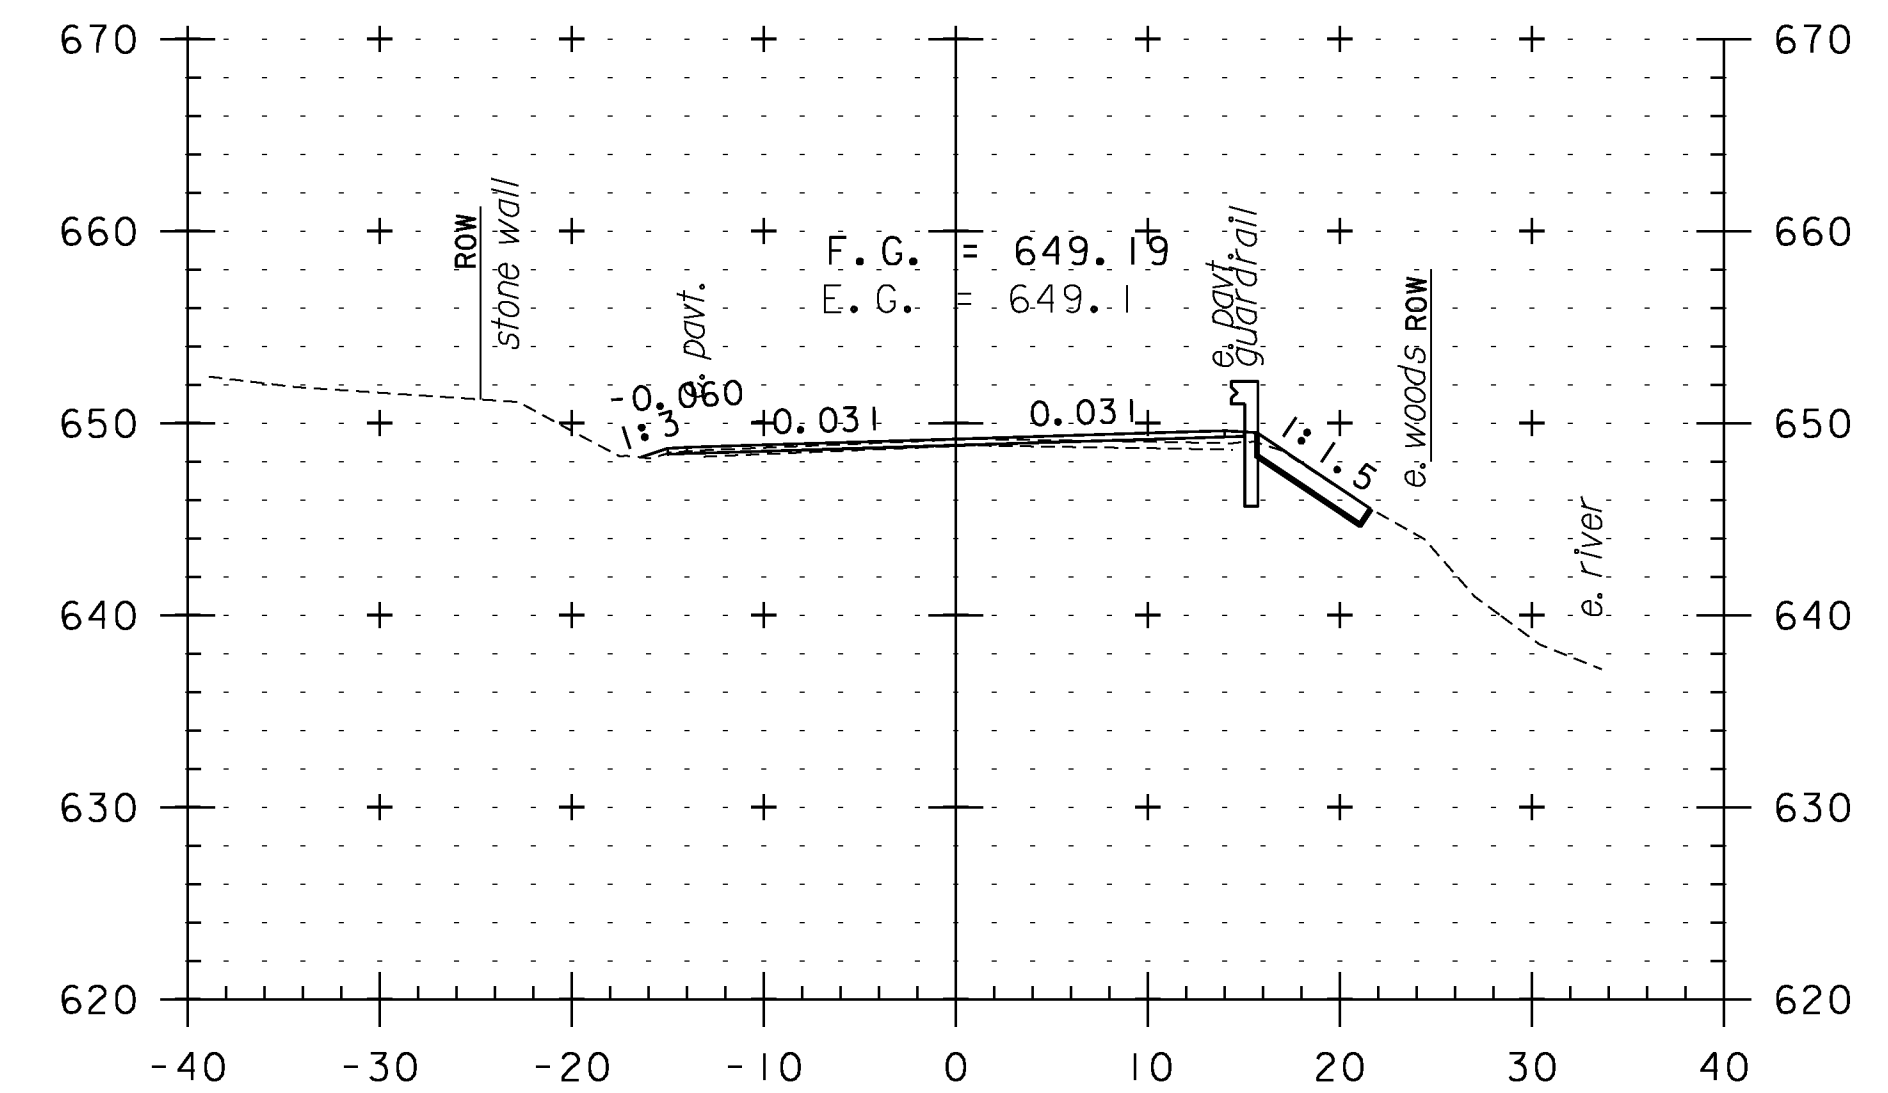

360+00

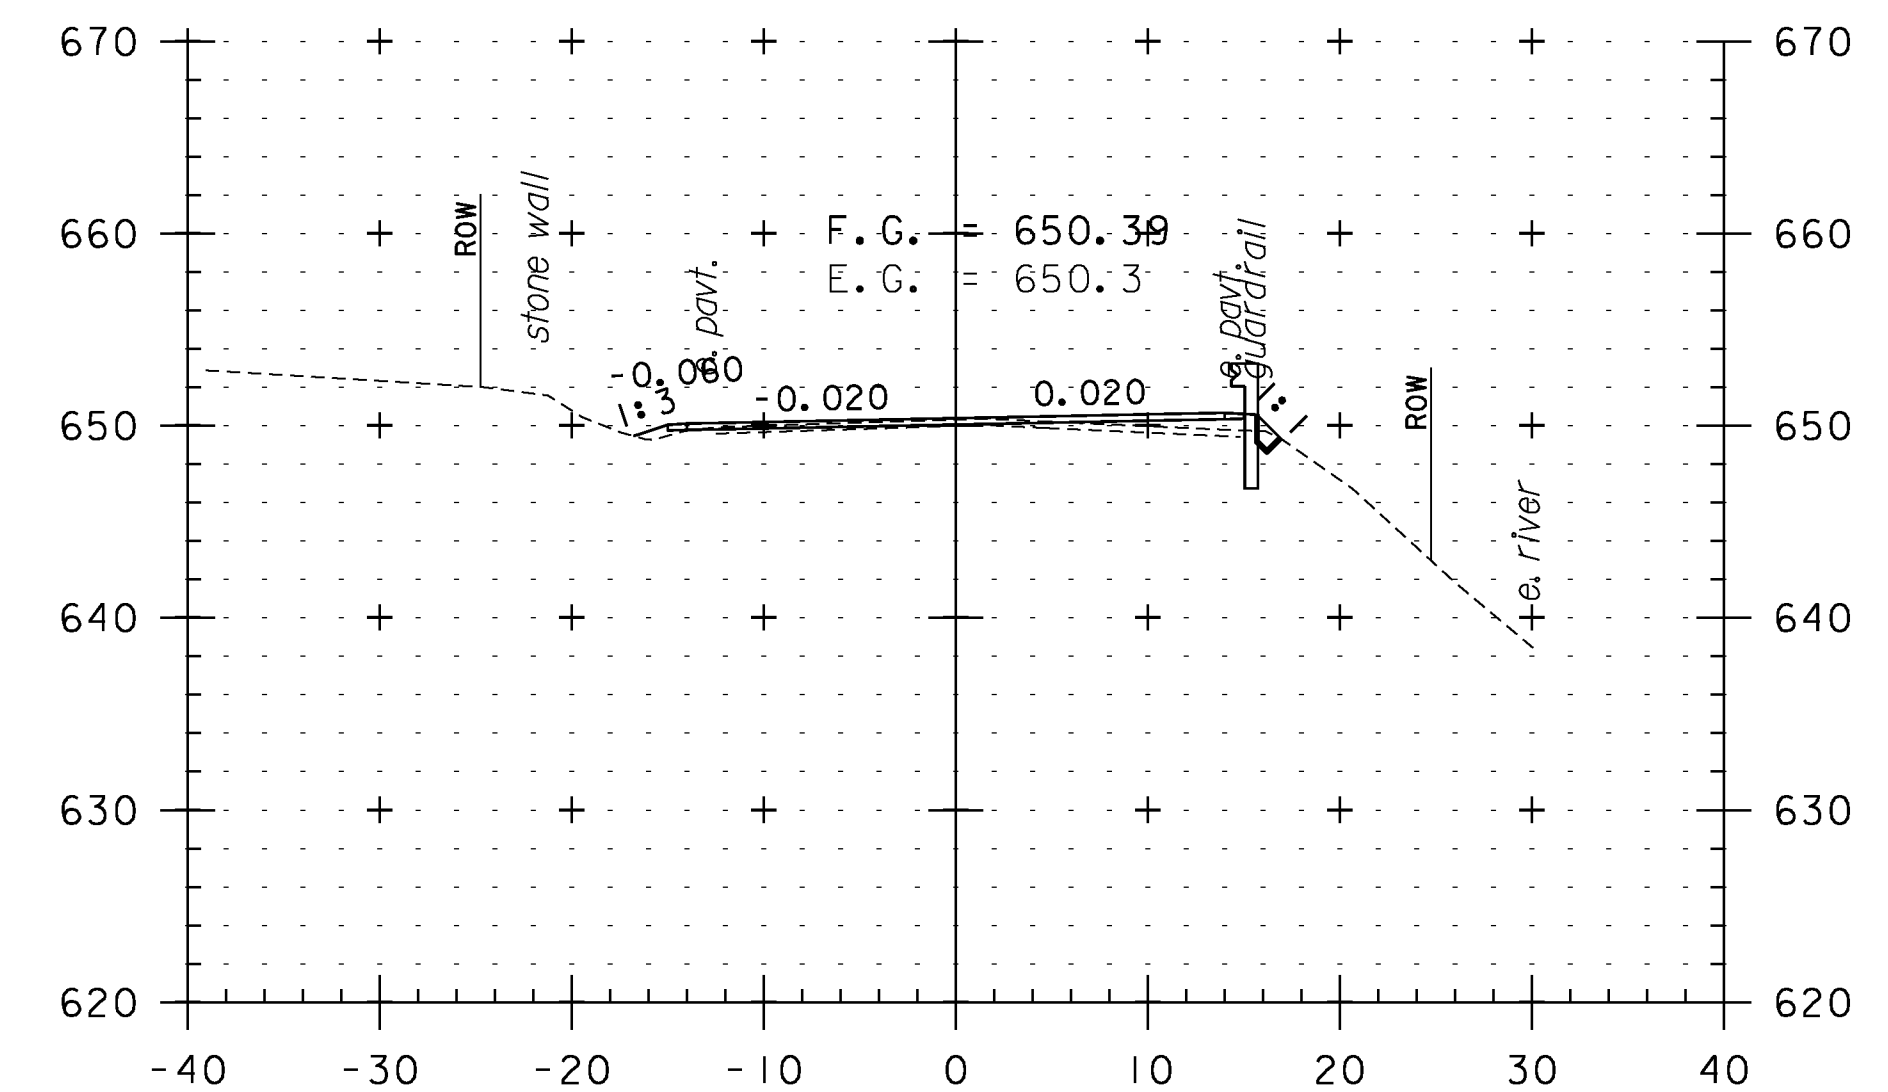

359+50

CROSS SECTION SHEET 69

PROJECT NAME: WEATHERSFIELD

PROJECT NUMBER: STP 2913(I)

FILE NAME: I0c228

PROJECT LEADER: PTS

DESIGNED BY: NLL


IPARM FILE NAME: pI0c228_159

PLOT DATE: 2/7/2013

DRAWN BY: WWG

CHECKED BY: PTS

SHEET 159 OF 234

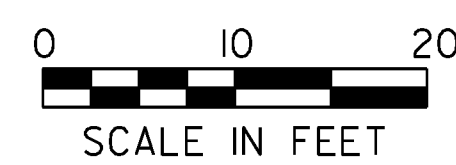

STA. 356+50 TO STA. 360+00