




369+50

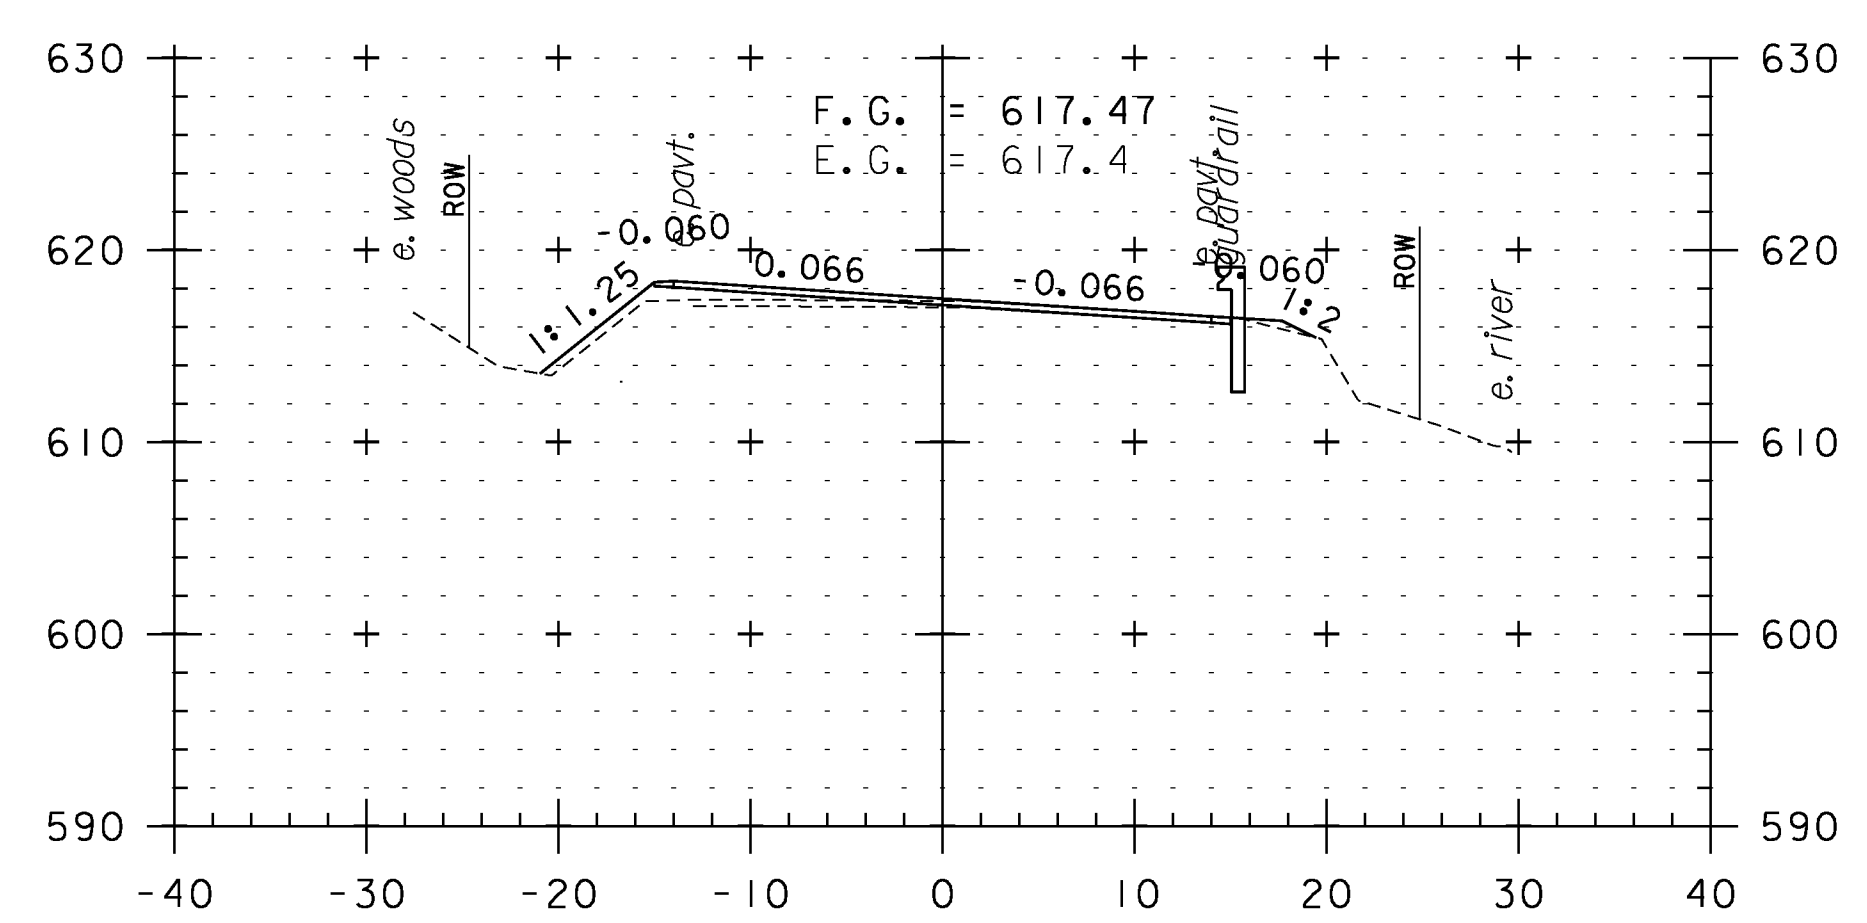


371+00

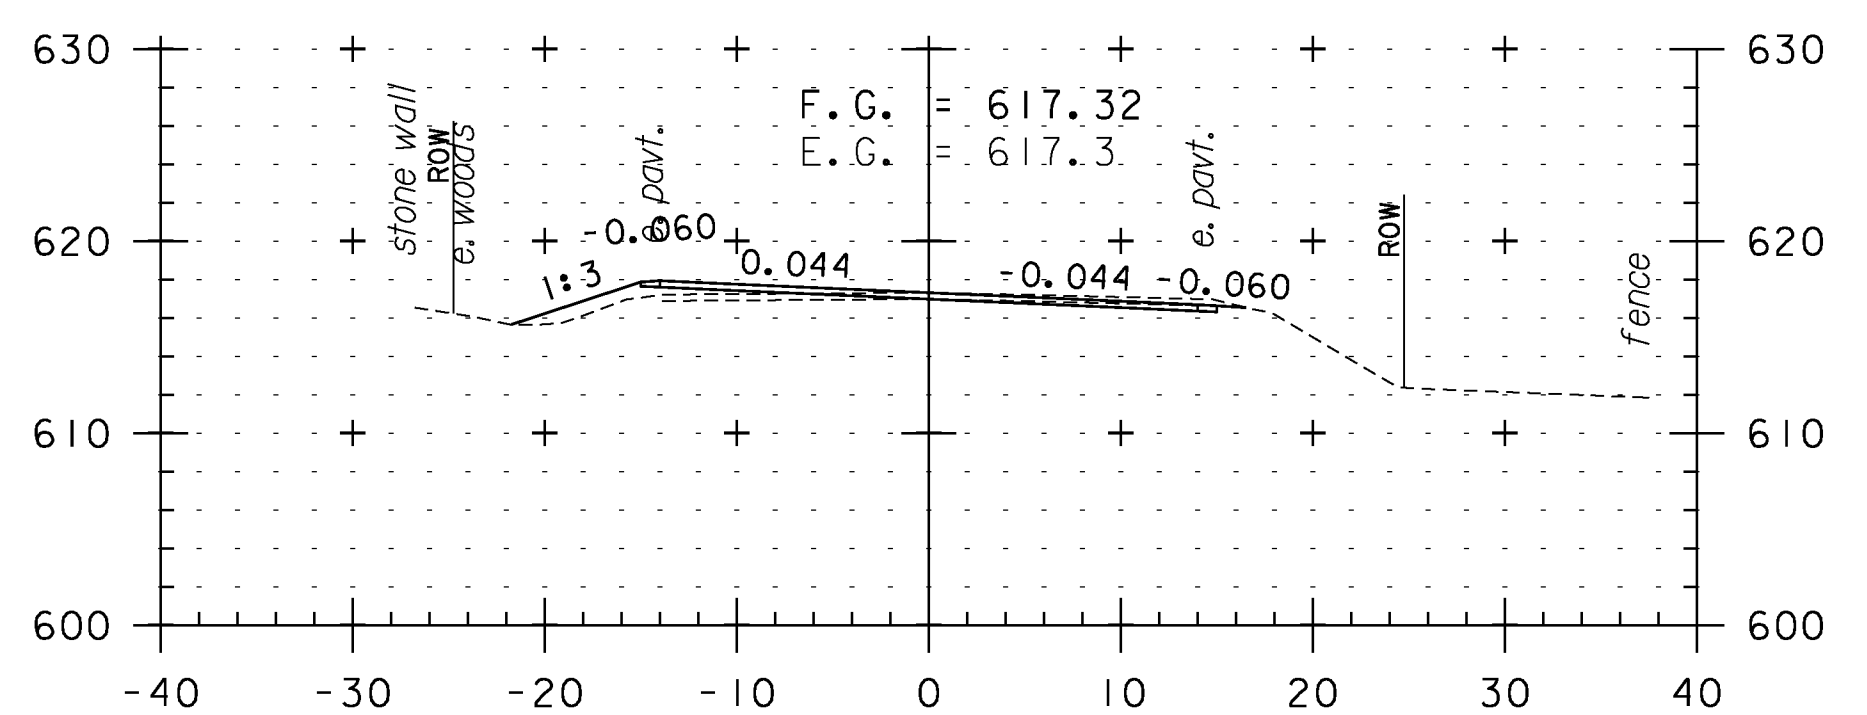


372+50

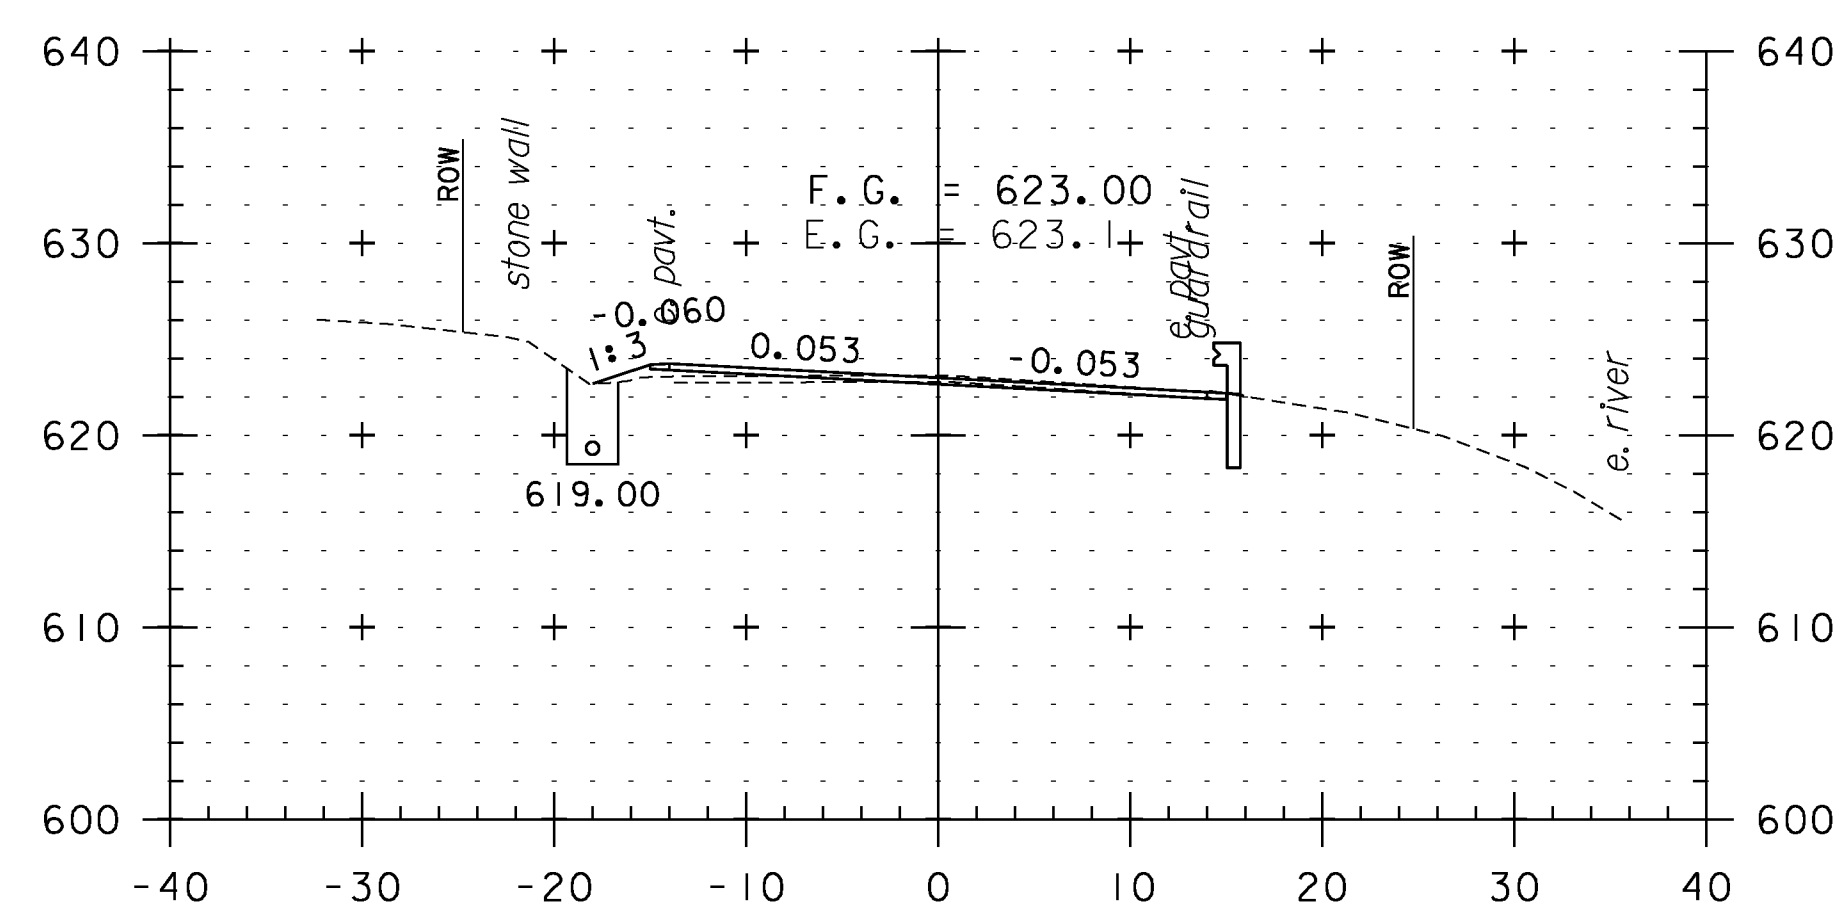


369+00

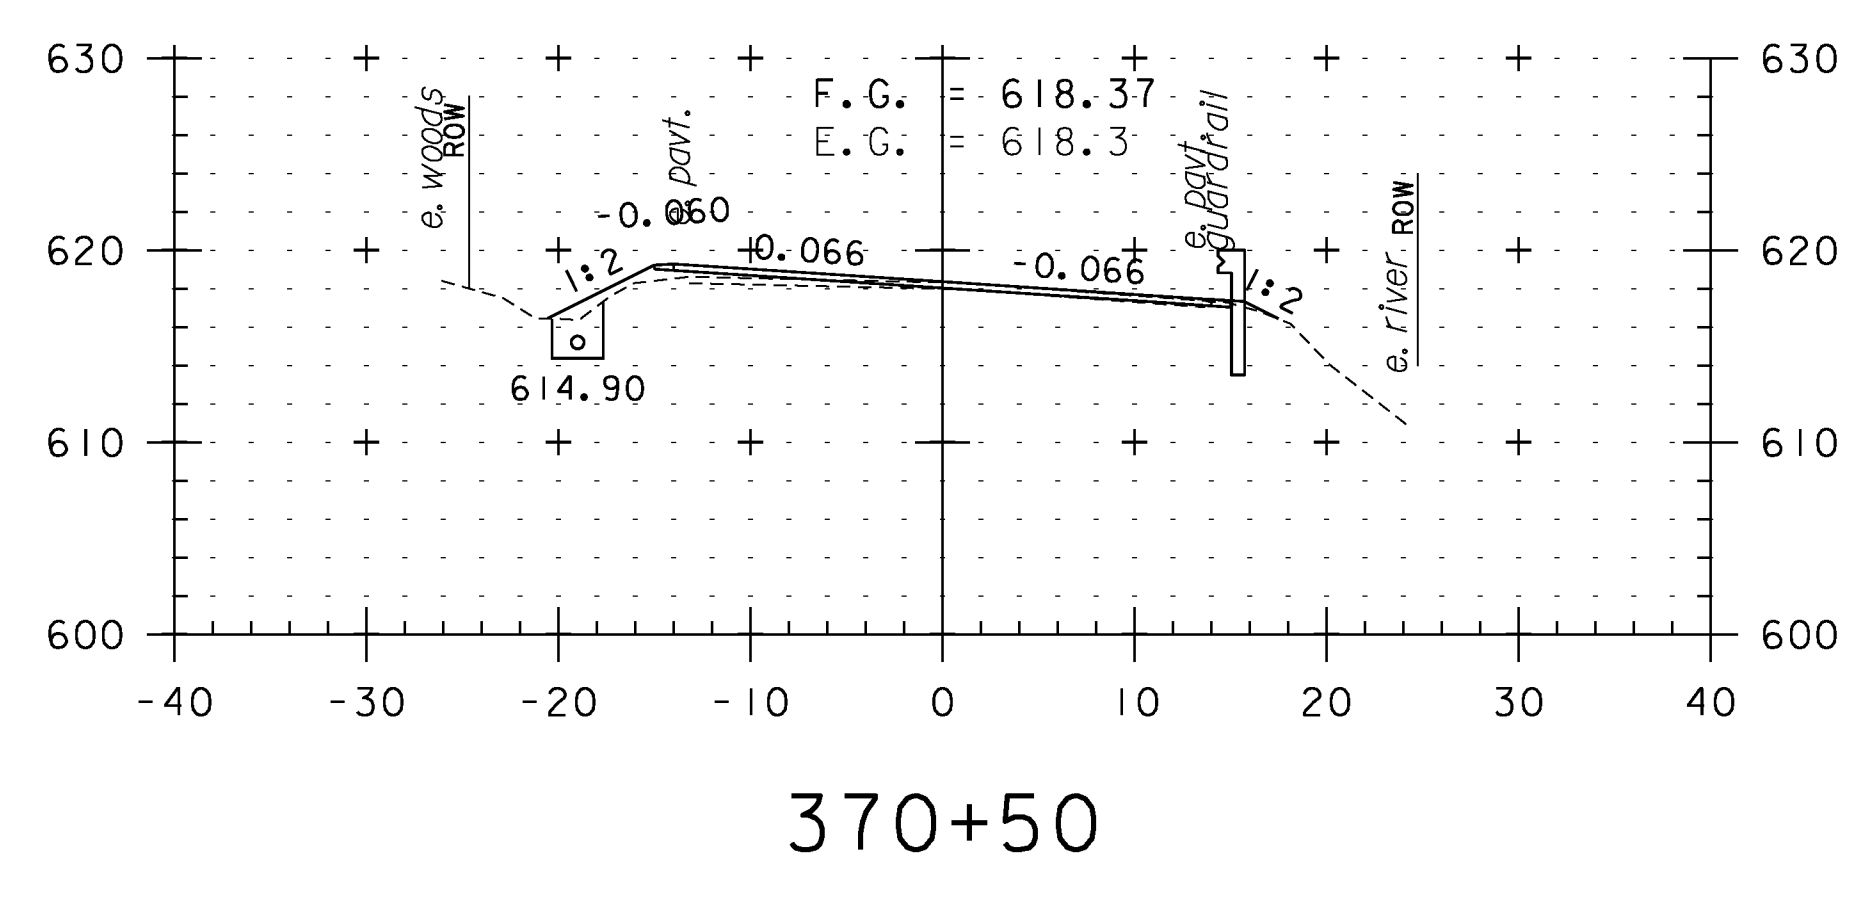


370+50

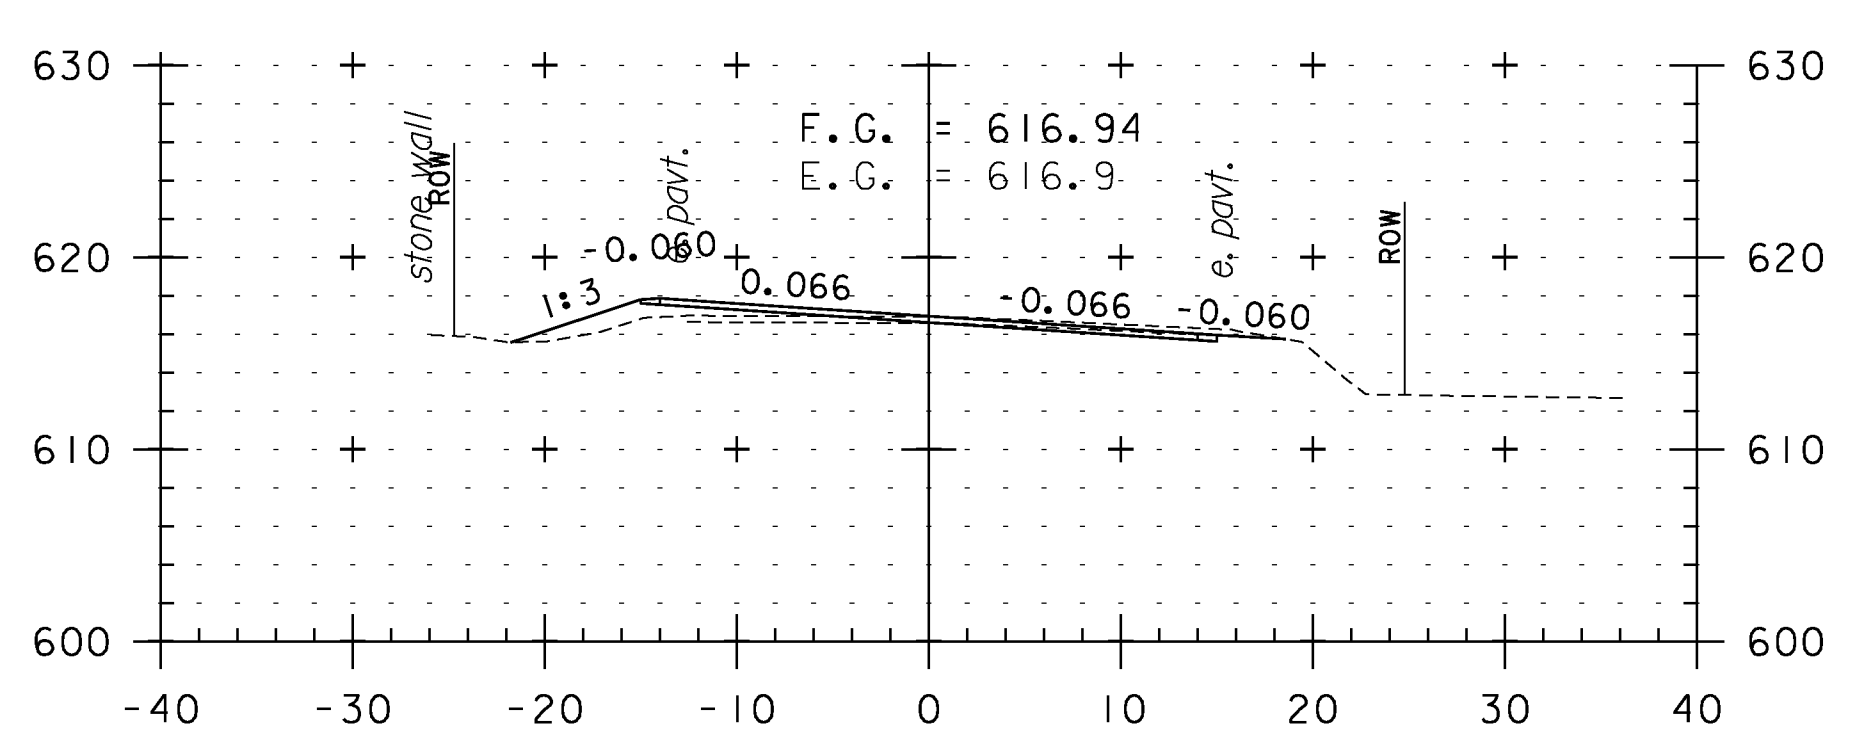


372+00

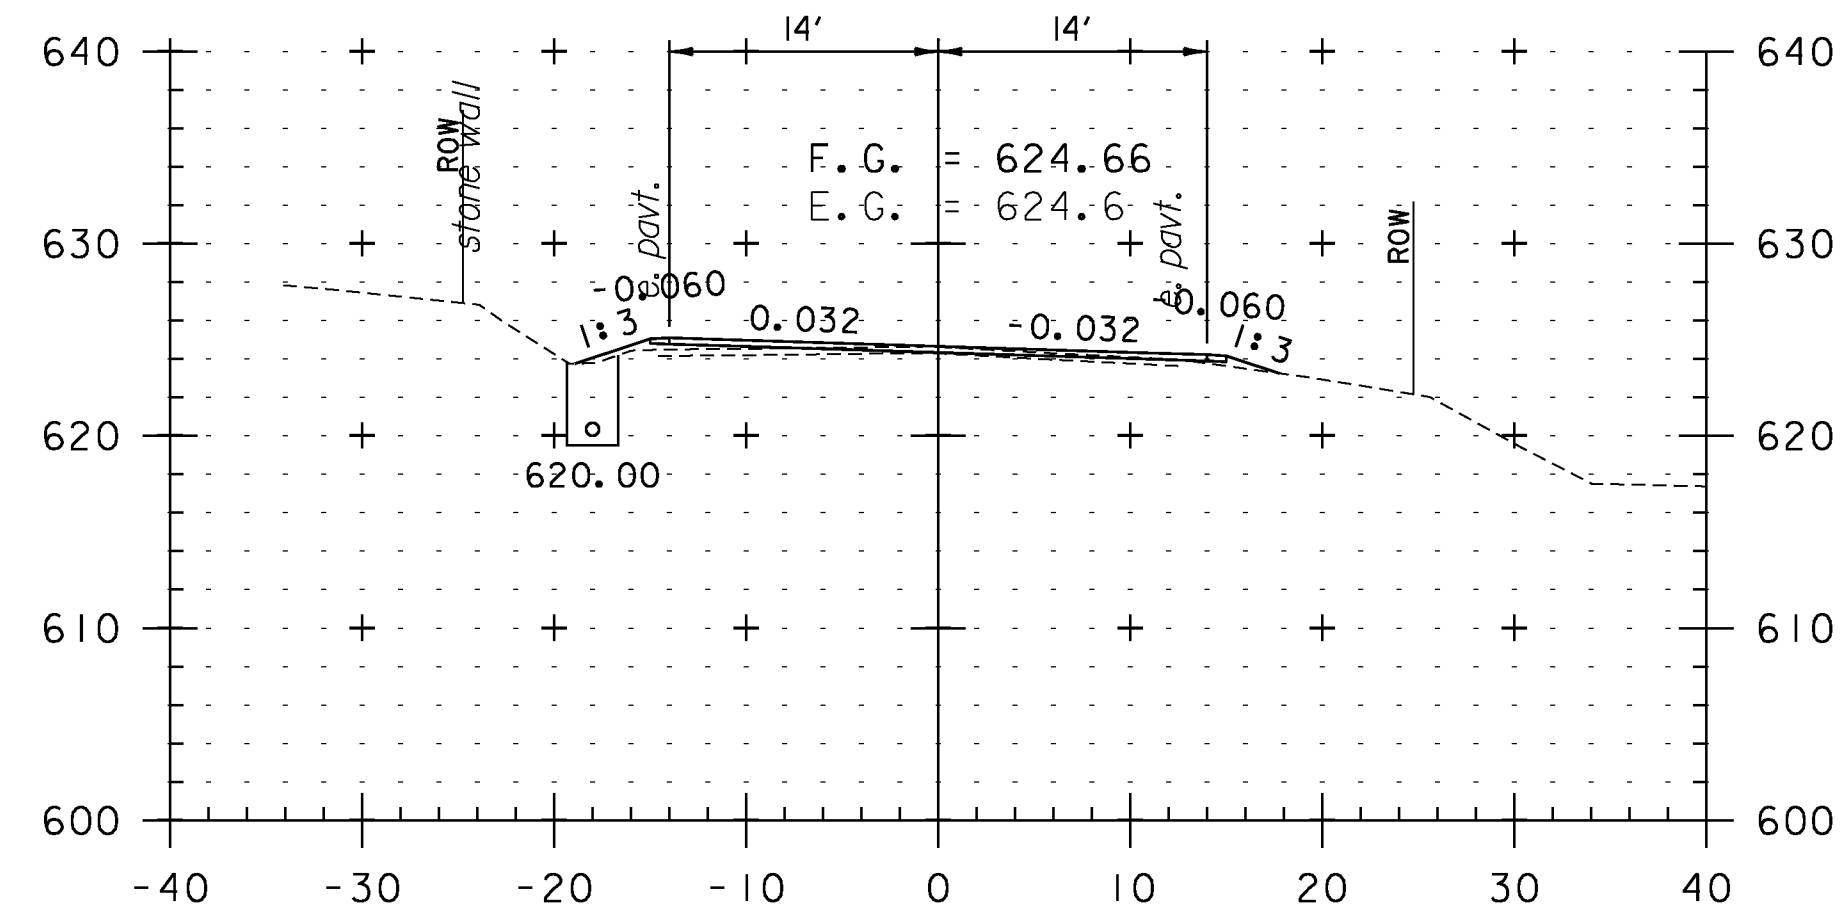

368+50

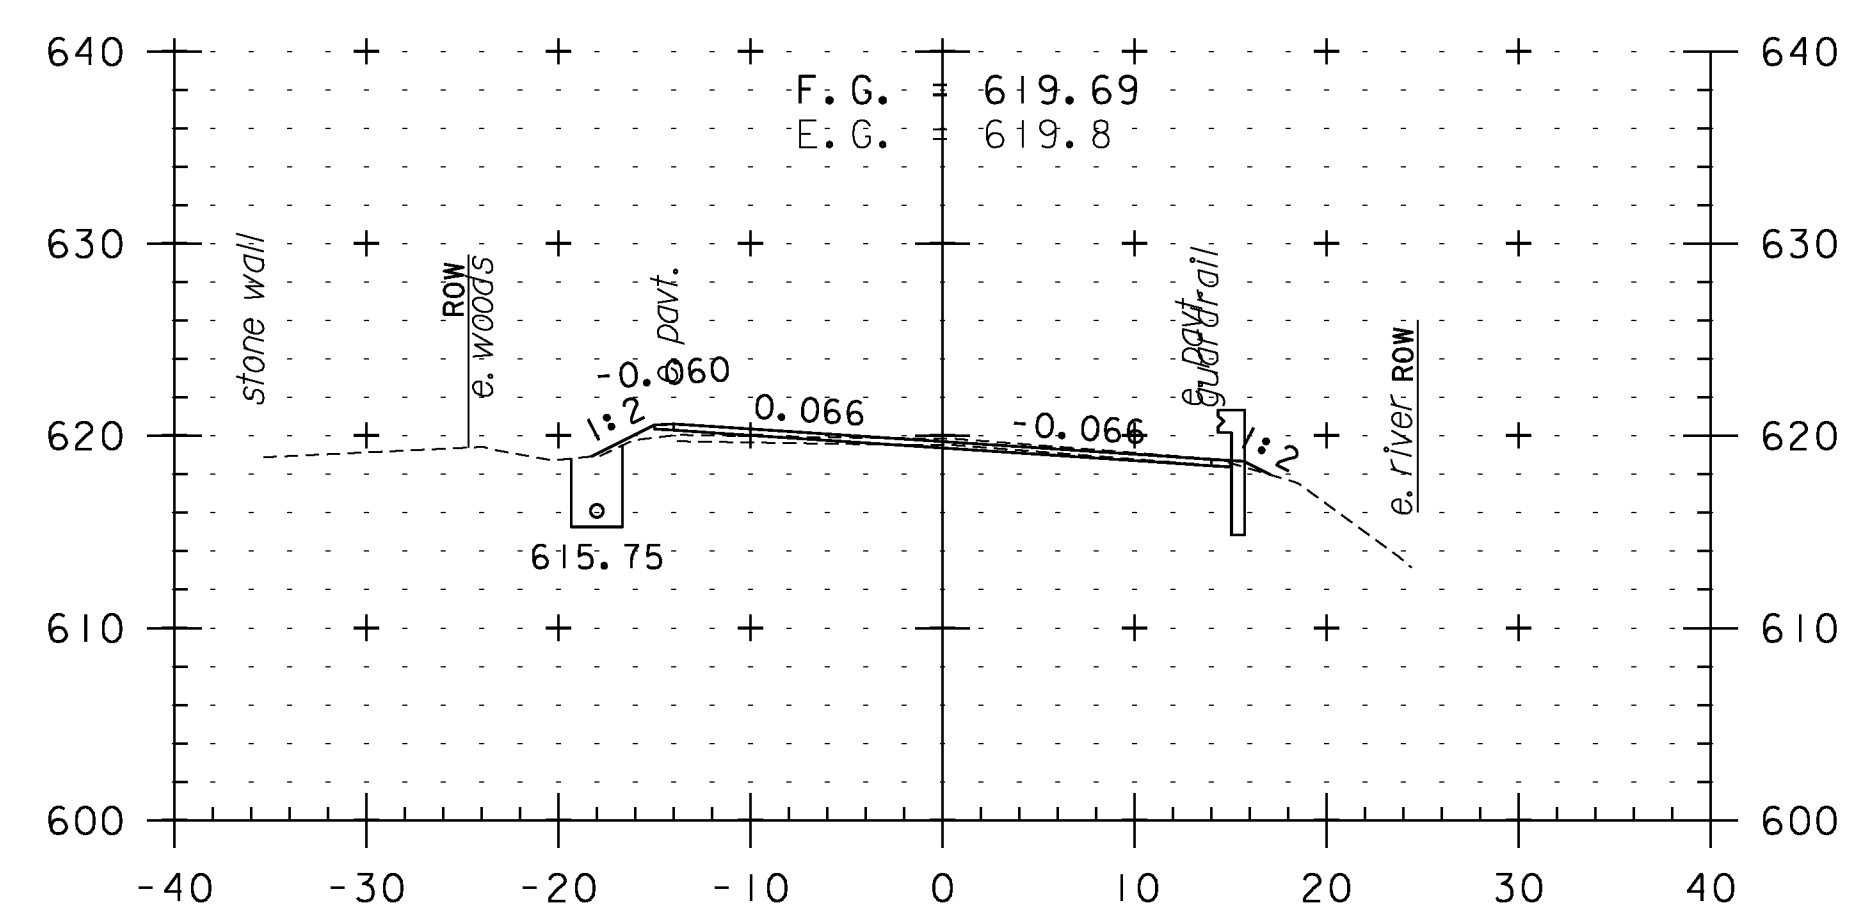

370+00

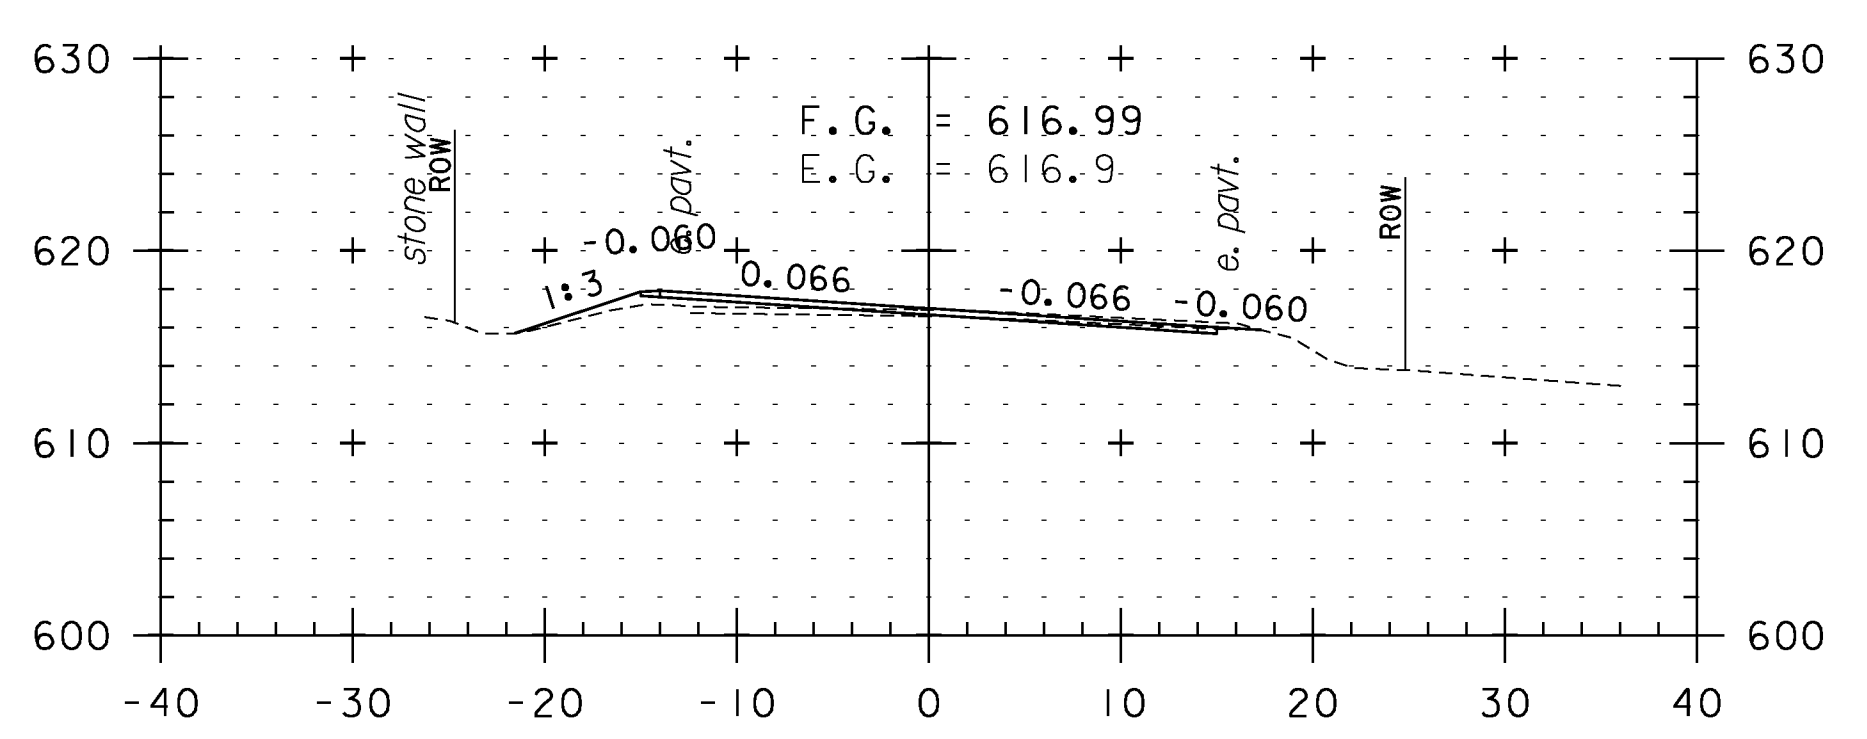

371+50

**CROSS SECTION SHEET 72**

PROJECT NAME: WEATHERSFIELD	PLOT DATE: 2/7/2013
PROJECT NUMBER: STP 2913(I)	DRAWN BY: WWG
FILE NAME: I0c228	CHECKED BY: PTS
PROJECT LEADER: PTS	SHEET 162 OF 234
DESIGNED BY: NLL	
IPARM FILE NAME: pI0c228.l62	



STA. 368+50 TO STA. 372+50