




378+00

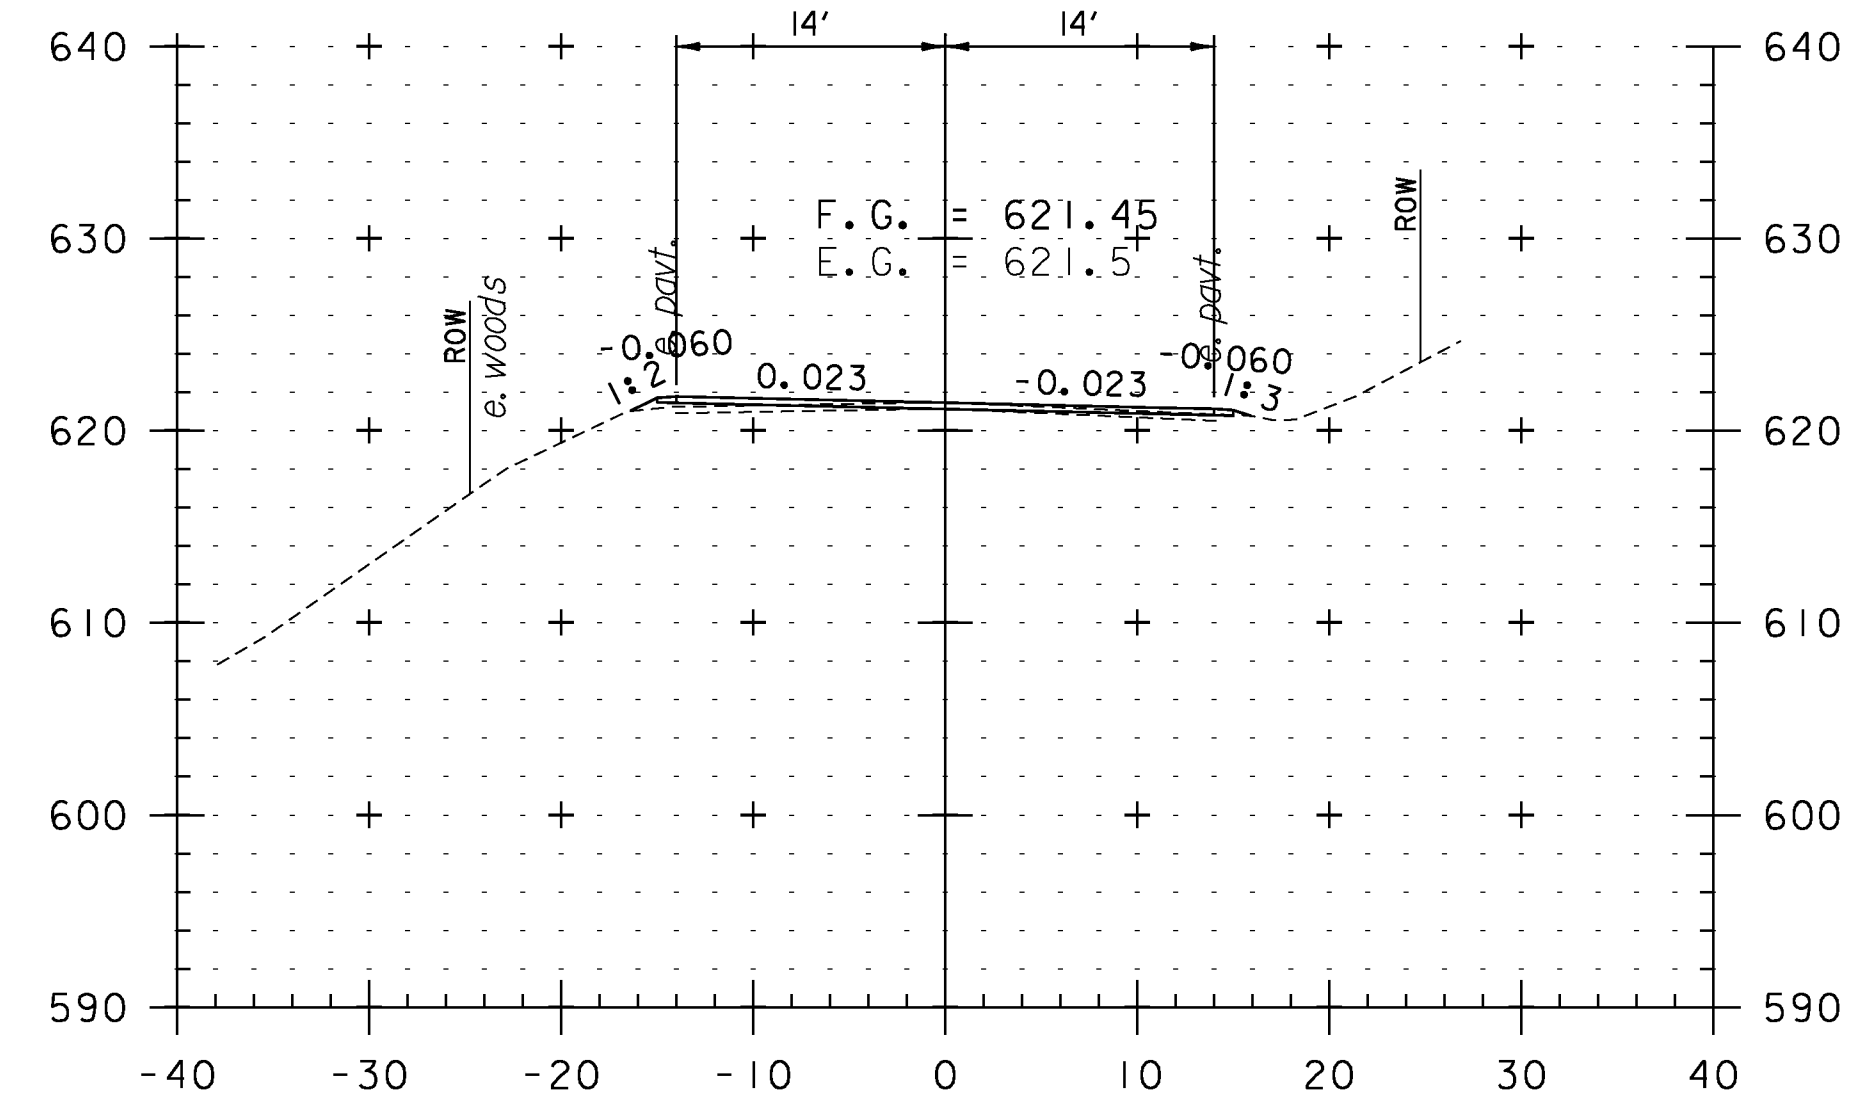


377+50

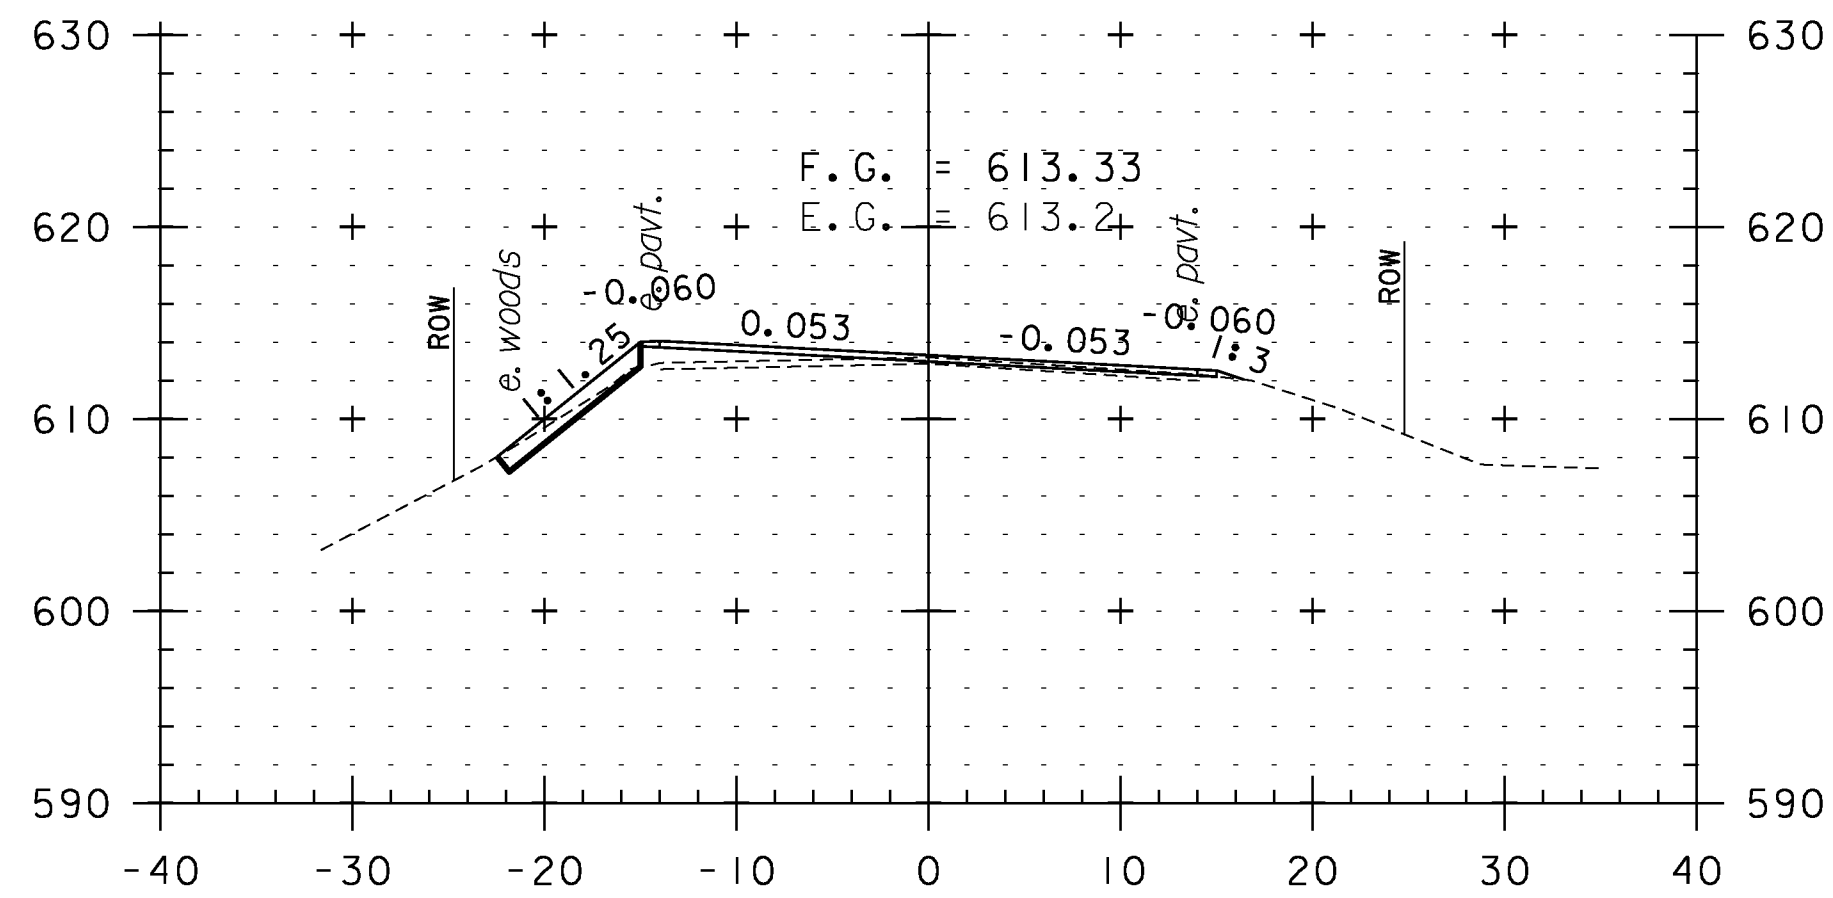


379+50

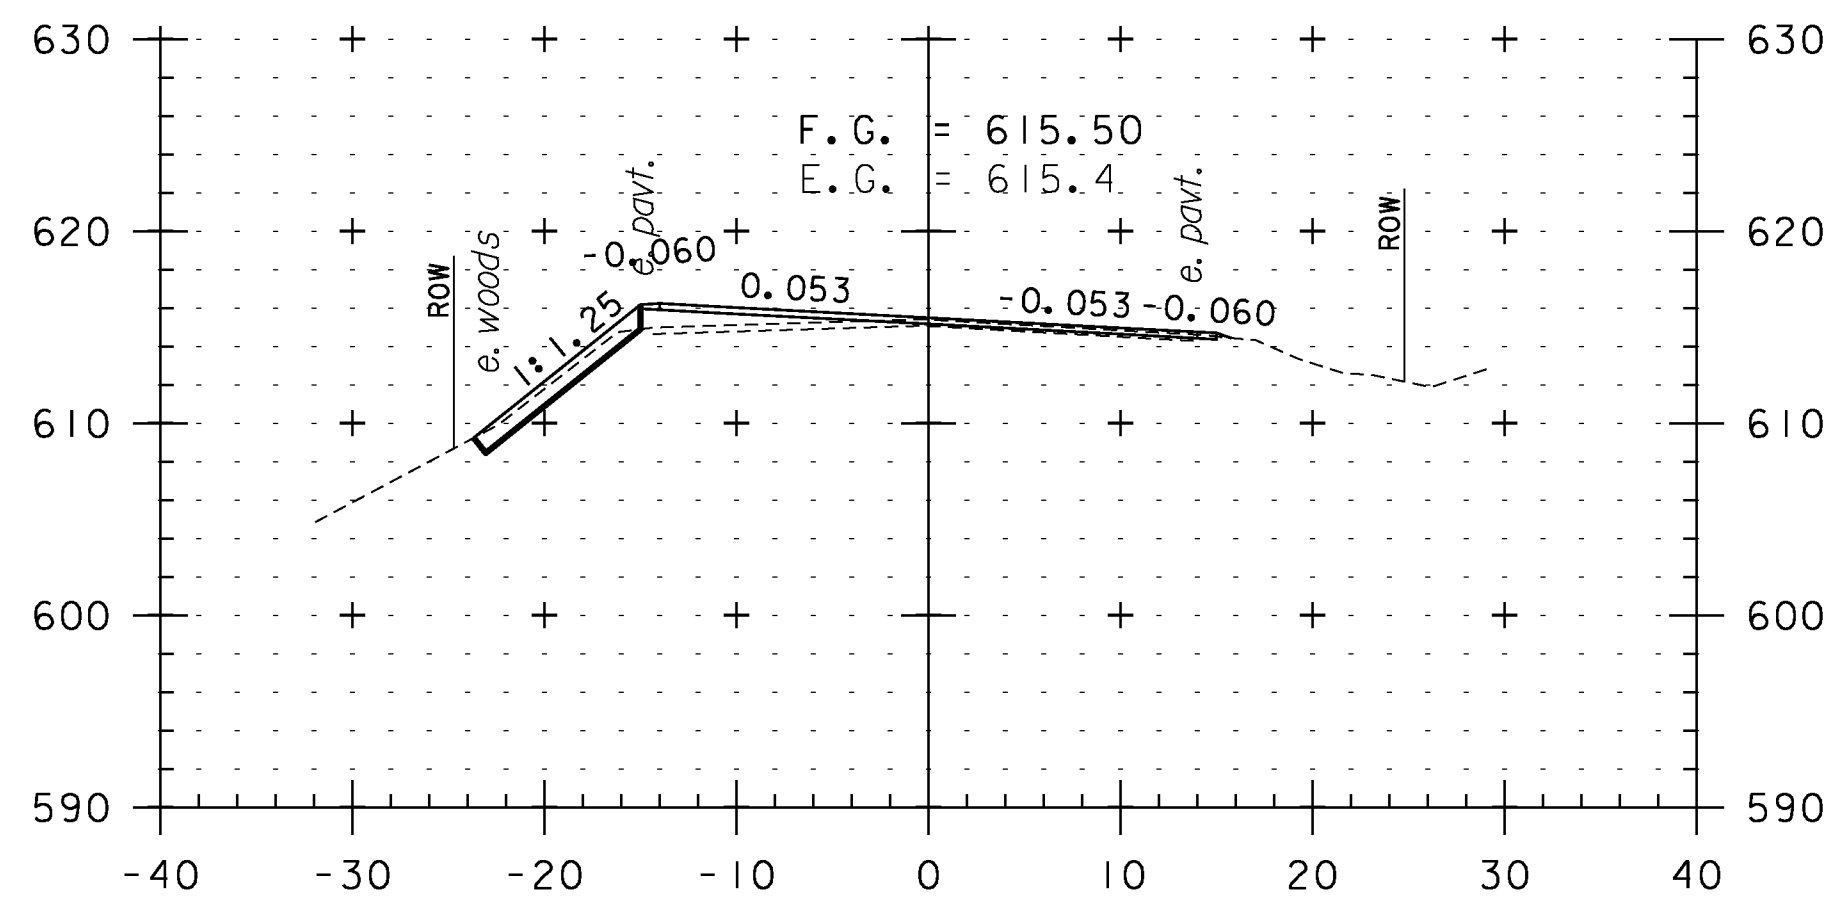


379+00

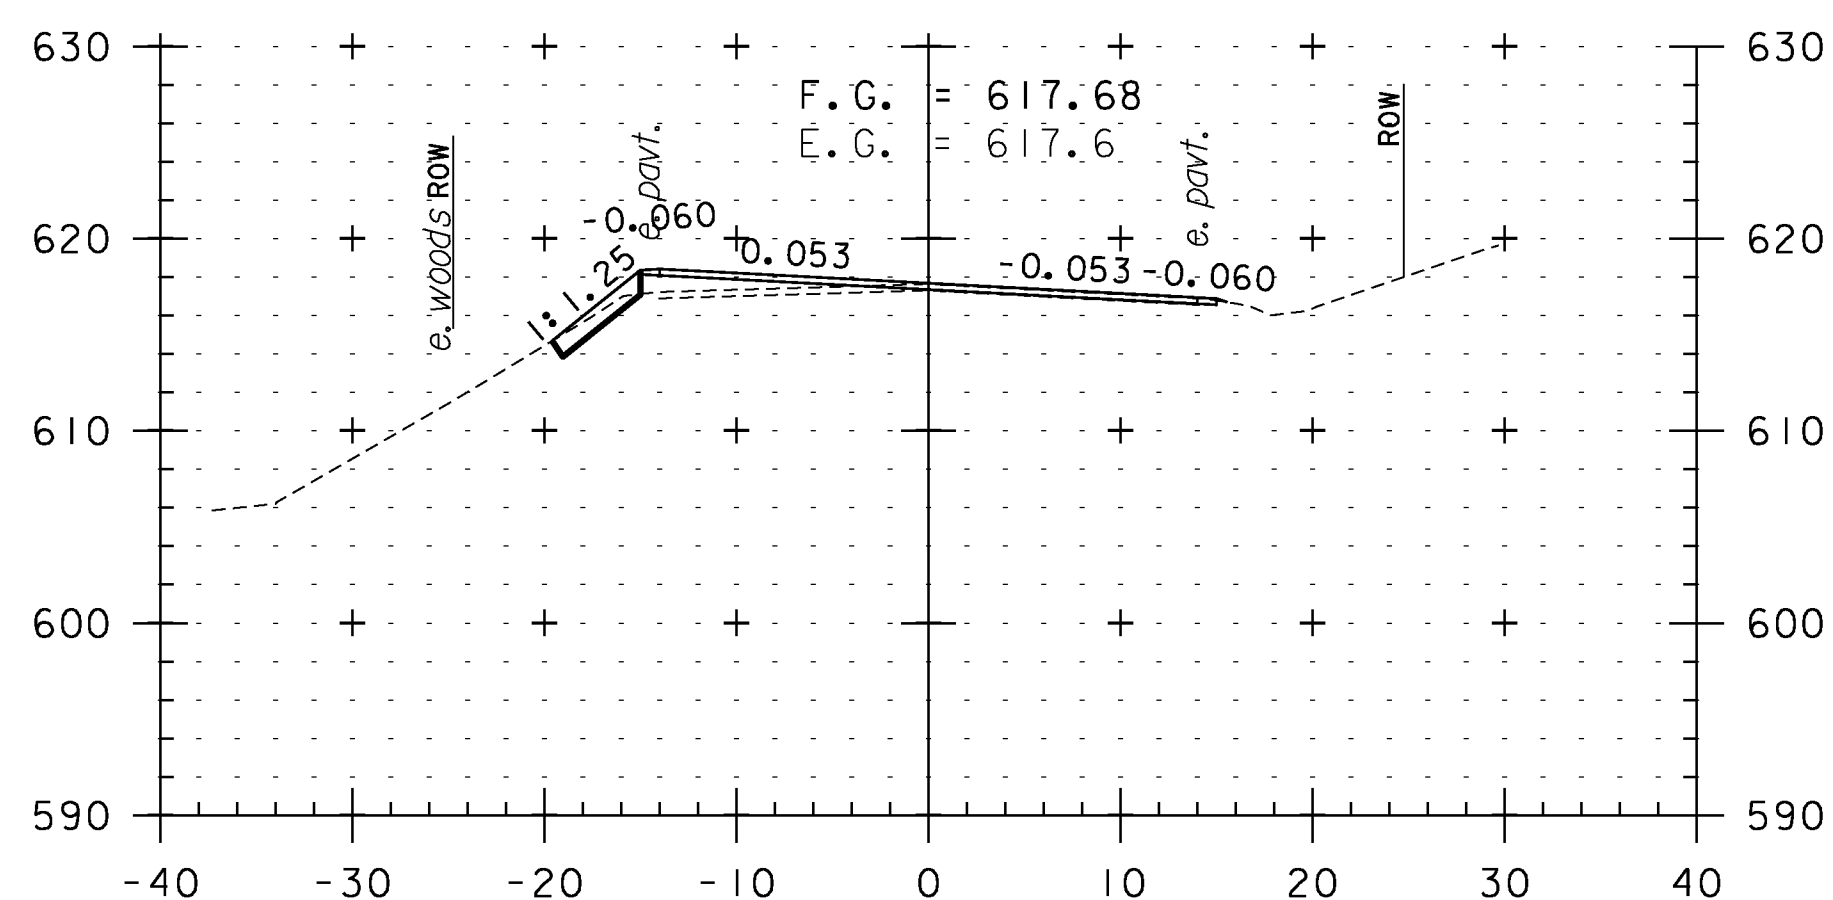


378+50

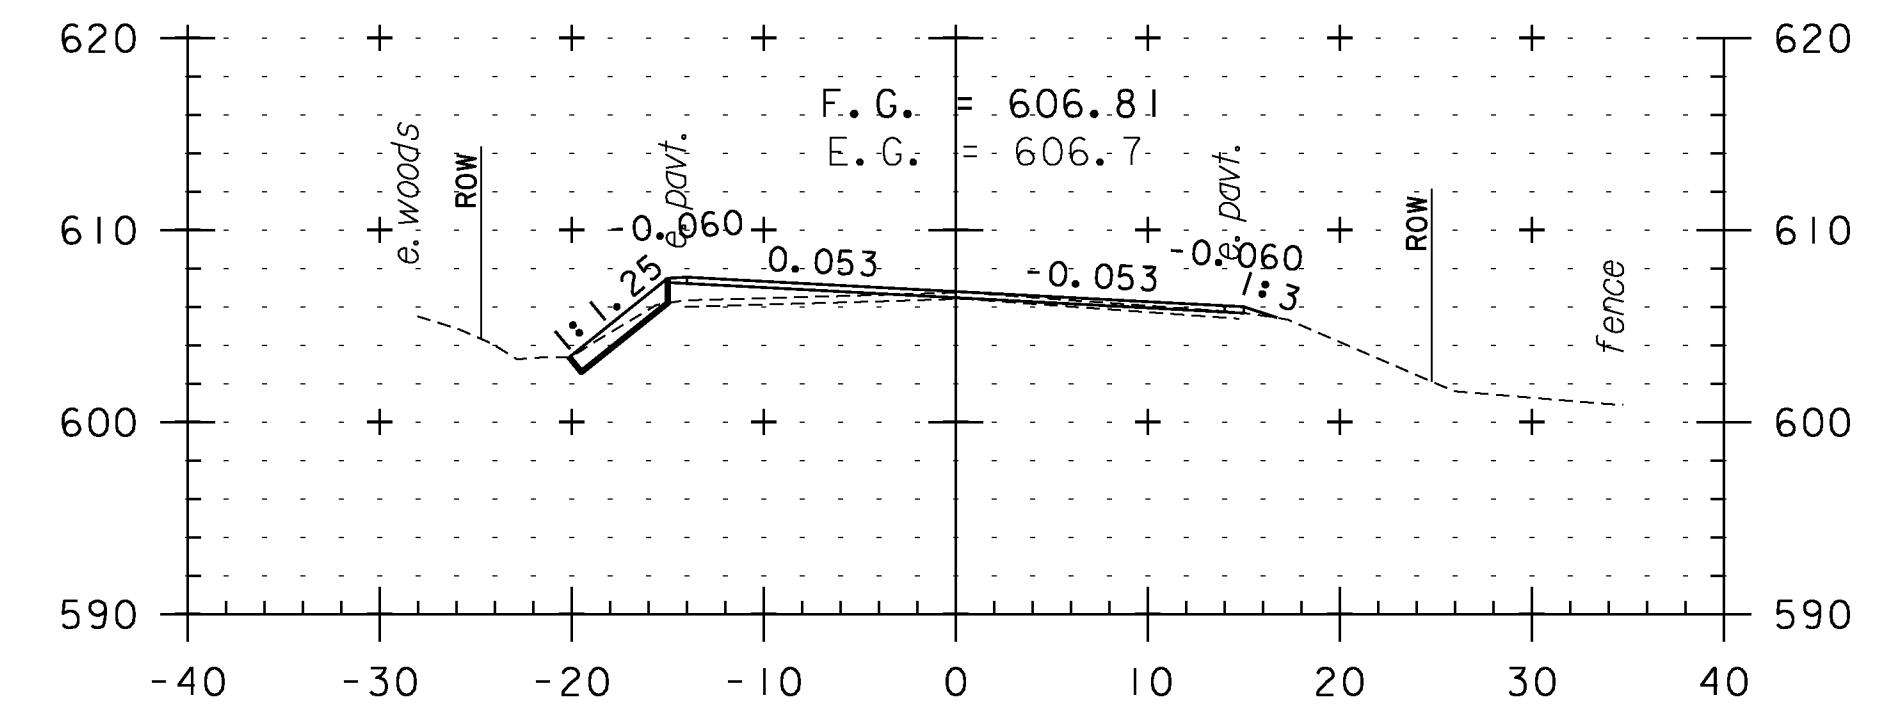

381+00

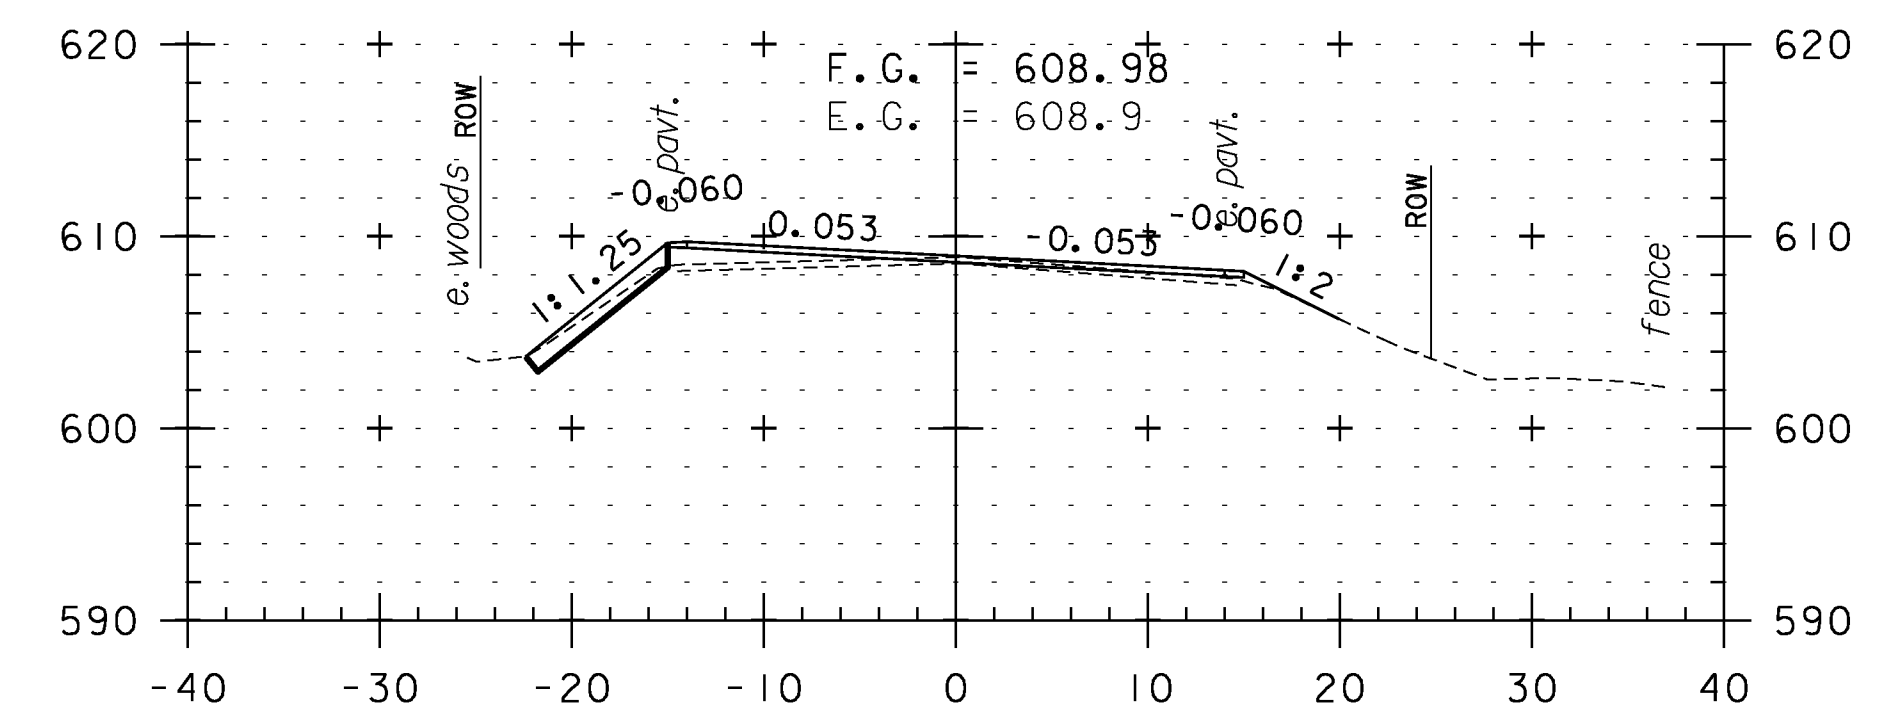

380+50

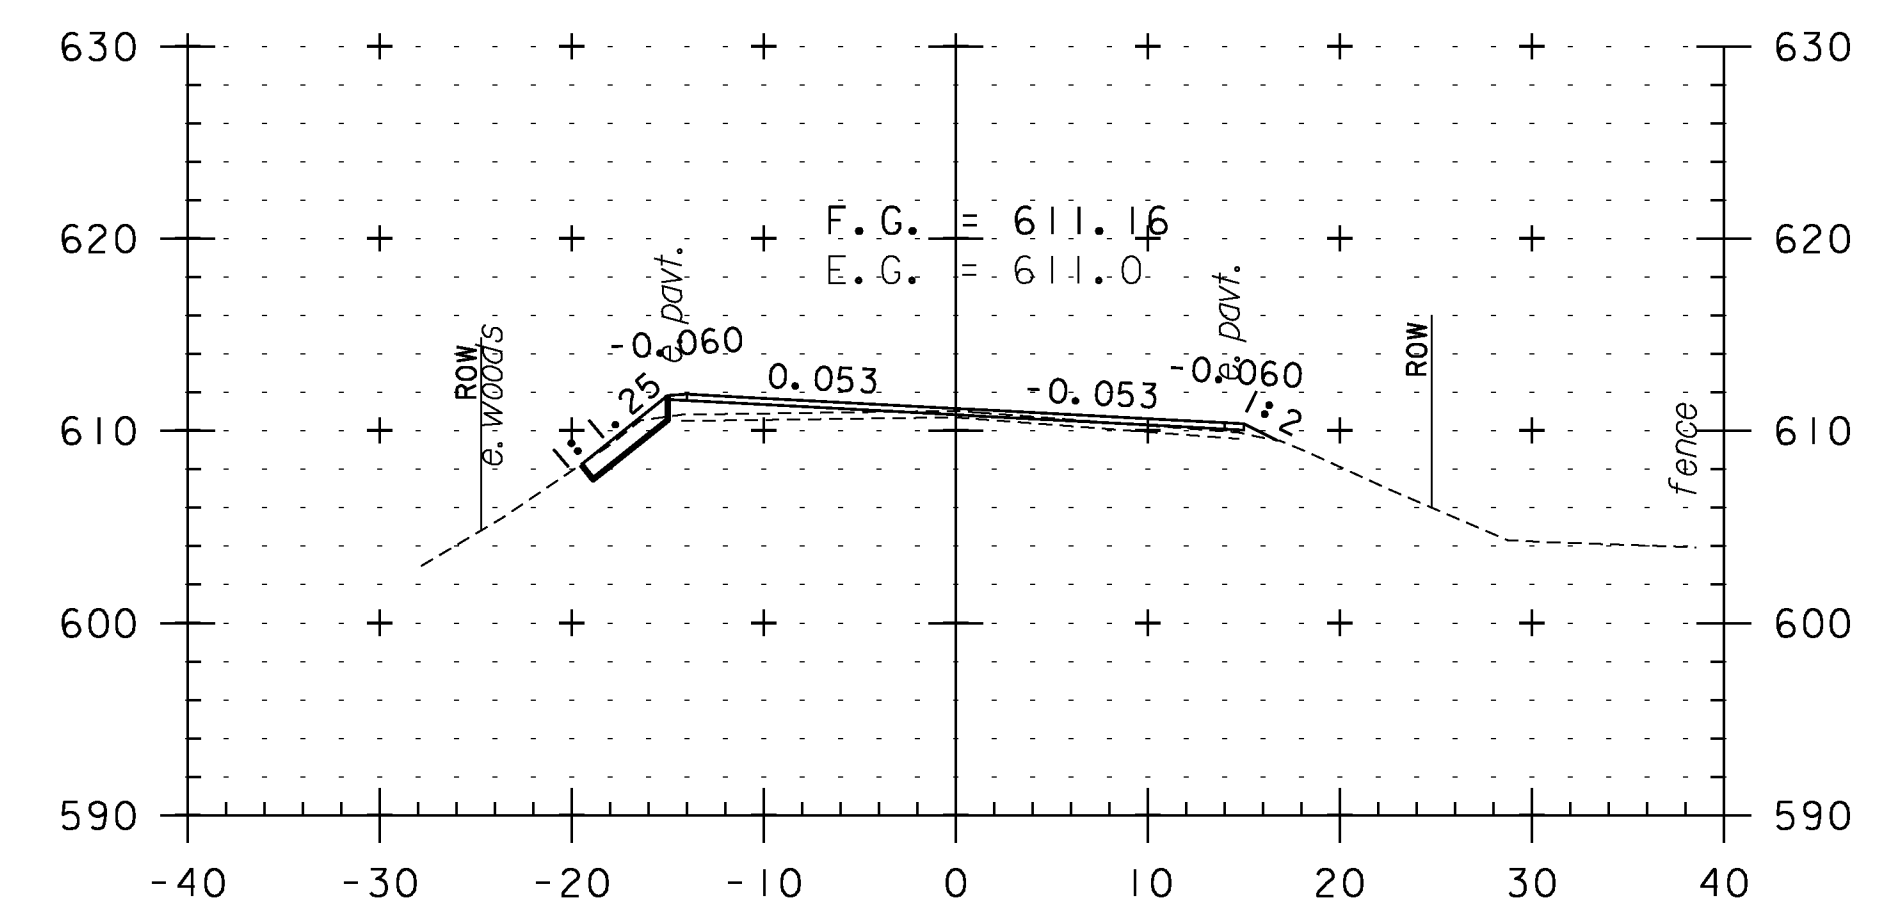

380+00

CROSS SECTION SHEET 74

PROJECT NAME: WEATHERSFIELD

PROJECT NUMBER: STP 2913(I)

FILE NAME: I0c228

PROJECT LEADER: PTS

DESIGNED BY: NLL


IPARM FILE NAME: pI0c228_I64

PLOT DATE: 2/7/2013

DRAWN BY: WWG

CHECKED BY: PTS

SHEET 164 OF 234

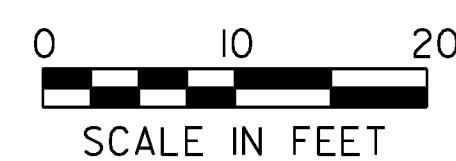

STA. 377+50 TO STA. 381+00