




402+50

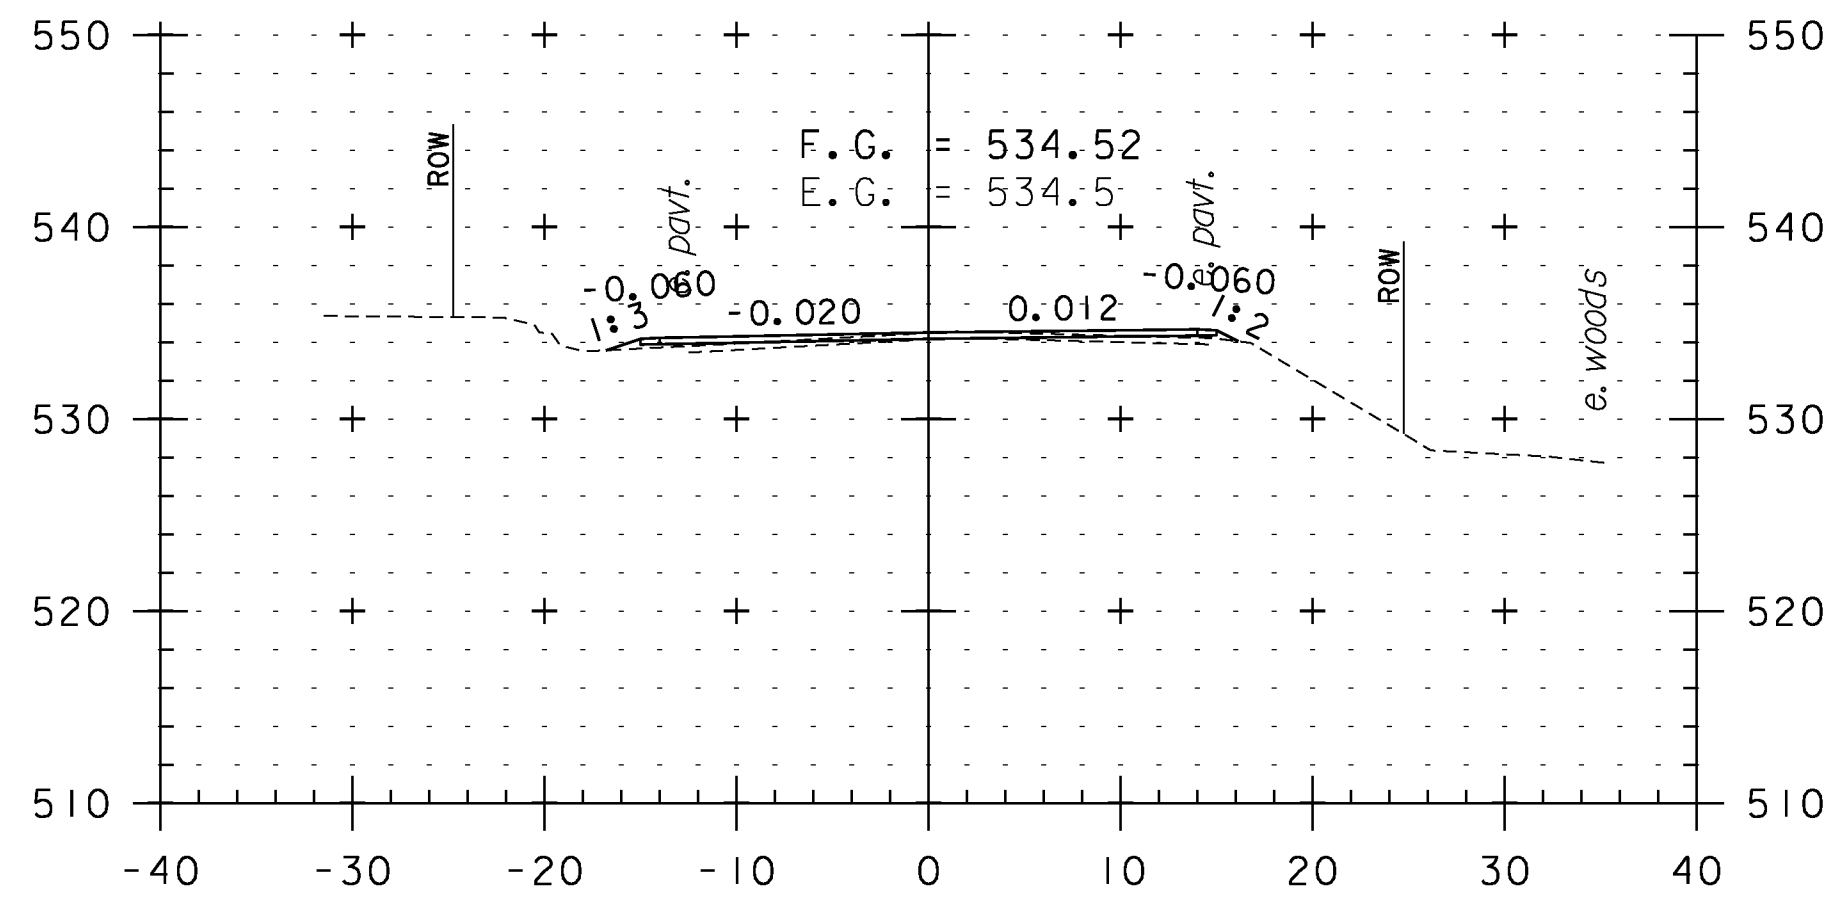


404+00

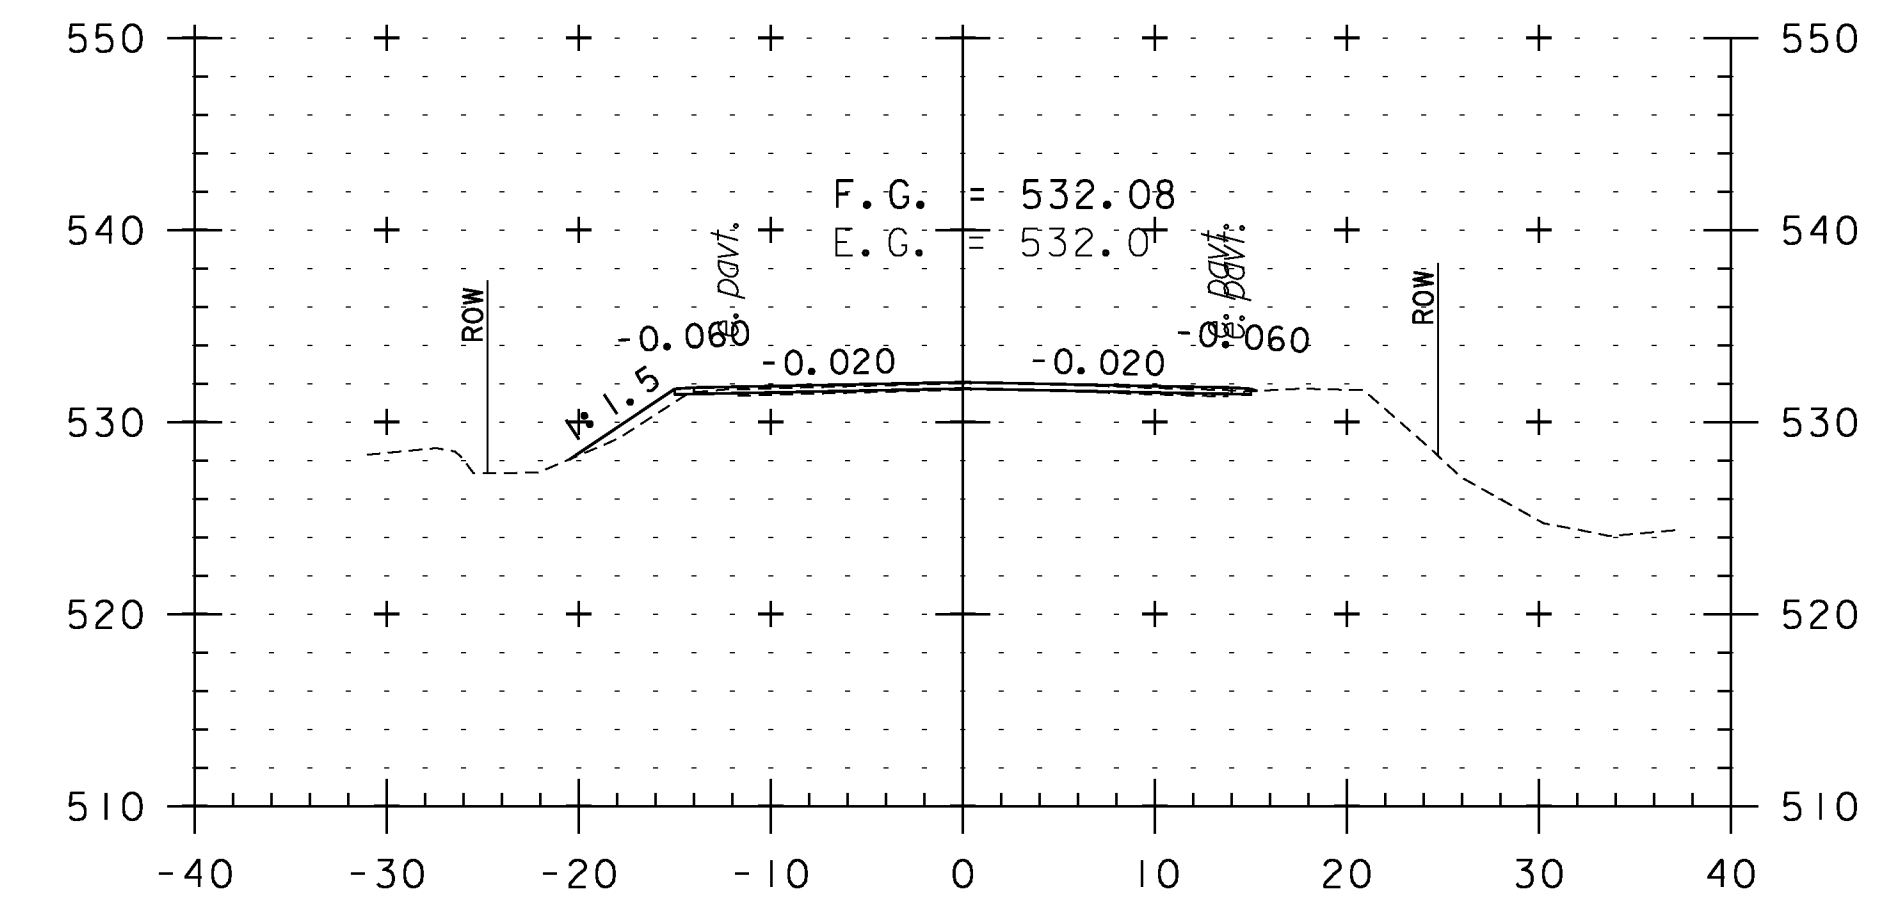


405+00

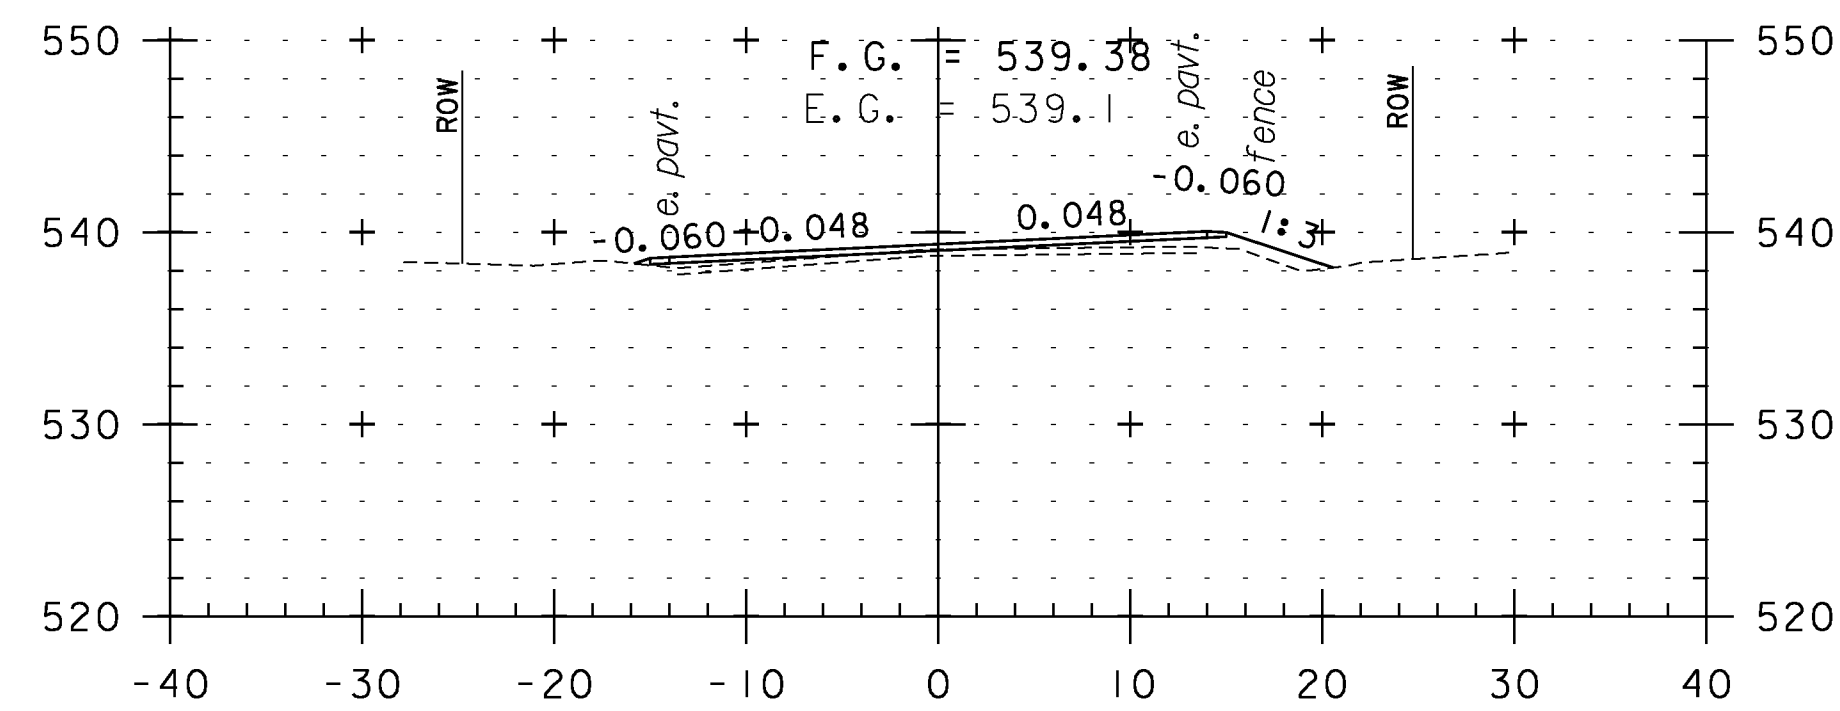


402+00

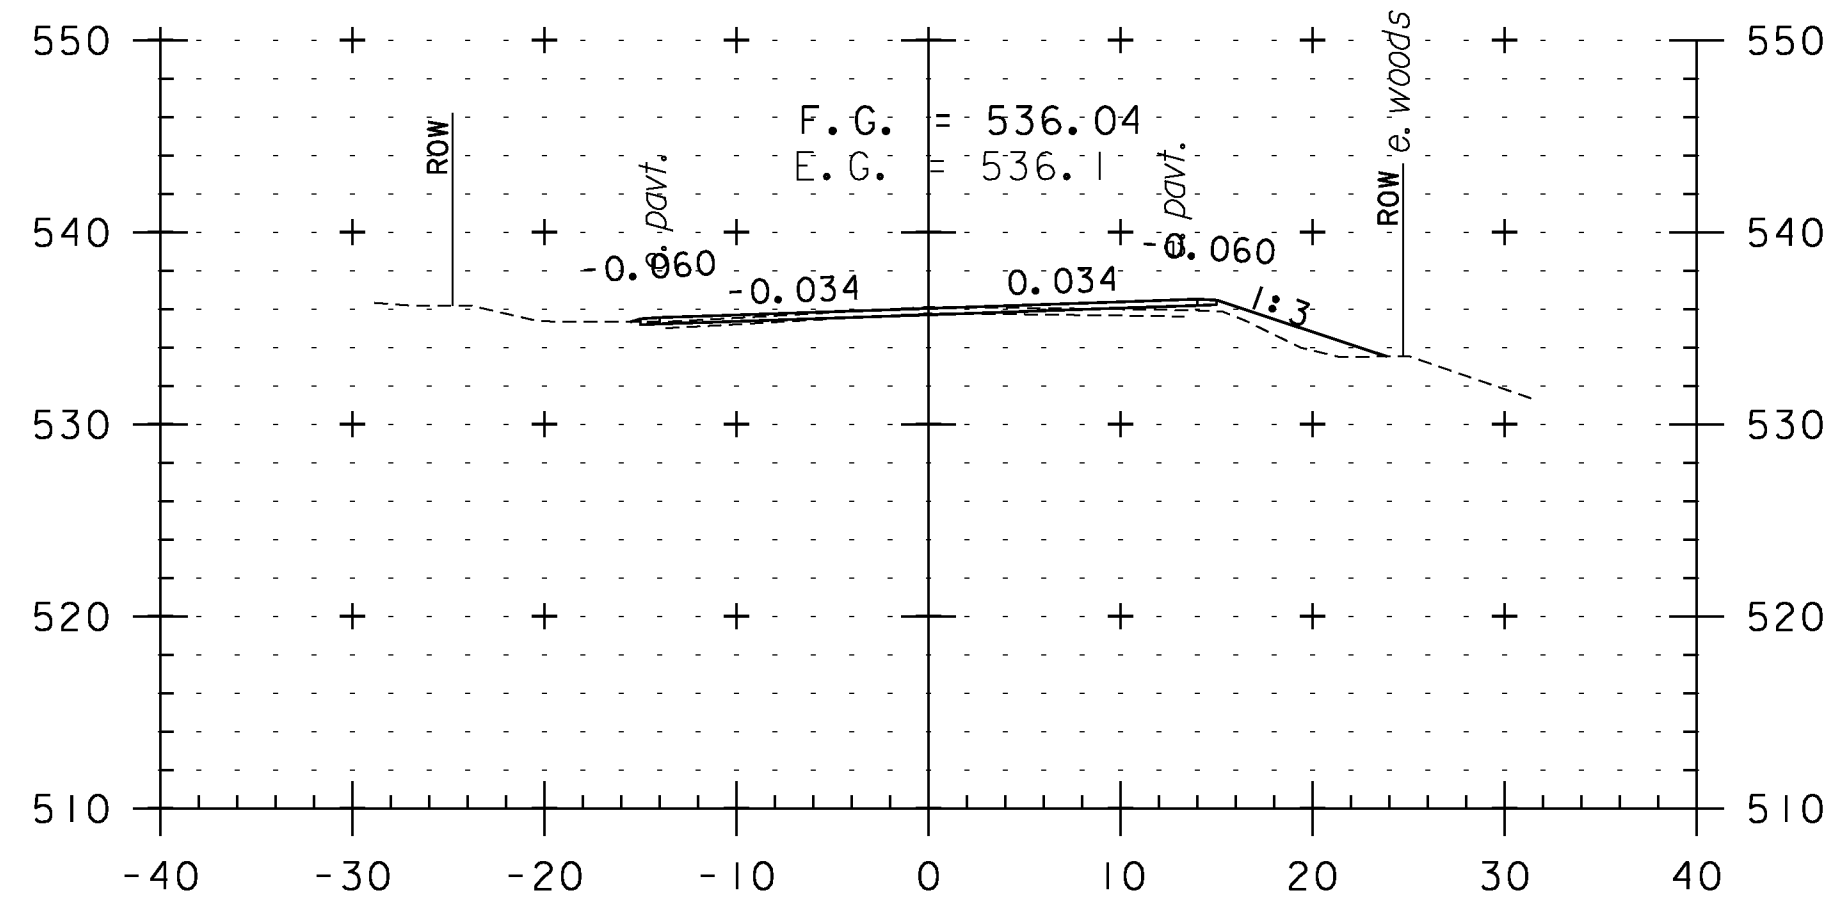


403+50

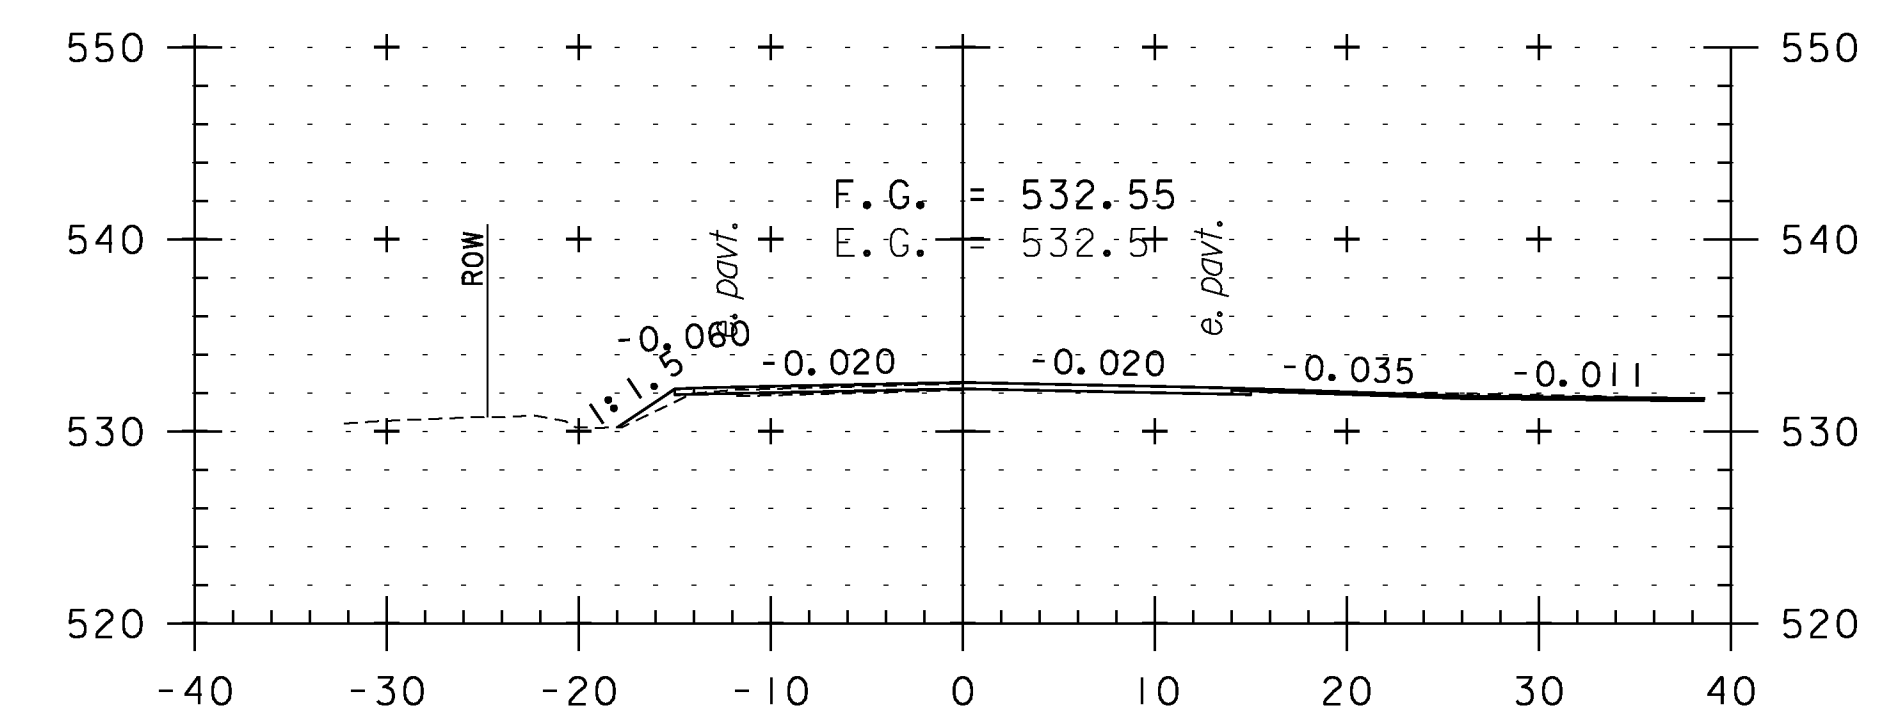


404+70
TH 46

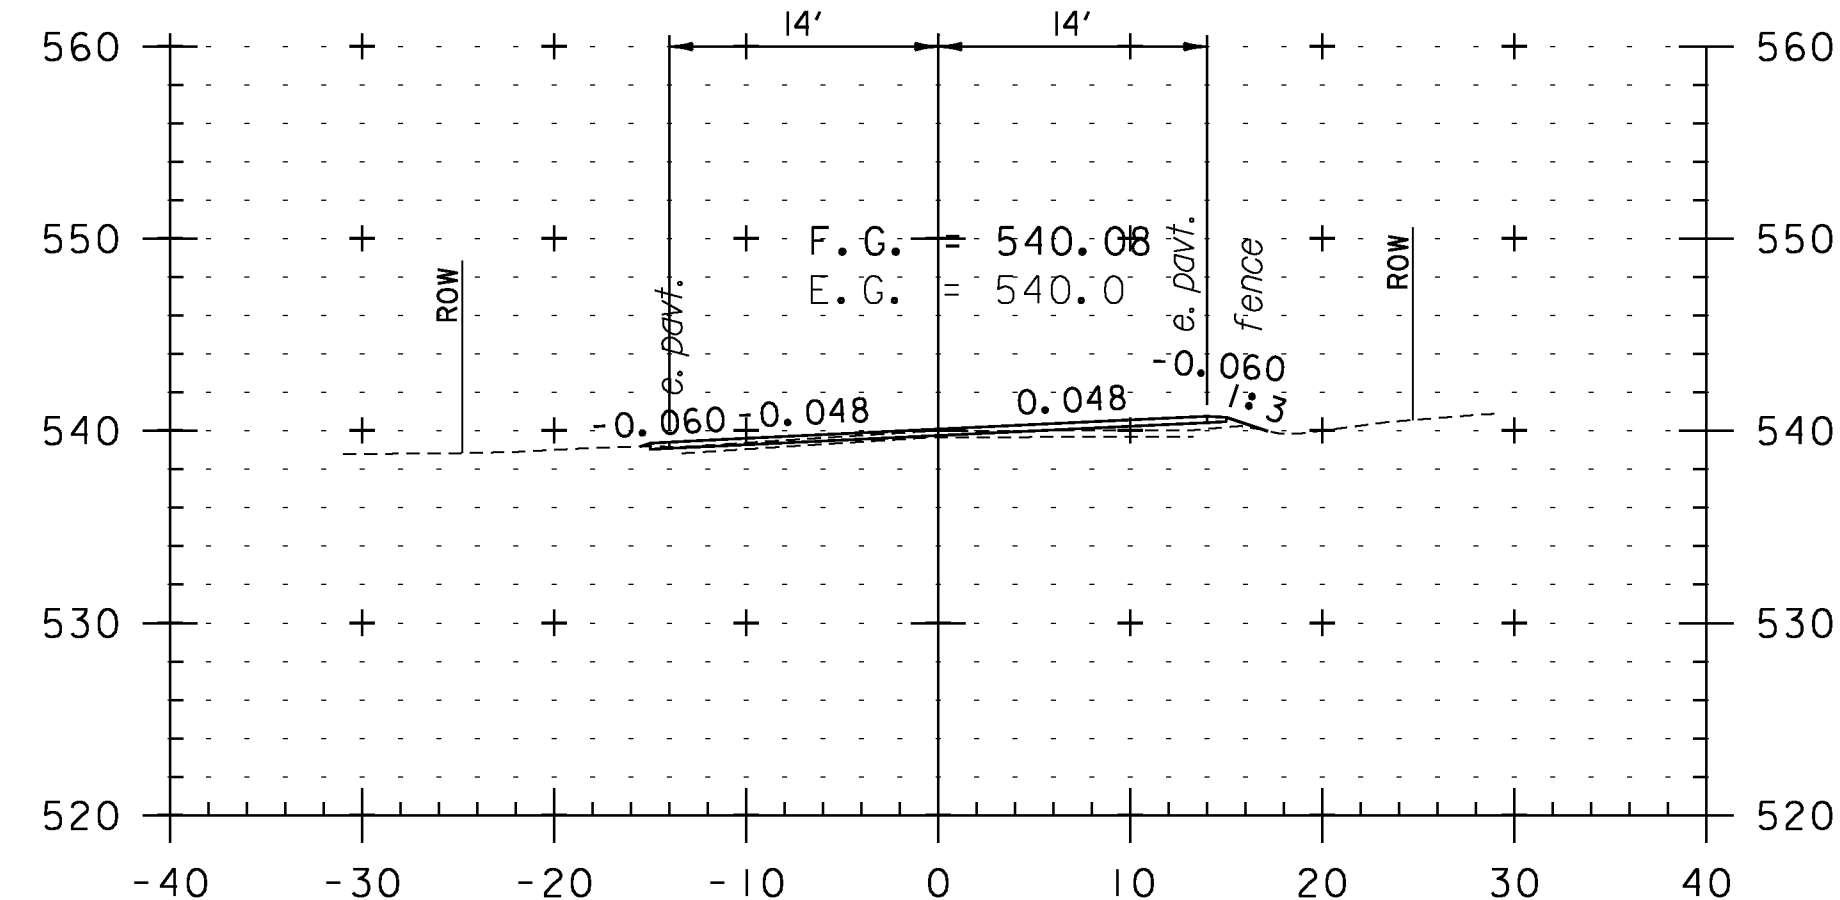

401+50

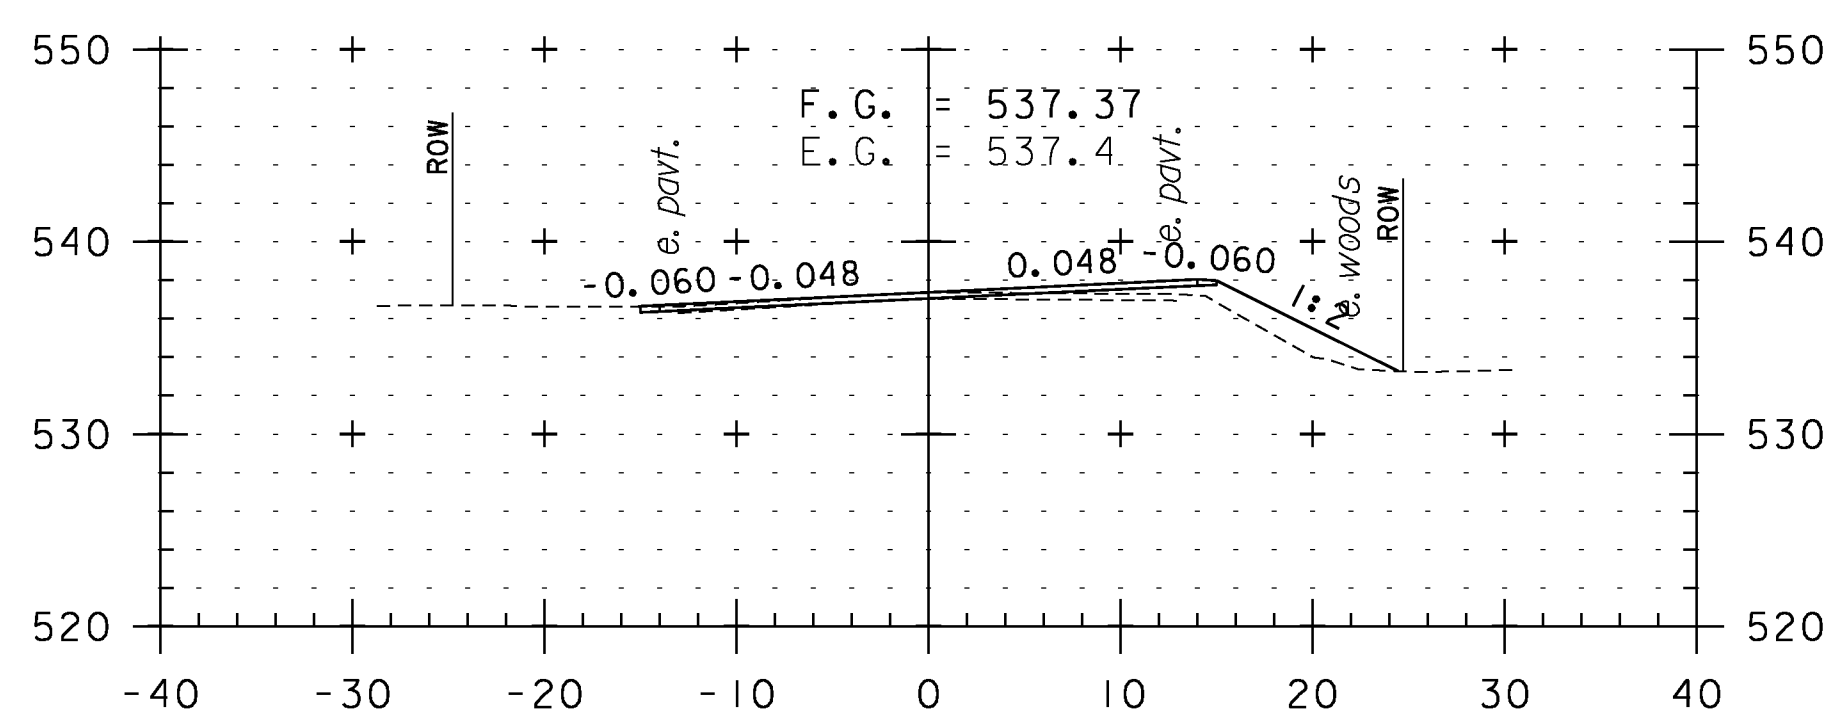

403+00

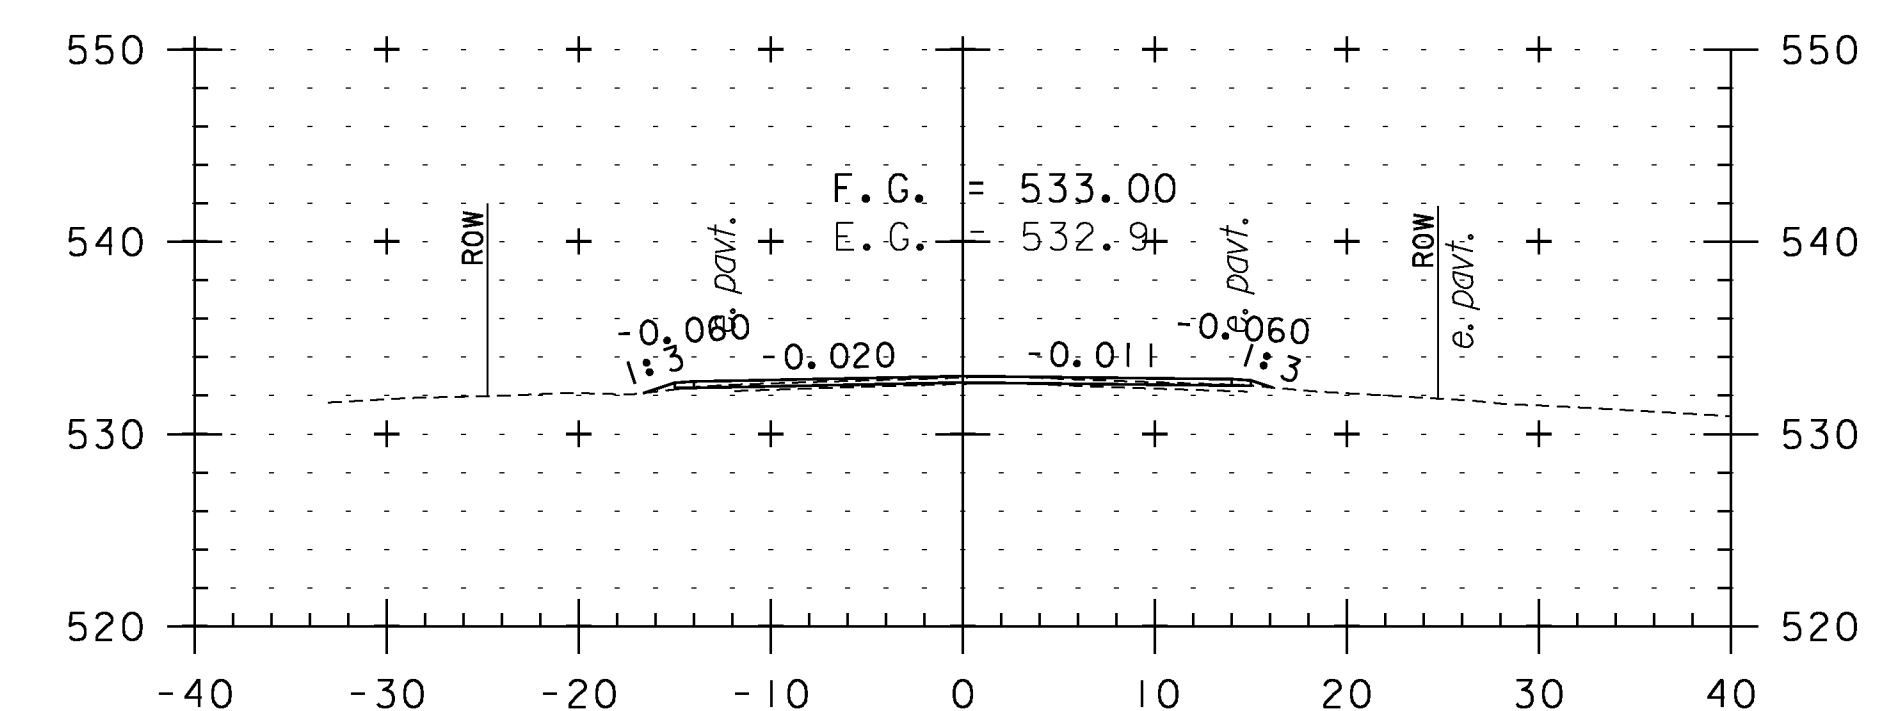

404+50

CROSS SECTION SHEET 80

PROJECT NAME: WEATHERSFIELD

PROJECT NUMBER: STP 2913(I)

FILE NAME: I0c228

PROJECT LEADER: PTS

DESIGNED BY: NLL


IPARM FILE NAME: pI0c228.I70

PLOT DATE: 2/7/2013

DRAWN BY: WWG

CHECKED BY: PTS

SHEET 170 OF 234

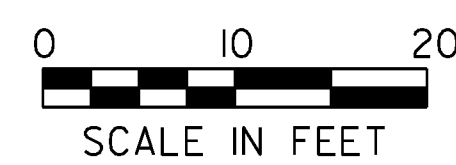

STA. 401+50 TO STA. 405+00