




406+50

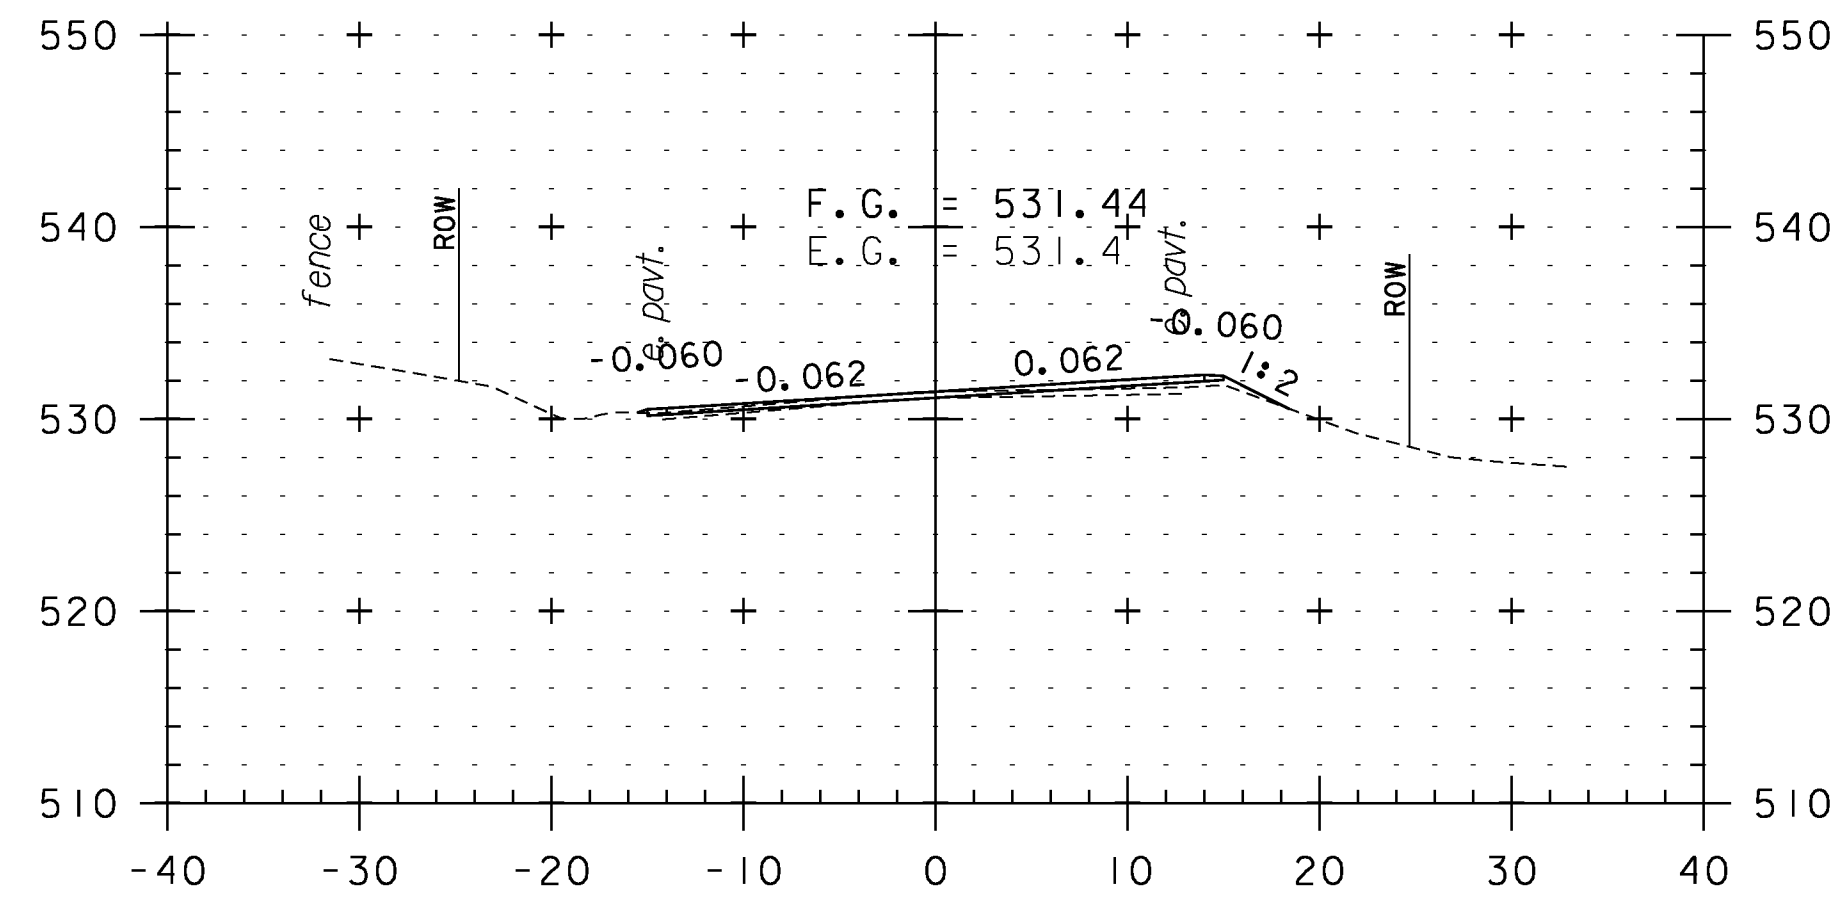


408+00

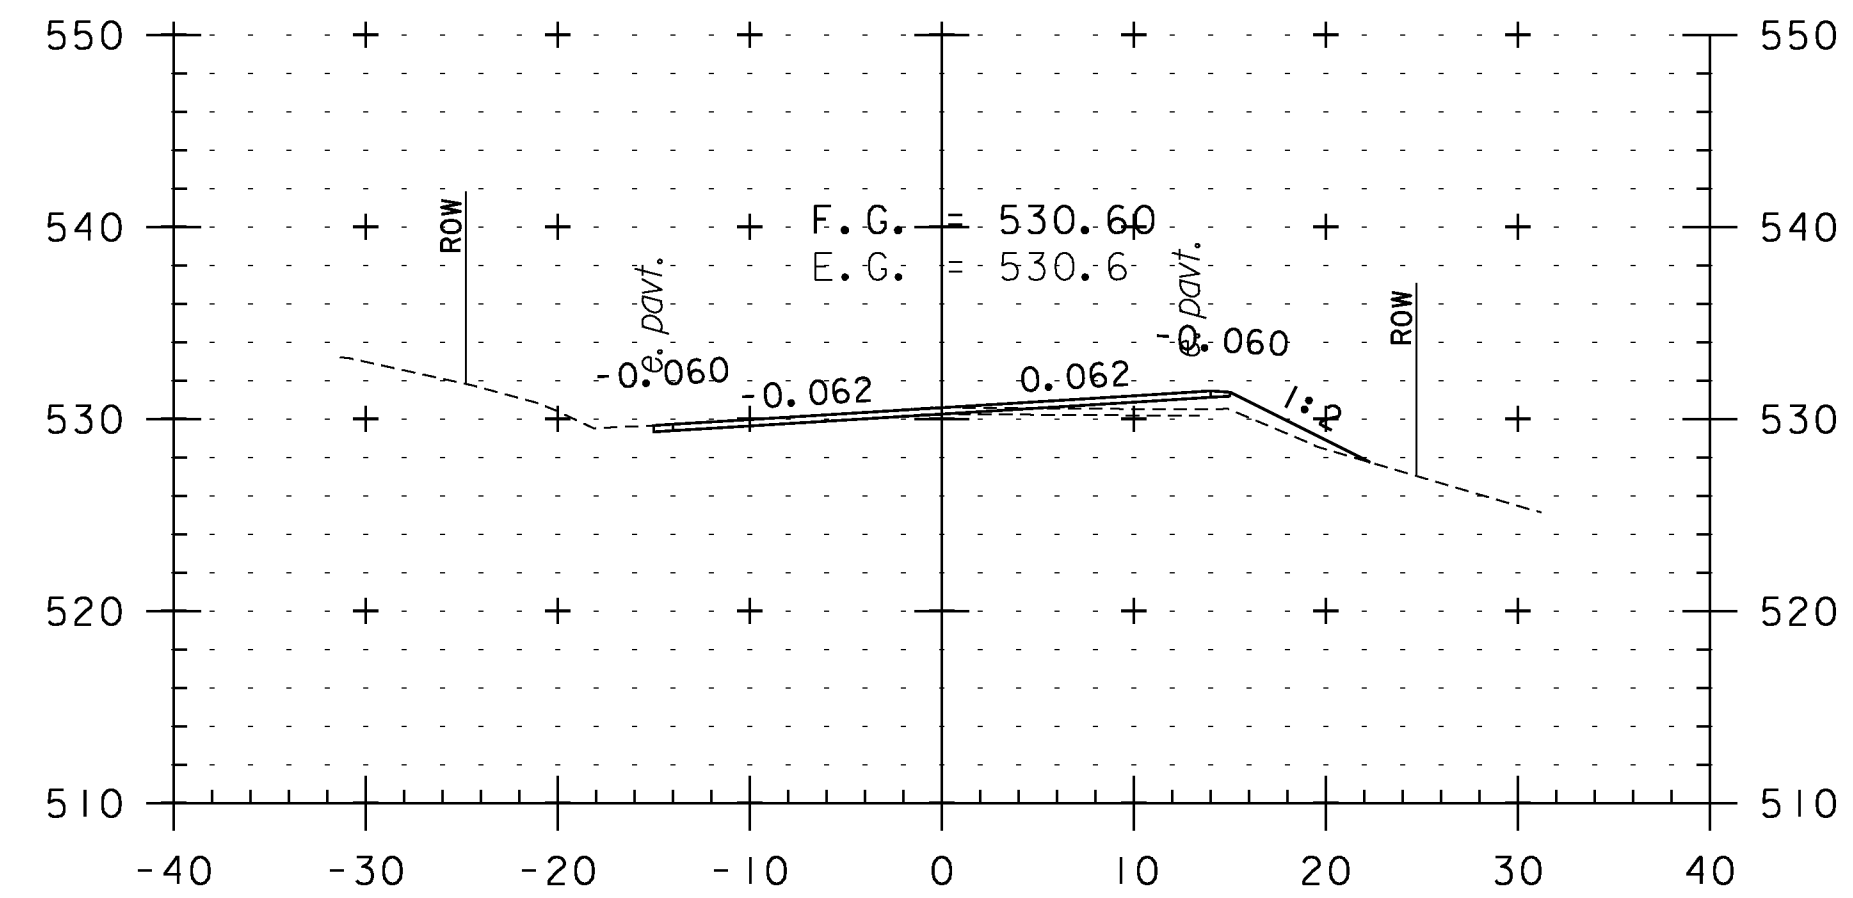


409+50

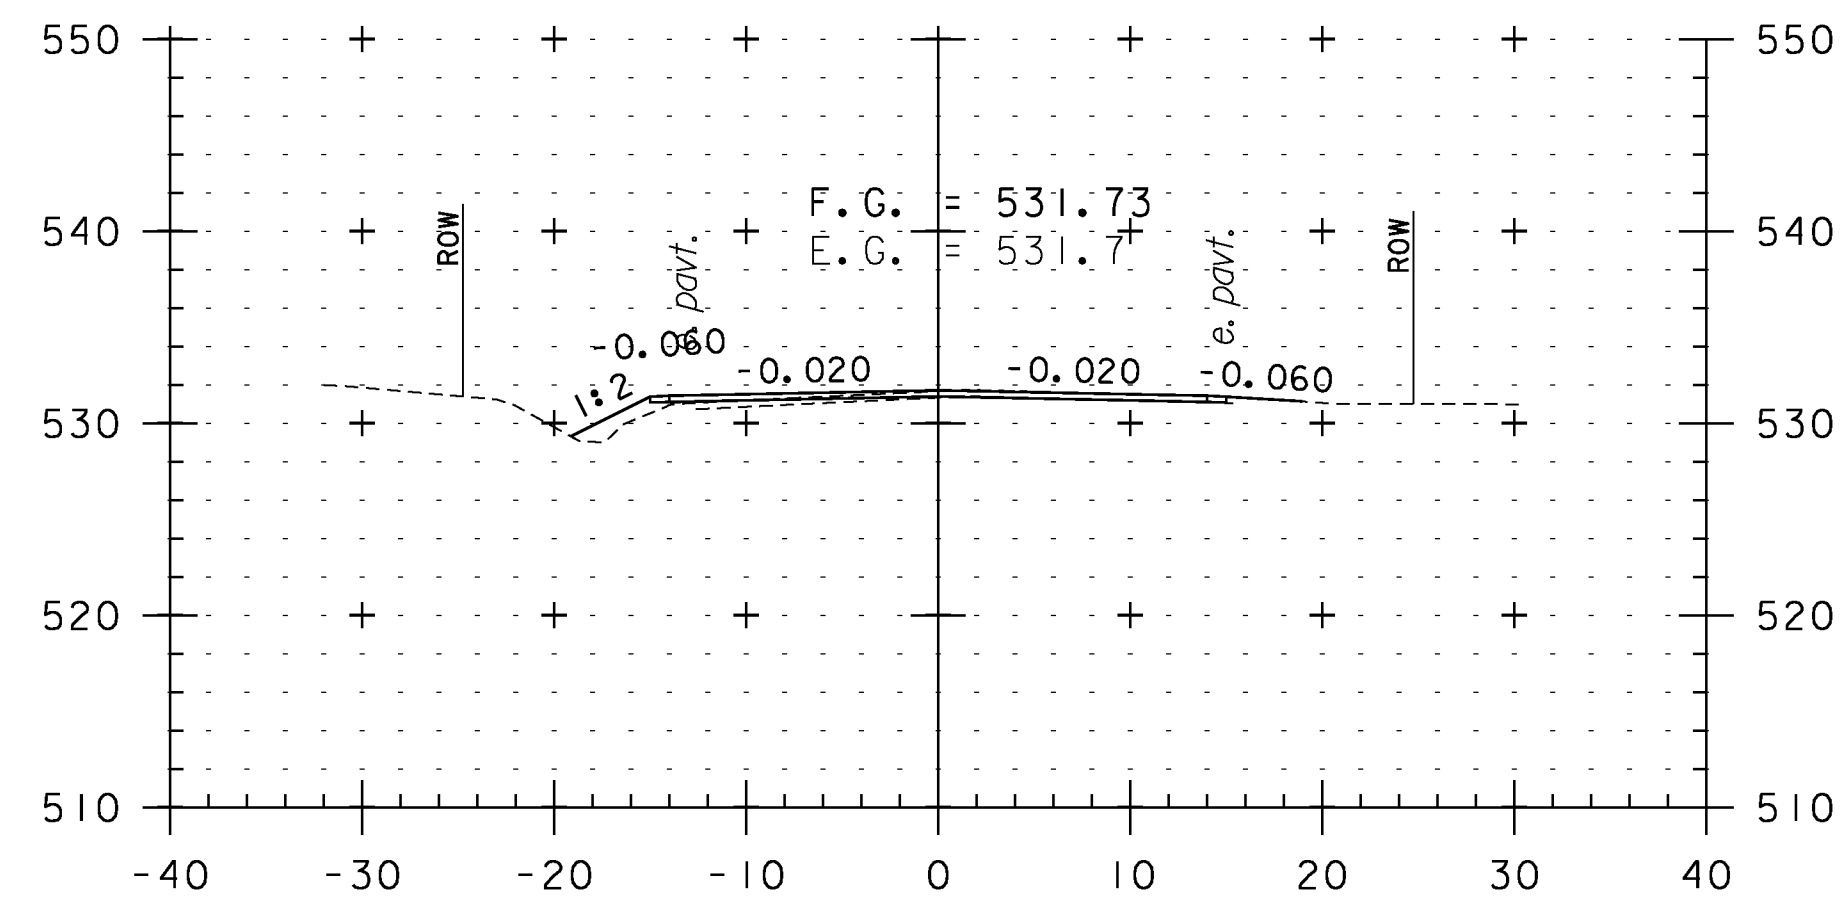


406+00

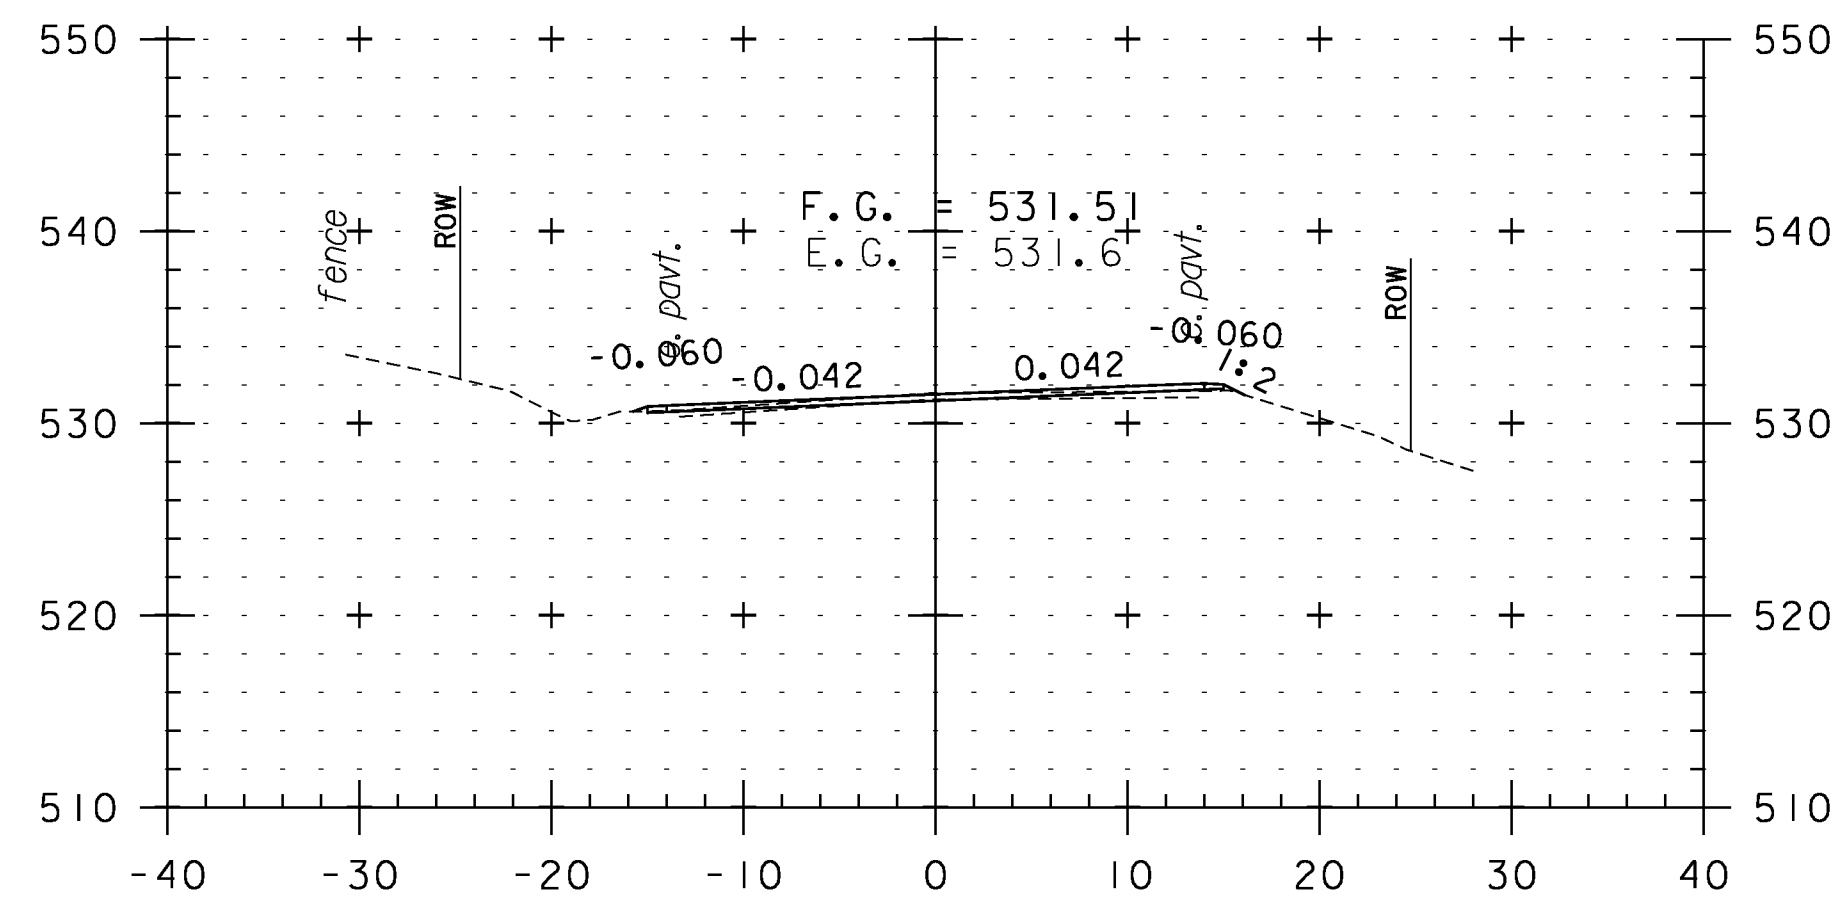


407+50

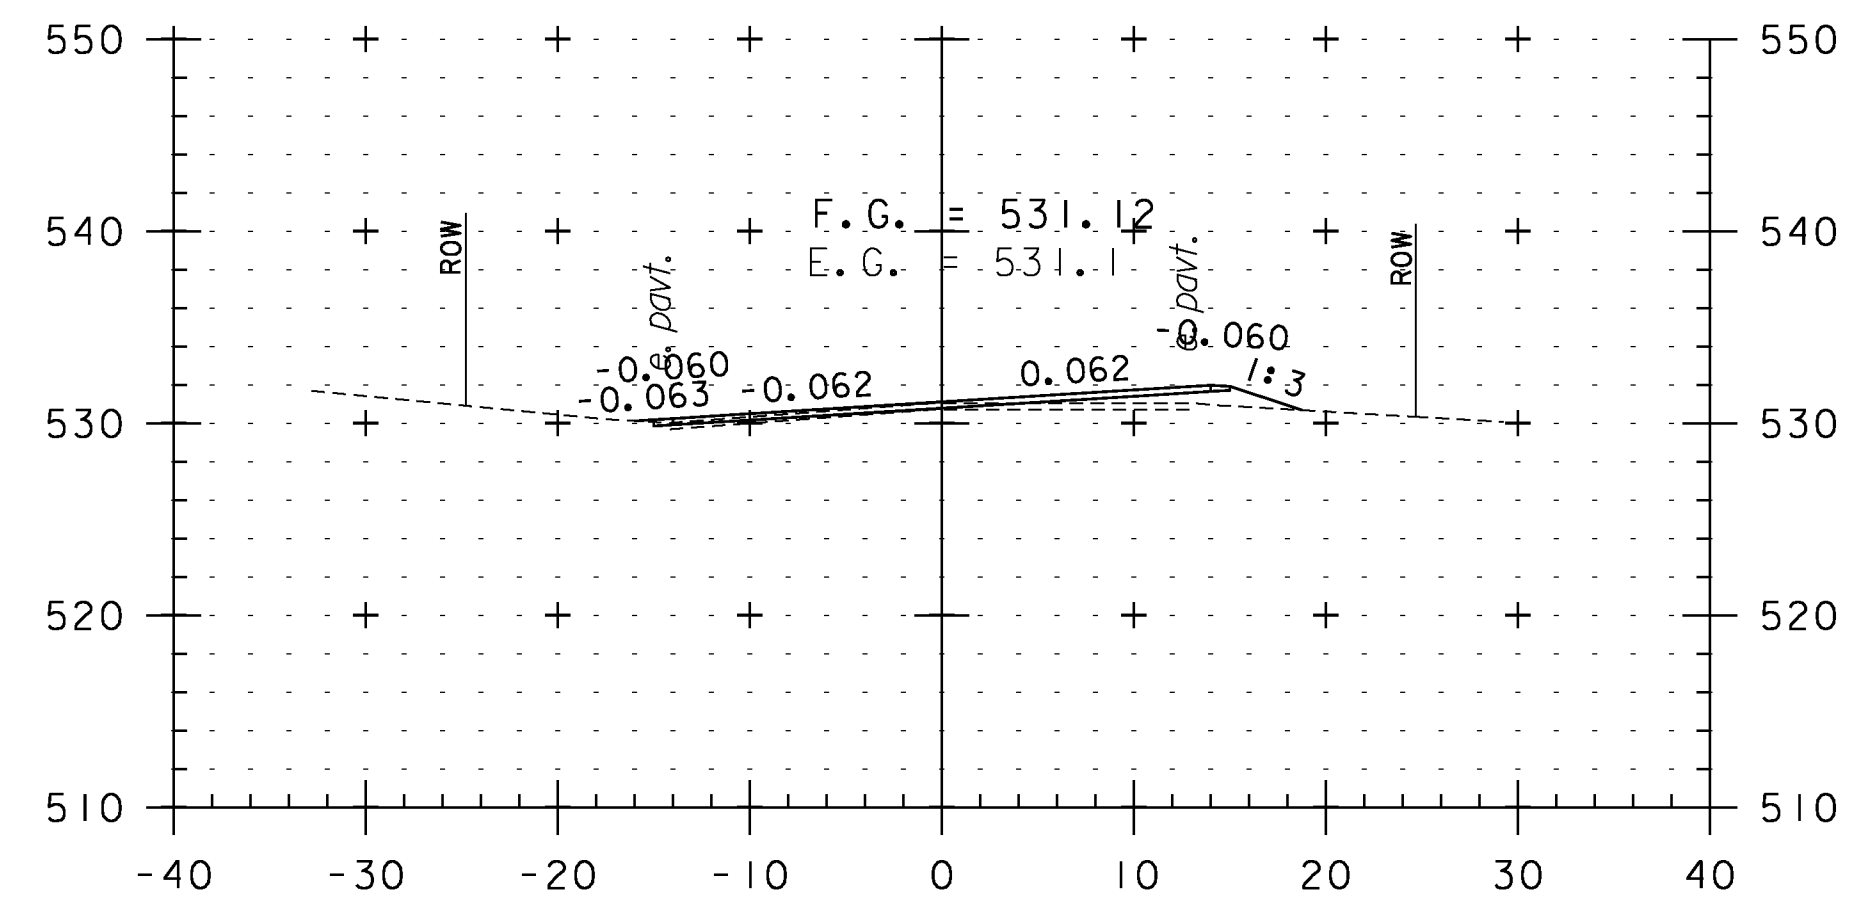


409+00

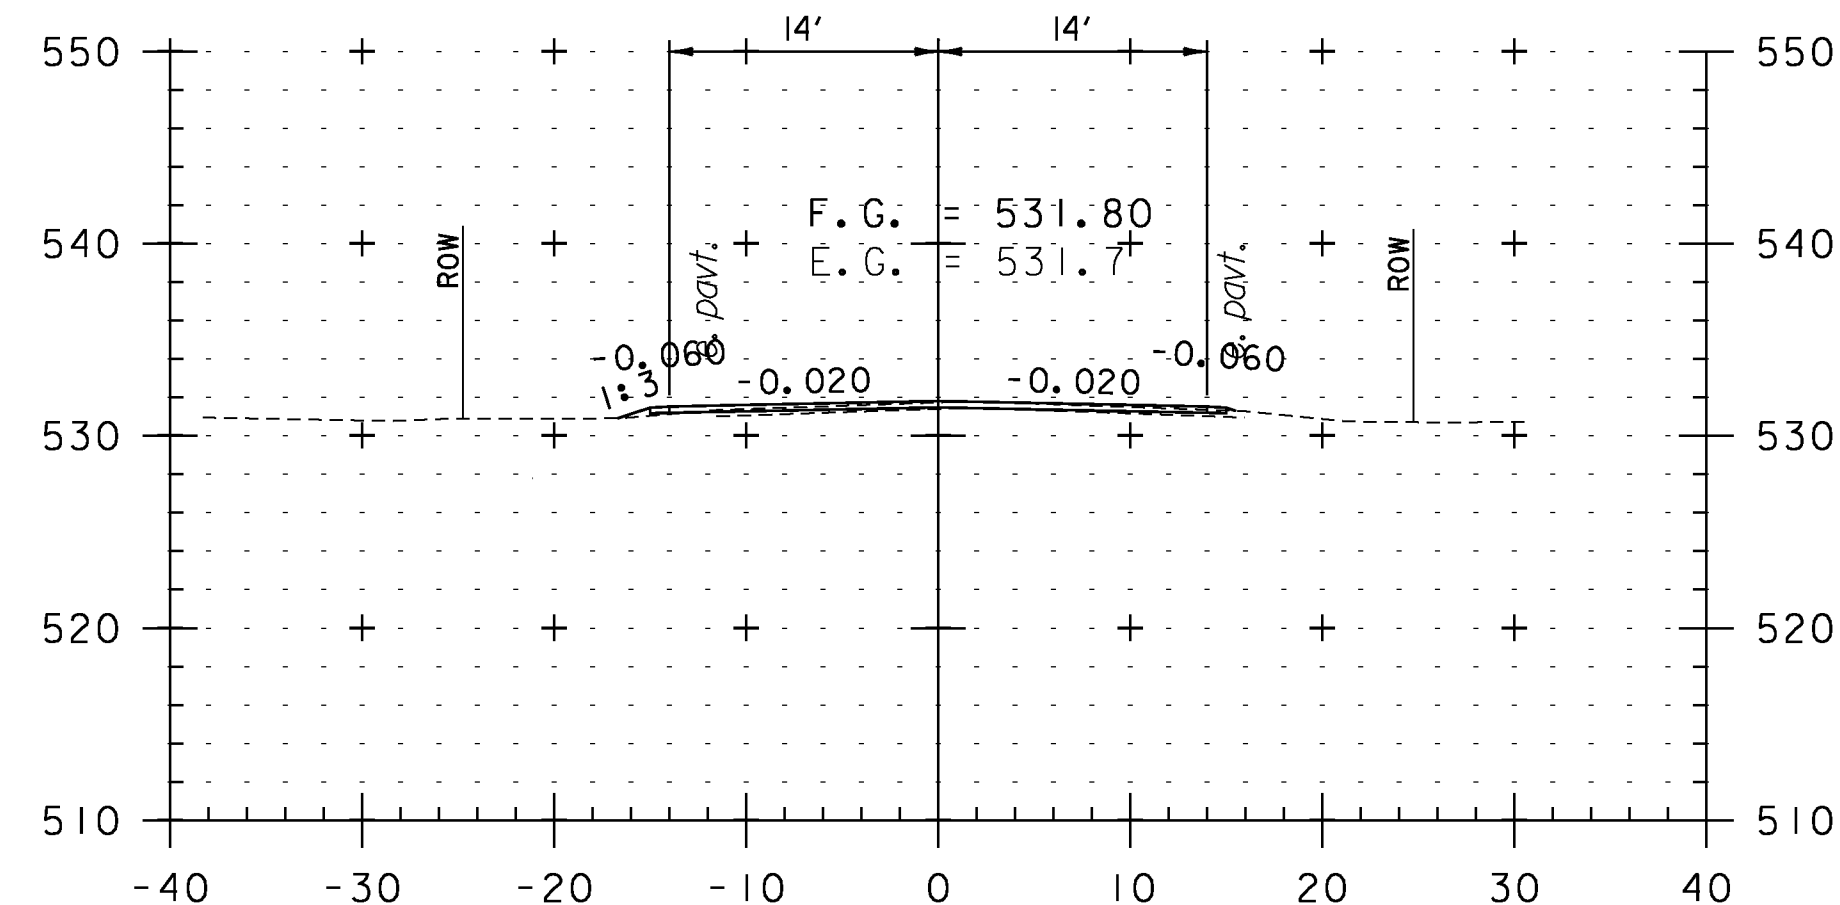

405+50

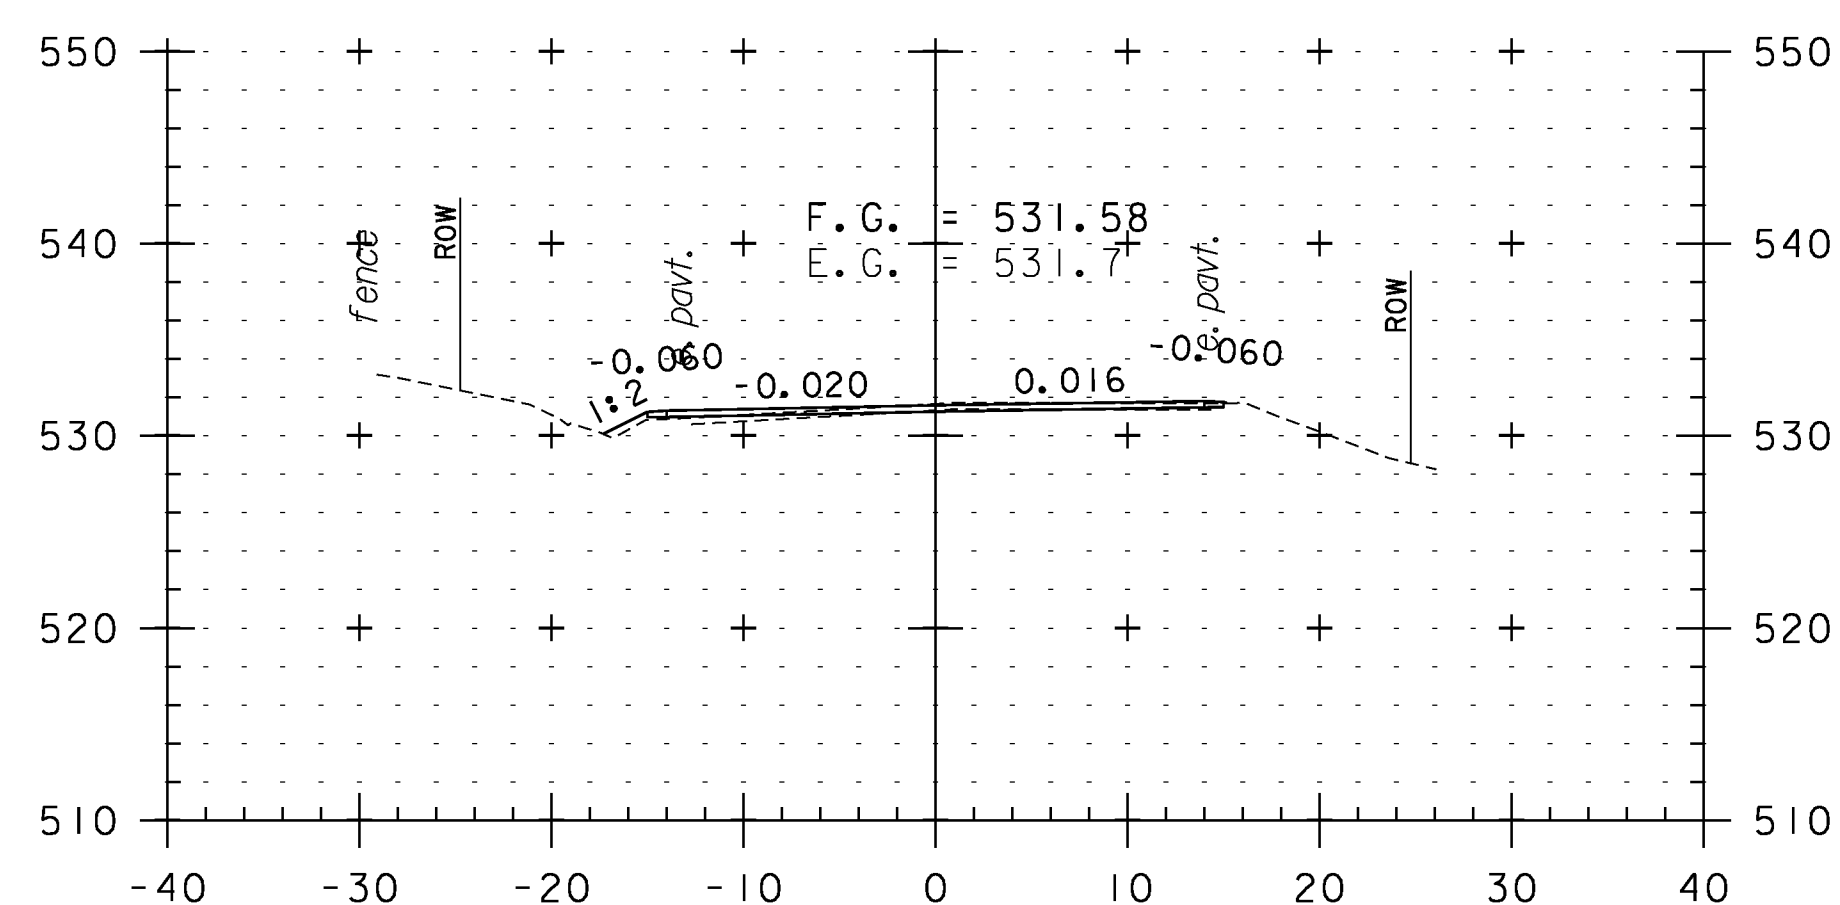


407+00

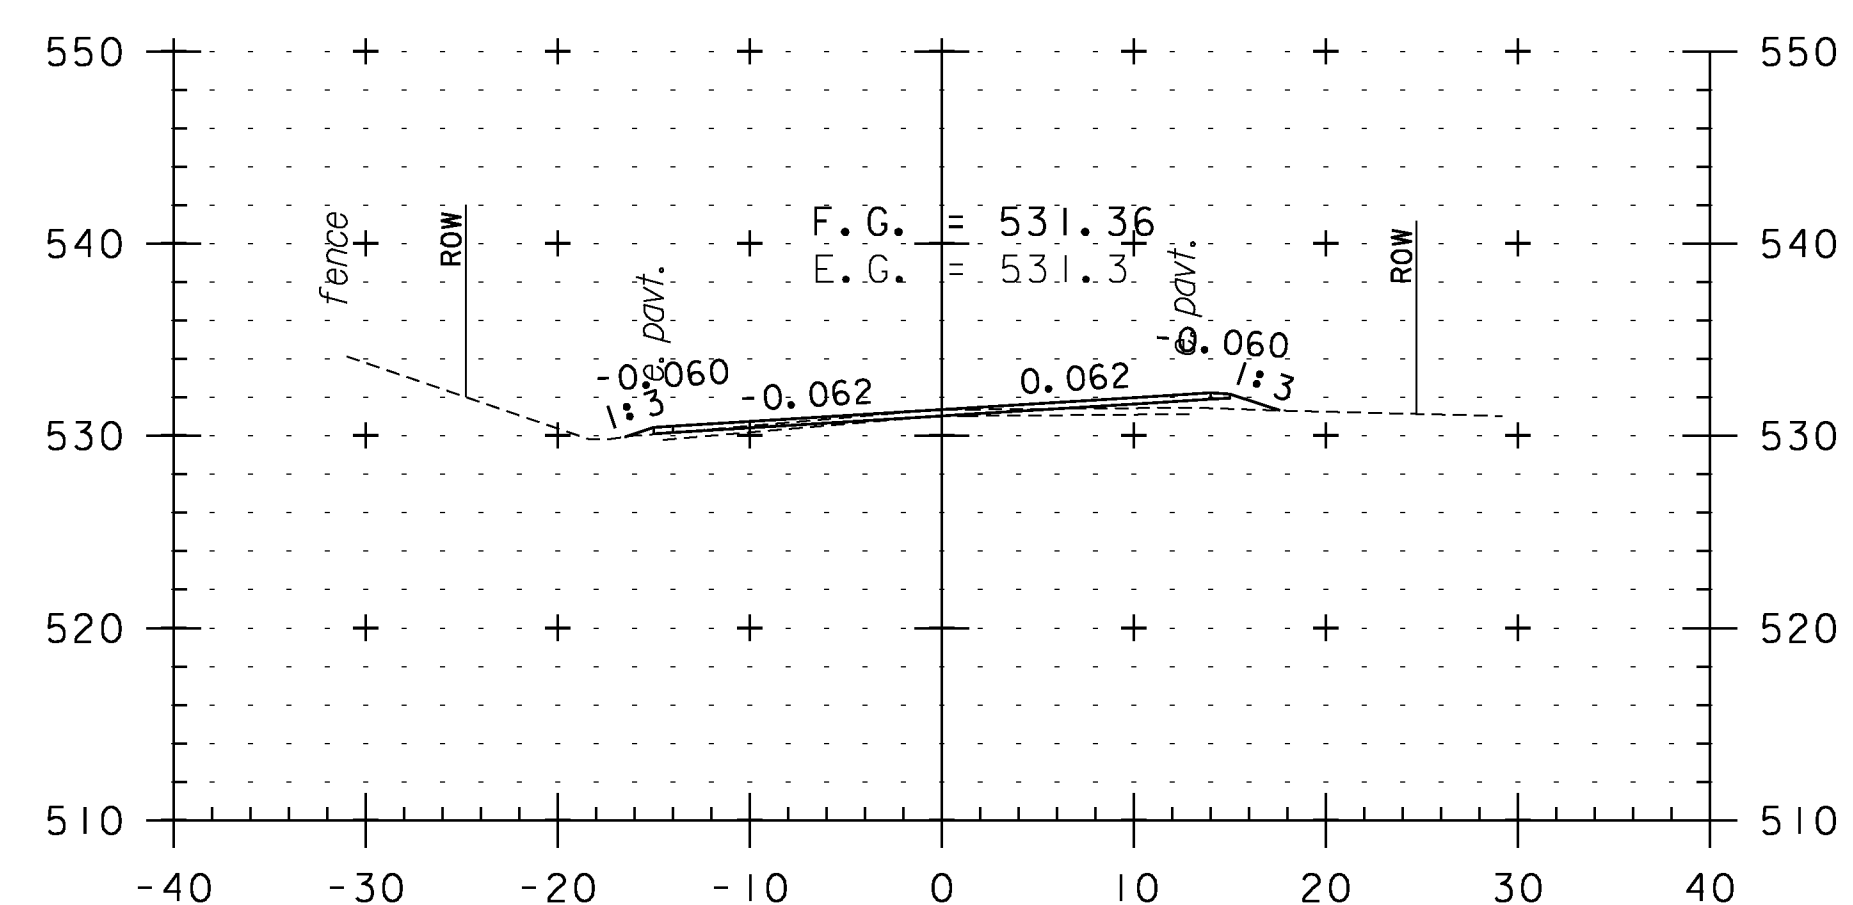

408+50

**CROSS SECTION SHEET 81**

PROJECT NAME:	WEATHERSFIELD
PROJECT NUMBER:	STP 2913(I)
FILE NAME:	I0c228
PROJECT LEADER:	PTS
DESIGNED BY:	NLL
IPARM FILE NAME:	pI0C228.I71
PLOT DATE:	2/7/2013
DRAWN BY:	WWG
CHECKED BY:	PTS
SHEET	171 OF 234

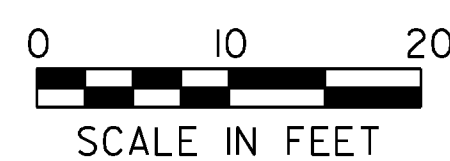

STA. 405+50 TO STA. 409+50