




411+00

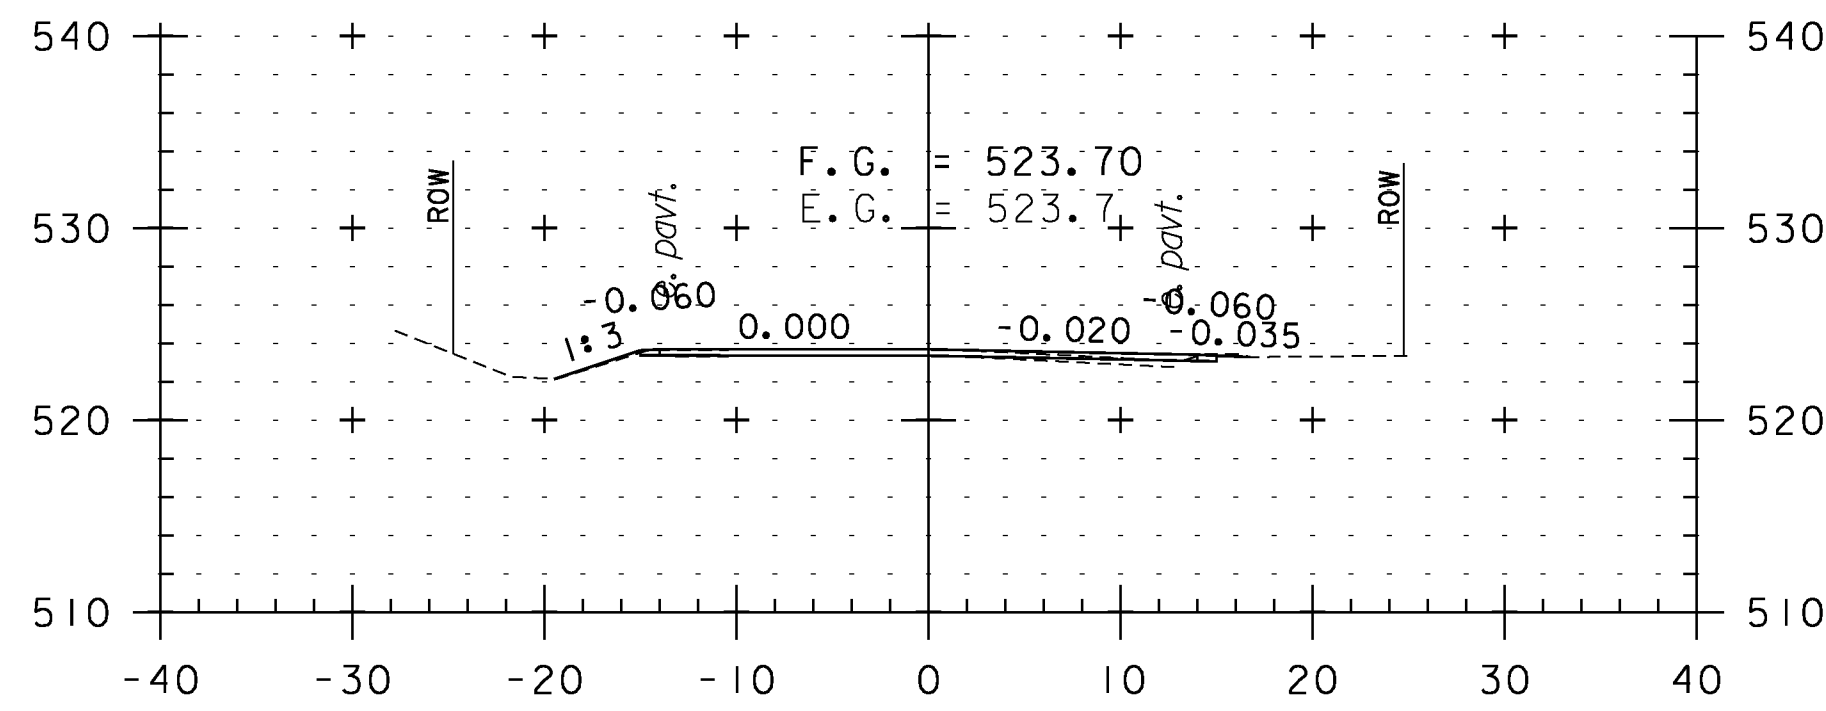


412+50

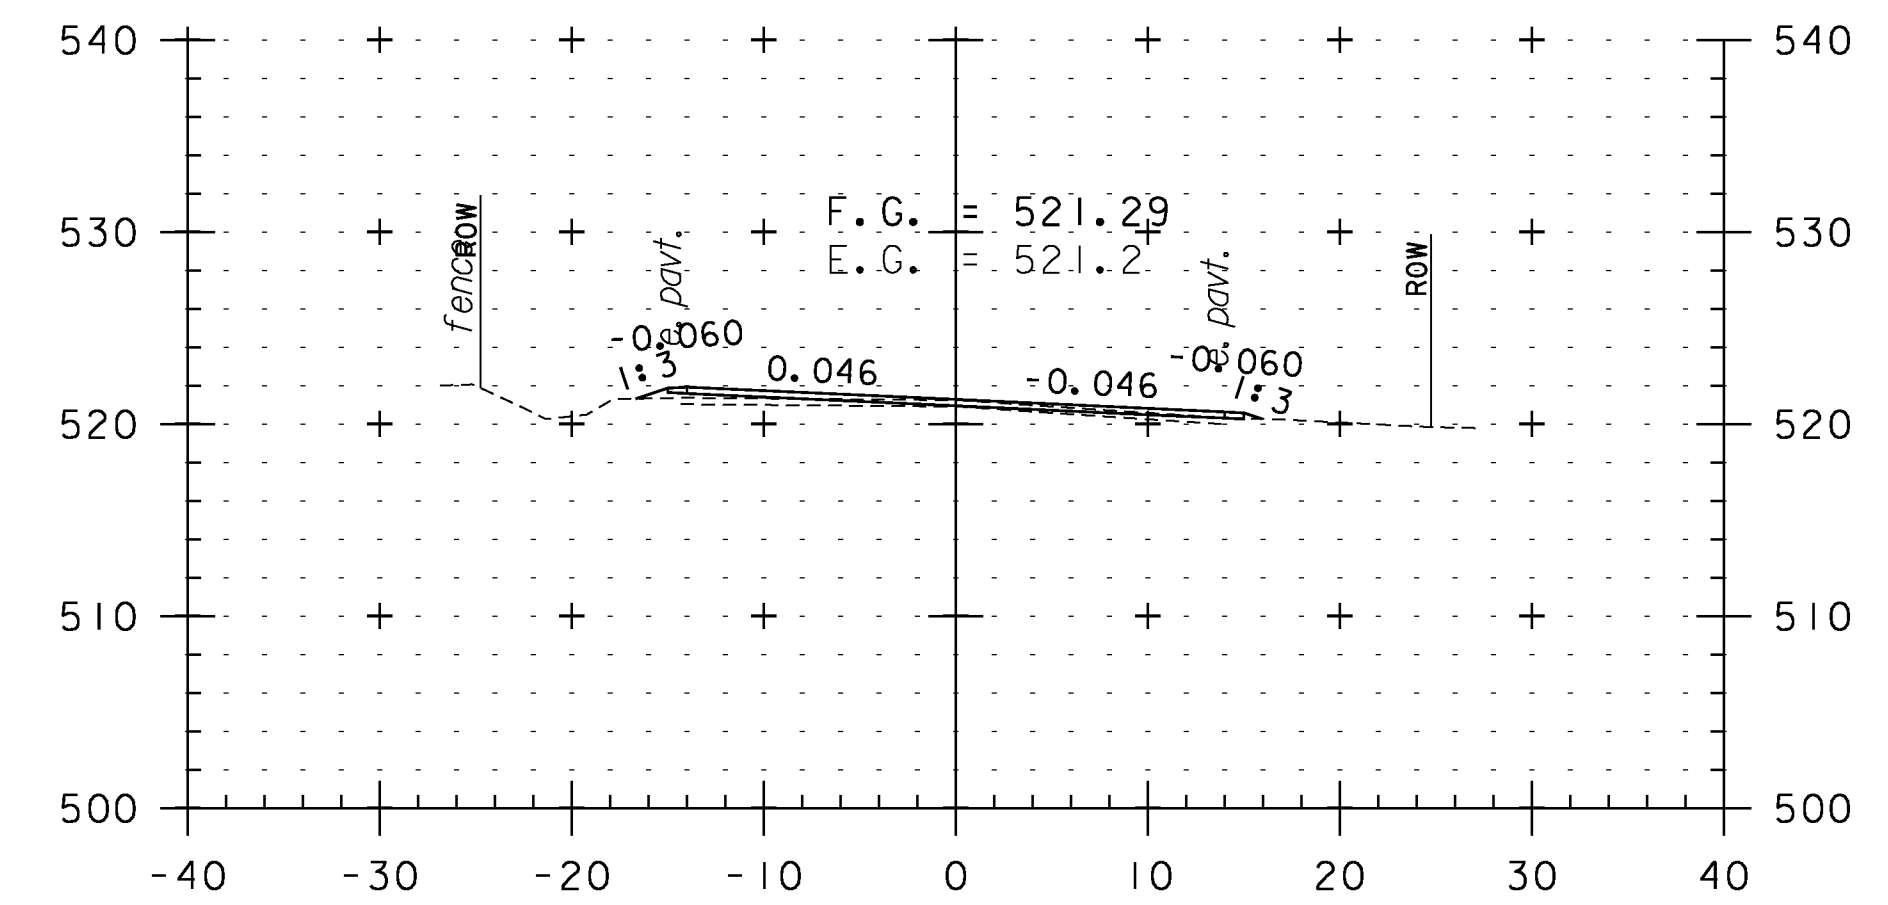


414+00

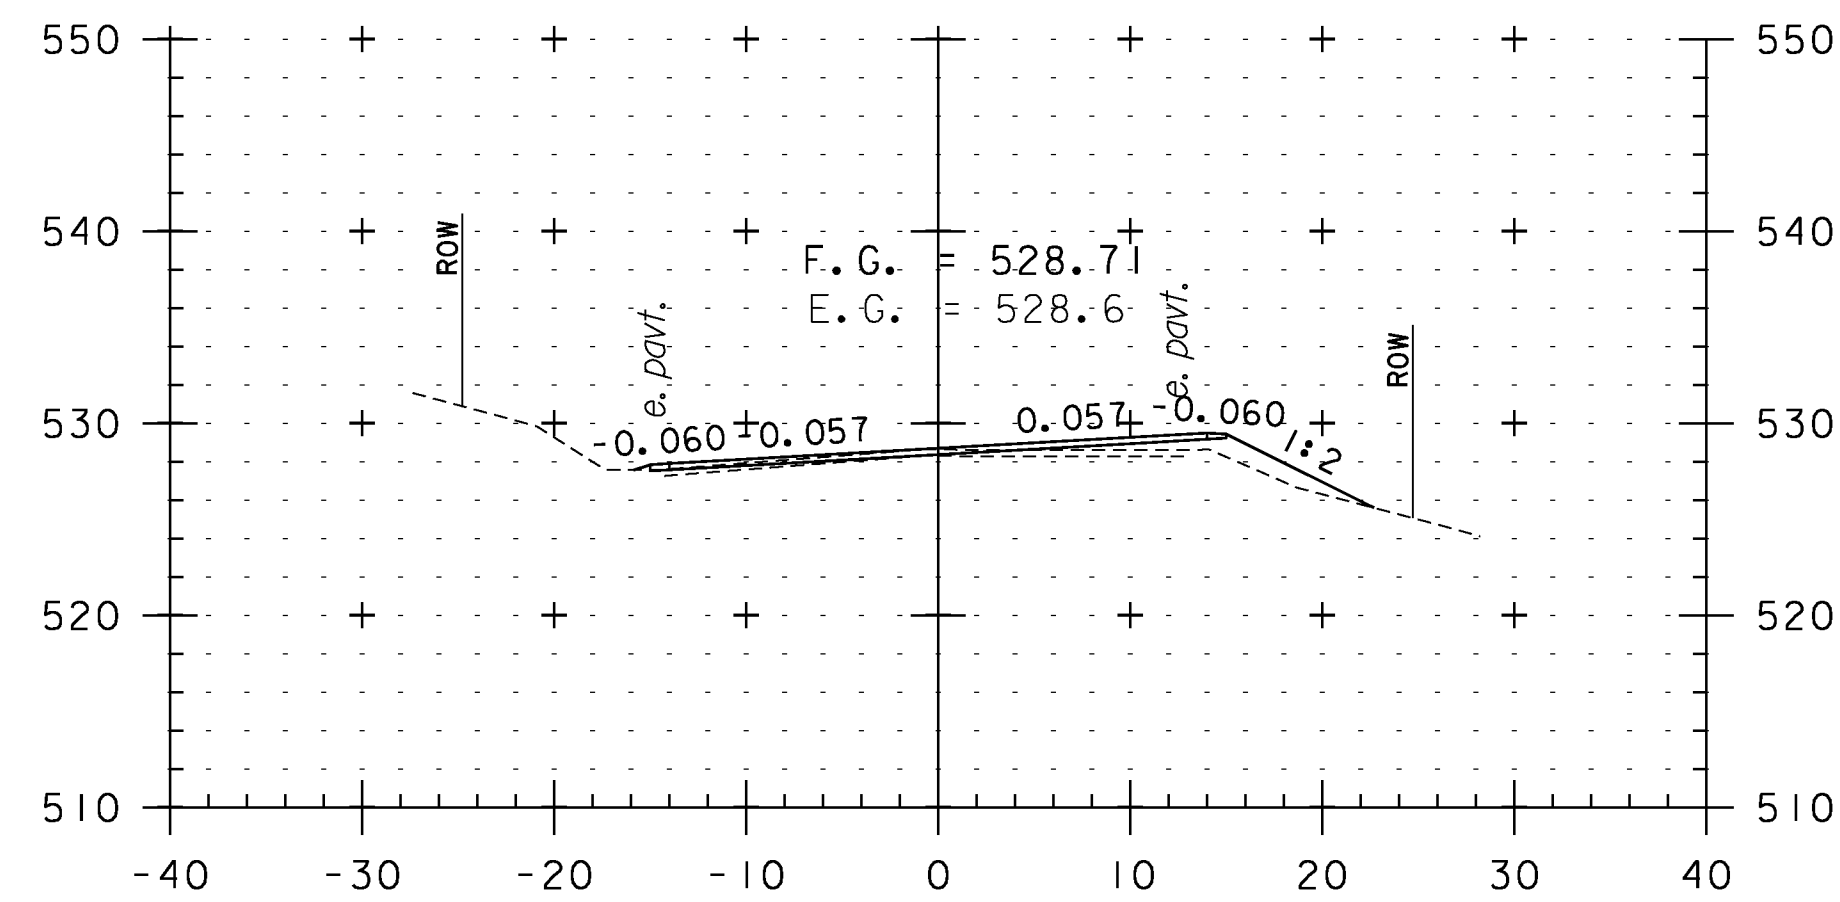


410+50

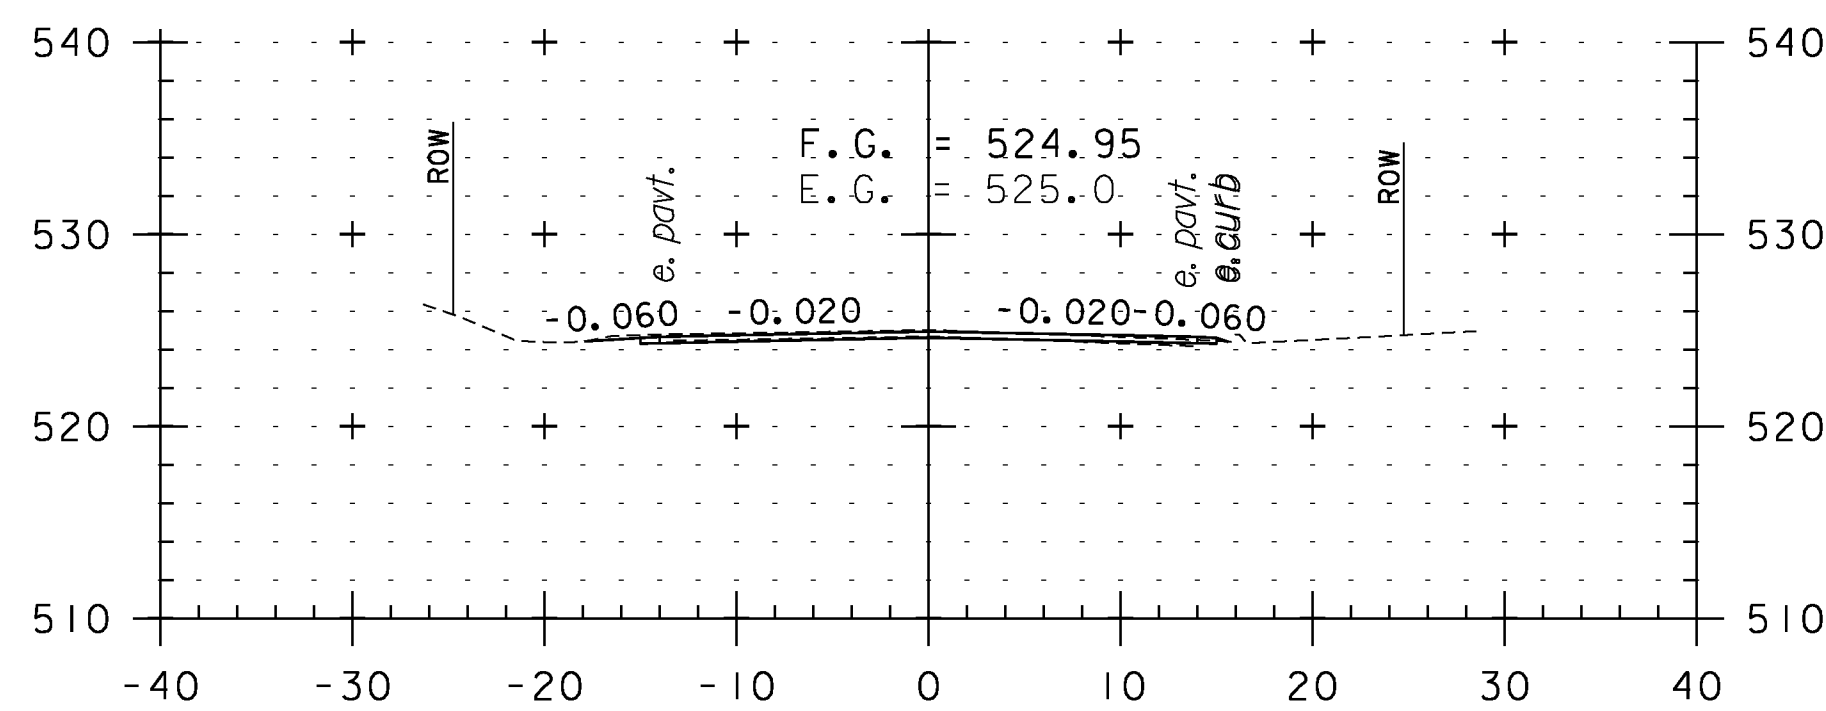


412+00

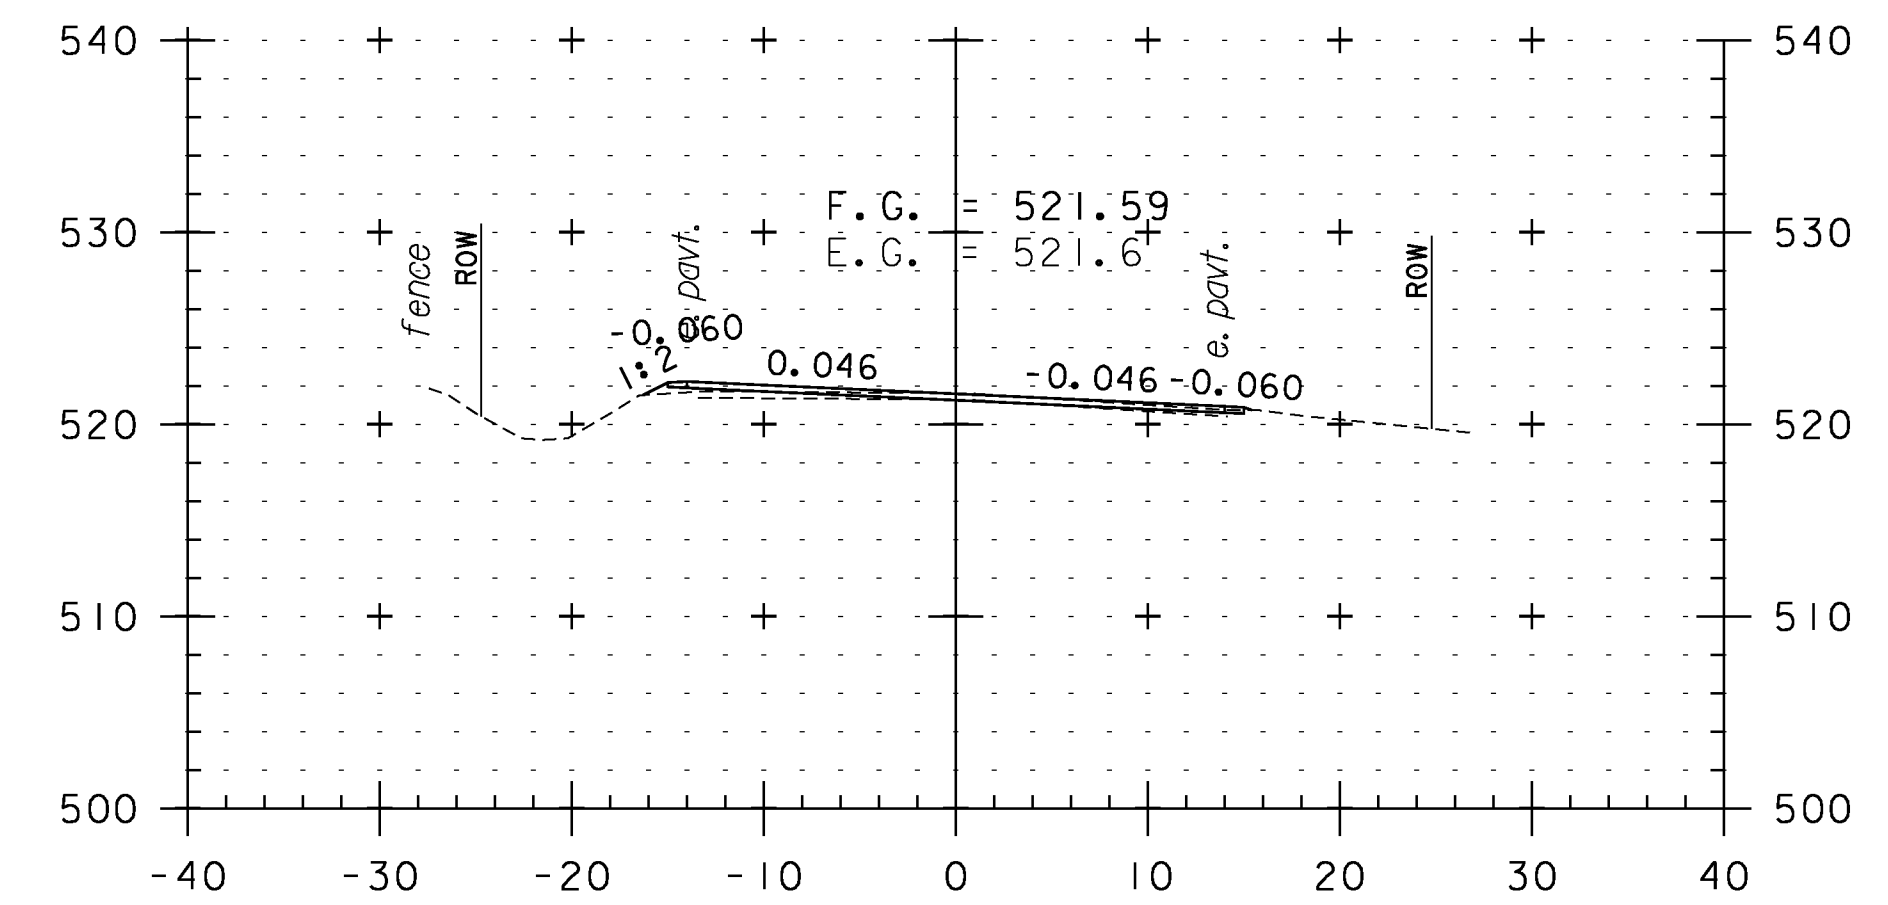


413+50

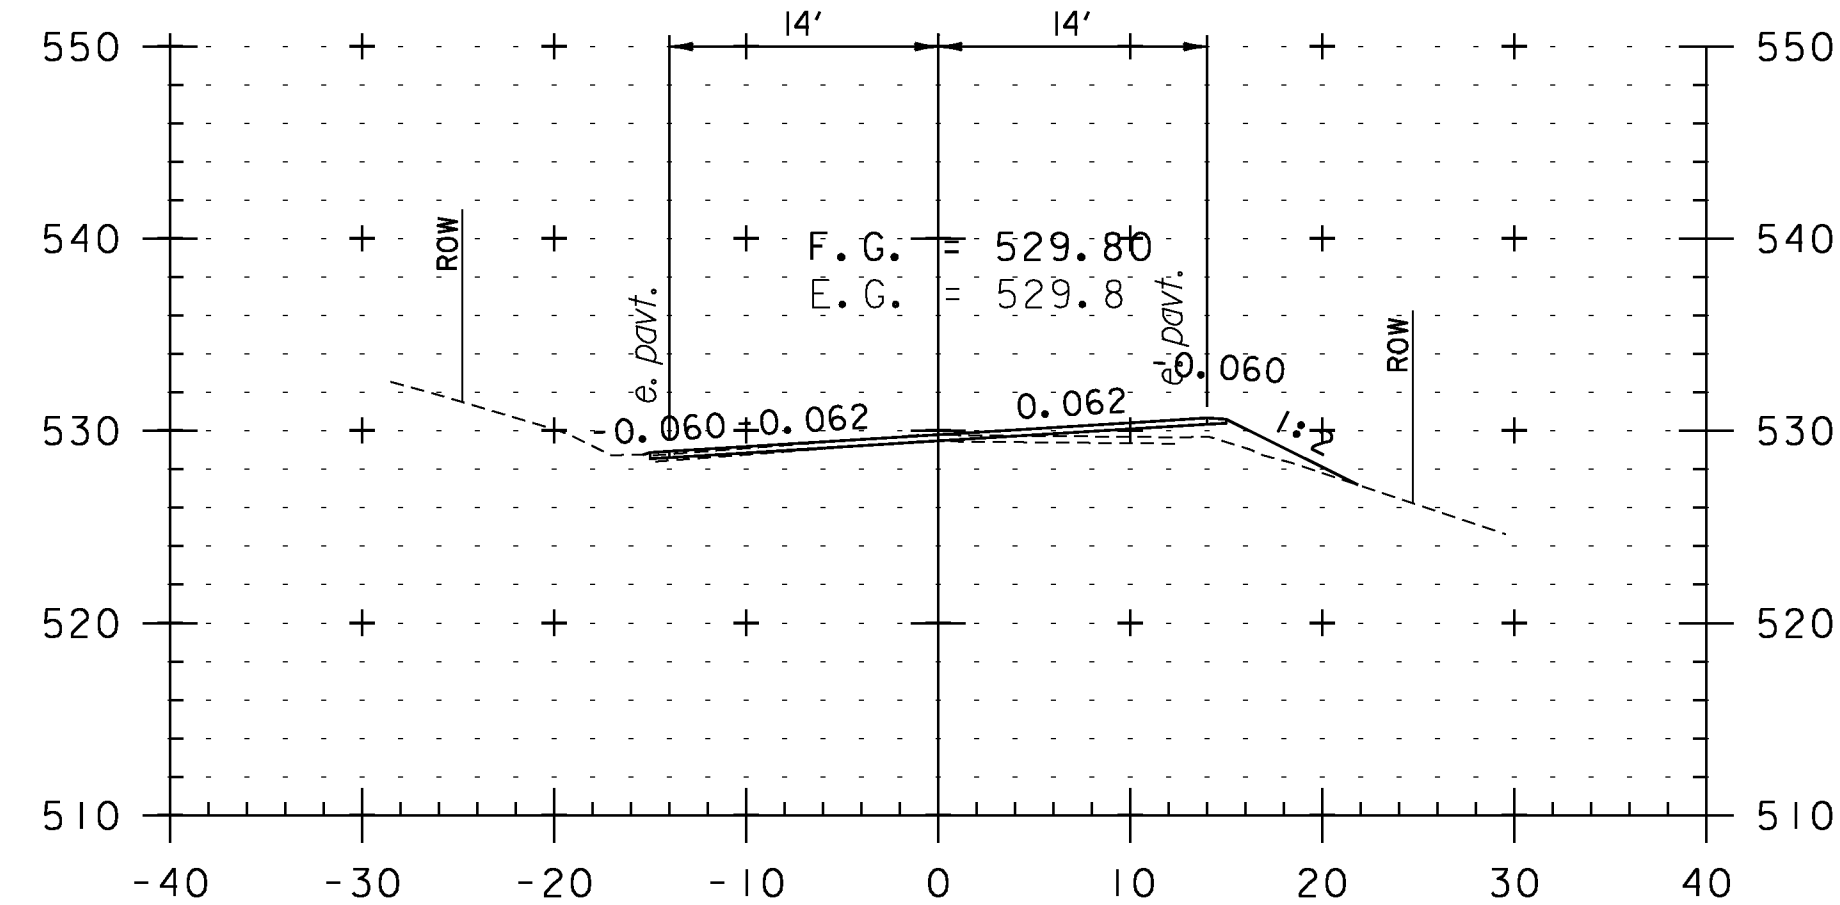

410+00

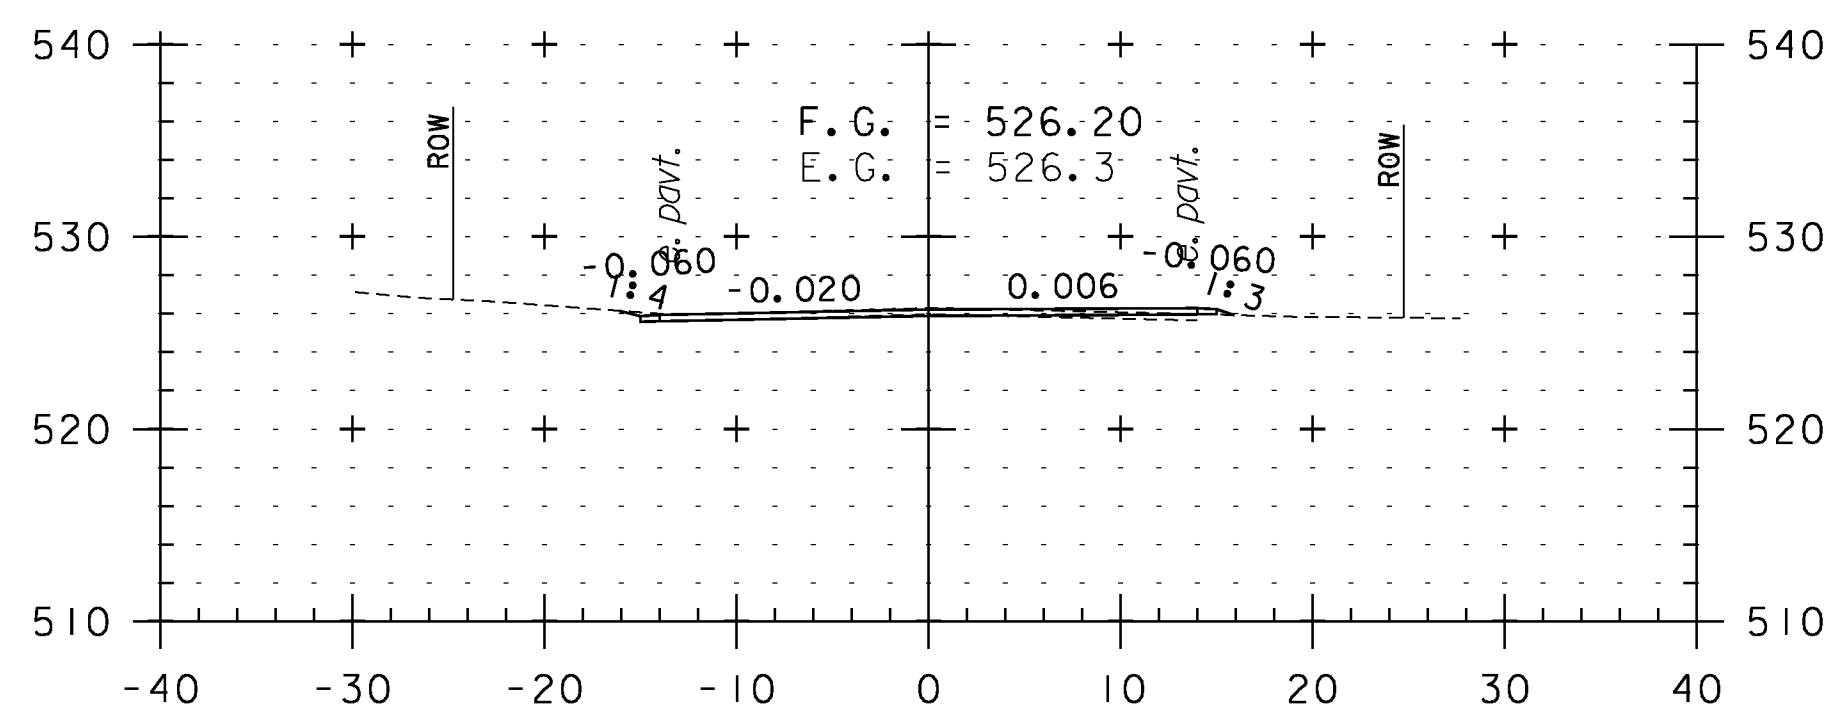

411+50

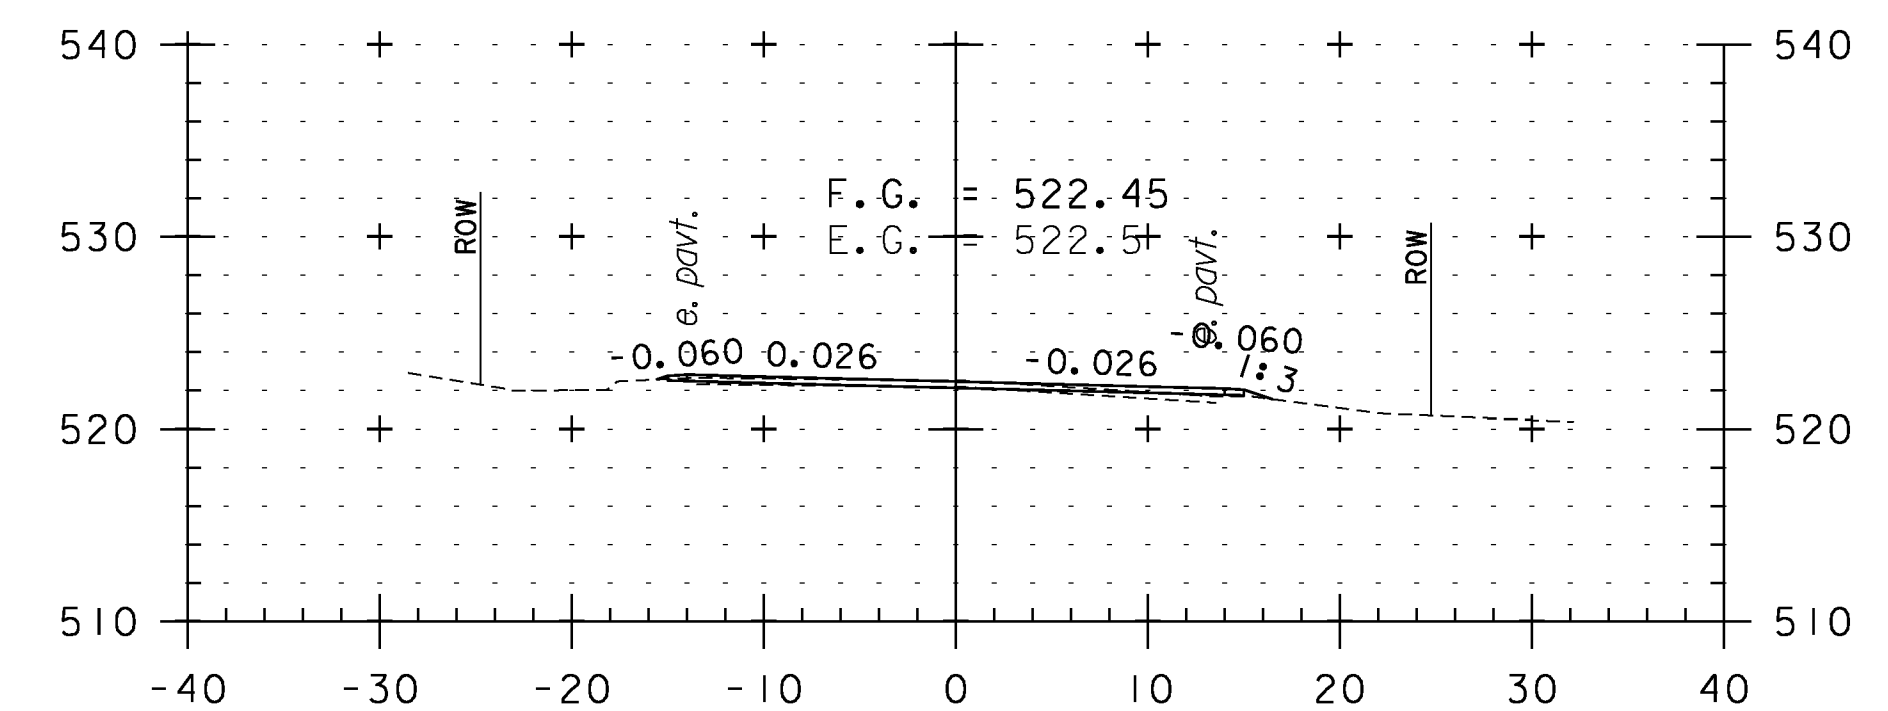

413+00

CROSS SECTION SHEET 82

PROJECT NAME: WEATHERSFIELD

PROJECT NUMBER: STP 2913(I)

FILE NAME: I0c228

PROJECT LEADER: PTS

DESIGNED BY: NLL


IPARM FILE NAME: pI0C228.I72

PLOT DATE: 2/7/2013

DRAWN BY: WWG

CHECKED BY: PTS

SHEET 172 OF 234

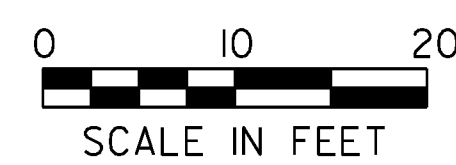

STA. 410+00 TO STA. 414+00