




428+75
END PROJECT

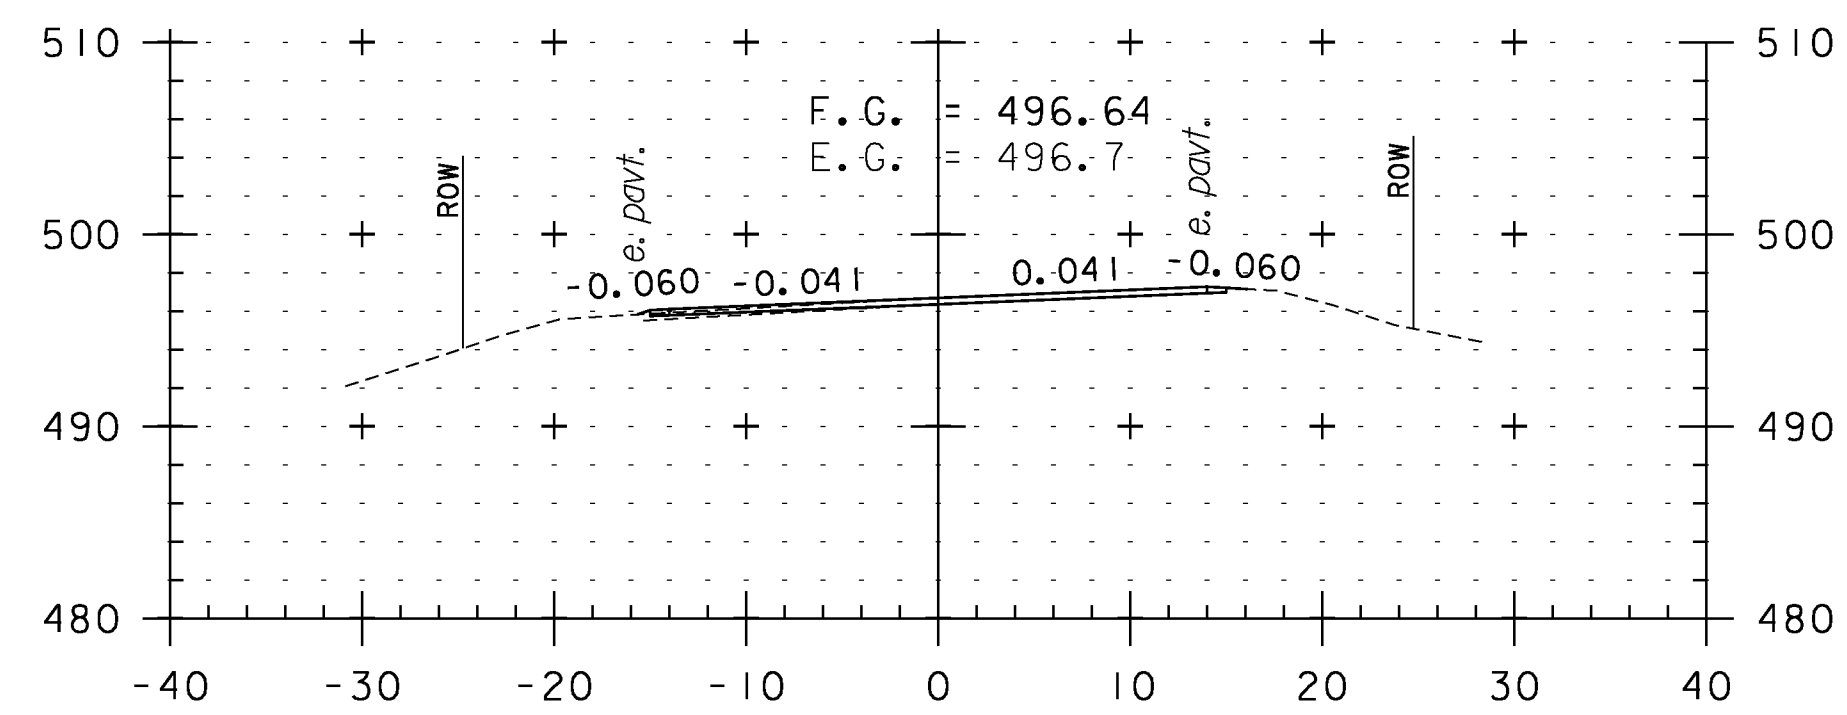


428+50

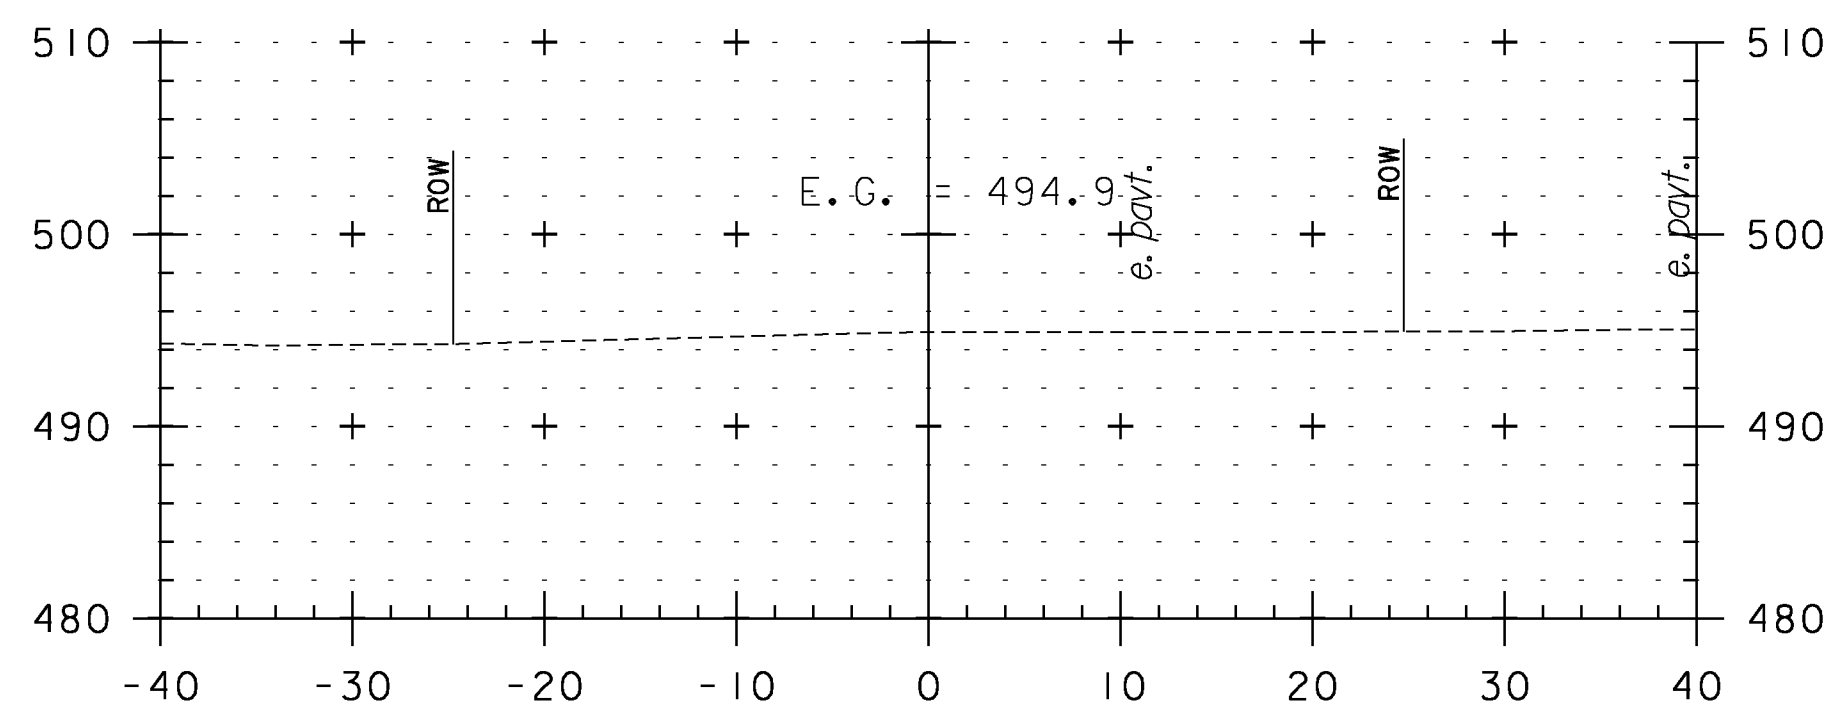

429+50

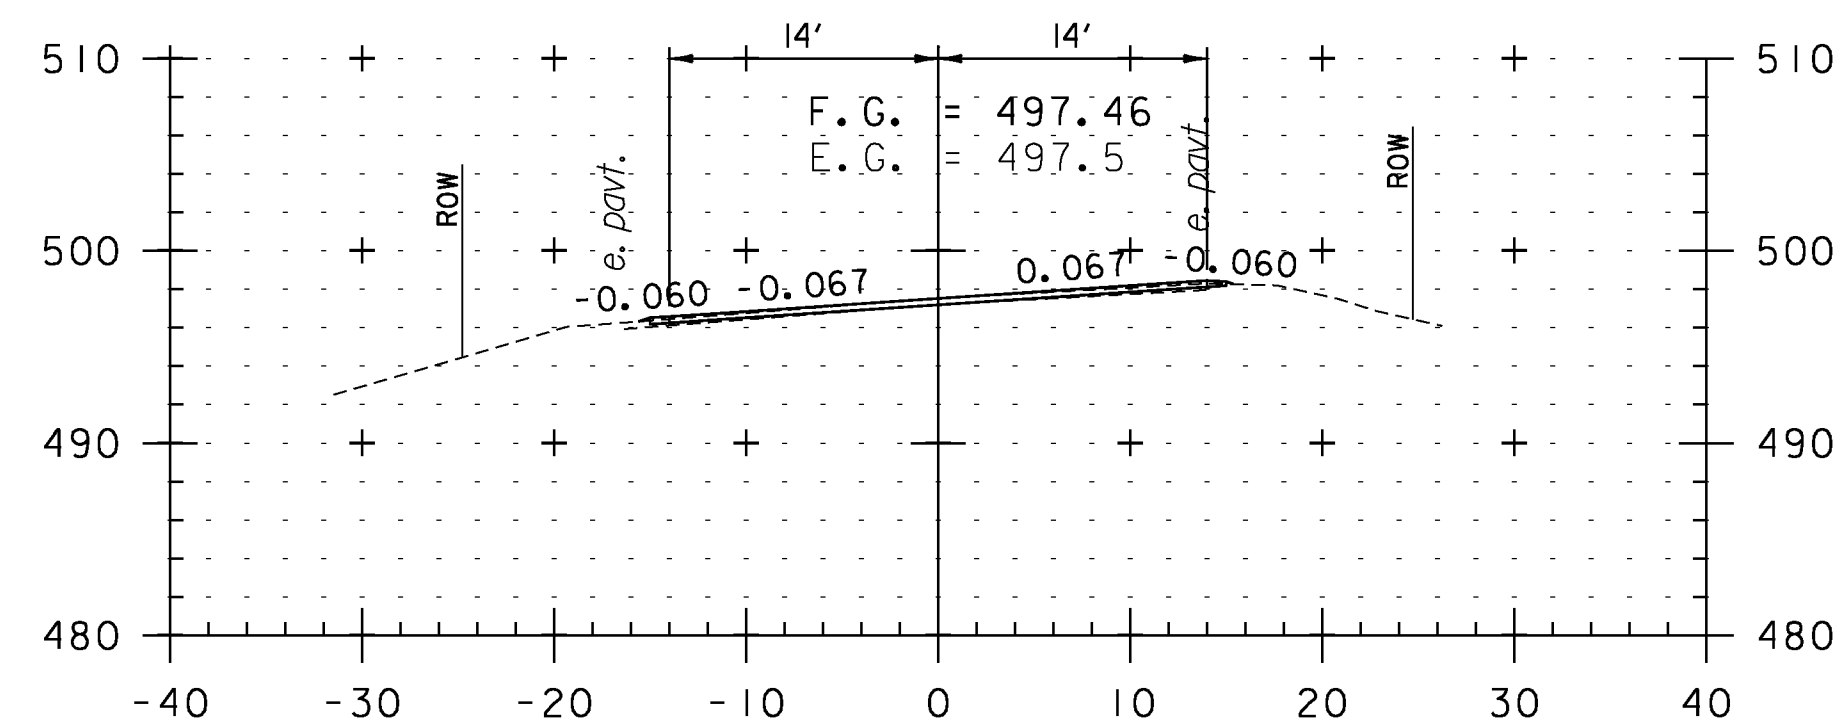

428+00

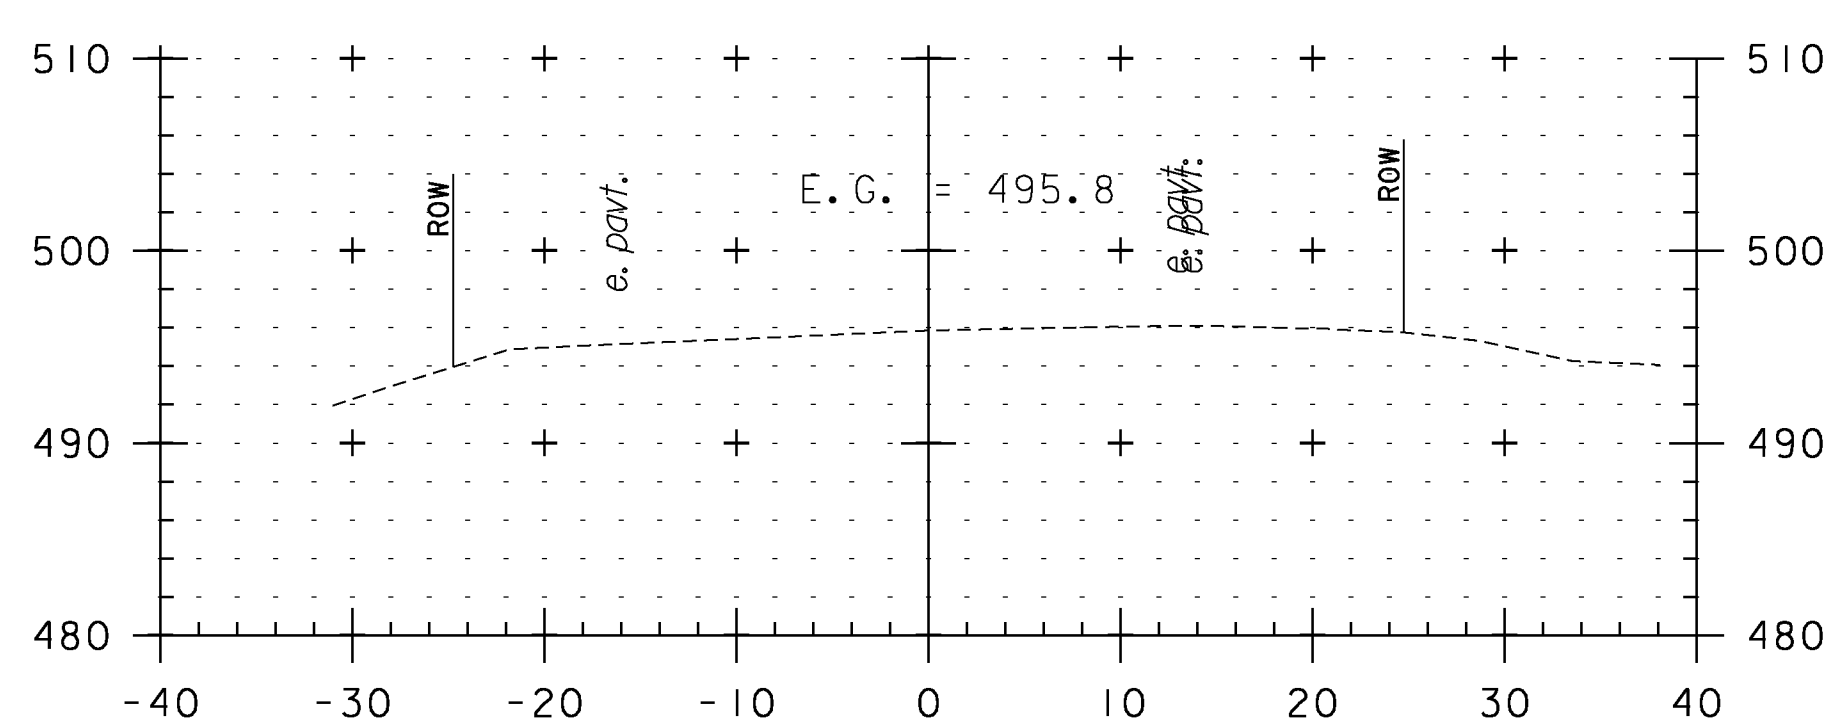

429+00

CROSS SECTION SHEET 86

PROJECT NAME: WEATHERSFIELD

PROJECT NUMBER: STP 2913(I)

FILE NAME: I0c228

PROJECT LEADER: PTS

DESIGNED BY: NLL


IPARM FILE NAME: pI0c228.I76

PLOT DATE: 2/7/2013

DRAWN BY: WWG

CHECKED BY: PTS

SHEET 176 OF 234

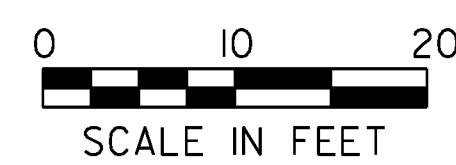

STA. 428+00 TO STA. 429+50