




20+50

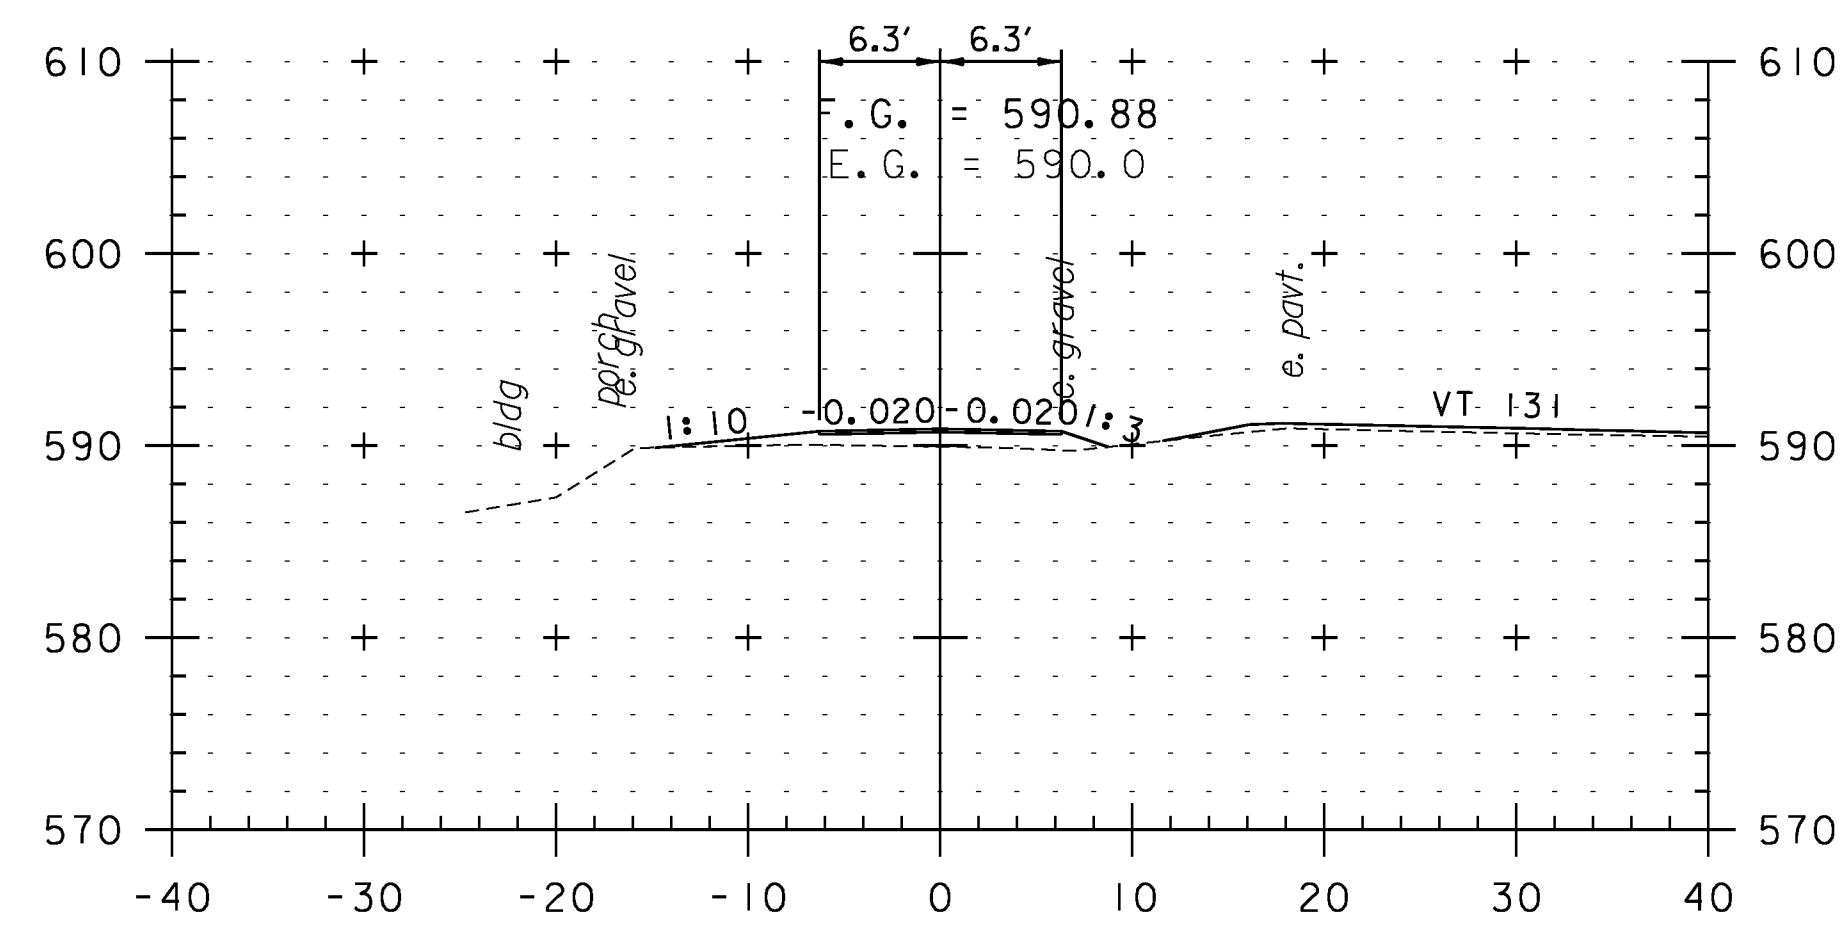

20+25

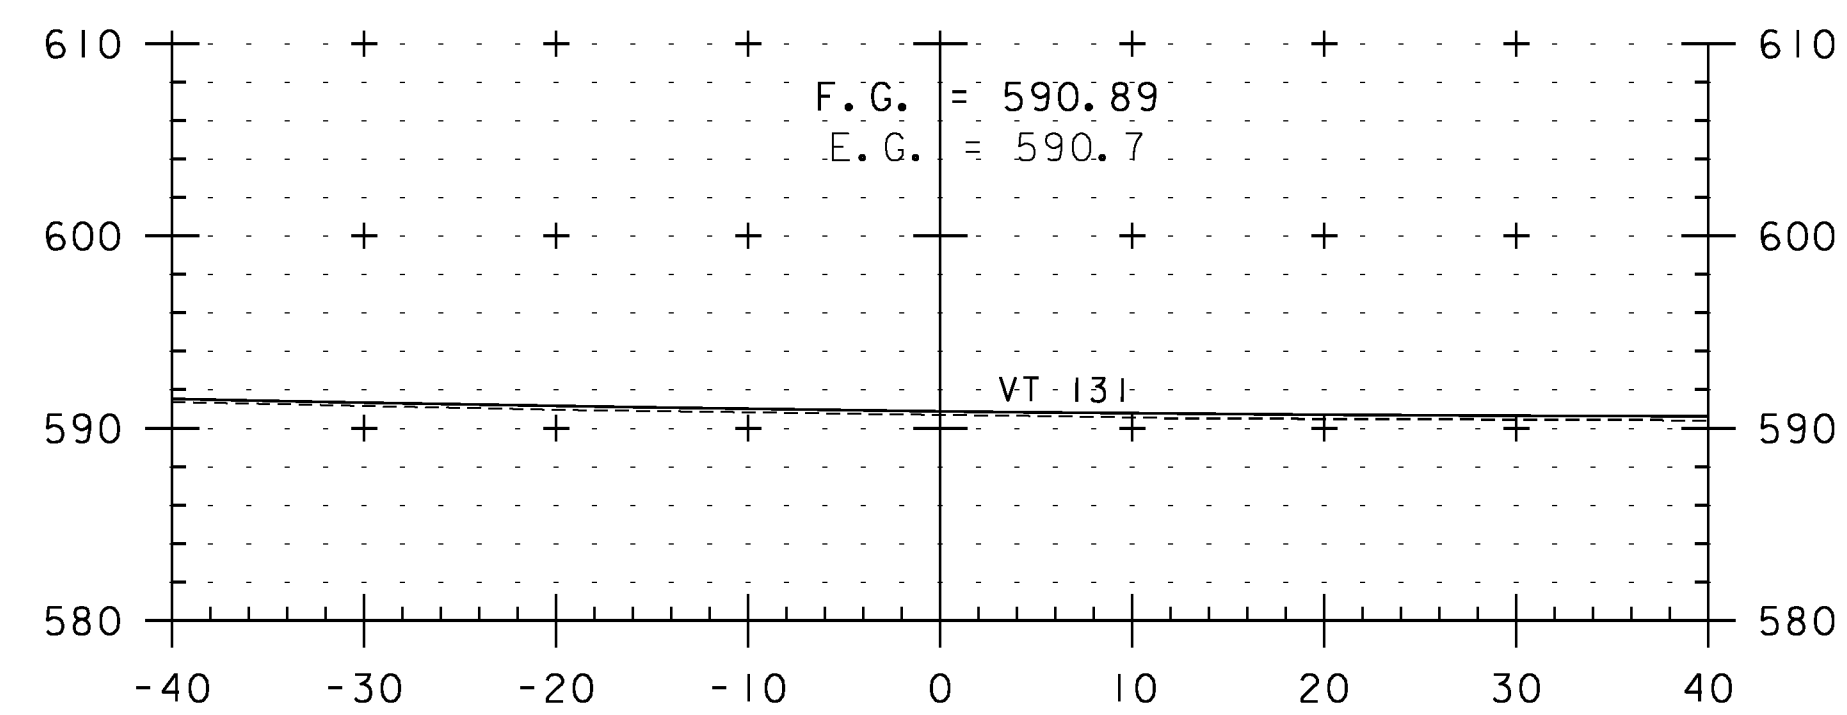

20+00

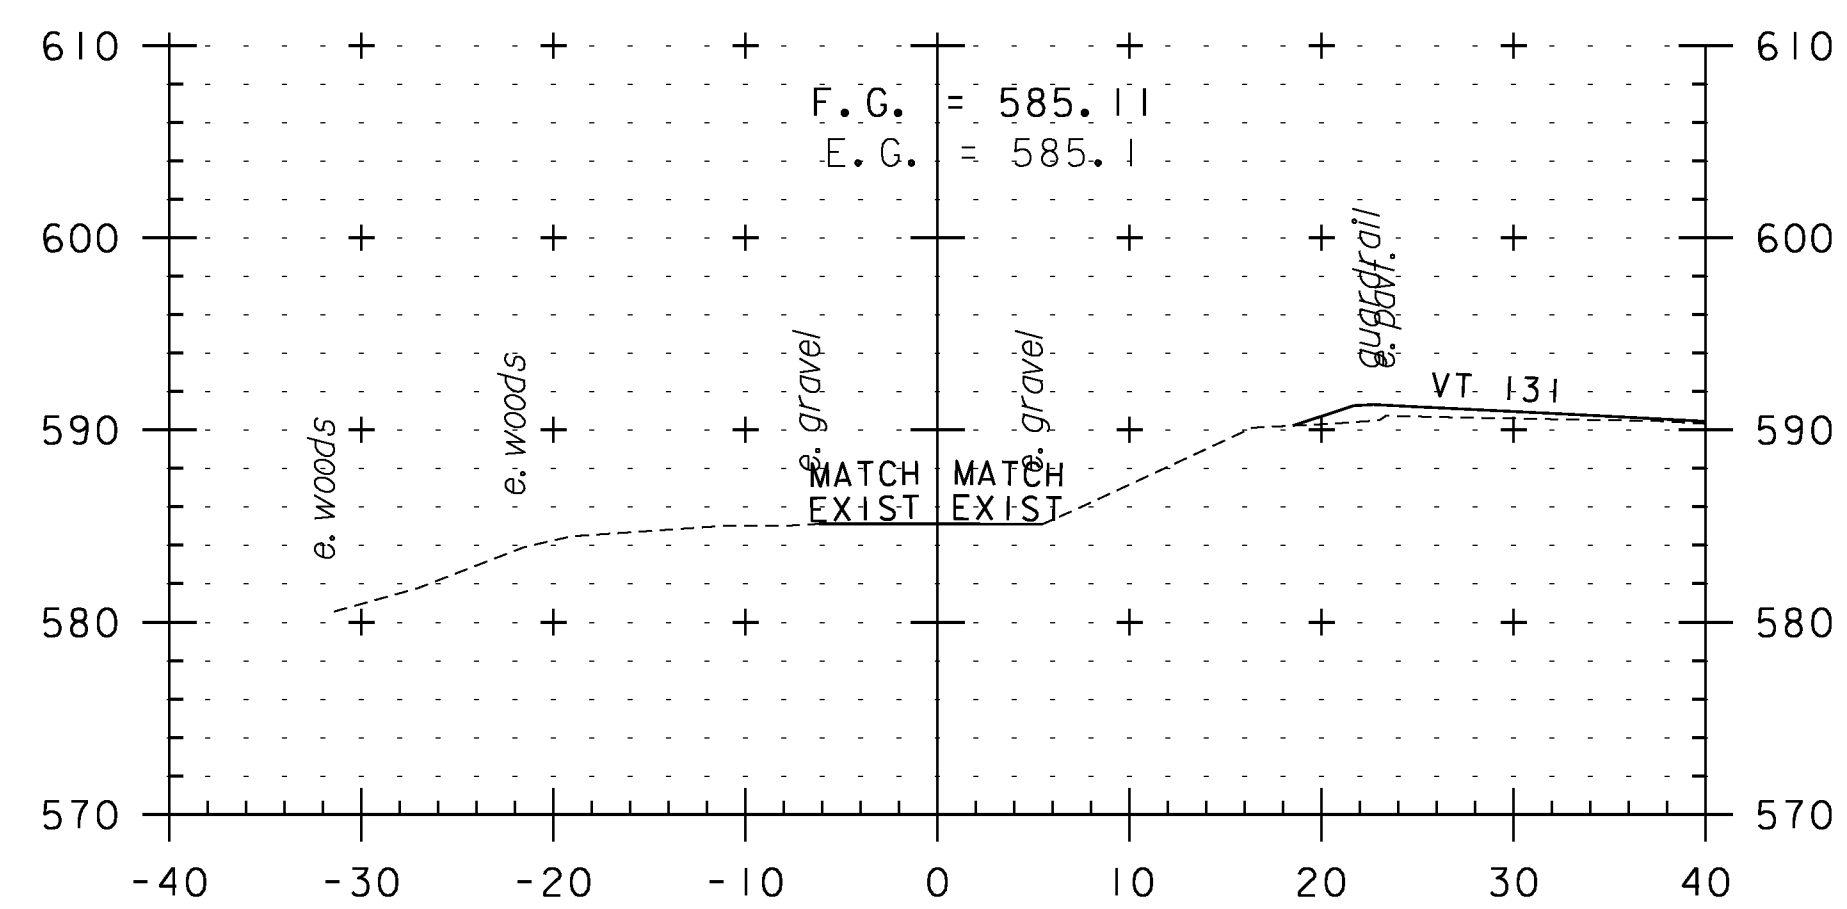

20+75



STA. 20+00 TO STA. 20+75

### CROSS SECTION TH 94

PROJECT NAME: WEATHERSFIELD

PROJECT NUMBER: STP 2913(I)

FILE NAME: I0c228

PROJECT LEADER: PTS

DESIGNED BY: JLS

IPARM FILE NAME: p10c228.l78

PLOT DATE: 2/7/2013

DRAWN BY: JLS

CHECKED BY: PTS

SHEET 178 OF 234